



TEMPORARY 4 INCH WHITE LINE, PAINT  
 DURABLE 4 INCH WHITE LINE (OPTION BID ITEM)  
 165+50 TO 165+85 SOLID LT  
 165+50 TO 169+66 SOLID RT  
 165+85 TO 166+13 SOLID LT ( TH 17)  
 166+34 TO 166+62 SOLID LT ( TH 17)  
 166+62 TO 171+50 SOLID LT  
 169+66 TO 170+00 SOLID RT ( TH 45)  
 170+24 TO 170+56 SOLID RT ( TH 45)  
 170+56 TO 171+50 SOLID RT

TEMPORARY 4 INCH YELLOW LINE, PAINT  
 DURABLE 4 INCH YELLOW LINE (OPTION BID ITEM)  
 165+50 TO 166+04 SOLID LT & RT  
 166+24 DOUBLE SOLID LT ( TH 17)  
 166+44 TO 169+86 SOLID LT & RT  
 170+07 TO 170+12 DOUBLE SOLID RT ( TH 45)  
 170+26 TO 171+50 SOLID LT & RT

TEMPORARY 24 INCH STOP BAR, PAINT  
 DURABLE 24 INCH STOP BAR (OPTION BID ITEM)  
 166+08 TO 166+23 LT ( TH 17)  
 170+08 TO 170+29 RT ( TH 45)  
 TEMPORARY LETTER OR SYMBOL, PAINT  
 DURABLE LETTER OR SYMBOL (OPTION BID ITEM)  
 166+17 LT - STOP ( TH 17)  
 170+18 RT - STOP ( TH 45)

STEEL BEAM GUARDRAIL, GALVANIZED  
 166+40 TO 169+26 LT  
 166+40 TO 169+40 RT  
 ANCHOR FOR STEEL BEAM RAIL  
 166+40 LT  
 166+40 RT  
 169+26 LT  
 169+40 RT

REMOVAL AND DISPOSAL OF GUARDRAIL  
 166+40 TO 169+26 LT  
 166+40 TO 169+40 RT  
 DELINEATOR WITH STEEL POST  
 166+40 LT  
 166+40 RT  
 169+26 LT  
 169+40 RT  
 REMOVING SIGNS  
 AS SHOWN - 9

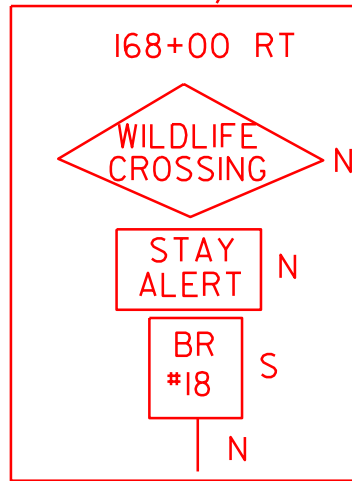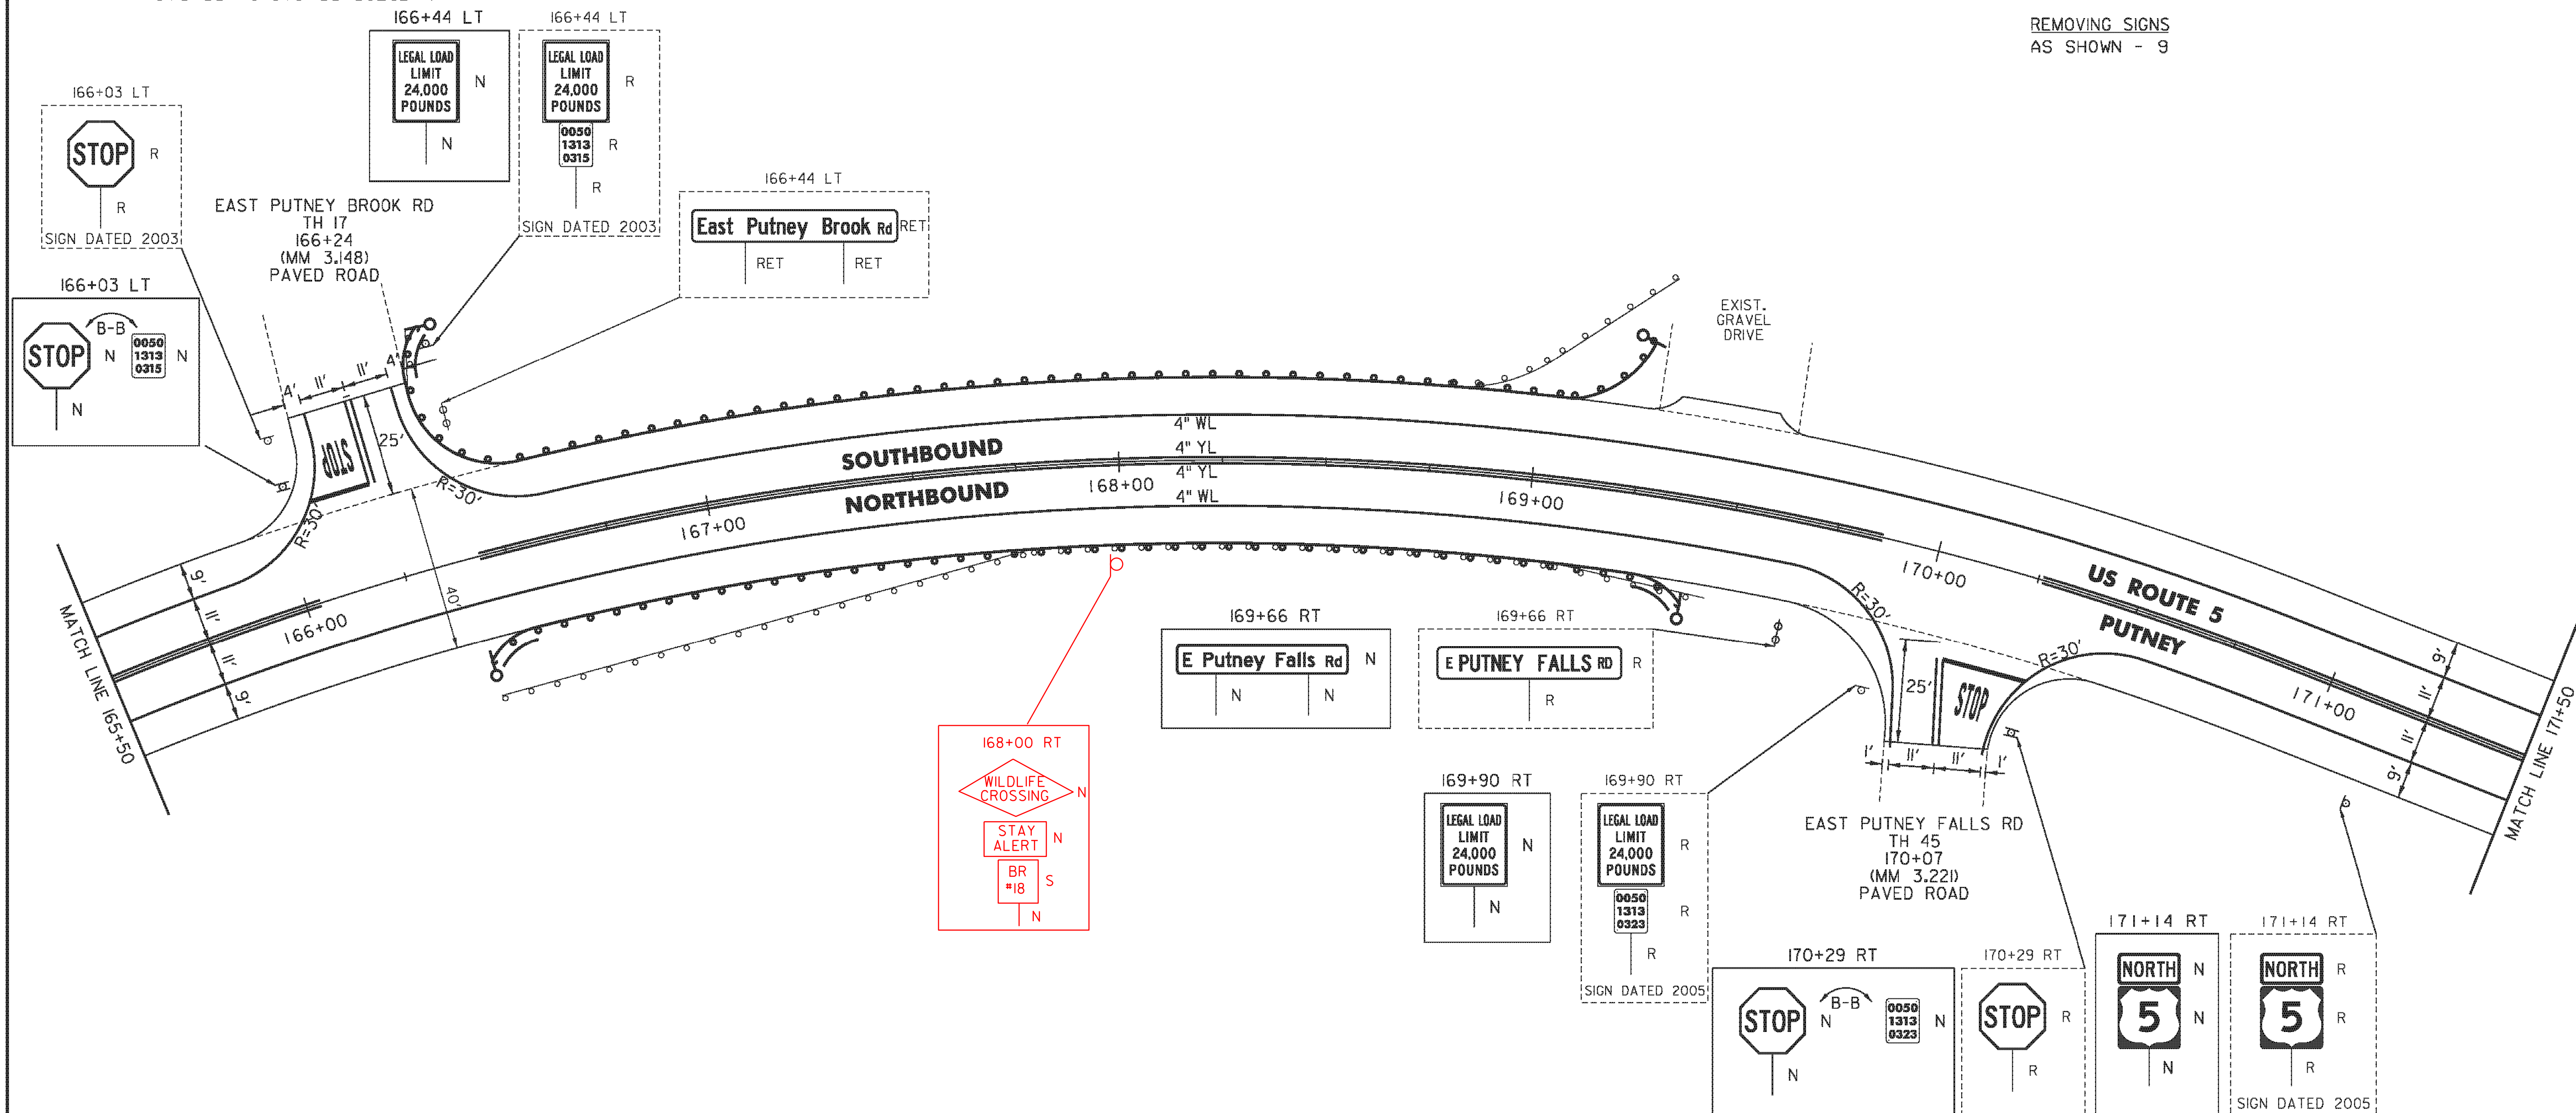

- LEGEND**
- R = REMOVE EXISTING
  - S = SALVAGE
  - R&S = REMOVE AND SALVAGE
  - N = NEW
  - RET = RETAIN
  - B-B = BACK TO BACK
  - = EXISTING GUARDRAIL
  - = PROPOSED GUARDRAIL
  - = YELLOW LINE
  - = WHITE LINE
  - = DELINEATOR
  - = UTILITY POLE

PROJECT NAME: PUTNEY-WESTMINSTER  
 PROJECT NUMBER: STP 2946(I)

FILE NAME: zllc344bdr.dgn  
 PROJECT LEADER: P. SHEDD  
 DESIGNED BY: N. LEMAY  
 ROADWAY LAYOUT I7 US 5

PLOT DATE: 12/10/2013  
 DRAWN BY: W. GORDON  
 CHECKED BY: P. SHEDD  
 SHEET 38 OF 138

NOT TO SCALE