


TEMPORARY 4 INCH WHITE LINE, PAINT
 DURABLE 4 INCH WHITE LINE (OPTION BID ITEM)
 191+50 TO 197+50 SOLID LT & RT
 TEMPORARY 4 INCH YELLOW LINE, PAINT
 DURABLE 4 INCH YELLOW LINE, POLYUREA
 191+50 TO 197+50 SOLID LT & RT

STEEL BEAM GUARDRAIL, GALVANIZED
 191+54 TO 197+50 RT
 ANCHOR FOR STEEL BEAM RAIL
 191+54 RT

REMOVAL AND DISPOSAL OF GUARDRAIL
 191+54 TO 197+50 RT
 DELINEATOR WITH STEEL POST
 191+54 RT

MILLED RUMBLE STRIPS
 191+50 TO 197+50 CL
 REMOVING SIGNS
 AS SHOWN - 2

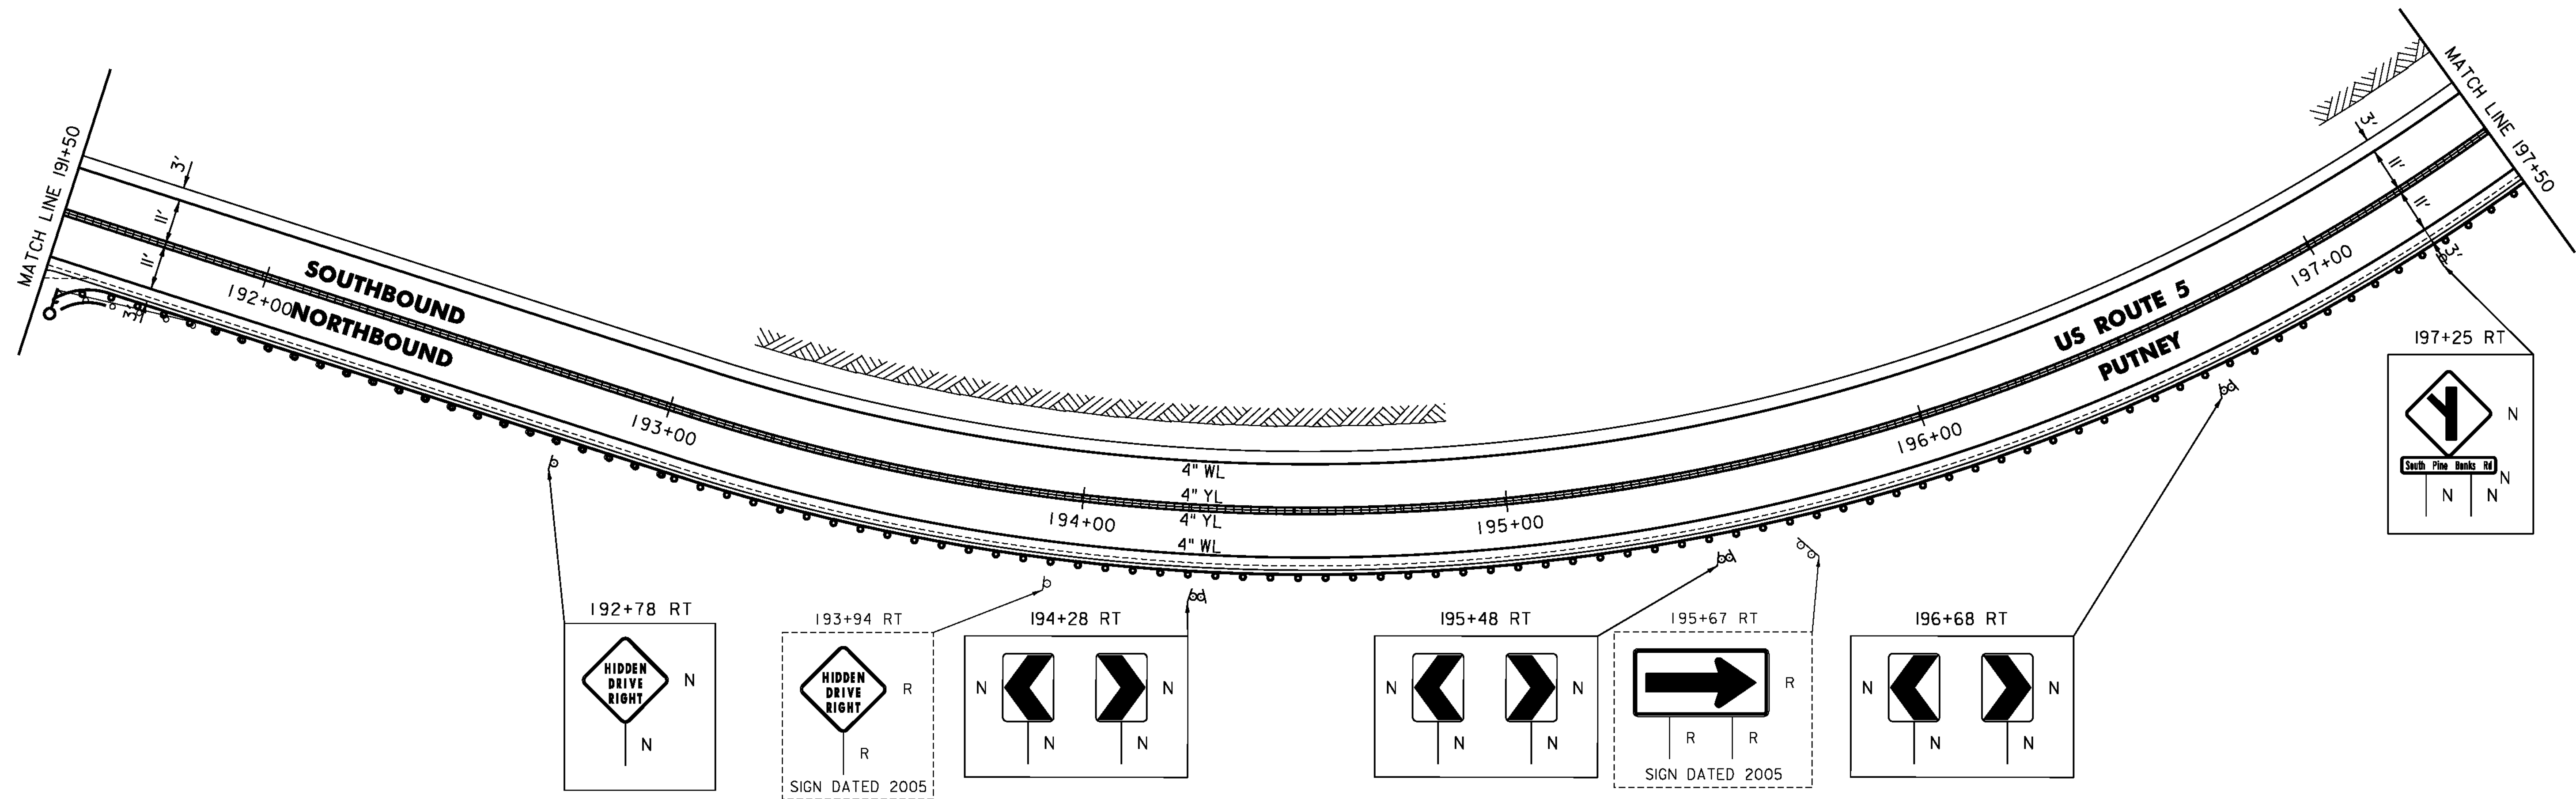

NOT TO SCALE

LEGEND

- R = REMOVE EXISTING
- S = SALVAGE
- R&S = REMOVE AND SALVAGE
- N = NEW
- RET = RETAIN
- B-B = BACK TO BACK
- = EXISTING GUARDRAIL
- = PROPOSED GUARDRAIL
- YL = YELLOW LINE
- WL = WHITE LINE
- = DELINEATOR
- ⊕ = UTILITY POLE

PROJECT NAME: PUTNEY-WESTMINSTER

PROJECT NUMBER: STP 2946(1)

FILE NAME: zllc344bdr.dgn
 PROJECT LEADER: P. SHEDD
 DESIGNED BY: N. LEMAY
 ROADWAY LAYOUT 20 US 5

PLOT DATE: 12/10/2013
 DRAWN BY: W. GORDON
 CHECKED BY: P. SHEDD
 SHEET 41 OF 138