

TEMPORARY 4 INCH WHITE LINE, PAINT
 DURABLE 4 INCH WHITE LINE (OPTION BID ITEM)
 197+50 TO 201+13 SOLID LT
 197+50 TO 203+50 SOLID RT
 201+13 TO 201+66 SOLID LT
 201+86 TO 201+88 SOLID LT
 201+88 TO 203+50 SOLID LT

TEMPORARY 4 INCH YELLOW LINE, PAINT
 197+50 TO 201+36 SOLID LT & RT
 201+56 TO 201+75 DOUBLE SOLID LT (TH 19)
 201+76 TO 203+50 SOLID LT & RT

DURABLE 4 INCH YELLOW LINE (OPTION BID ITEM)
 201+00 TO 201+36 SOLID LT & RT
 201+56 TO 201+75 DOUBLE SOLID LT (TH 19)
 201+76 TO 203+50 SOLID LT & RT


DURABLE 4 INCH YELLOW LINE, POLYUREA
 197+50 TO 201+00 SOLID LT & RT

TEMPORARY 24 INCH STOP BAR, PAINT
 DURABLE 24 INCH STOP BAR (OPTION BID ITEM)
 201+32 TO 201+56 LT (TH 19)
 TEMPORARY LETTER OR SYMBOL, PAINT
 DURABLE LETTER OR SYMBOL (OPTION BID ITEM)
 201+46 LT - STOP (TH 19)

STEEL BEAM GUARDRAIL, GALVANIZED
 197+50 TO 198+41.5 RT
 ANCHOR FOR STEEL BEAM RAIL
 198+41.5 RT

REMOVAL AND DISPOSAL OF GUARDRAIL
 197+50 TO 198+36 RT
 DELINEATOR WITH STEEL POST
 198+41.5 RT

MILLED RUMBLE STRIPS
 197+50 TO 201+00 CL
 REMOVING SIGNS
 AS SHOWN - 9
 ERECTING SALVAGED SIGNS
 AS SHOWN - 2

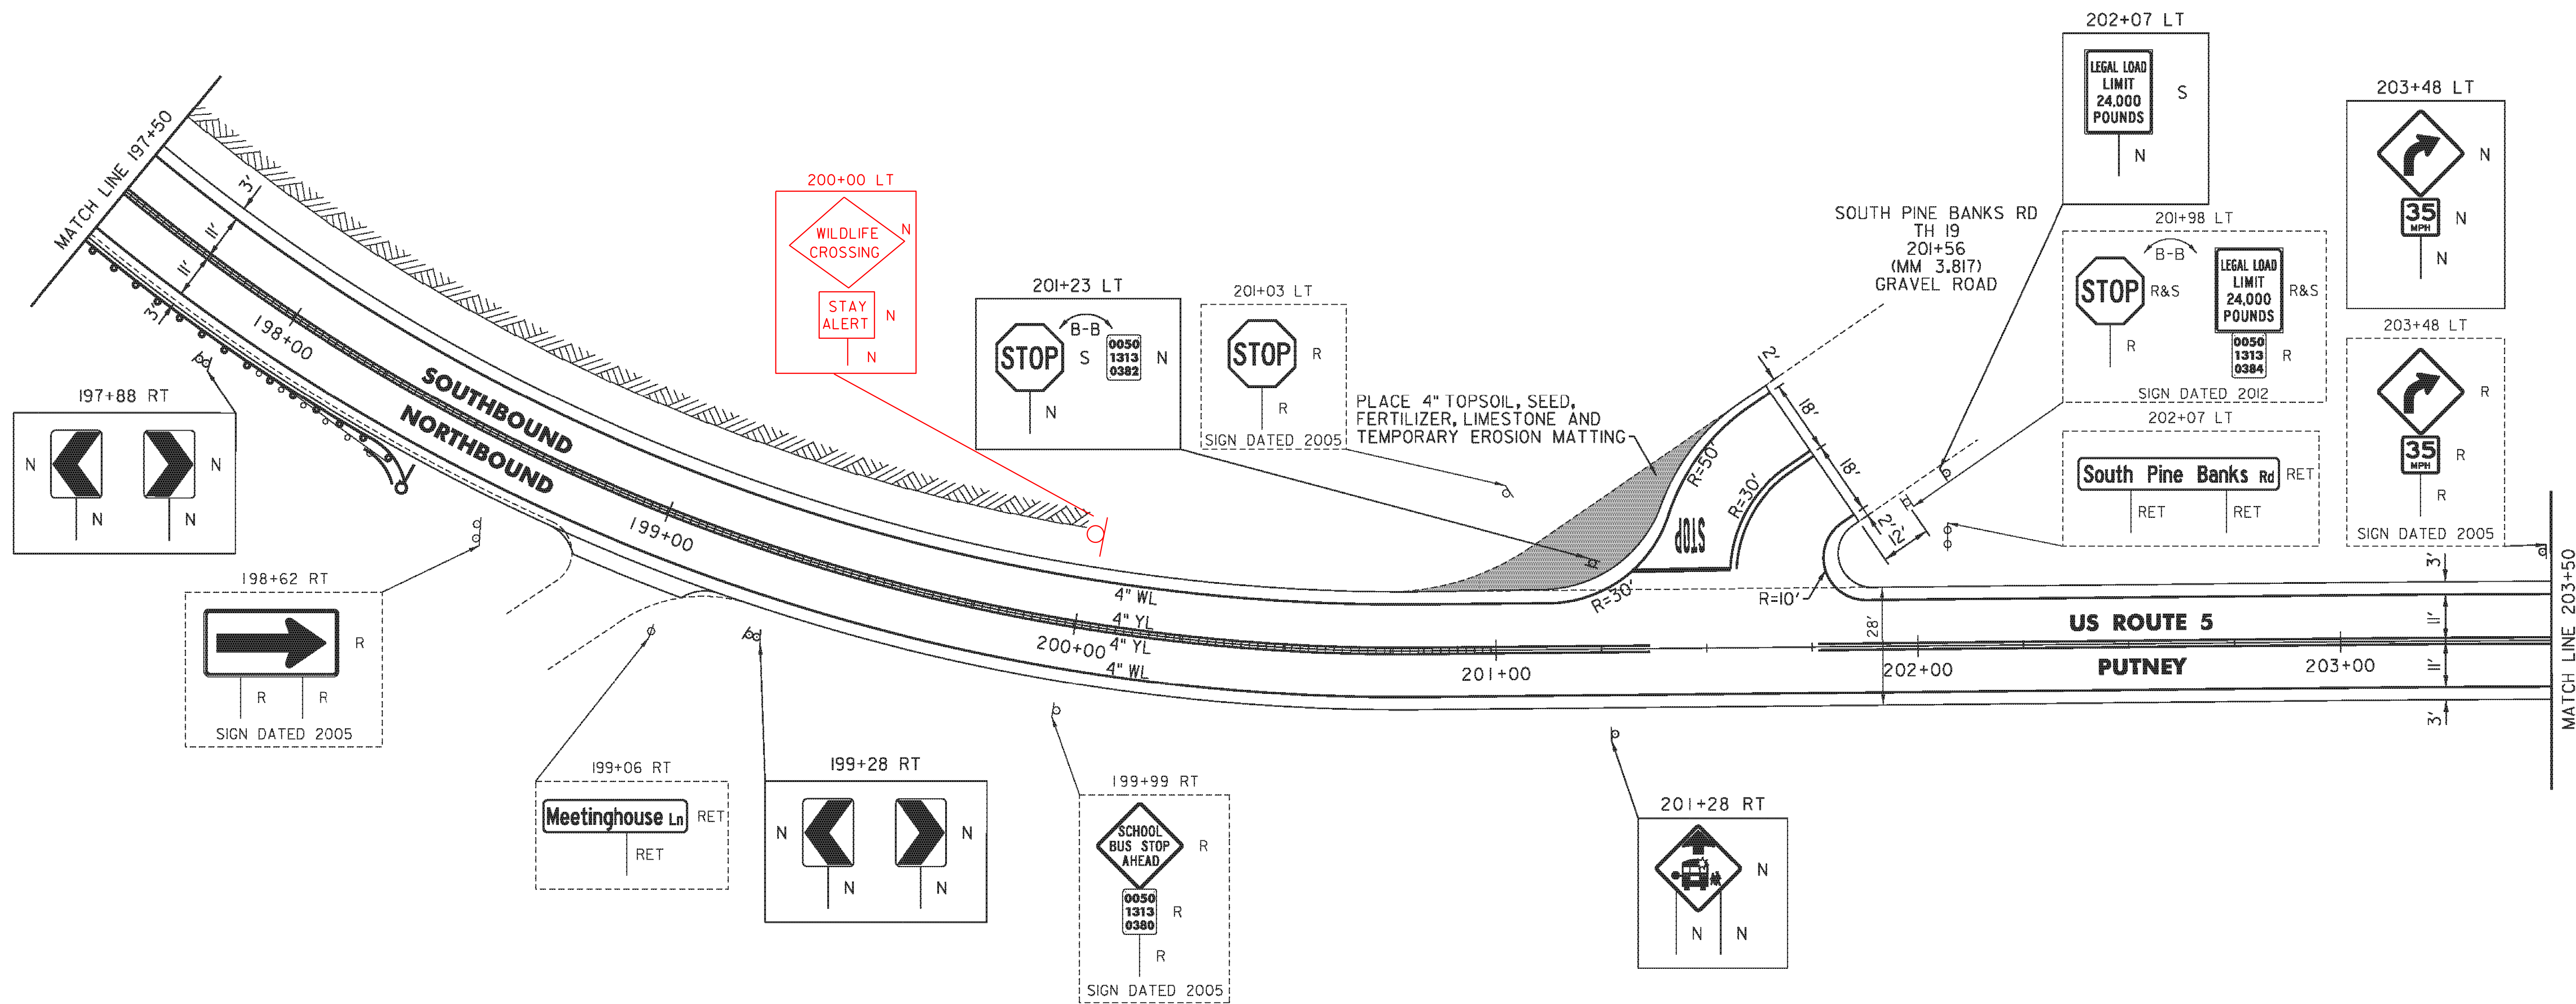

LEGEND

R	= REMOVE EXISTING
S	= SALVAGE
R&S	= REMOVE AND SALVAGE
N	= NEW
RET	= RETAIN
B-B	= BACK TO BACK
---	= EXISTING GUARDRAIL
---	= PROPOSED GUARDRAIL
---	= YELLOW LINE
---	= WHITE LINE
---	= DELINEATOR
---	= UTILITY POLE

PROJECT NAME:	PUTNEY-WESTMINSTER	FILE NAME:	zllc344bdr.dgn	PLOT DATE:	12/10/2013
PROJECT NUMBER:	STP 2946(I)	PROJECT LEADER:	P. SHEDD	DRAWN BY:	W. GORDON
		DESIGNED BY:	N. LEMAY	CHECKED BY:	P. SHEDD
		ROADWAY LAYOUT 21 US 5		SHEET	42 OF 138

NOT TO SCALE