

TEMPORARY 4 INCH WHITE LINE, PAINT
 DURABLE 4 INCH WHITE LINE (OPTION BID ITEM)
 225+50 TO 236+50 SOLID LT & RT

TEMPORARY 4 INCH YELLOW LINE, PAINT
 DURABLE 4 INCH YELLOW LINE, POLYUREA
 225+50 TO 236+50 SOLID LT & RT

STEEL BEAM GUARDRAIL, GALVANIZED
 228+68 TO 230+30.5 LT
 226+96 TO 227+08.5 RT
 229+33.5 TO 229+46 RT

STEEL BEAM GUARDRAIL,
 GALVANIZED W/8 FEET POSTS
 227+08.5 TO 229+33.5 RT

ANCHOR FOR STEEL BEAM RAIL
 226+96 RT
 228+68 LT
 229+46 RT
 230+30.5 LT

REMOVAL AND DISPOSAL OF GUARDRAIL
 228+09 TO 229+46 RT
 228+68 TO 229+46 LT



DELINEATOR WITH STEEL POST
 226+96 RT
 228+68 LT
 229+46 RT
 230+30.5 LT

MILLED RUMBLE STRIPS
 225+50 TO 236+50 CL

REMOVING SIGNS
 AS SHOWN - 1

ERECTING SALVAGED SIGNS
 AS SHOWN - 1

SANTA'S LAND

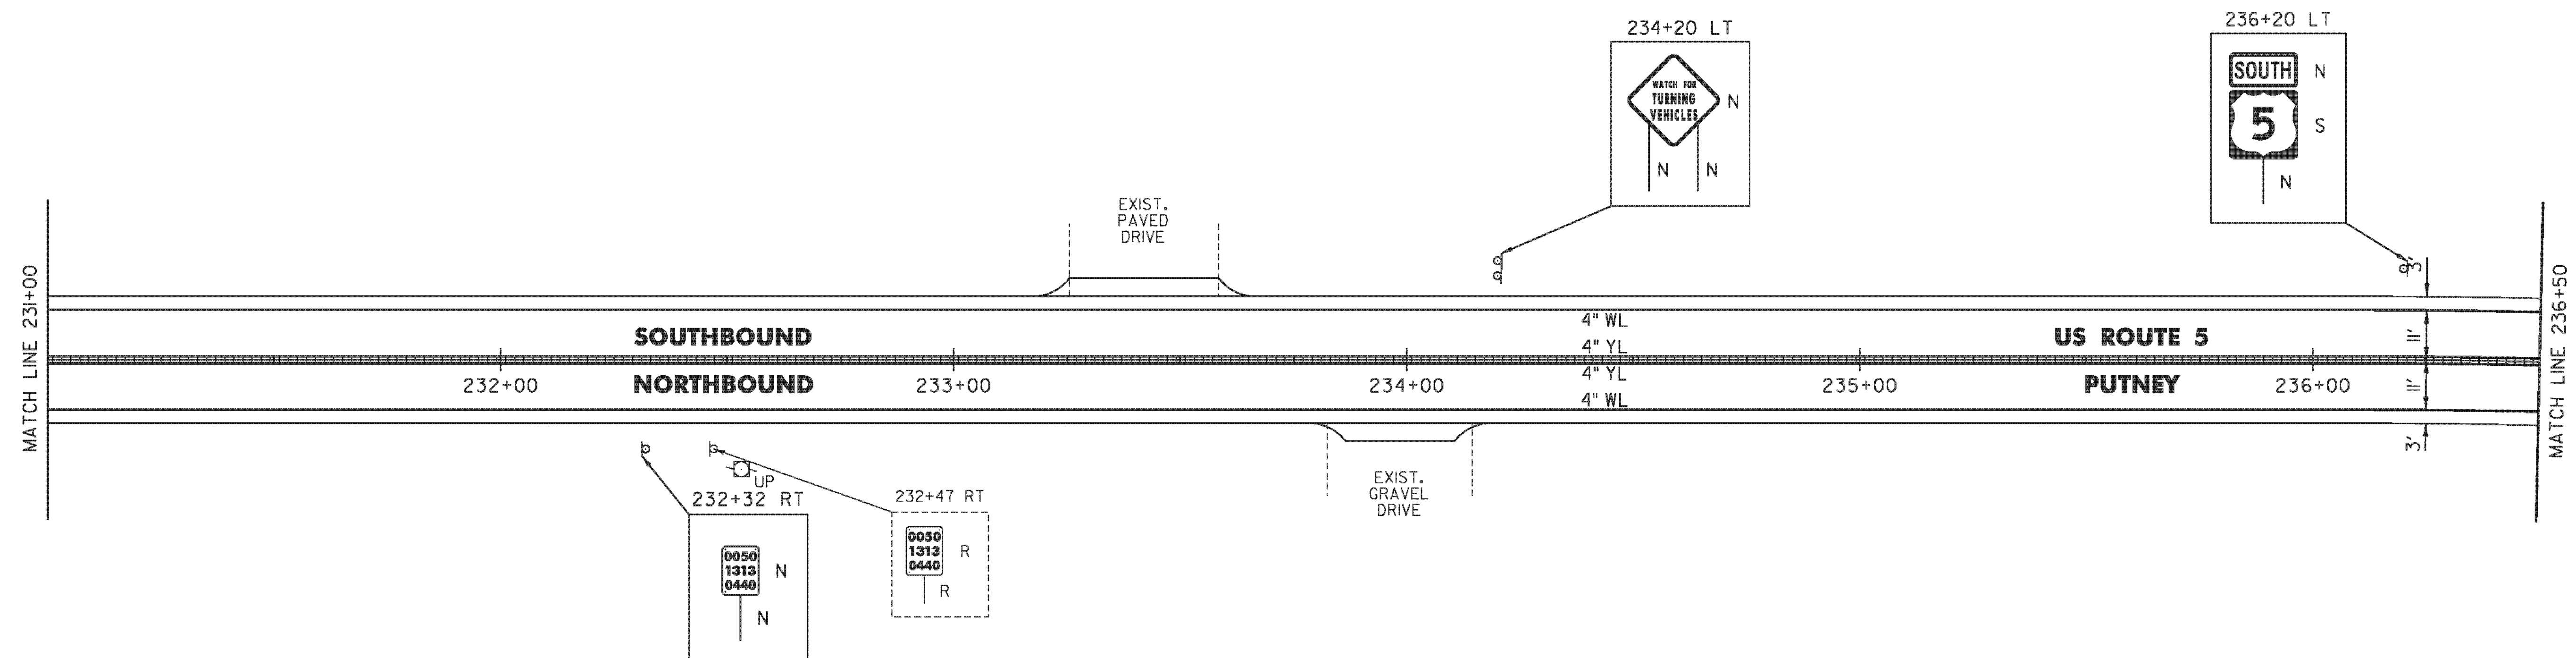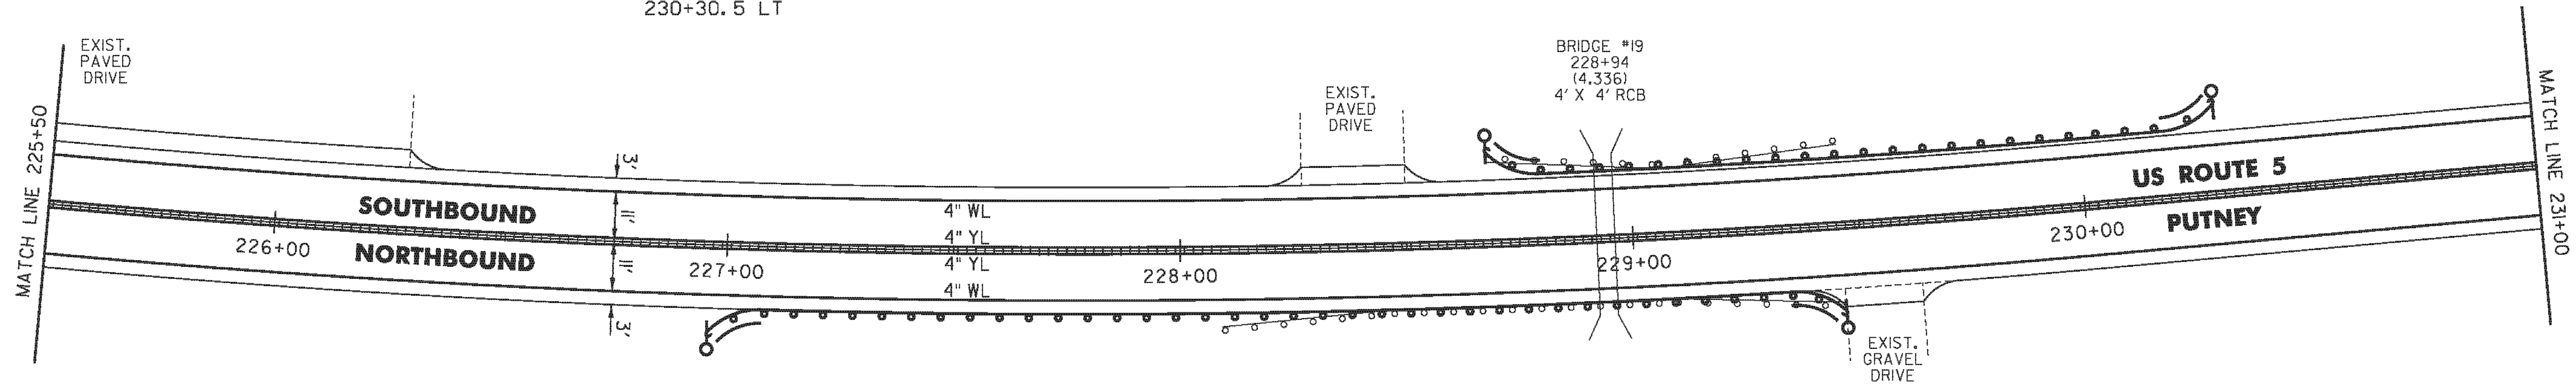

- LEGEND**
- R = REMOVE EXISTING
 - S = SALVAGE
 - R&S = REMOVE AND SALVAGE
 - N = NEW
 - RET = RETAIN
 - B-B = BACK TO BACK
 - = EXISTING GUARDRAIL
 - = PROPOSED GUARDRAIL
 - YL = YELLOW LINE
 - WL = WHITE LINE
 - = DELINEATOR
 - = UTILITY POLE

PROJECT NAME: PUTNEY-WESTMINSTER

PROJECT NUMBER: STP 2946(1)

FILE NAME: zllc344bdr.dgn

PROJECT LEADER: P. SHEDD

DESIGNED BY: N. LEMAY

ROADWAY LAYOUT 24 US 5

PLOT DATE: 12/10/2013

DRAWN BY: W. GORDON

CHECKED BY: P. SHEDD

SHEET 45 OF 138

NOT TO SCALE