

TEMPORARY 4 INCH WHITE LINE, PAINT  
 DURABLE 4 INCH WHITE LINE (OPTION BID ITEM)  
 236+50 TO 237+91 SOLID LT  
 236+50 TO 242+50 SOLID RT  
 237+91 TO 238+20 SOLID LT (TH 64)  
 238+44 TO 239+02 SOLID LT (TH 64/65)  
 239+11 TO 239+14 SOLID LT (TH 65)  
 239+14 TO 242+50 SOLID LT

TEMPORARY 4 INCH YELLOW LINE, PAINT  
 236+50 TO 238+30 SOLID LT & RT  
 238+33 TO 238+37 DOUBLE SOLID LT (TH 64)  
 238+70 TO 242+50 SOLID LT & RT  
 238+71 TO 239+07 DOUBLE SOLID LT (TH 65)

DURABLE 4 INCH YELLOW LINE (OPTION BID ITEM)  
 237+75 TO 238+30 SOLID LT & RT  
 238+33 TO 238+37 DOUBLE SOLID LT (TH 64)  
 238+70 TO 241+50 SOLID LT & RT  
 238+71 TO 239+07 DOUBLE SOLID LT (TH 65)

DURABLE 4 INCH YELLOW LINE, POLYUREA  
 236+50 TO 237+75 SOLID LT & RT  
 241+50 TO 242+50 SOLID LT & RT


TEMPORARY 24 INCH STOP BAR, PAINT  
 DURABLE 24 INCH STOP BAR (OPTION BID ITEM)  
 238+12 TO 238+36 LT (TH 64)  
 238+66 TO 238+70 LT (TH 65)

MILLED RUMBLE STRIPS  
 236+50 TO 237+75 CL  
 241+50 TO 242+50 CL

TEMPORARY LETTER OR SYMBOL, PAINT  
 DURABLE LETTER OR SYMBOL (OPTION BID ITEM)  
 238+28 LT - STOP (TH 64)  
 238+76 LT - STOP (TH 65)

REMOVING SIGNS  
 AS SHOWN - 8

ERECTING SALVAGED SIGNS  
 AS SHOWN - 1

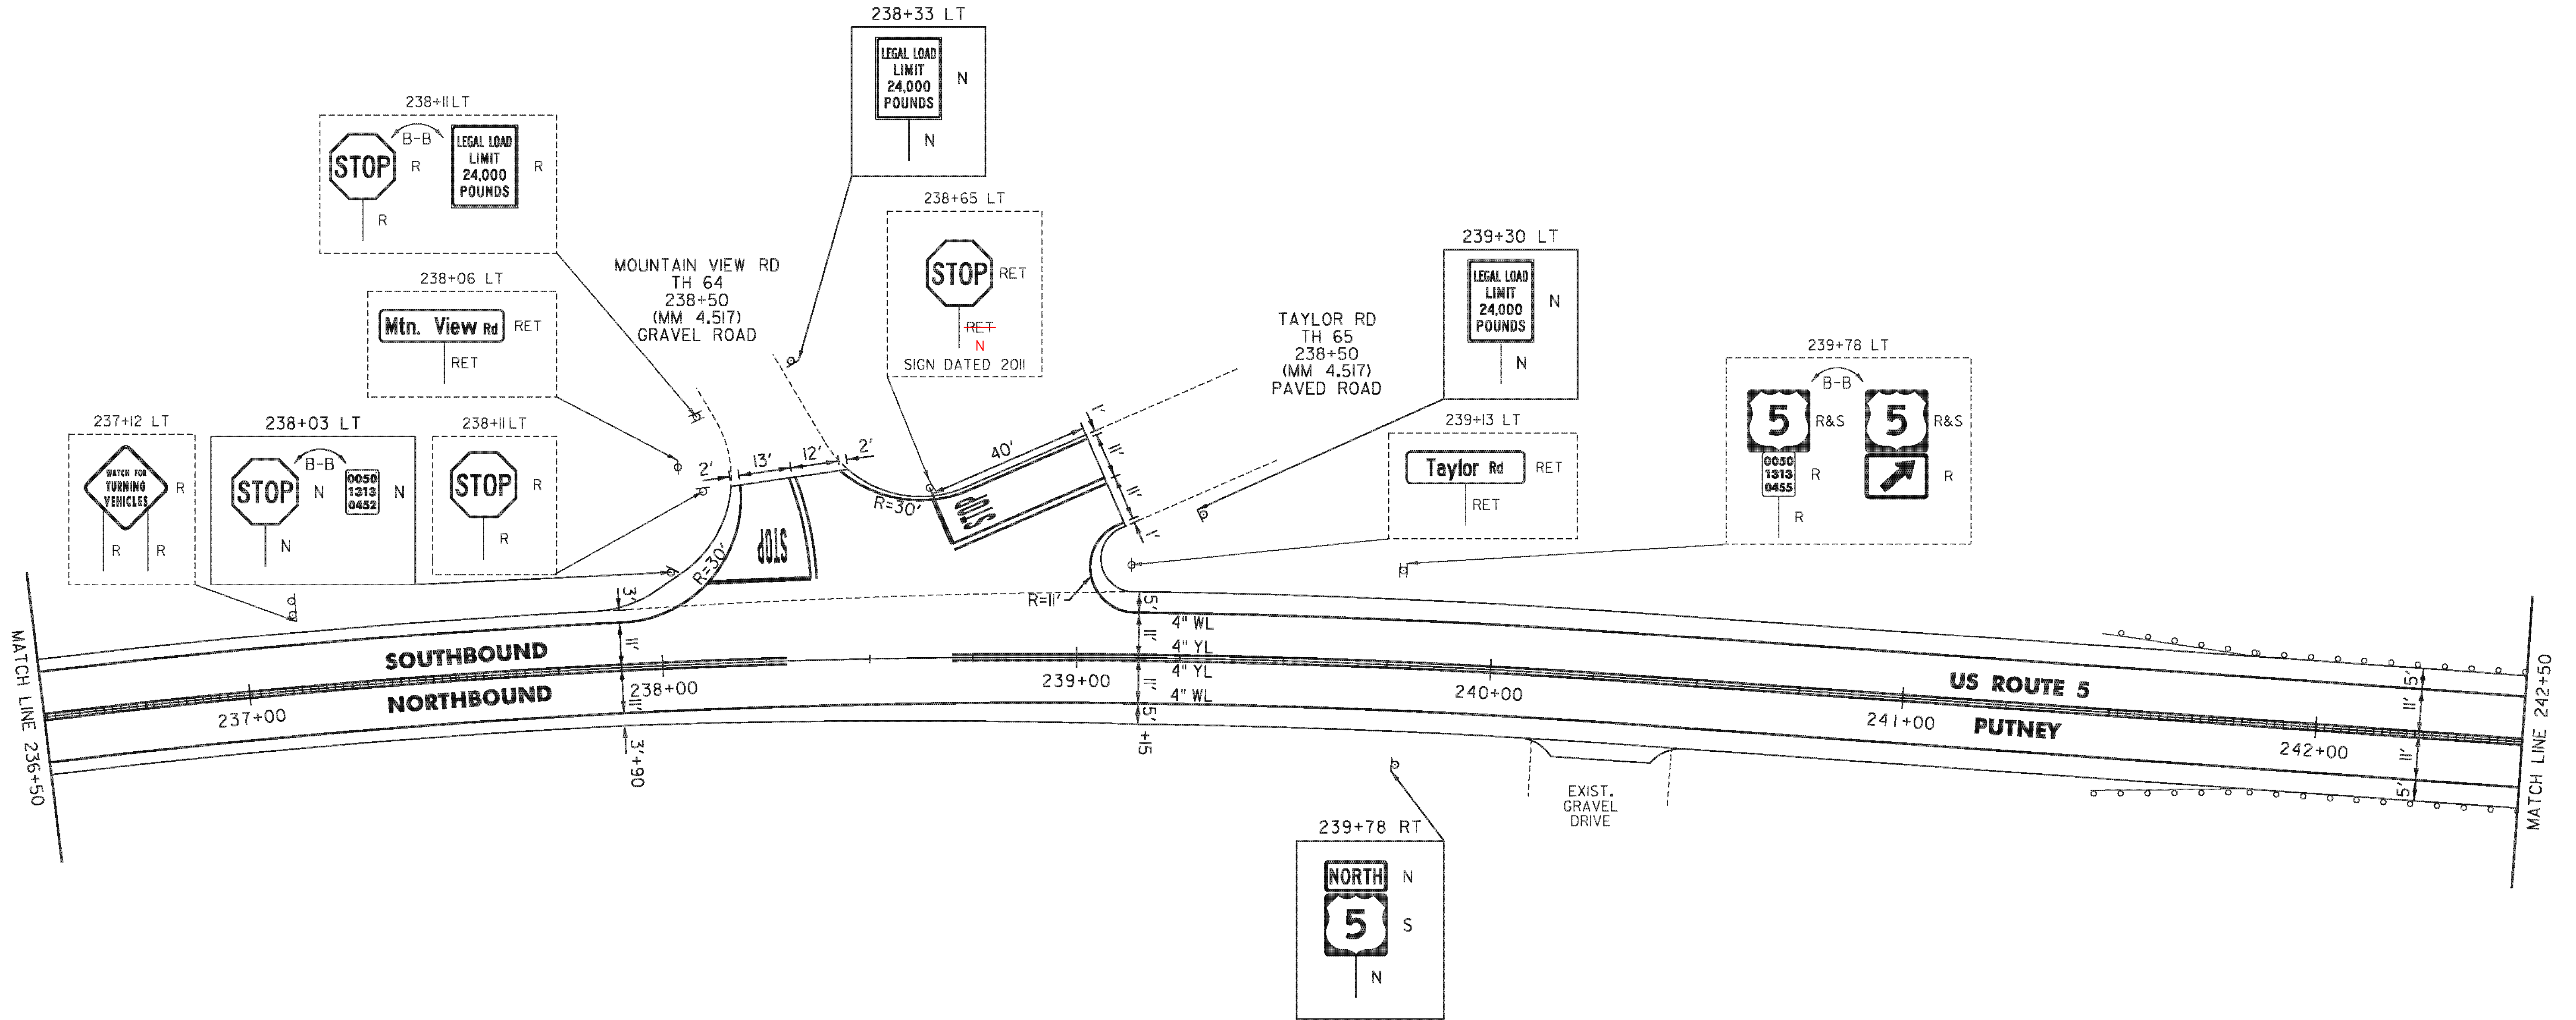

NOT TO SCALE

- LEGEND**
- R = REMOVE EXISTING
  - S = SALVAGE
  - R&S = REMOVE AND SALVAGE
  - N = NEW
  - RET = RETAIN
  - B-B = BACK TO BACK
  - = EXISTING GUARDRAIL
  - = PROPOSED GUARDRAIL
  - YL = YELLOW LINE
  - WL = WHITE LINE
  - = DELINEATOR
  - = UTILITY POLE

PROJECT NAME:	PUTNEY-WESTMINSTER
PROJECT NUMBER:	STP 2946(I)
FILE NAME:	zllc344bdr.dgn
PROJECT LEADER:	P. SHEDD
DESIGNED BY:	N. LEMAY
ROADWAY LAYOUT:	25 US 5
PLOT DATE:	12/10/2013
DRAWN BY:	W. GORDON
CHECKED BY:	P. SHEDD
SHEET:	46 OF 138