

TEMPORARY 4 INCH WHITE LINE, PAINT
 DURABLE 4 INCH WHITE LINE (OPTION BID ITEM)
 266+50 TO 278+50 SOLID LT & RT



TEMPORARY 4 INCH YELLOW LINE, PAINT
 266+50 TO 278+50 SOLID LT & RT
 DURABLE 4 INCH YELLOW LINE (OPTION BID ITEM)
 269+75 TO 273+25 SOLID LT & RT
 DURABLE 4 INCH YELLOW LINE, POLYUREA
 266+50 TO 269+75 SOLID LT & RT
 273+25 TO 278+50 SOLID LT & RT

STEEL BEAM GUARDRAIL, GALVANIZED
 266+50 TO 267+41.5 LT
 272+98 TO 273+35.5 RT
 276+97 TO 277+34.5 LT
 ANCHOR FOR STEEL BEAM RAIL
 267+41.5 LT
 272+98 RT
 276+97 LT

REMOVAL AND DISPOSAL OF GUARDRAIL
 266+50 TO 267+40 LT
 272+98 TO 273+35.5 RT
 276+97 TO 277+34.5 LT
 DELINEATOR WITH STEEL POST
 267+41.5 LT
 272+98 RT
 276+97 LT

MILLED RUMBLE STRIPS
 266+50 TO 269+75 CL
 273+25 TO 278+50 CL
 REMOVING SIGNS
 AS SHOWN - 1

REHAB. DROP INLETS, CATCH BASINS,
 OR MANHOLES, CLASS I, CLASS II
 277+51 RT

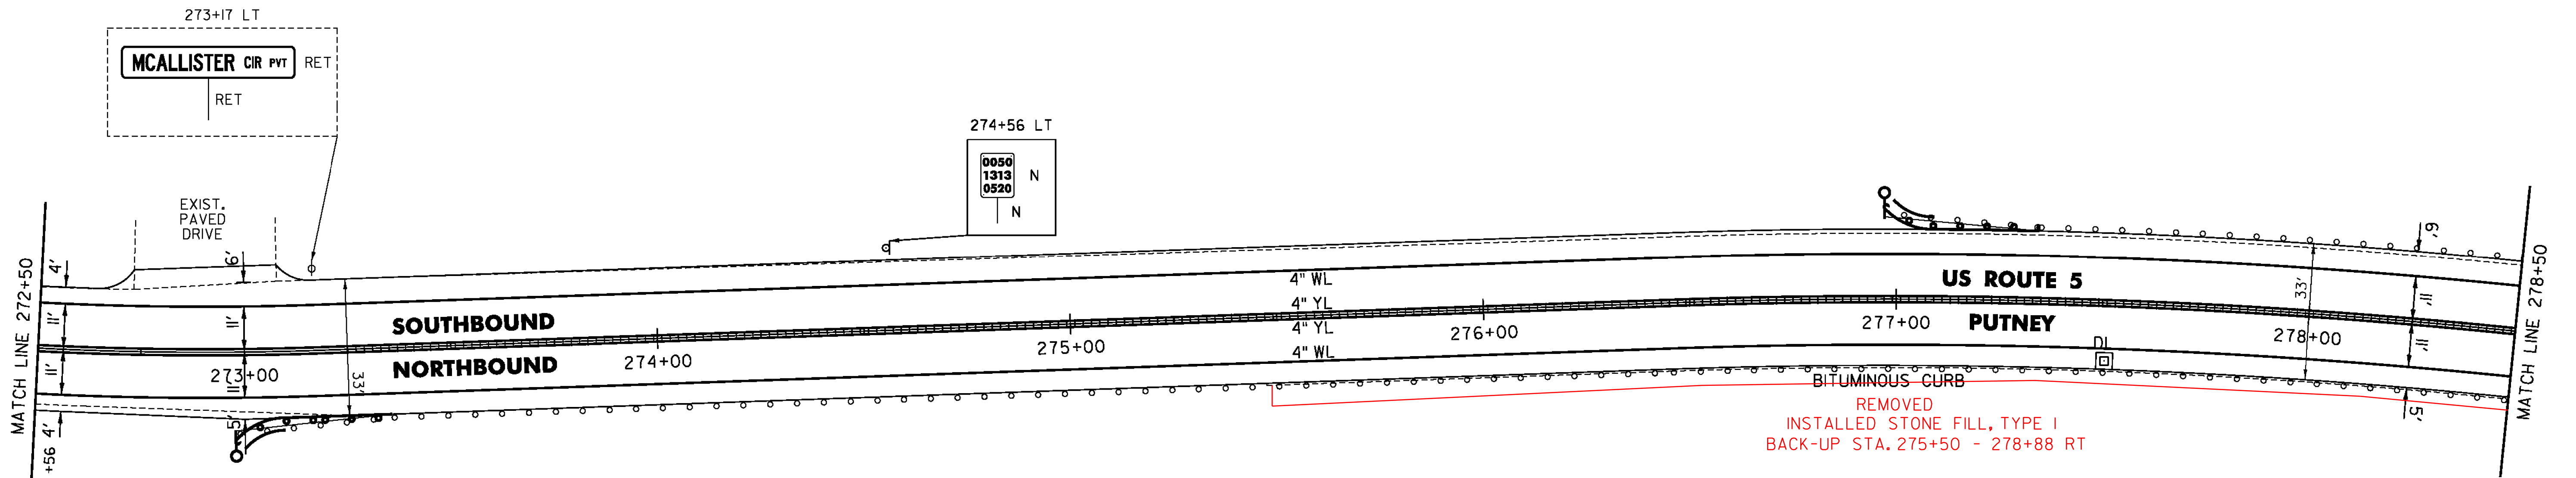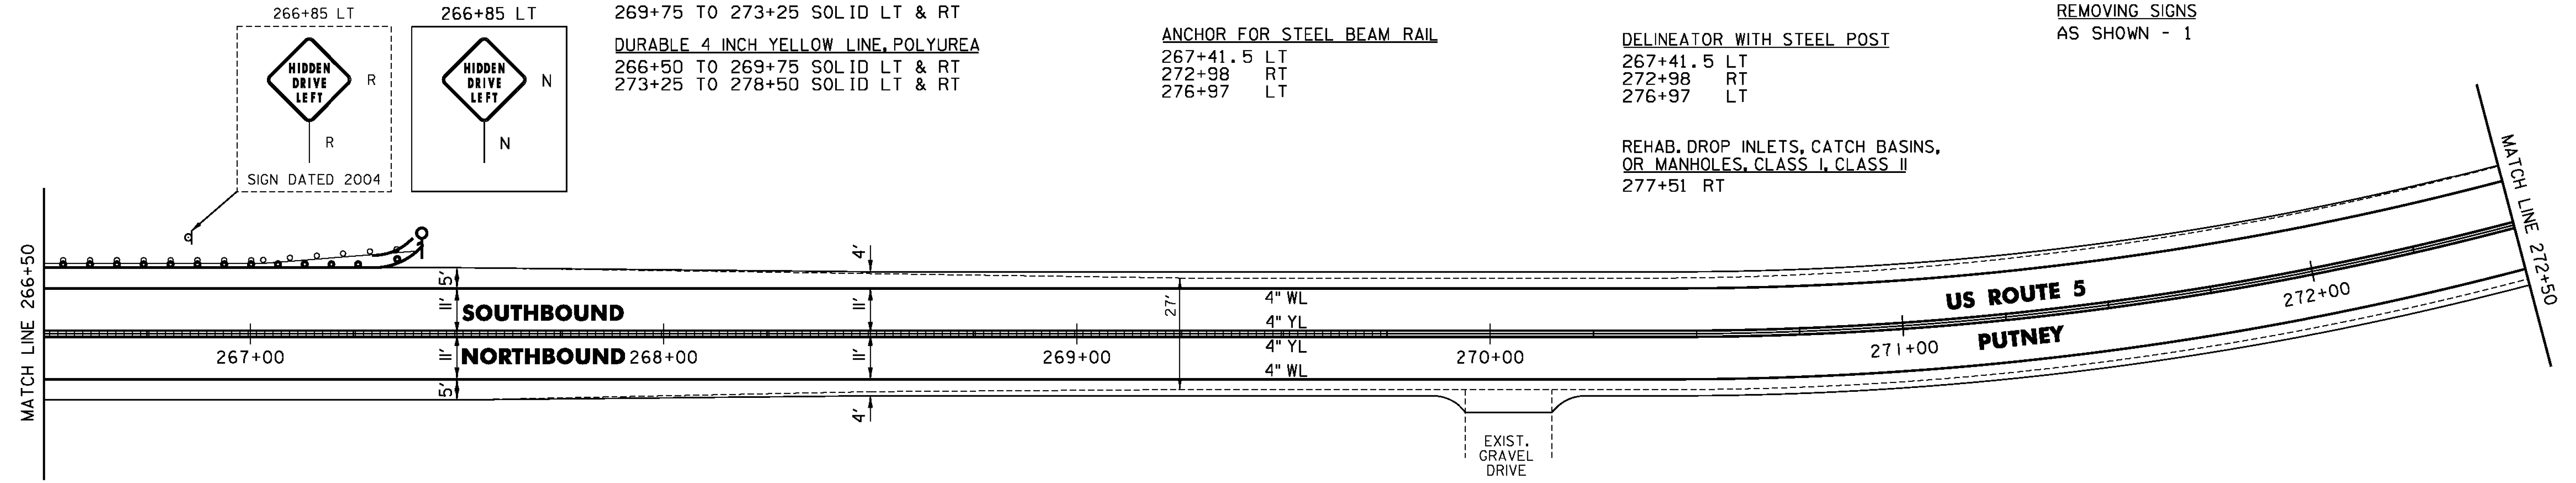

- LEGEND**
- R = REMOVE EXISTING
 - S = SALVAGE
 - R&S = REMOVE AND SALVAGE
 - N = NEW
 - RET = RETAIN
 - B-B = BACK TO BACK
 - = EXISTING GUARDRAIL
 - = PROPOSED GUARDRAIL
 - YL = YELLOW LINE
 - WL = WHITE LINE
 - = DELINEATOR
 - = UTILITY POLE

PROJECT NAME:	PUTNEY-WESTMINSTER	FILE NAME:	zllc344bdr.dgn	PLOT DATE:	12/10/2013
PROJECT NUMBER:	STP 2946(I)	PROJECT LEADER:	P. SHEDD	DRAWN BY:	W. GORDON
		DESIGNED BY:	N. LEMAY	CHECKED BY:	P. SHEDD
		ROADWAY LAYOUT	30 US 5	SHEET	51 OF 138

NOT TO SCALE