


TEMPORARY 4 INCH WHITE LINE, PAINT
 DURABLE 4 INCH WHITE LINE (OPTION BID ITEM)
 W78+50 TO W83+50 SOLID LT
 W78+50 TO W79+65 SOLID RT
 W80+45 TO W83+50 SOLID RT

TEMPORARY 4 INCH YELLOW LINE, PAINT
 DURABLE 4 INCH YELLOW LINE, POLYUREA
 W78+50 TO W79+85 SOLID LT & RT
 W80+25 TO W83+50 SOLID LT & RT

MILLED RUMBLE STRIPS
 W78+50 TO W79+85 CL
 W80+25 TO W83+50 CL

REMOVING SIGNS
 AS SHOWN - 6

ERECTING SALVAGED SIGNS
 AS SHOWN - 2

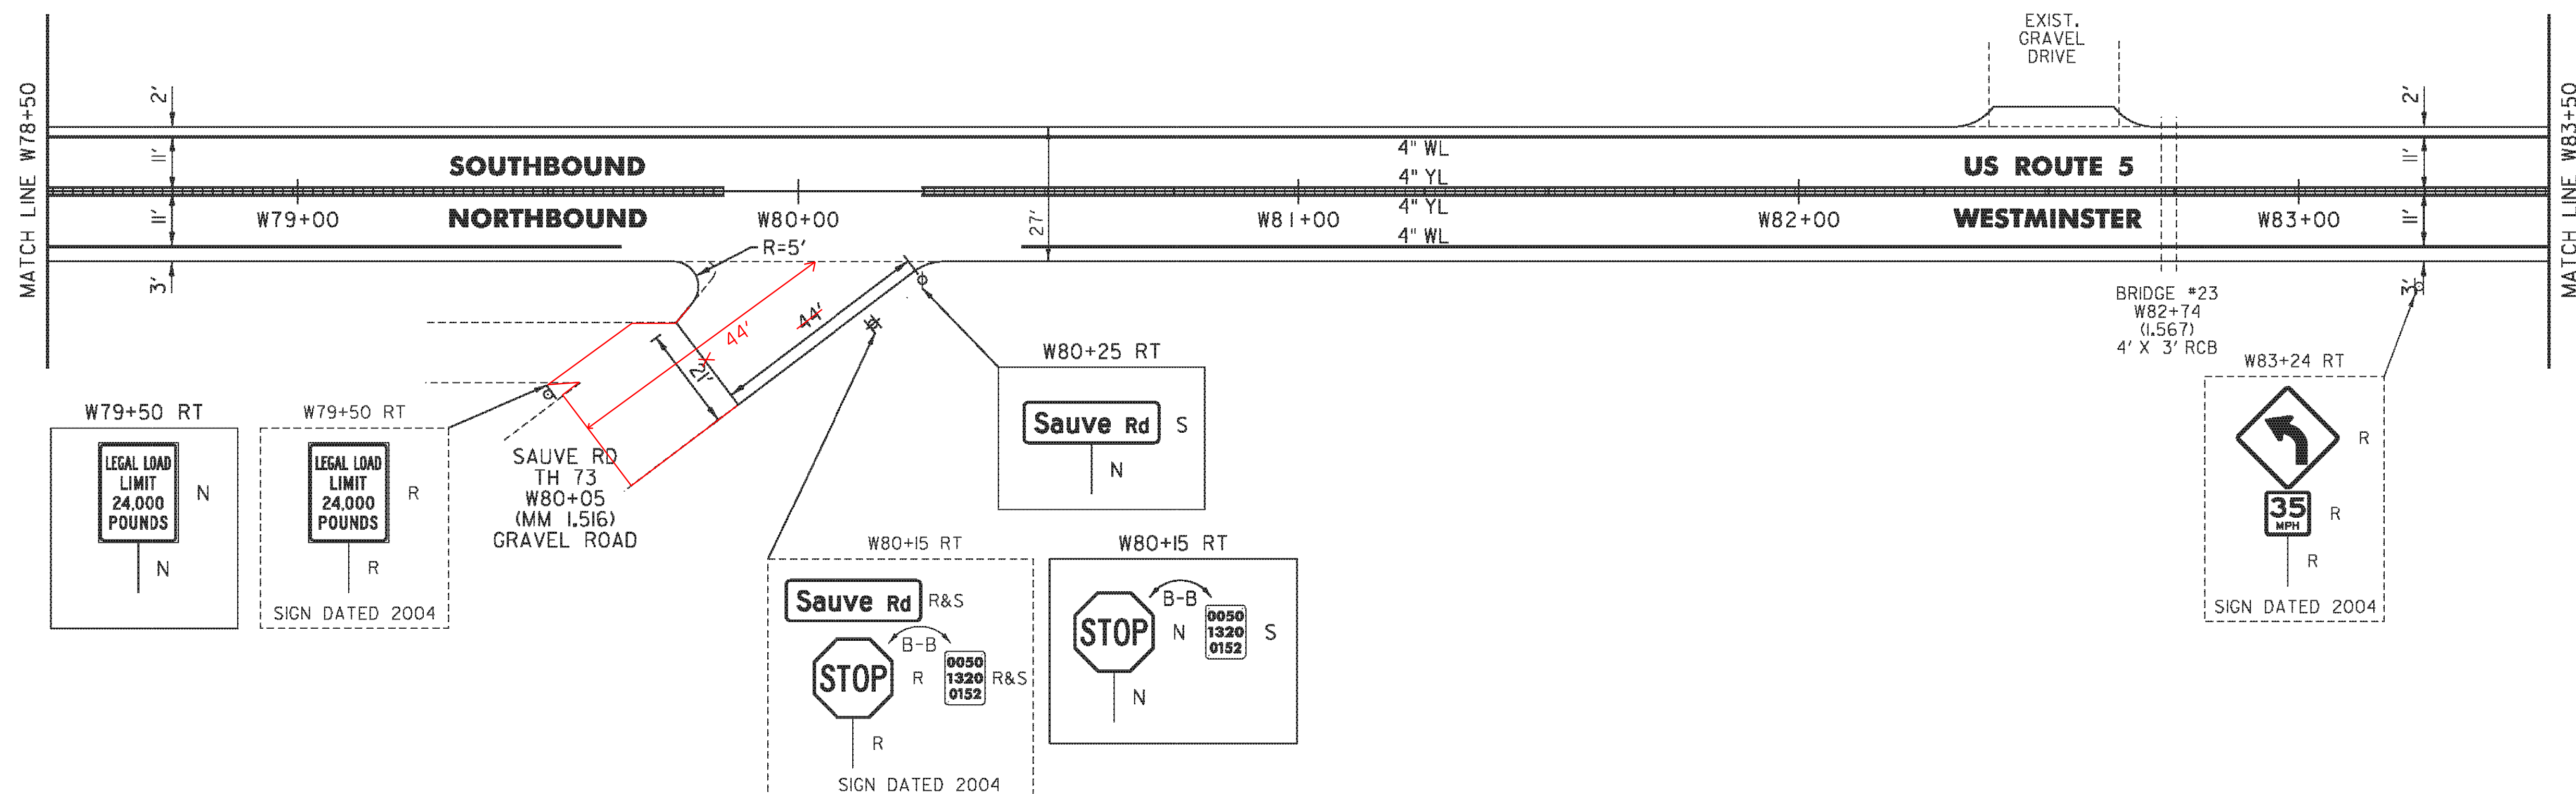

NOT TO SCALE

- LEGEND**
- R = REMOVE EXISTING
 - S = SALVAGE
 - R&S = REMOVE AND SALVAGE
 - N = NEW
 - RET = RETAIN
 - B-B = BACK TO BACK
 - = EXISTING GUARDRAIL
 - - - = PROPOSED GUARDRAIL
 - YL = YELLOW LINE
 - WL = WHITE LINE
 - | — = DELINEATOR
 - | — | — = UTILITY POLE

PROJECT NAME: PUTNEY-WESTMINSTER

PROJECT NUMBER: STP 2946(I)

FILE NAME: zllc344bdr.dgn
 PROJECT LEADER: P. SHEDD
 DESIGNED BY: N. LEMAY
 ROADWAY LAYOUT 40 US 5

PLOT DATE: 12/10/2013
 DRAWN BY: W. GORDON
 CHECKED BY: P. SHEDD
 SHEET 61 OF 138