


TEMPORARY 4 INCH WHITE LINE, PAINT
 DURABLE 4 INCH WHITE LINE (OPTION BID ITEM)
 W152+50 TO W158+50 SOLID LT
 W152+50 TO W154+30 SOLID RT
 W155+10 TO W158+50 SOLID RT

TEMPORARY 4 INCH YELLOW LINE, PAINT
 W152+50 TO W154+50 SOLID LT & RT
 W154+90 TO W158+50 SOLID LT & RT
 DURABLE 4 INCH YELLOW LINE (OPTION BID ITEM)
 W154+25 TO W154+50 SOLID LT & RT
 W154+90 TO W158+50 SOLID LT & RT
 DURABLE 4 INCH YELLOW LINE, POLYUREA
 W152+50 TO W154+25 SOLID LT & RT

REHAB. DROP INLETS, CATCH BASINS,
 OR MANHOLES, CLASS I
 W157+50 LT
 MILLED RUMBLE STRIPS
 W152+50 TO W154+25 CL

REMOVING SIGNS
 AS SHOWN - 7
 ERECTING SALVAGED SIGNS
 AS SHOWN - 1

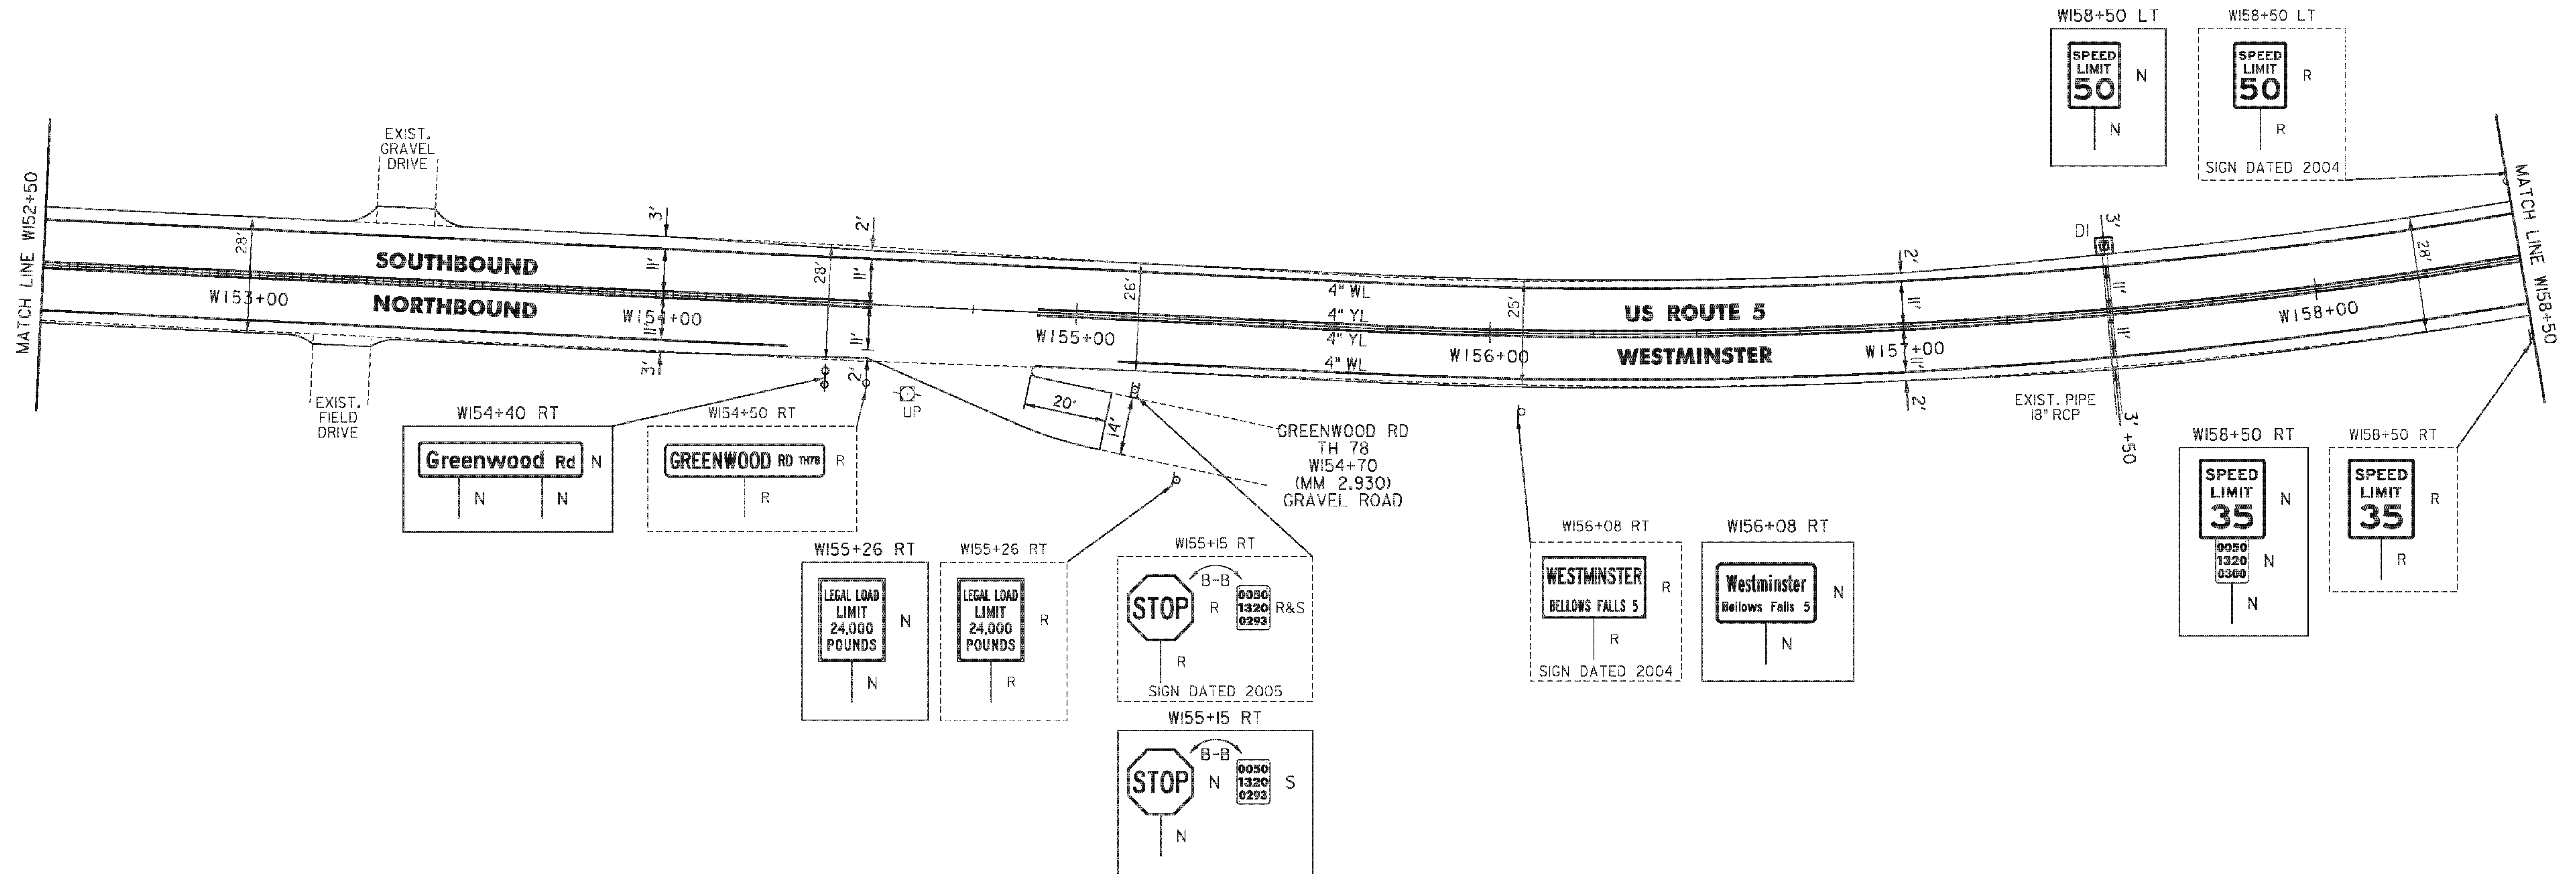

NOT TO SCALE

- LEGEND**
- R = REMOVE EXISTING
 - S = SALVAGE
 - R&S = REMOVE AND SALVAGE
 - N = NEW
 - RET = RETAIN
 - B-B = BACK TO BACK
 - = EXISTING GUARDRAIL
 - = PROPOSED GUARDRAIL
 - YL = YELLOW LINE
 - WL = WHITE LINE
 - = DELINEATOR
 - ⊕ = UTILITY POLE

PROJECT NAME: PUTNEY-WESTMINSTER
 PROJECT NUMBER: STP 2946(1)
 FILE NAME: zllc344bdr.dgn
 PROJECT LEADER: P. SHEDD
 DESIGNED BY: N. LEMAY
 ROADWAY LAYOUT 49 US 5
 PLOT DATE: 12/10/2013
 DRAWN BY: W. GORDON
 CHECKED BY: P. SHEDD
 SHEET 70 OF 138