

TEMPORARY 4 INCH WHITE LINE, PAINT  
 DURABLE 4 INCH WHITE LINE (OPTION BID ITEM)  
 W208+50 TO W220+50 SOLID LT & RT

TEMPORARY 4 INCH YELLOW LINE, PAINT  
 DURABLE 4 INCH YELLOW LINE (OPTION BID ITEM)  
 W208+50 TO W218+85 SOLID LT & RT  
 W218+85 TO W220+50 DASHED LT, SOLID RT

~~CLEANING CULV. PIPE, IN PLACE  
 (0 TO 24 IN., INCL.)  
 W209+69~~

STEEL BEAM GUARDRAIL, GALVANIZED  
 W209+31 TO W209+68.5 LT  
 W215+02.5 TO W215+40 LT  
 W215+61 TO W215+98.5 LT  
 W217+80.5 TO W218+18 LT


ANCHOR FOR STEEL BEAM RAIL  
 W209+31 LT  
 W215+40 LT  
 W215+61 LT  
 W218+18 LT

REMOVAL AND DISPOSAL OF GUARDRAIL  
 W209+31 TO W209+68.5 LT  
 W215+02.5 TO W215+40 LT  
 W215+61 TO W215+98.5 LT  
 W217+80.5 TO W218+18 LT

REMOVING SIGNS  
 AS SHOWN - 4

DELINEATOR WITH STEEL POST  
 W209+31 LT  
 W215+40 LT  
 W215+61 LT  
 W218+18 LT

~~REMOVAL OF EXISTING CURB  
 W208+84 TO W209+31 RT  
 W209+99 TO W210+24 RT~~  
 REMOVED CURB DOWN TO  
 EXISTING GROUND ELEV.

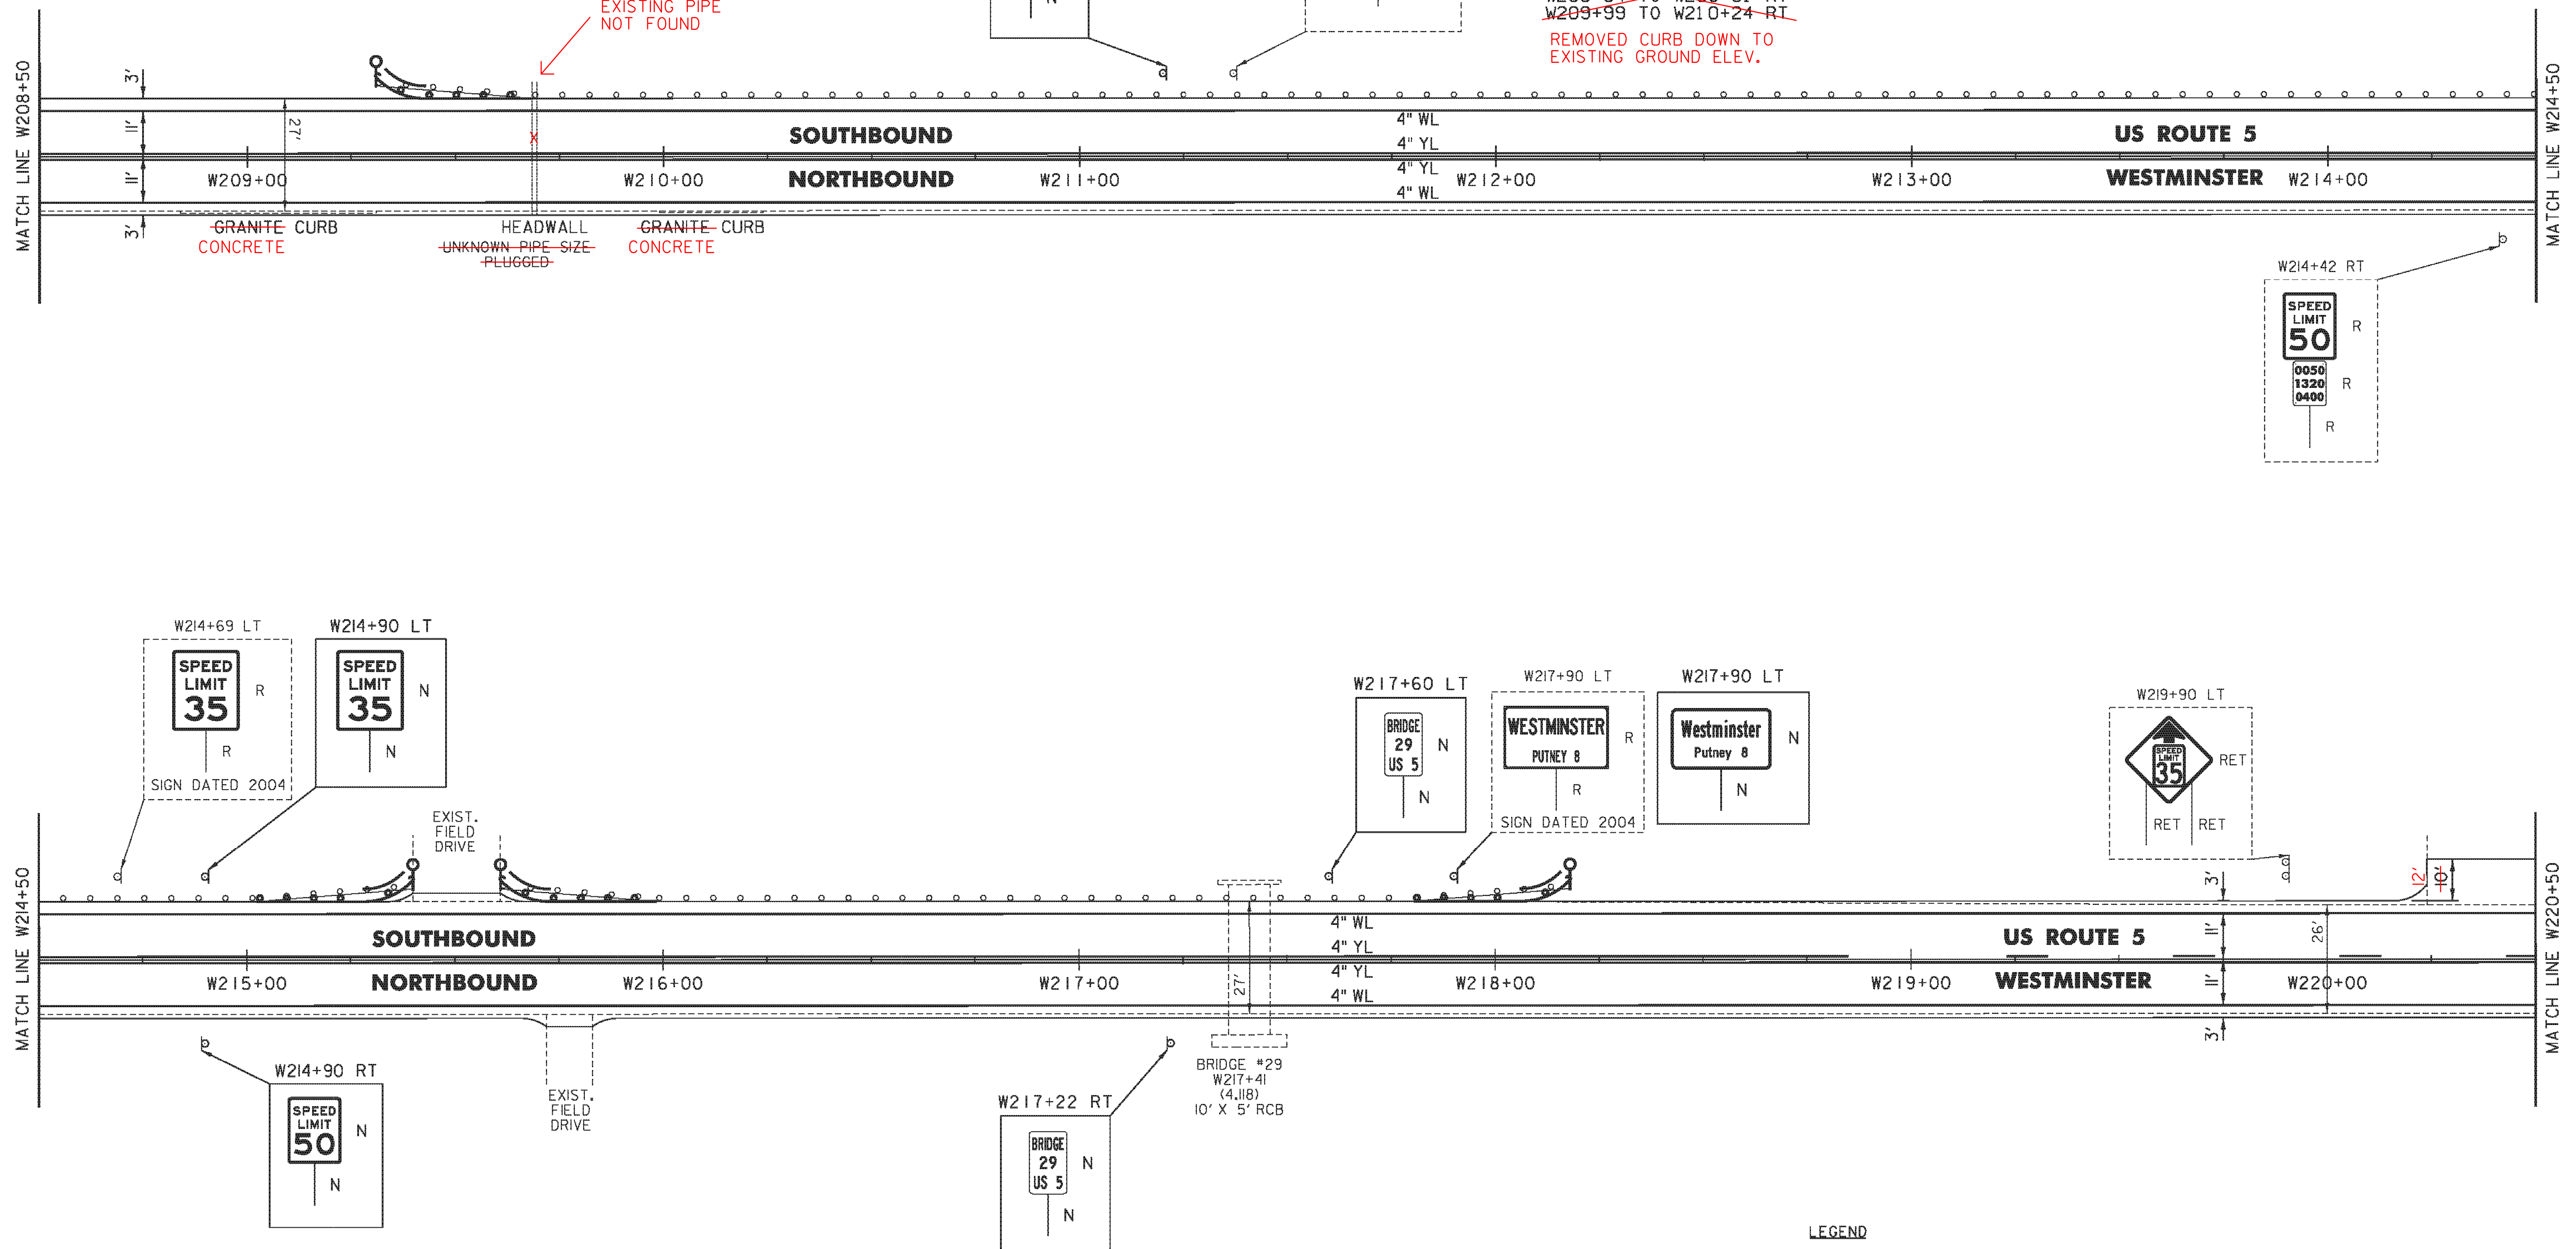

NOT TO SCALE

- LEGEND**
- R = REMOVE EXISTING
  - S = SALVAGE
  - R&S = REMOVE AND SALVAGE
  - N = NEW
  - RET = RETAIN
  - B-B = BACK TO BACK
  - = EXISTING GUARDRAIL
  - = PROPOSED GUARDRAIL
  - = YELLOW LINE
  - = WHITE LINE
  - = DELINEATOR
  - = UTILITY POLE

PROJECT NAME: PUTNEY-WESTMINSTER  
 PROJECT NUMBER: STP 2946(I)

FILE NAME: zllc344bdr.dgn  
 PROJECT LEADER: P. SHEDD  
 DESIGNED BY: N. LEMAY  
 ROADWAY LAYOUT 56 US 5

PLOT DATE: 12/10/2013  
 DRAWN BY: W. GORDON  
 CHECKED BY: P. SHEDD  
 SHEET 77 OF 138