

TEMPORARY 4 INCH WHITE LINE, PAINT
 DURABLE 4 INCH YELLOW LINE (OPTION BID ITEM)
 W220+50 TO W232+50 SOLID LT & RT


TEMPORARY 4 INCH YELLOW LINE, PAINT
 DURABLE 4 INCH WHITE LINE (OPTION BID ITEM)
 W220+50 TO W225+50 DASHED LT, SOLID RT
 W225+50 TO W232+50 SOLID LT, DASHED RT

STEEL BEAM GUARDRAIL, GALVANIZED
 W228+78.5 TO W231+03.5 LT
 W229+43 TO W230+93 RT
 W231+18 TO W232+50 RT
 W231+28.5 TO W232+50 LT

STEEL BEAM GUARDRAIL,
 GALVANIZED/NESTED
 W231+03.5 TO W231+28.5 LT
 W230+93 TO W231+18 RT

ANCHOR FOR STEEL BEAM RAIL
 W228+78.5 LT
 W229+43 RT

DELINEATOR WITH STEEL POST
 W228+78.5 LT
 W229+43 RT

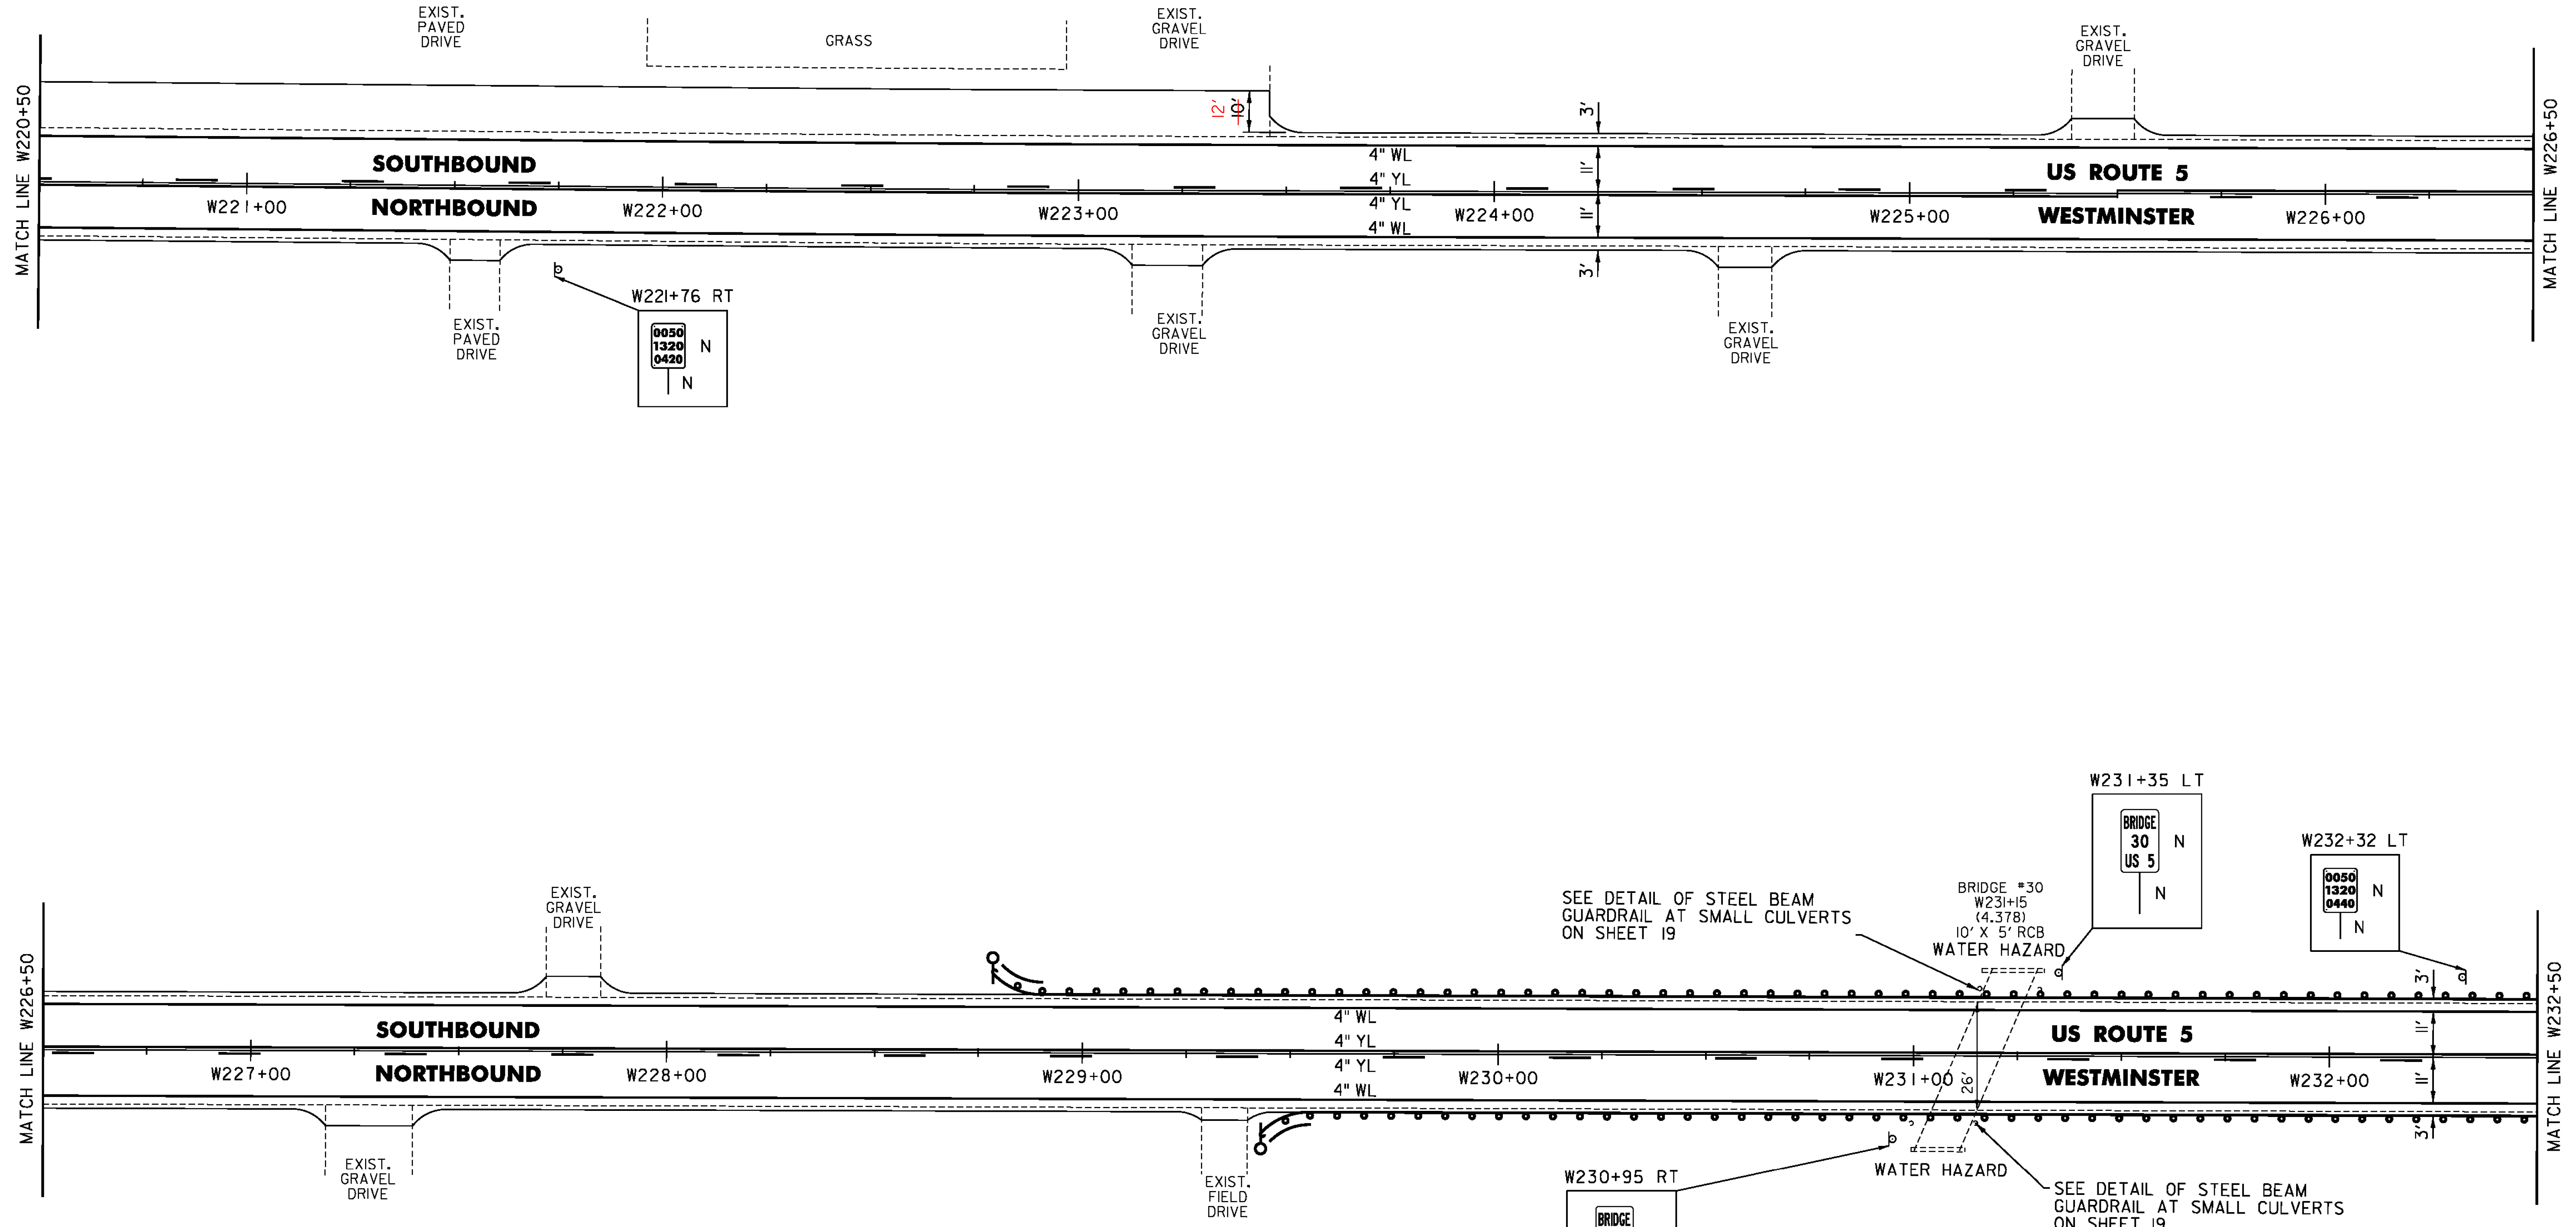

LEGEND

R	=	REMOVE EXISTING
S	=	SALVAGE
R&S	=	REMOVE AND SALVAGE
N	=	NEW
RET	=	RETAIN
B-B	=	BACK TO BACK
—○—	=	EXISTING GUARDRAIL
—○—	=	PROPOSED GUARDRAIL
—○—	=	YELLOW LINE
—○—	=	WHITE LINE
—○—	=	DELINEATOR
—○—	=	UTILITY POLE

PROJECT NAME: PUTNEY-WESTMINSTER
 PROJECT NUMBER: STP 2946(I)

FILE NAME: zllc344bdr.dgn
 PROJECT LEADER: P. SHEDD
 DESIGNED BY: N. LEMAY
 ROADWAY LAYOUT 57 US 5

PLOT DATE: 12/10/2013
 DRAWN BY: W. GORDON
 CHECKED BY: P. SHEDD
 SHEET 78 OF 138

NOT TO SCALE