

TEMPORARY 4 INCH WHITE LINE, PAINT
 DURABLE 4 INCH WHITE LINE (OPTION BID ITEM)
 W268+25 TO W274+25 SOLID LT
 W268+25 TO A3+45 SOLID RT
 W269+32 TO W273+36 SOLID RT
 A0+93 TO B2+28 SOLID LT
 A3+45 TO W274+25 SOLID RT

TEMPORARY 4 INCH YELLOW LINE, PAINT
 DURABLE 4 INCH YELLOW LINE (OPTION BID ITEM)
 W268+25 TO W268+60 SOLID LT & RT
 W269+00 TO W273+67 SOLID LT & RT
 W274+07 TO W274+25 SOLID LT & RT
 A1+05 TO A2+75 SOLID LT & RT
 B0+25 TO B2+35 SOLID LT & RT

TEMPORARY 24" STOP BAR, PAINT
 DURABLE 24" STOP BAR (OPTION BID ITEM)
 A1+05 LT
 B2+35 RT

TEMPORARY LETTER OR SYMBOL, PAINT
 DURABLE LETTER OR SYMBOL (OPTION BID ITEM)
 A1+13 LT - "STOP"
 B0+26 LT - YIELD MARKINGS (3)
 B2+27 RT - "STOP"


STEEL BEAM GUARDRAIL, GALVANIZED
 W270+00 TO W270+37.5 RT
 W272+33.5 TO W272+71 RT

ANCHOR FOR STEEL BEAM RAIL
 W270+00 RT
 W272+71 RT

REMOVAL AND DISPOSAL OF GUARDRAIL
 W270+00 TO W270+37.5 RT
 W272+33.5 TO W272+71 RT

DELINEATOR WITH STEEL POST
 W270+00 RT
 W272+71 RT

REMOVING SIGNS
 AS SHOWN - 36

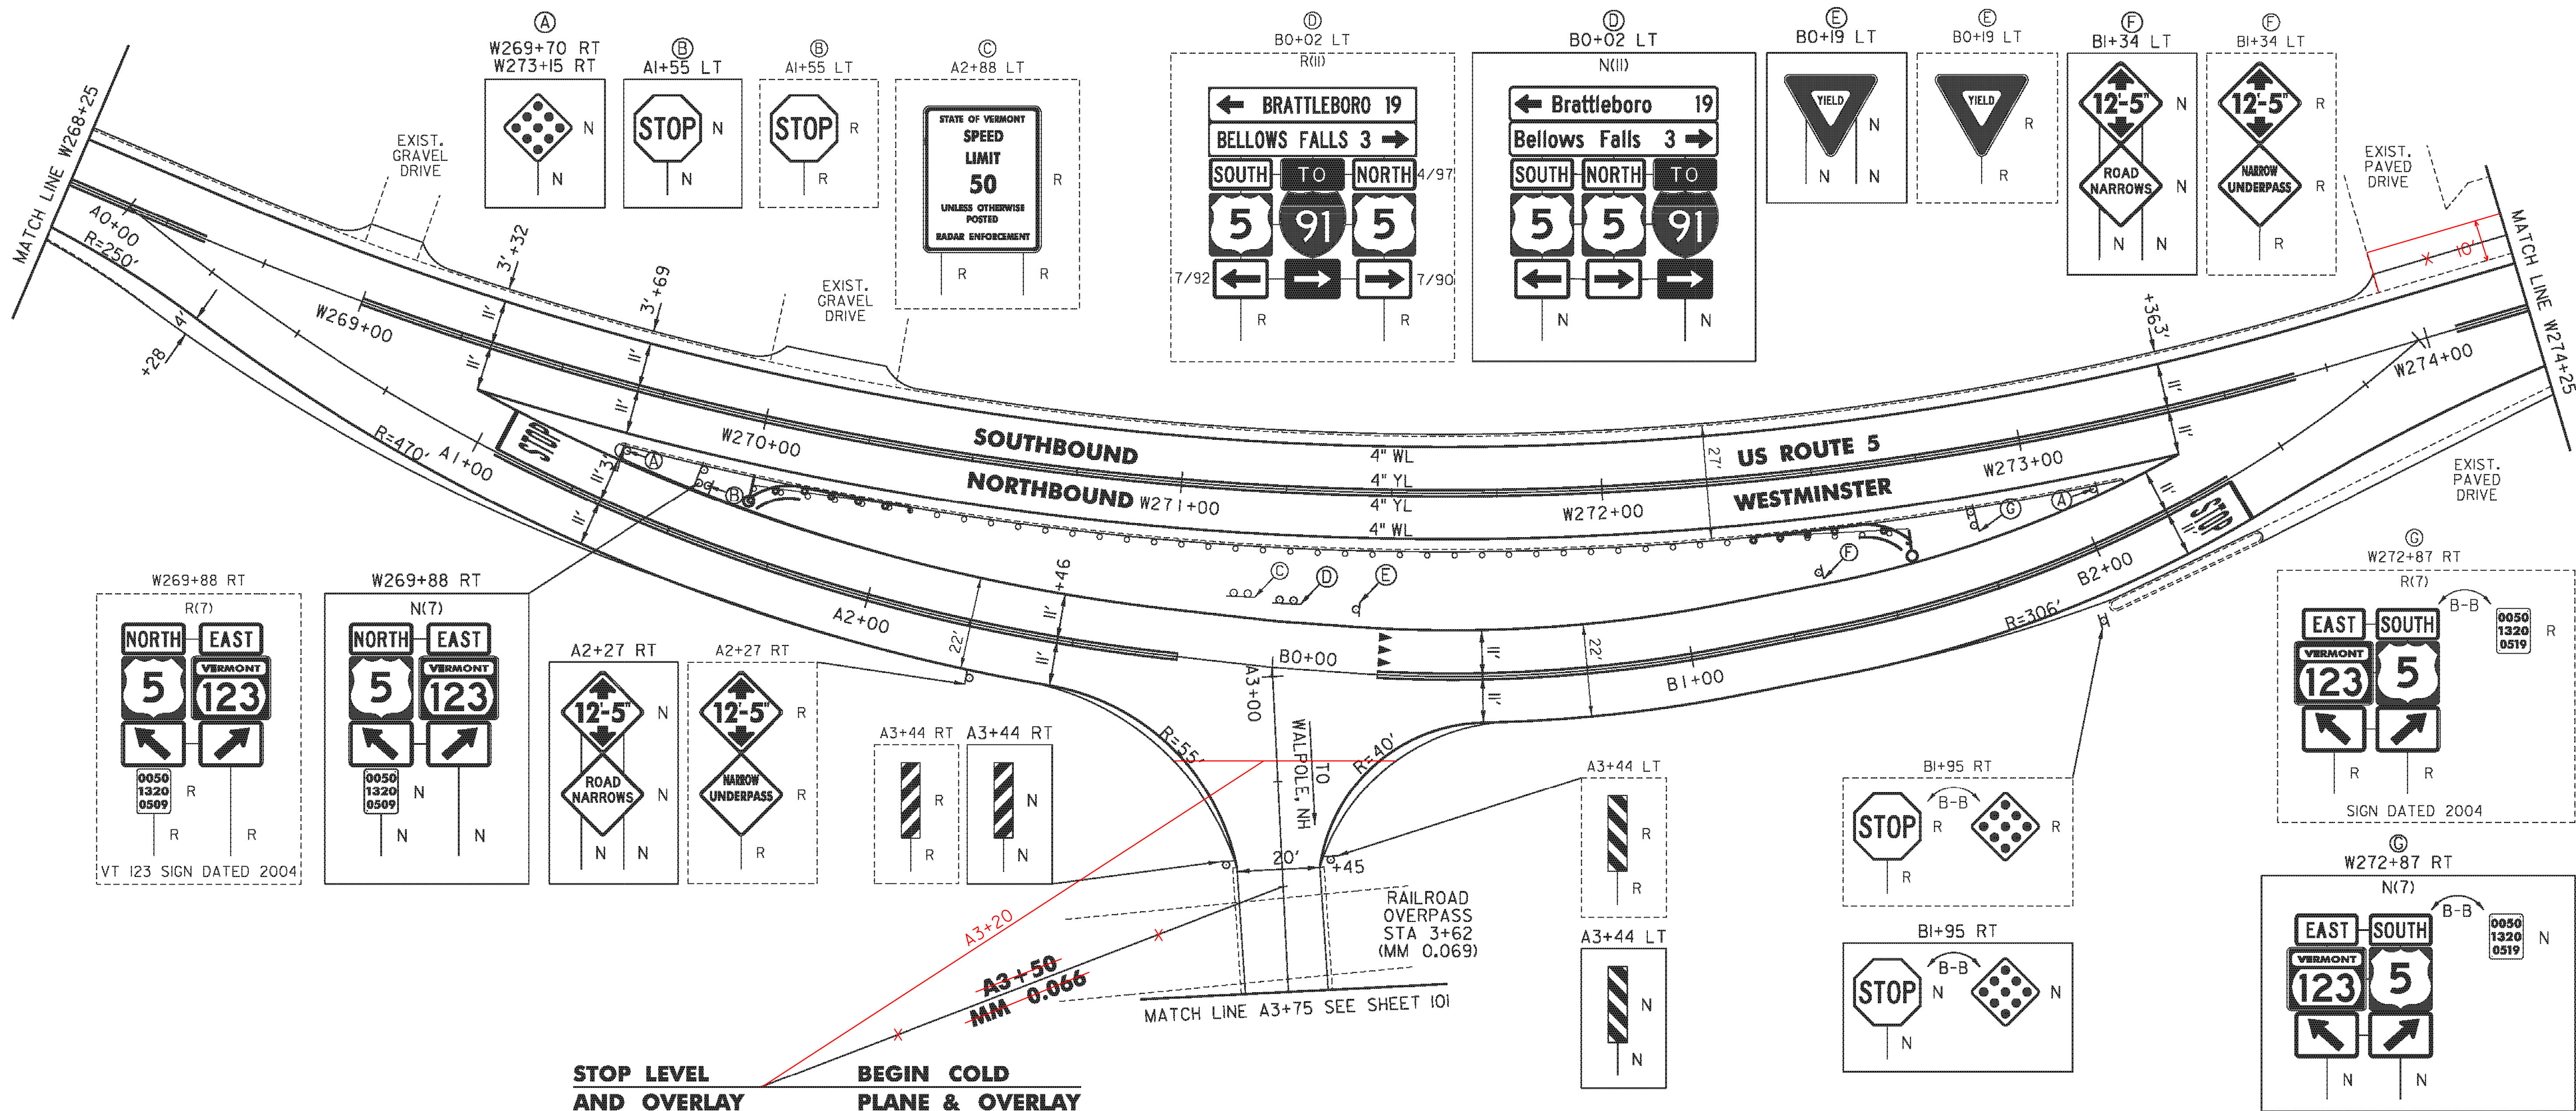

STOP LEVEL AND OVERLAY **BEGIN COLD PLANE & OVERLAY**

- LEGEND**
- R = REMOVE EXISTING
 - S = SALVAGE
 - R&S = REMOVE AND SALVAGE
 - N = NEW
 - RET = RETAIN
 - B-B = BACK TO BACK
 - = EXISTING GUARDRAIL
 - = PROPOSED GUARDRAIL
 - YL = YELLOW LINE
 - WL = WHITE LINE
 - = DELINEATOR
 - = UTILITY POLE

PROJECT NAME: PUTNEY-WESTMINSTER
 PROJECT NUMBER: STP 2946(I)

FILE NAME: zllc344bdr.dgn
 PROJECT LEADER: P. SHEDD
 DESIGNED BY: N. LEMAY
 ROADWAY LAYOUT 6I US 5

PLOT DATE: 12/10/2013
 DRAWN BY: W. GORDON
 CHECKED BY: P. SHEDD
 SHEET 82 OF 138

NOT TO SCALE