

TEMPORARY 4 INCH WHITE LINE, PAINT  
 DURABLE 4 INCH WHITE LINE (OPTION BID ITEM)  
 W318+50 TO W330+50 SOLID LT & RT

TEMPORARY 4 INCH YELLOW LINE, PAINT  
 DURABLE 4 INCH YELLOW LINE (OPTION BID ITEM)  
 W318+50 TO W330+50 SOLID LT & RT

PAINTED CURB  
 W318+50 TO W318+59 LT

STEEL BEAM GUARDRAIL, GALVANIZED  
 W324+00 TO W324+75 RT  
 W324+12.5 TO W324+75 LT


ANCHOR FOR STEEL BEAM RAIL  
 W324+00 RT  
 W324+12.5 LT  
 W324+75 RT  
 W324+75 LT

REMOVAL AND DISPOSAL OF GUARDRAIL  
 W324+00 TO W324+75 RT  
 W324+17 TO W324+75 LT

DELINEATOR WITH STEEL POST  
 W324+00 RT  
 W324+12.5 LT  
 W324+75 RT  
 W324+75 LT

REMOVING SIGNS  
 AS SHOWN - 1

**STA W304+75 TO W322+75  
 SEE IM SIGN(44) FOR  
 EXISTING AND PROPOSED SIGNING**

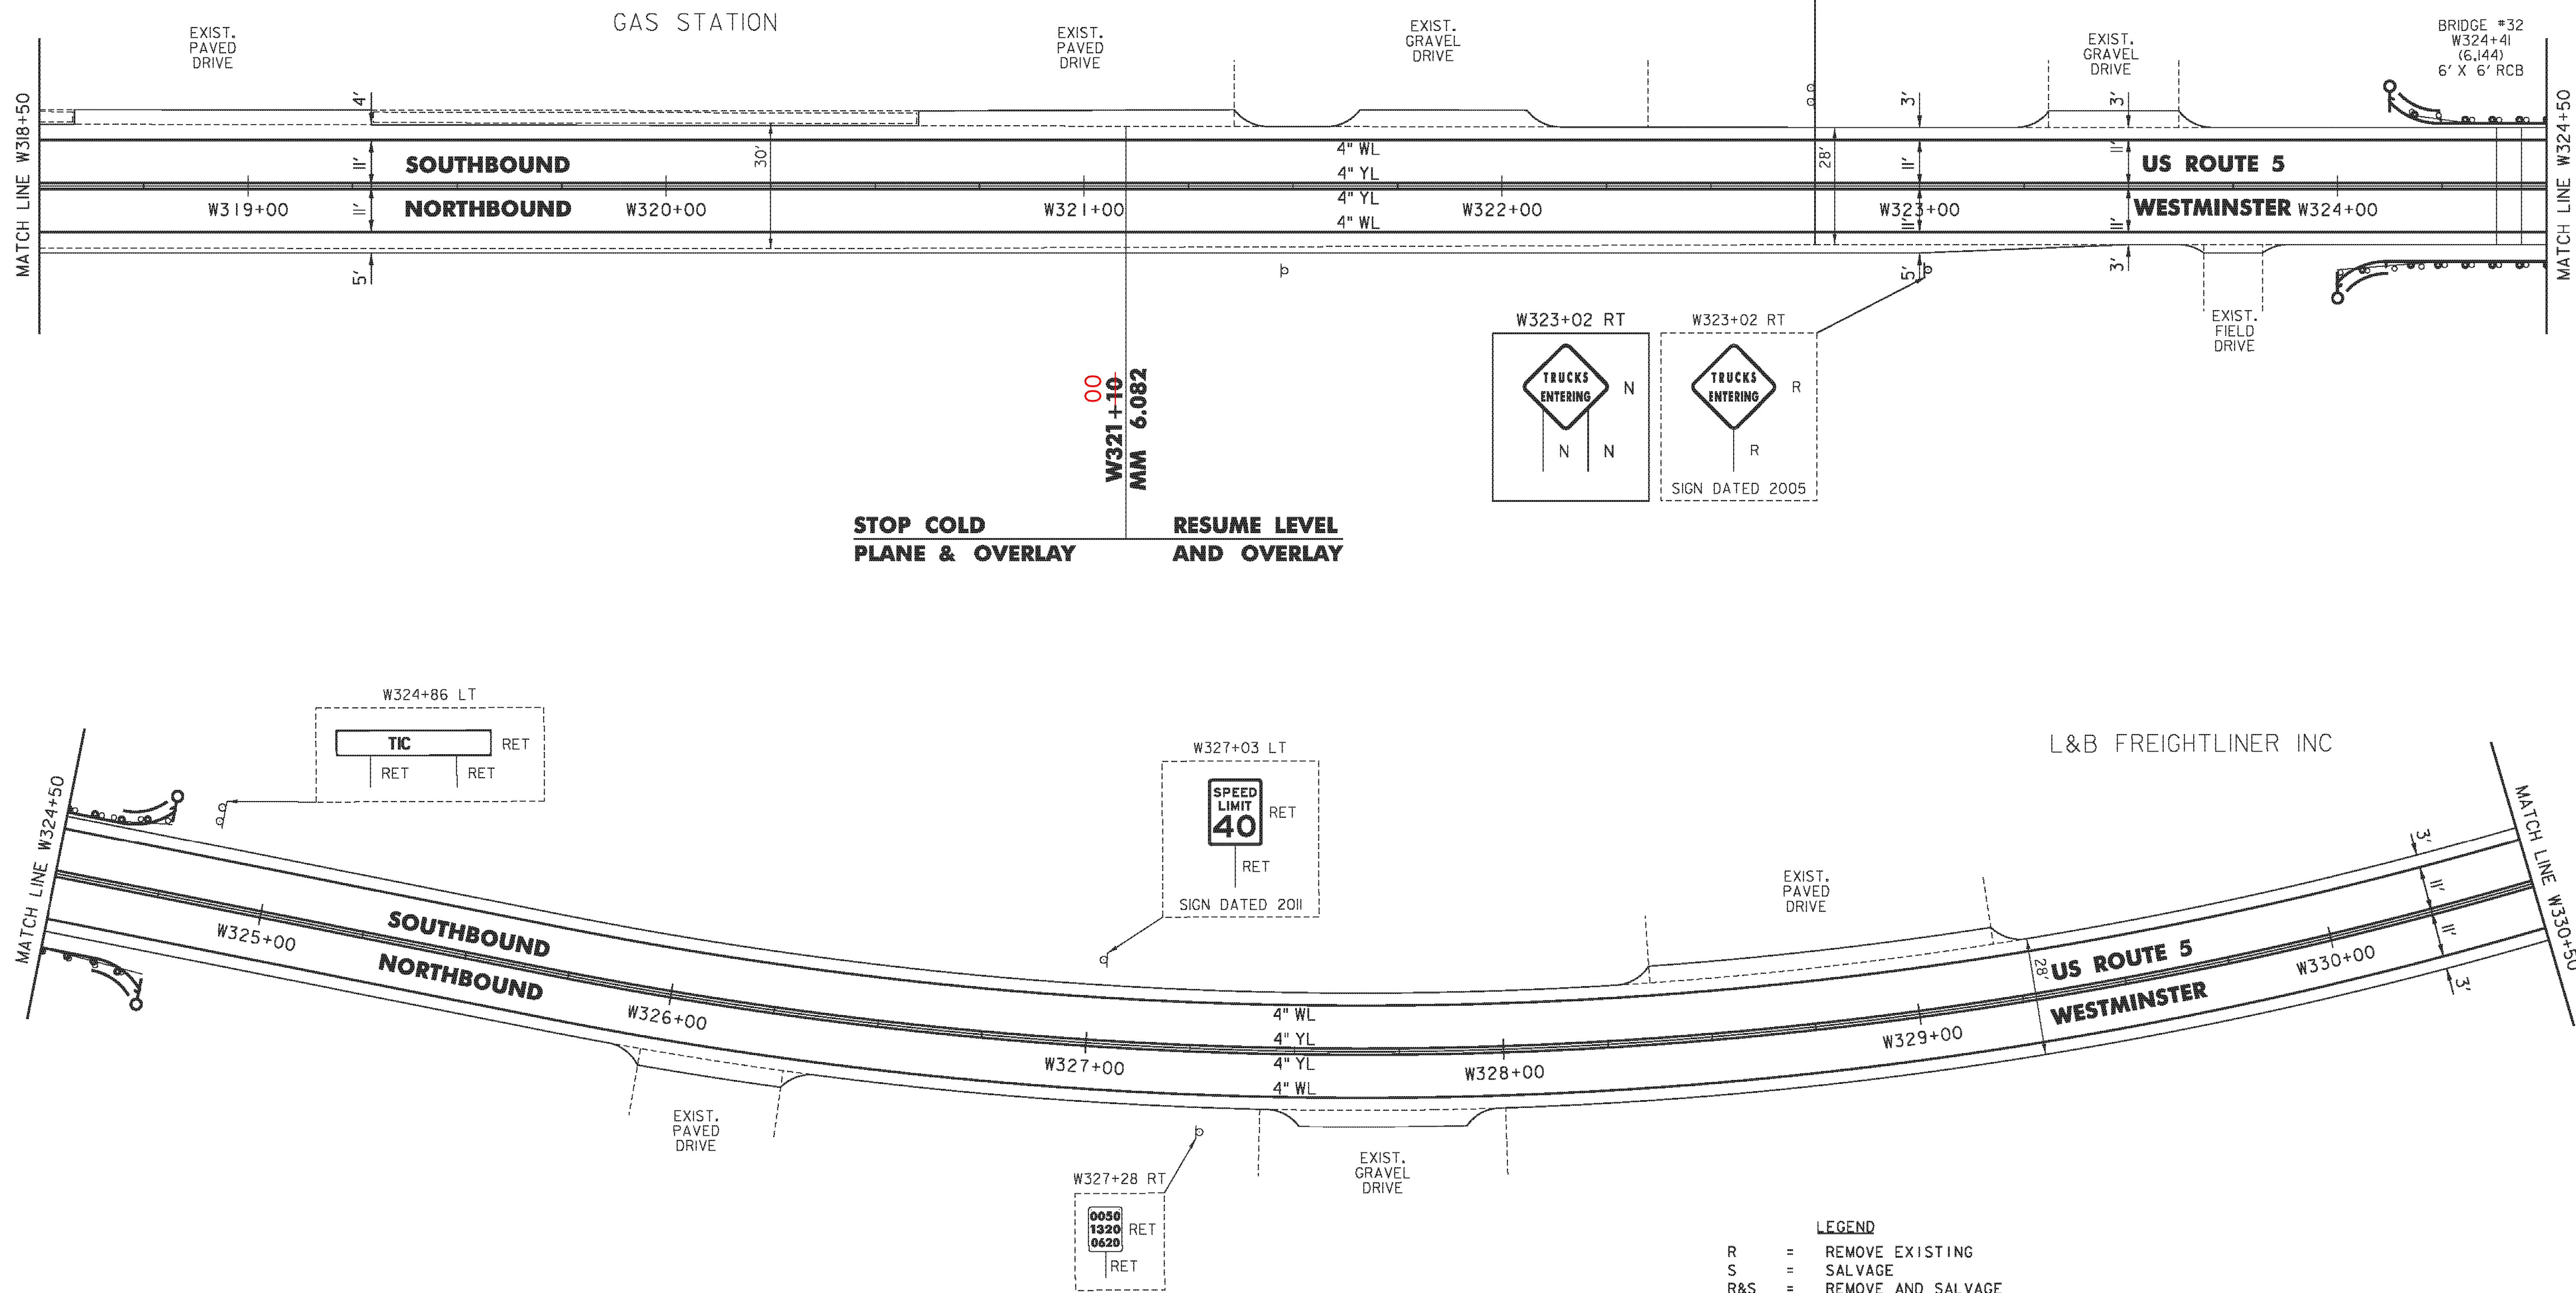

**STOP COLD  
 PLANE & OVERLAY**      **RESUME LEVEL  
 AND OVERLAY**

00  
 W321+10  
 MM 6.082

L&B FREIGHTLINER INC

- LEGEND**
- R = REMOVE EXISTING
  - S = SALVAGE
  - R&S = REMOVE AND SALVAGE
  - N = NEW
  - RET = RETAIN
  - B-B = BACK TO BACK
  - = EXISTING GUARDRAIL
  - = PROPOSED GUARDRAIL
  - YL = YELLOW LINE
  - WL = WHITE LINE
  - = DELINEATOR
  - = UTILITY POLE

PROJECT NAME:	PUTNEY-WESTMINSTER	FILE NAME:	zllc344bdr.dgn	PLOT DATE:	12/10/2013
PROJECT NUMBER:	STP 2946(I)	PROJECT LEADER:	P. SHEDD	DRAWN BY:	W. GORDON
		DESIGNED BY:	N. LEMAY	CHECKED BY:	P. SHEDD
		ROADWAY LAYOUT	68 US 5	SHEET	89 OF 138

NOT TO SCALE