


TEMPORARY 4 INCH WHITE LINE, PAINT  
 DURABLE 4 INCH WHITE LINE (OPTION BID ITEM)  
 W366+50 TO W376+50 SOLID LT & RT

TEMPORARY 4 INCH YELLOW LINE, PAINT  
 W366+50 TO W376+50 SOLID LT & RT  
 DURABLE 4 INCH YELLOW LINE (OPTION BID ITEM)  
 W366+50 TO W372+00 SOLID LT & RT  
 DURABLE 4 INCH YELLOW LINE, POLYUREA  
 W372+00 TO W376+50 SOLID LT & RT

MILLED RUMBLE STRIPS  
 W372+00 TO W376+50 CL  
 REMOVING SIGNS  
 AS SHOWN - 1

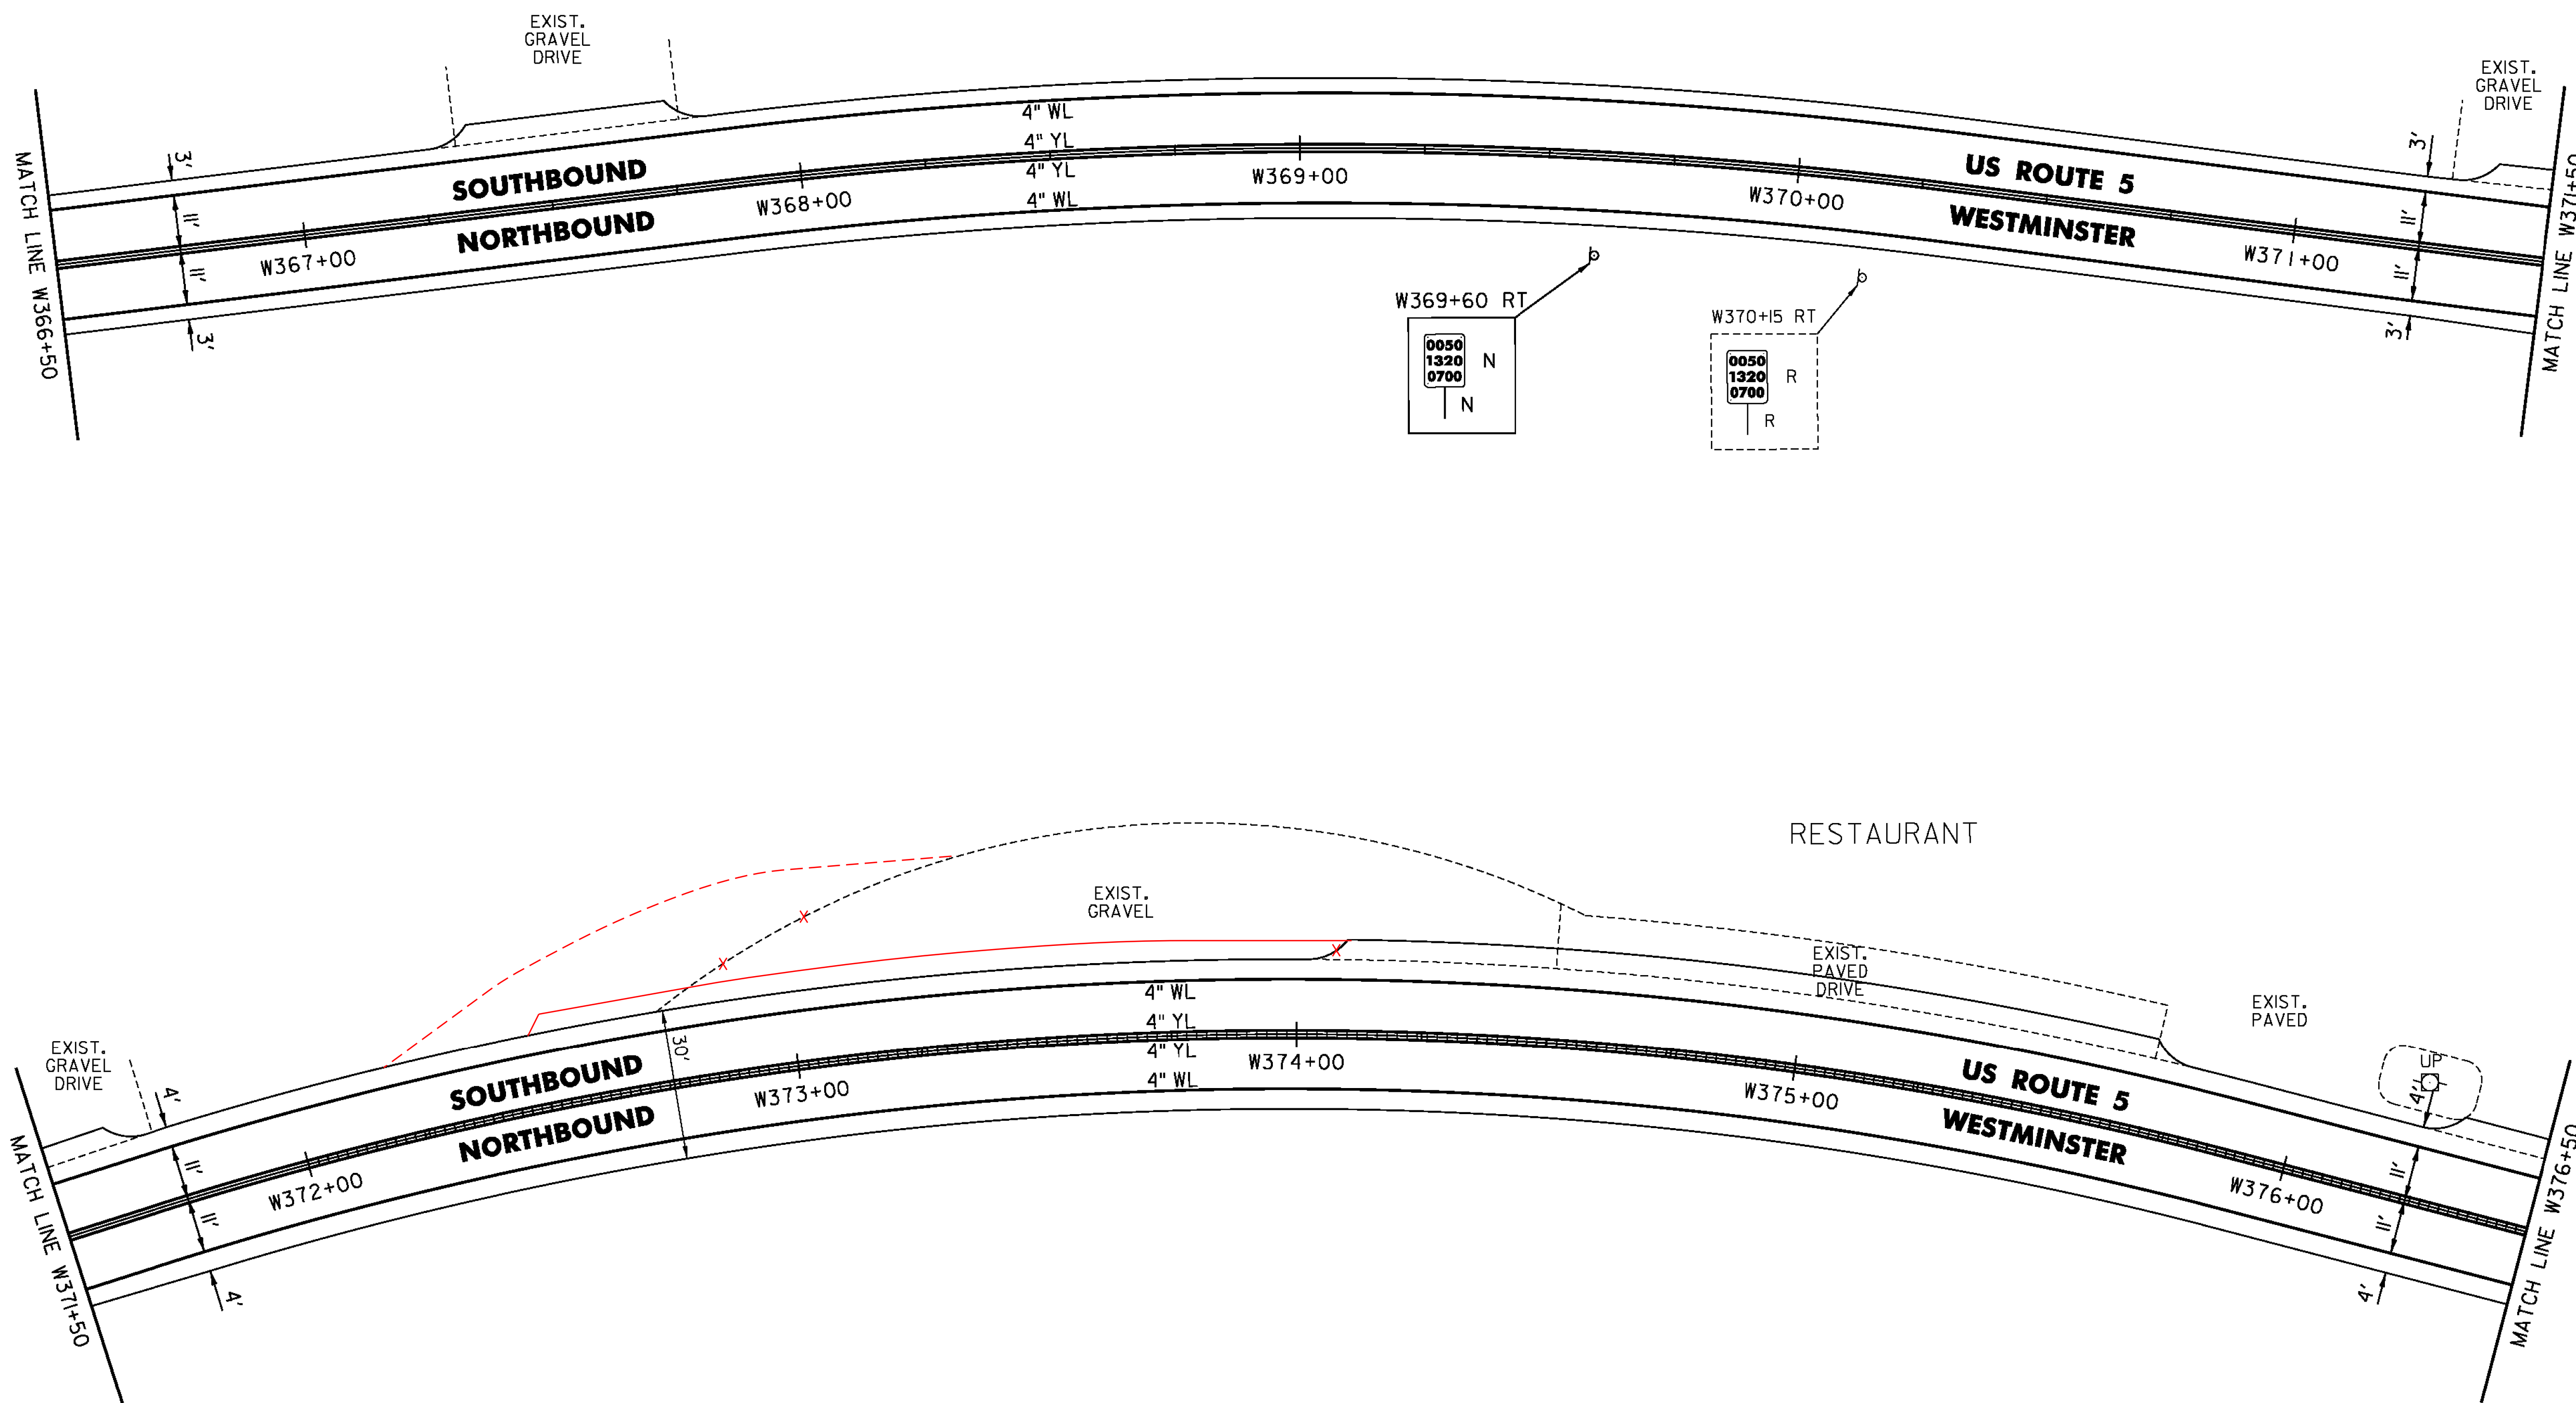

RESTAURANT

EXIST. PAVED DRIVE

EXIST. PAVED

LEGEND

- R = REMOVE EXISTING
- S = SALVAGE
- R&S = REMOVE AND SALVAGE
- N = NEW
- RET = RETAIN
- B-B = BACK TO BACK
- = EXISTING GUARDRAIL
- = PROPOSED GUARDRAIL
- YL = YELLOW LINE
- WL = WHITE LINE
- = DELINEATOR
- = UTILITY POLE

PROJECT NAME: PUTNEY-WESTMINSTER

PROJECT NUMBER: STP 2946(I)

FILE NAME: zllc344bdr.dgn  
 PROJECT LEADER: P. SHEDD  
 DESIGNED BY: N. LEMAY  
 ROADWAY LAYOUT 72 US 5

PLOT DATE: 12/10/2013  
 DRAWN BY: W. GORDON  
 CHECKED BY: P. SHEDD  
 SHEET 93 OF 138

NOT TO SCALE