

TEMPORARY 4 INCH WHITE LINE, PAINT
 DURABLE 4 INCH WHITE LINE (OPTION BID ITEM)
 W429+50 TO W434+35 SOLID LT & RT

TEMPORARY 4 INCH YELLOW LINE, PAINT
 DURABLE 4 INCH YELLOW LINE (OPTION BID ITEM)
 W429+50 TO W434+35 SOLID LT & RT

STEEL BEAM GUARDRAIL, GALVANIZED
 W432+49 TO W434+80 RT

ANCHOR FOR STEEL BEAM RAIL
 W434+80 RT

DELINEATOR WITH STEEL POST
 W434+80 RT

REMOVAL AND DISPOSAL OF GUARDRAIL
 W432+49 TO W434+80 RT


BITUMINOUS CONCRETE CURB, TYPE A
 W432+24 TO W434+40 RT

REHAB. DROP INLETS, CATCH BASINS,
 OR MANHOLES, CLASS I, CLASS II
 W432+26 RT


CHANGING ELEVATION
 OF SEWER MANHOLES (NON-PART)
 W432+96 LT
 W433+91 RT
 CHANGING ELEVATION OF
 DROP INLETS, CATCH BASINS, OR MANHOLES
 (TO BE ADJUSTED BY OTHERS)
 W433+91 RT (TMH)

REMOVING SIGNS
 AS SHOWN - 1

END PUTNEY-WESTMINSTER STP 2946(1)
W434+35 (MM 8.226) EXISTING PAVEMENT
END COLD PLANE & OVERLAY JOINT

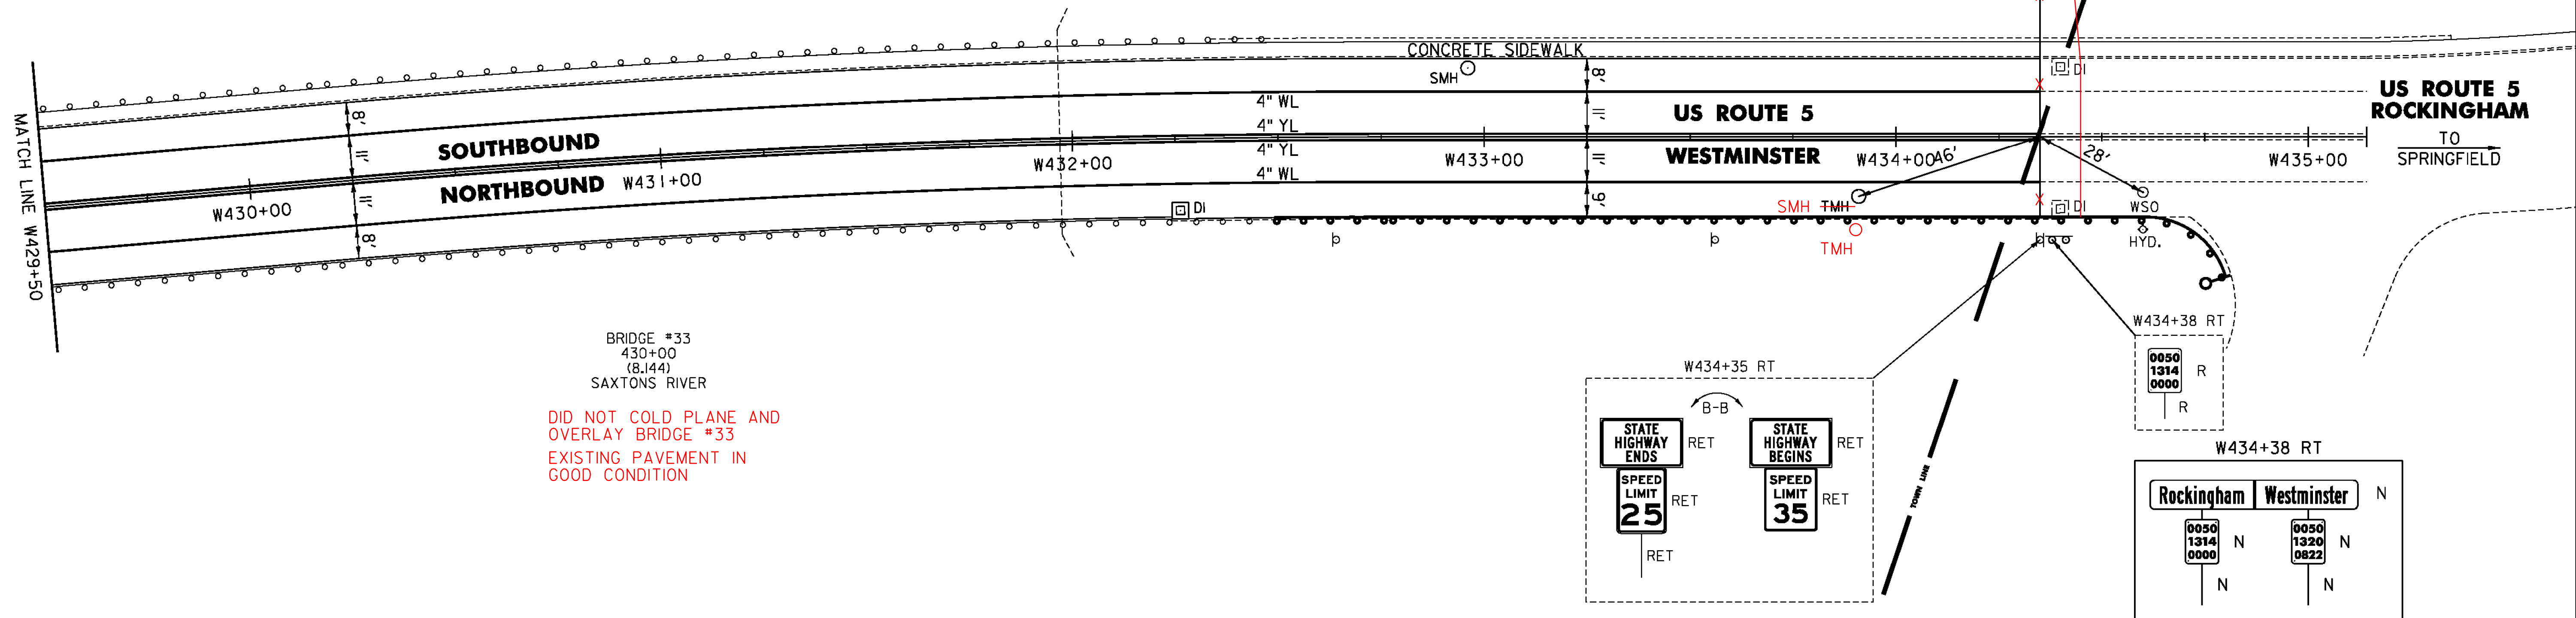

DID NOT COLD PLANE AND
 OVERLAY BRIDGE #33
 EXISTING PAVEMENT IN
 GOOD CONDITION

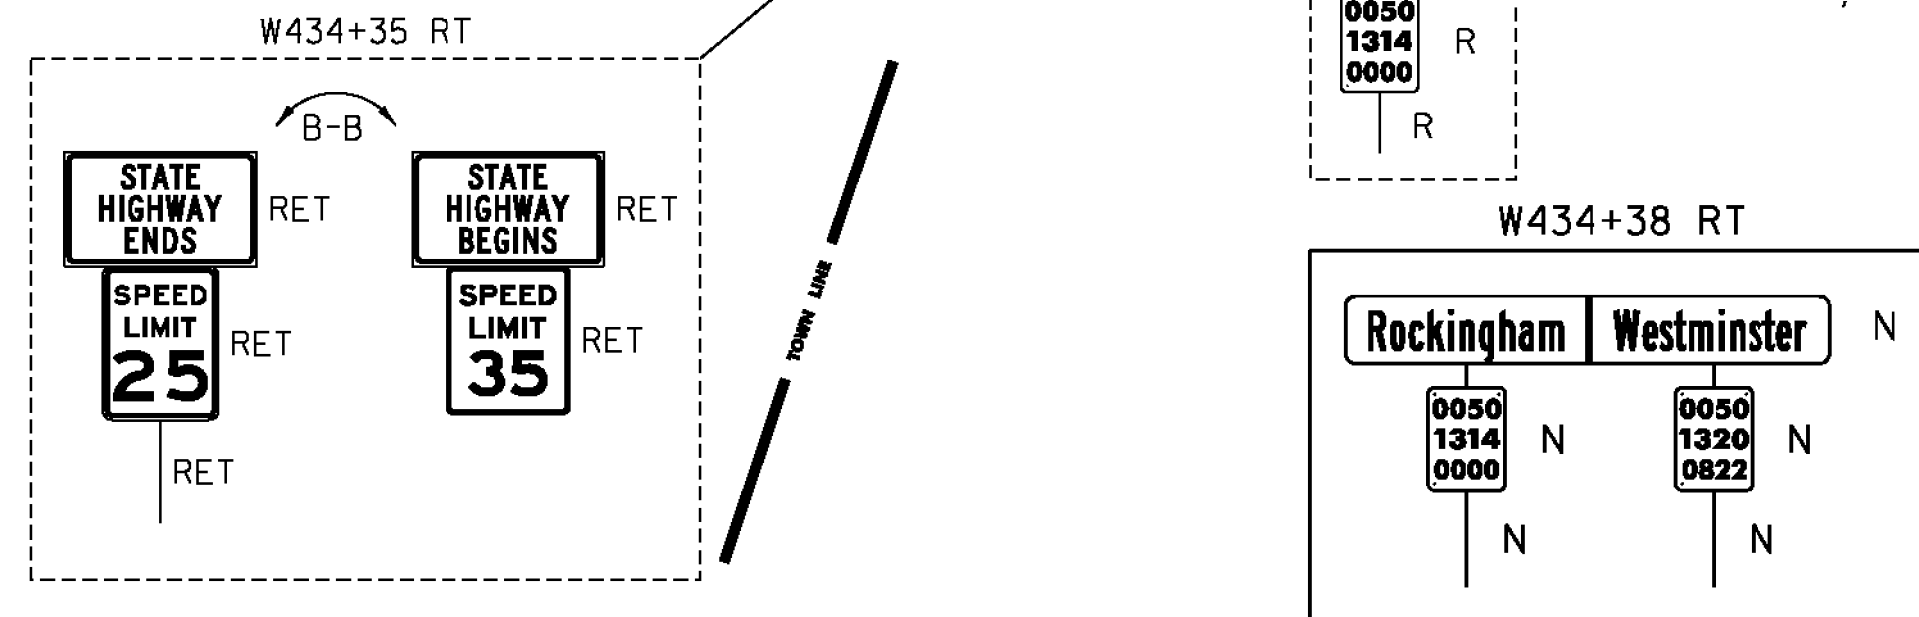

- LEGEND**
- R = REMOVE EXISTING
 - S = SALVAGE
 - R&S = REMOVE AND SALVAGE
 - N = NEW
 - RET = RETAIN
 - B-B = BACK TO BACK
 - = EXISTING GUARDRAIL
 - = PROPOSED GUARDRAIL
 - YL = YELLOW LINE
 - WL = WHITE LINE
 - = DELINEATOR
 - = UTILITY POLE

NOT TO SCALE

PROJECT NAME: PUTNEY-WESTMINSTER
 PROJECT NUMBER: STP 2946(1)

FILE NAME: zllc344bdr.dgn
 PROJECT LEADER: P. SHEDD
 DESIGNED BY: N. LEMAY
 ROADWAY LAYOUT 79 US 5

PLOT DATE: 12/10/2013
 DRAWN BY: W. GORDON
 CHECKED BY: P. SHEDD
 SHEET 100 OF 138