

TEMPORARY 4 INCH WHITE LINE, PAINT
 DURABLE 4 INCH WHITE LINE (OPTION BID ITEM)
 A13+50 TO A16+56 SOLID LT & RT

TEMPORARY 4 INCH YELLOW LINE, PAINT
 DURABLE 4 INCH YELLOW LINE (OPTION BID ITEM)
 A13+50 TO A16+56 SOLID LT & RT

TEMPORARY LETTER OR SYMBOL, PAINT
 DURABLE LETTER OR SYMBOL (OPTION BID ITEM)
 A14+30 RT - 'STOP'
 A14+70 RT - 'AHEAD'


STEEL BEAM GUARDRAIL, GALVANIZED
 A14+15 TO A16+02.5 RT
 A14+76.5 TO A16+14 LT

ANCHOR FOR STEEL BEAM RAIL
 A14+15 RT
 A14+76.5 LT

REMOVAL AND DISPOSAL OF GUARDRAIL
 A14+10 TO A16+02.5 RT
 A14+78.5 TO A16+14 LT

DELINEATOR WITH STEEL POST
 A14+15 RT
 A14+76.5 LT

REMOVING SIGNS
 AS SHOWN - 9

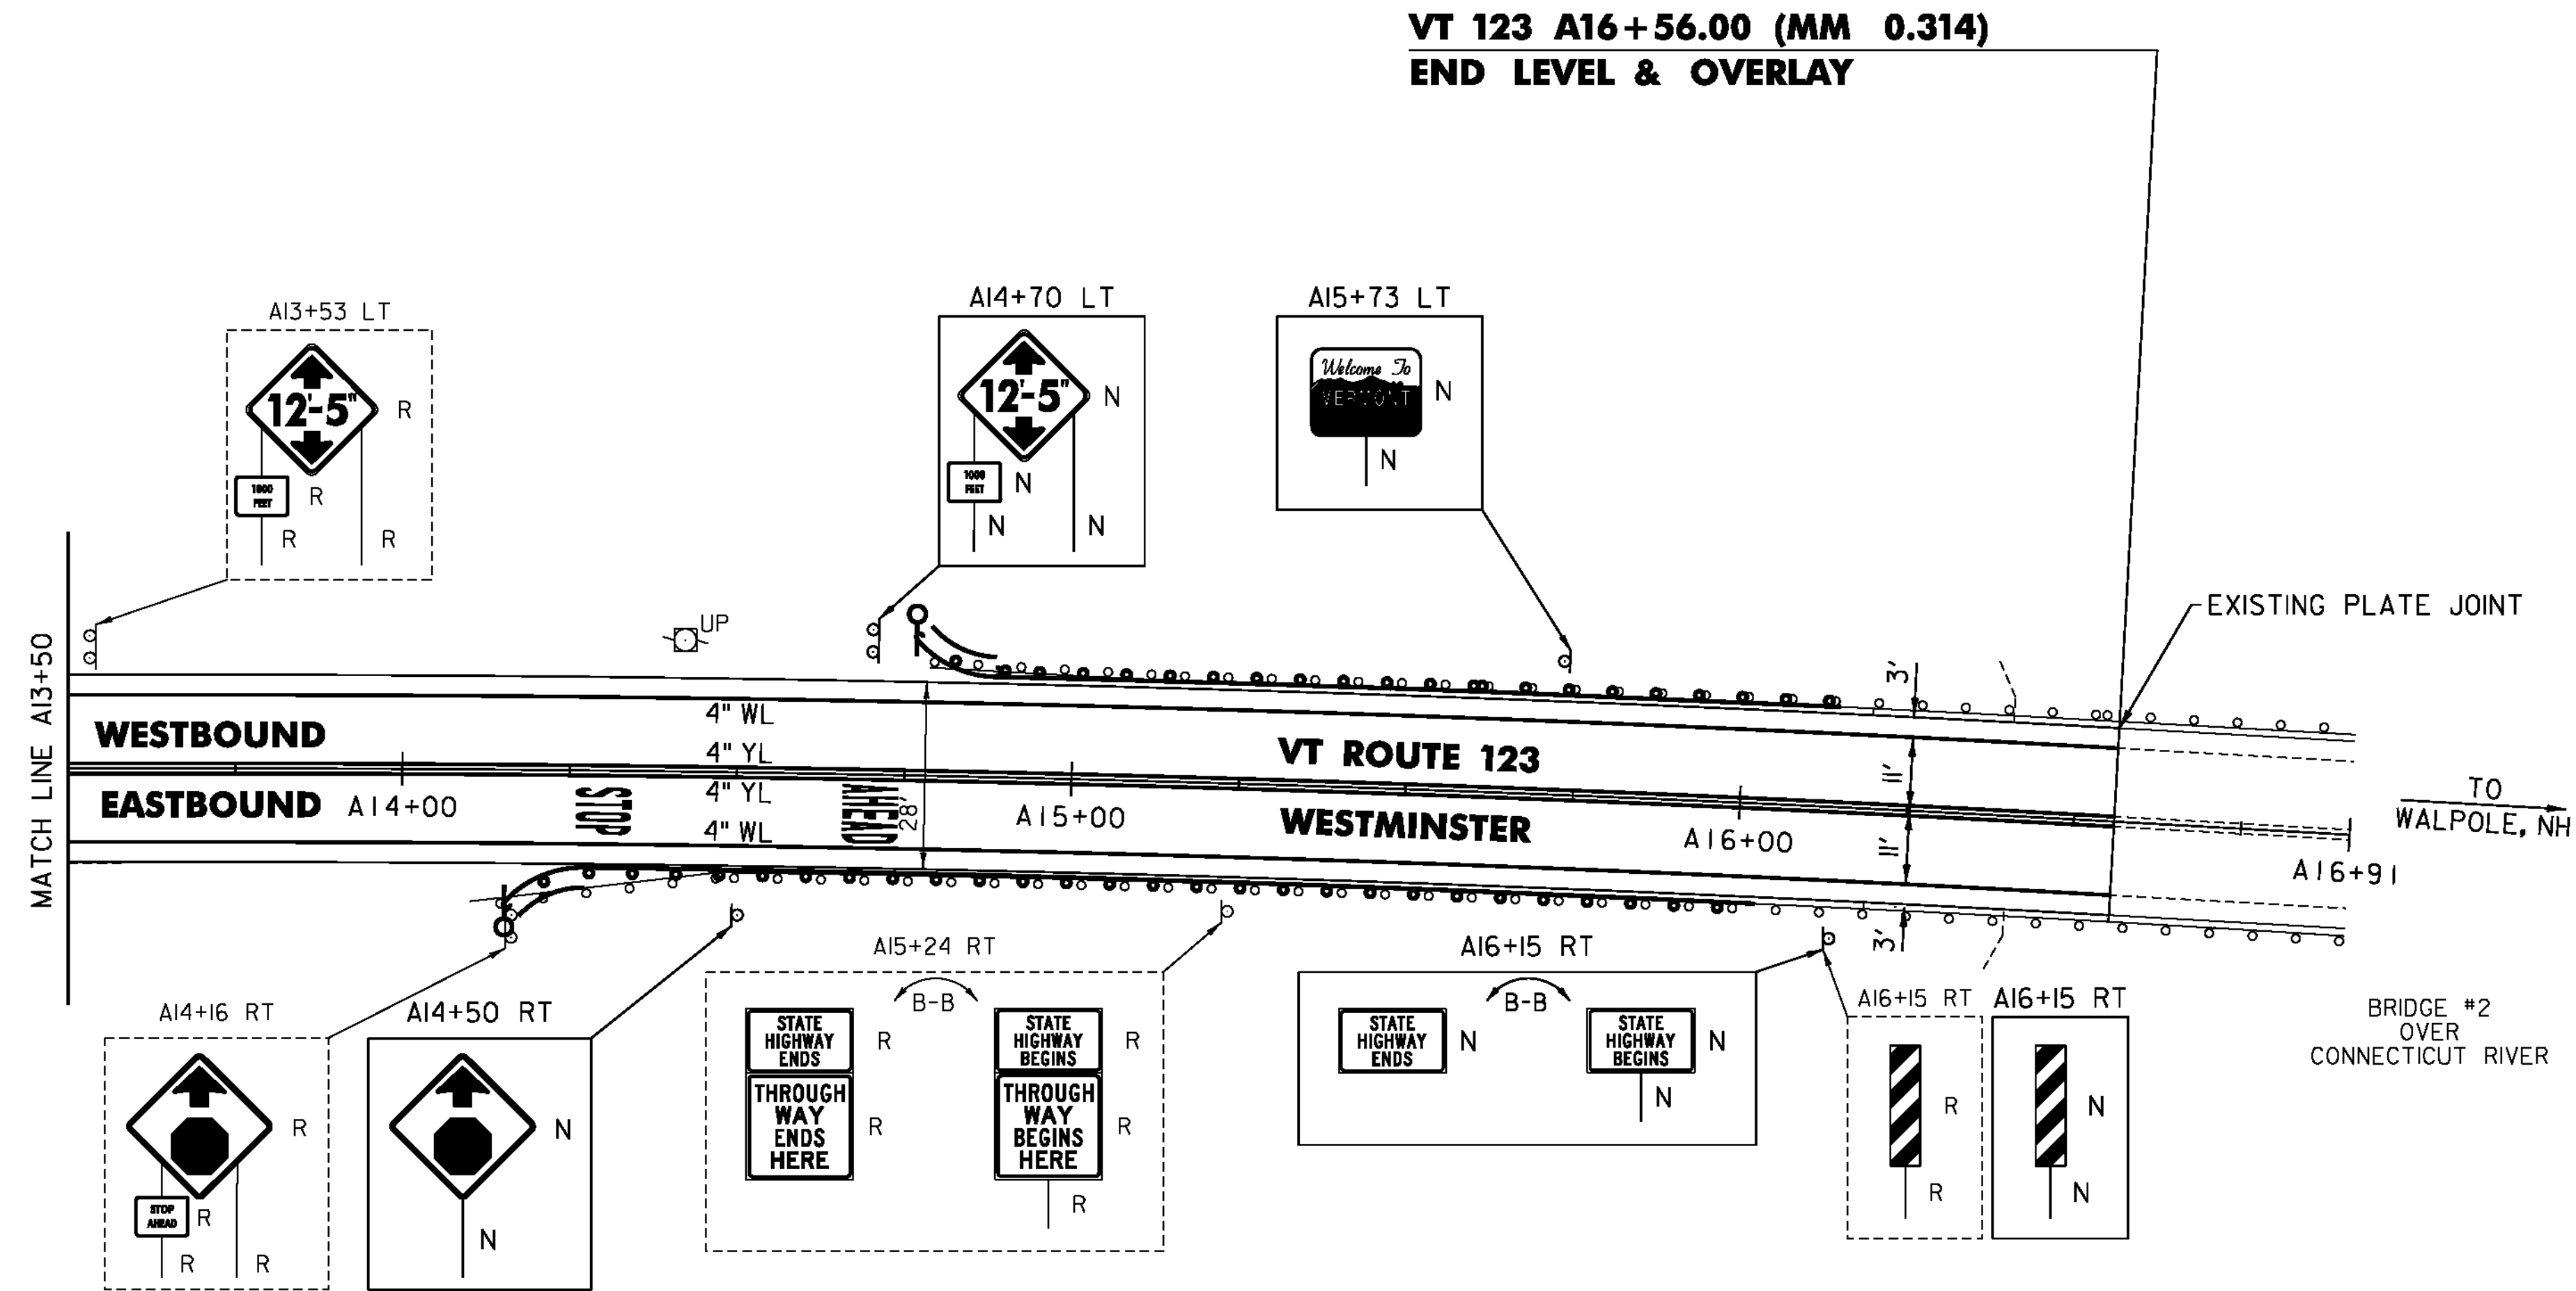

**VT 123 A16+56.00 (MM 0.314)
 END LEVEL & OVERLAY**

NOT TO SCALE

- LEGEND**
- R = REMOVE EXISTING
 - S = SALVAGE
 - R&S = REMOVE AND SALVAGE
 - N = NEW
 - RET = RETAIN
 - B-B = BACK TO BACK
 - = EXISTING GUARDRAIL
 - = PROPOSED GUARDRAIL
 - YL = YELLOW LINE
 - WL = WHITE LINE
 - = DELINEATOR
 - = UTILITY POLE

PROJECT NAME: PUTNEY-WESTMINSTER	FILE NAME: zllc344bdr.dgn	PLOT DATE: 12/10/2013
PROJECT NUMBER: STP 2946(1)	PROJECT LEADER: P. SHEDD	DRAWN BY: W. GORDON
DESIGNED BY: N. LEMAY	CHECKED BY: P. SHEDD	SHEET 102 OF 138
ROADWAY LAYOUT 81 VT 123		