

TEMPORARY 4 INCH WHITE LINE, PAINT  
 DURABLE 4 INCH WHITE LINE (OPTION BID ITEM)  
 C3+50 TO C7+91 SOLID LT  
 C3+50 TO C5+75 SOLID RT  
 C6+04 TO C6+09 SOLID RT ( I-91 NB OFF RAMP)  
 C6+04 TO C7+60 SOLID RT  
 C8+38 TO C9+50 SOLID RT  
 C8+46 TO C9+50 SOLID LT


STEEL BEAM GUARDRAIL, GALVANIZED  
 C3+50 TO C3+90 RT  
 C3+50 TO C4+65 LT  
 ANCHOR FOR STEEL BEAM RAIL  
 C3+90 RT  
 C4+65 LT

REMOVAL AND DISPOSAL OF GUARDRAIL  
 C3+50 TO C3+91 RT  
 C3+50 TO C4+64 LT  
 DELINEATOR WITH STEEL POST  
 C3+90 RT  
 C4+65 LT

TEMPORARY 4 INCH YELLOW LINE, PAINT  
 DURABLE 4 INCH YELLOW LINE (OPTION BID ITEM)  
 C3+50 TO C5+60 SOLID LT & RT  
 C6+00 TO C7+90 SOLID LT & RT  
 C7+91 TO C7+98 SOLID LT  
 C8+30 TO C9+50 SOLID LT & RT

STA. C0+00 TO C40+86  
 SEE IM SIGN(44) FOR  
 EXISTING AND PROPOSED SIGNING

TEMPORARY 8" WHITE LINE, PAINT  
 DURABLE 8" WHITE LINE (OPTION BID ITEM)  
 C7+60 TO C7+99 SOLID RT  
 C7+71 TO C7+99 SOLID RT ( I-91 NB OFF RAMP)

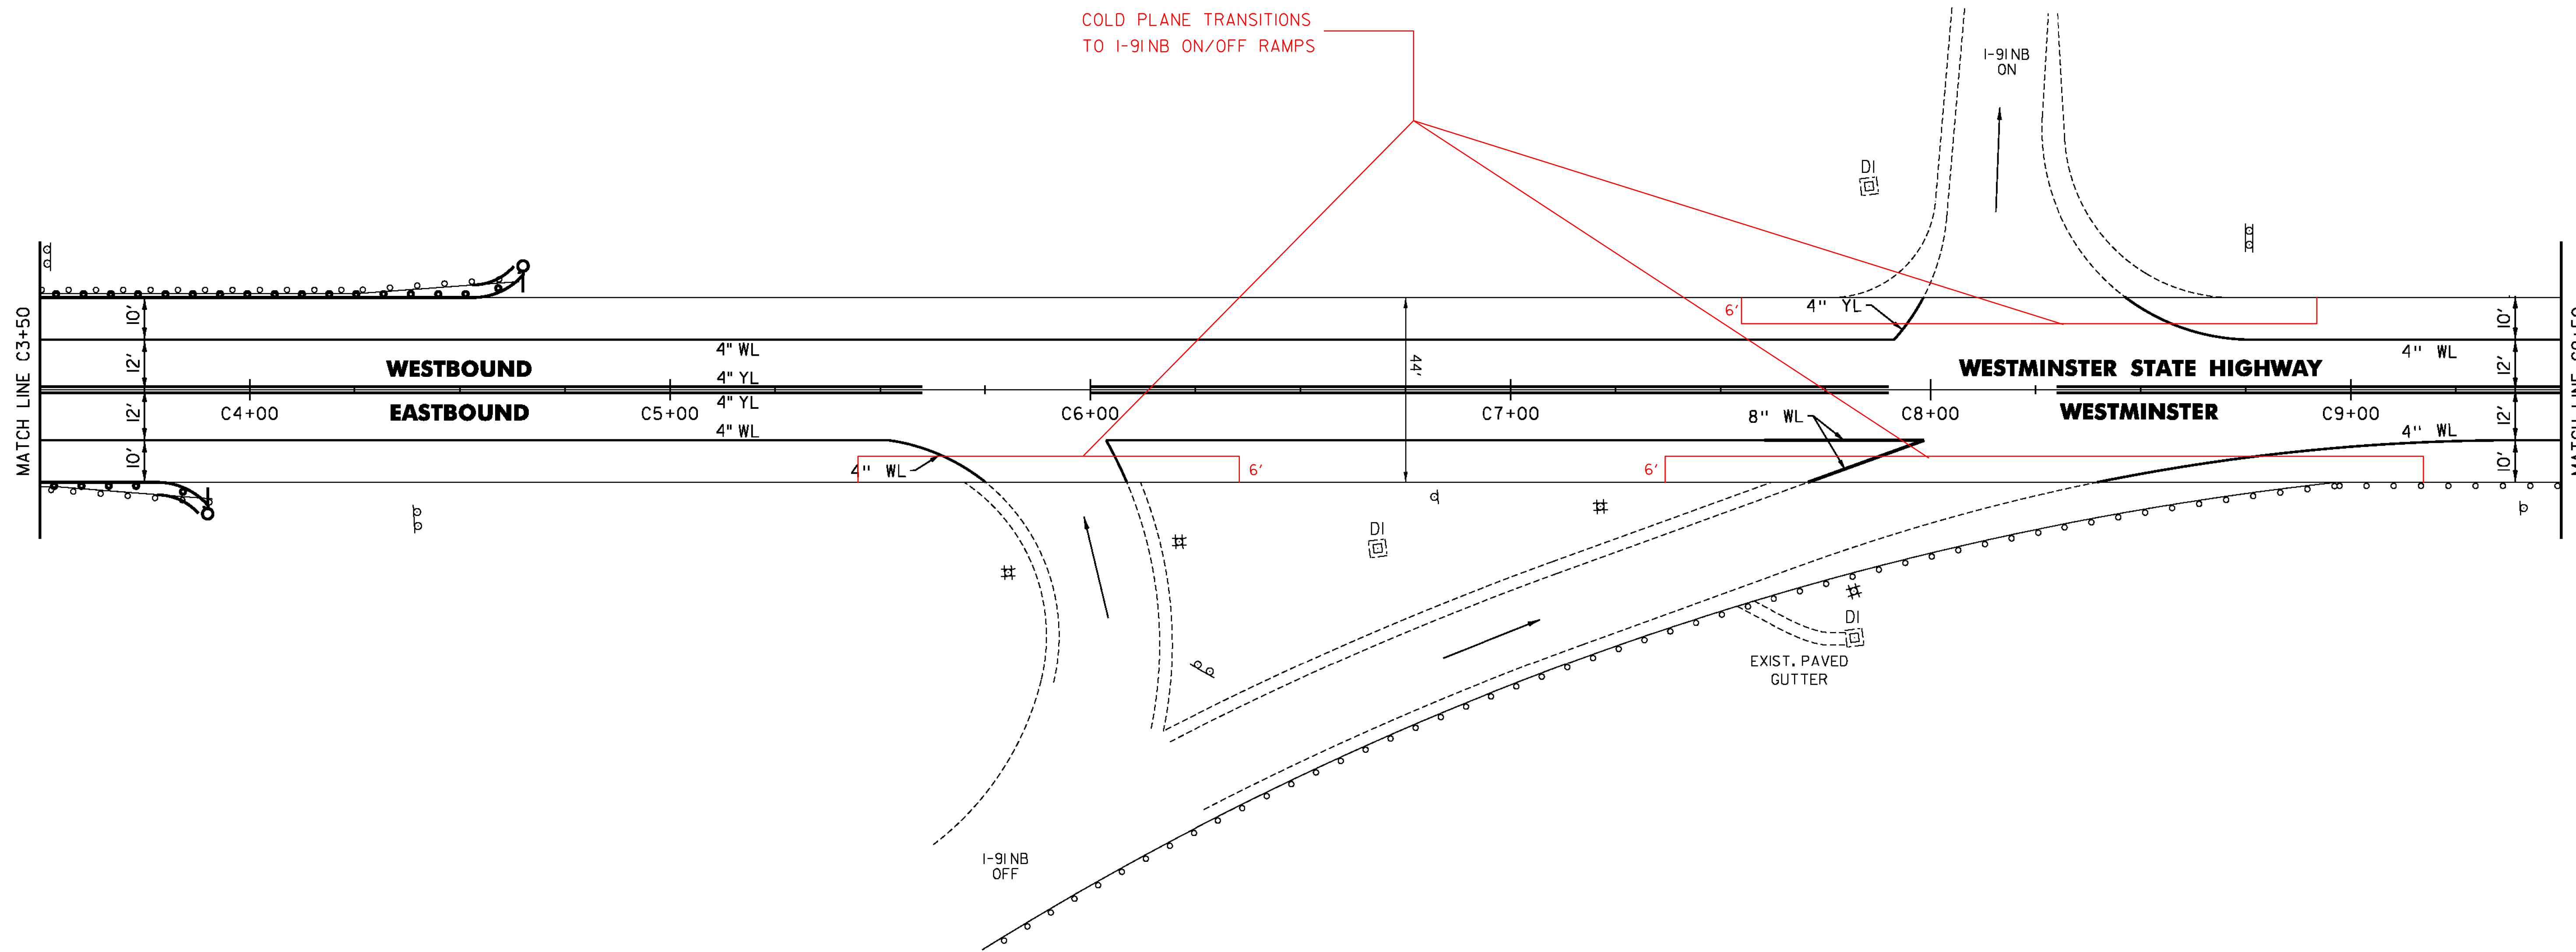

- LEGEND**
- R = REMOVE EXISTING
  - S = SALVAGE
  - R&S = REMOVE AND SALVAGE
  - N = NEW
  - RET = RETAIN
  - B-B = BACK TO BACK
  - = EXISTING GUARDRAIL
  - = PROPOSED GUARDRAIL
  - YL = YELLOW LINE
  - WL = WHITE LINE
  - = DELINEATOR
  - = UTILITY POLE

PROJECT NAME:	PUTNEY-WESTMINSTER
PROJECT NUMBER:	STP 2946(I)
FILE NAME:	zllc344bdr.dgn
PROJECT LEADER:	P. SHEDD
DESIGNED BY:	N. LEMAY
ROADWAY LAYOUT:	83 WSH
PLOT DATE:	12/10/2013
DRAWN BY:	W. GORDON
CHECKED BY:	P. SHEDD
SHEET:	104 OF 138

NOT TO SCALE