

RECORD PLANS

CONTRACTOR: **KUBRICKY CONSTRUCTION**
 RESIDENT ENGINEER: **JOSHUA HULETT**
 CONSTRUCTION BEGAN: **JUNE 1, 2017**
 CONSTRUCTION COMPLETE: **AUGUST 23, 2018**
 RECORD PLANS BY: **JOSHUA HULETT / PAUL BEYOR**




I HEREBY CERTIFY THAT ALL CONSTRUCTION REQUIRED BY THIS SET OF DRAWINGS HAS BEEN ACCOMPLISHED AS INDICATED HEREIN.

BY: E-SIGNED by Josh Hulett on 2018-12-20 13:22:01 UTC RESIDENT ENGINEER

DATE: December 20, 2018

NOTE: ANY FURTHER INFORMATION CONCERNING FINAL QUANTITIES, AMOUNTS OR OTHER DETAILS RELATIVE TO THIS PROJECT MAY BE FOUND AT CENTRAL FILES IN THE ELECTRONIC ARCHIVES.


STATE OF VERMONT
 AGENCY OF TRANSPORTATION

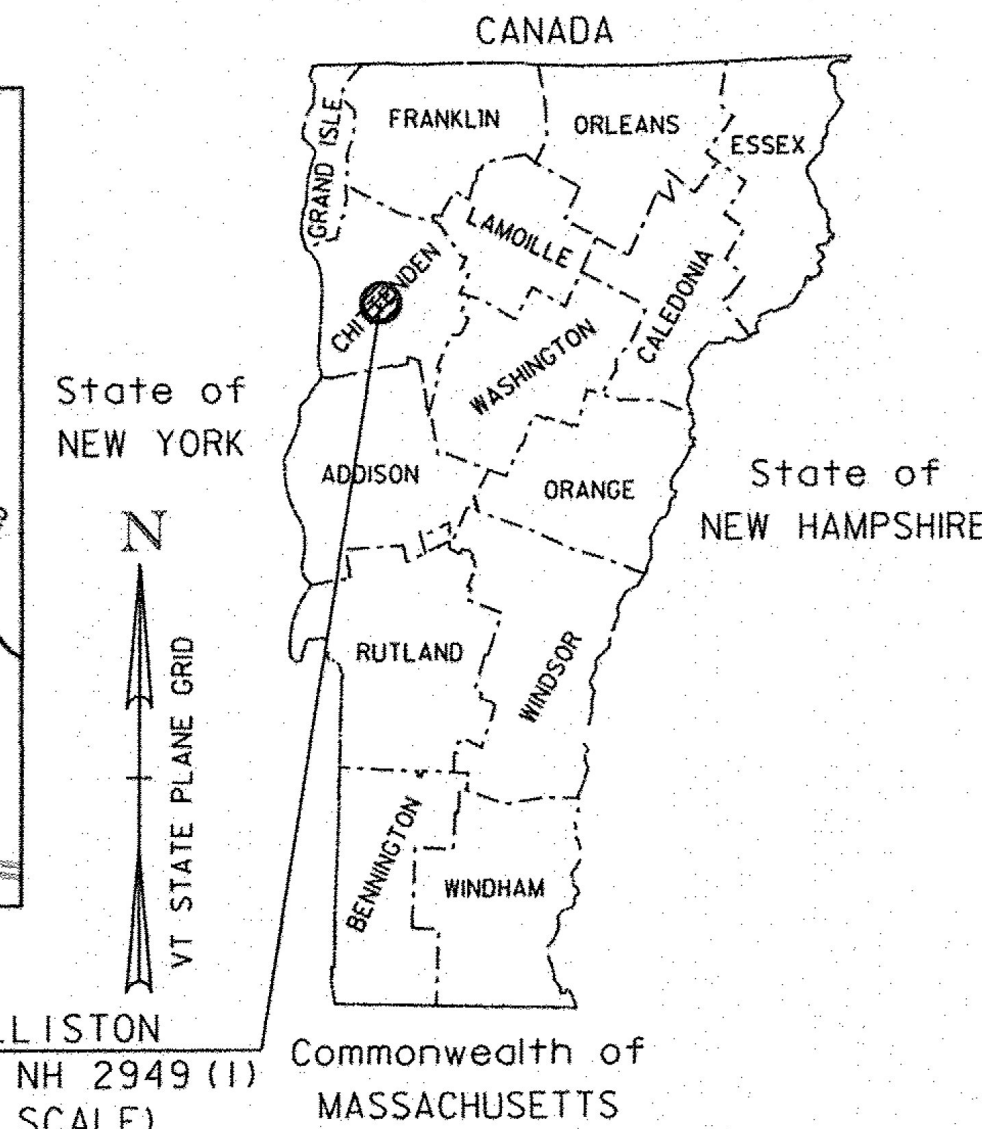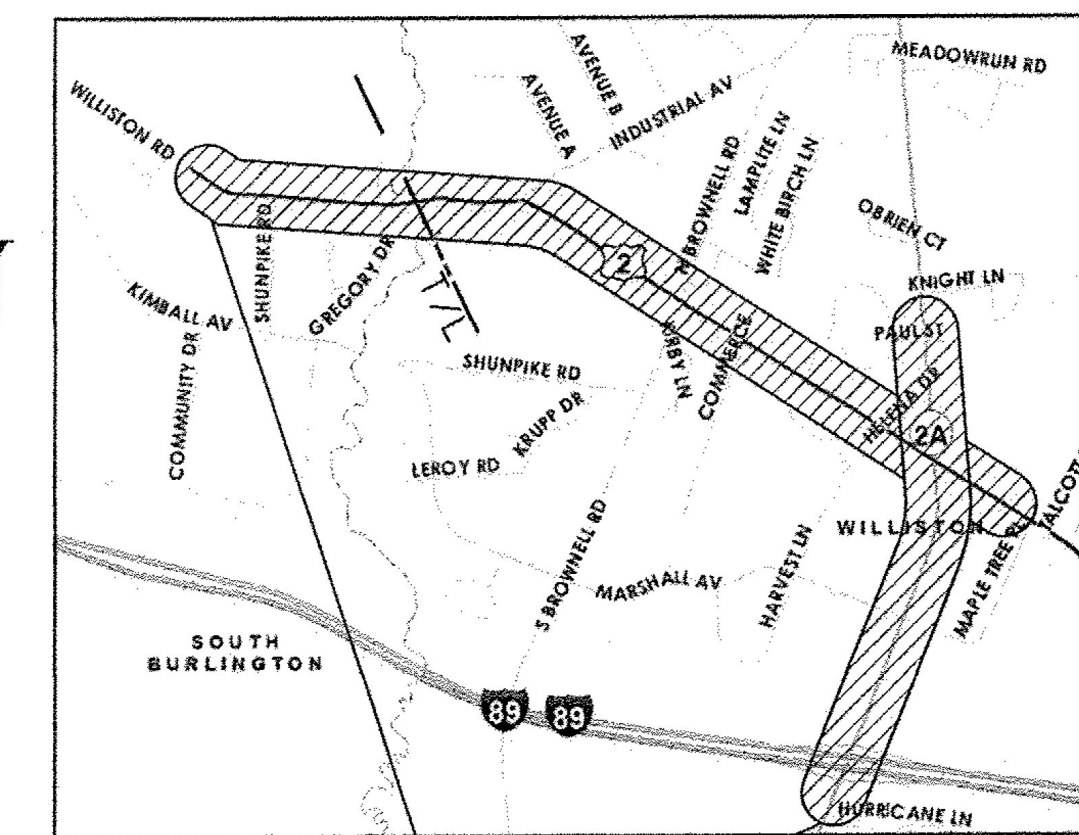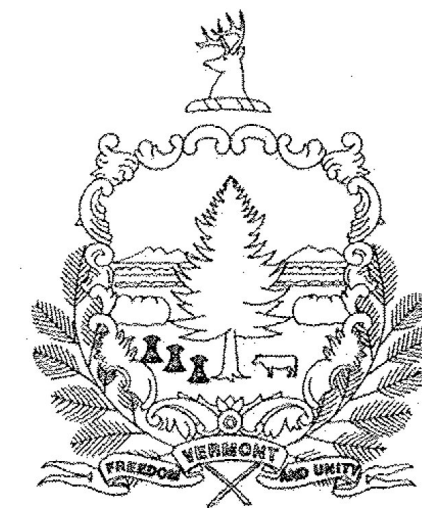

PROPOSED IMPROVEMENT
 CITY OF SOUTH BURLINGTON AND TOWN OF WILLISTON
 COUNTY OF CHITTENDEN
 U.S. ROUTE 2 AND VT ROUTE 2A (PRINCIPAL ARTERIAL) (NHS)


SOUTH BURLINGTON-WILLISTON
 NH 2944 (1)
 U. S. ROUTE 2
 SEE SHEET 10

WILLISTON
 NH 2949 (1)
 VT ROUTE 2A
 SEE SHEET 199

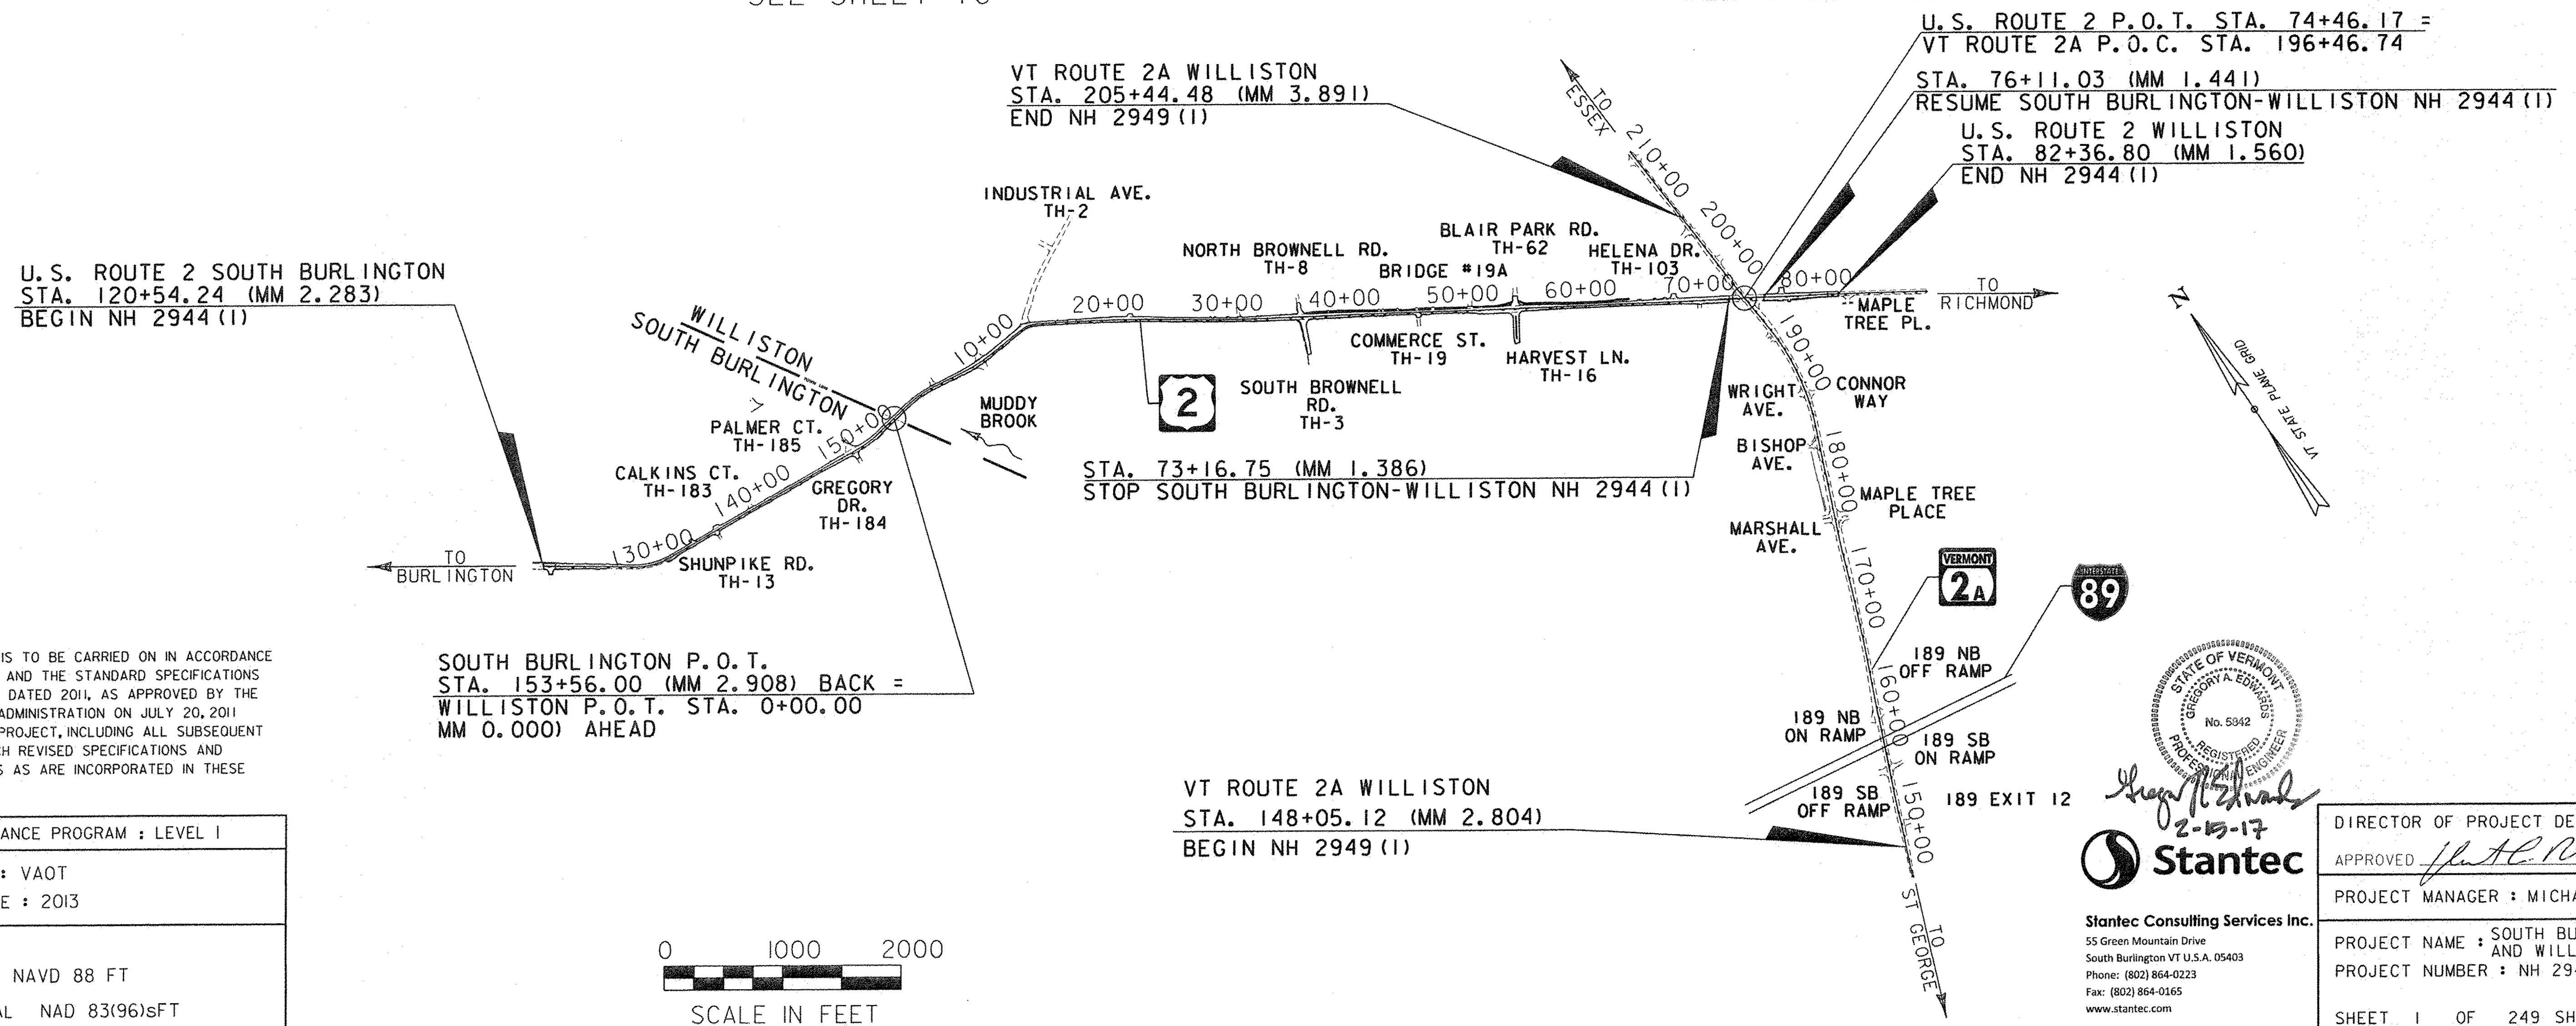

CONSTRUCTION IS TO BE CARRIED ON IN ACCORDANCE WITH THESE PLANS AND THE STANDARD SPECIFICATIONS FOR CONSTRUCTION DATED 2011, AS APPROVED BY THE FEDERAL HIGHWAY ADMINISTRATION ON JULY 20, 2011 FOR USE ON THIS PROJECT, INCLUDING ALL SUBSEQUENT REVISIONS AND SUCH REVISED SPECIFICATIONS AND SPECIAL PROVISIONS AS ARE INCORPORATED IN THESE PLANS.

QUALITY ASSURANCE PROGRAM : LEVEL I
SURVEYED BY : VAOT
SURVEYED DATE : 2013
DATUM
VERTICAL NAVD 88 FT
HORIZONTAL NAD 83(96)SFT

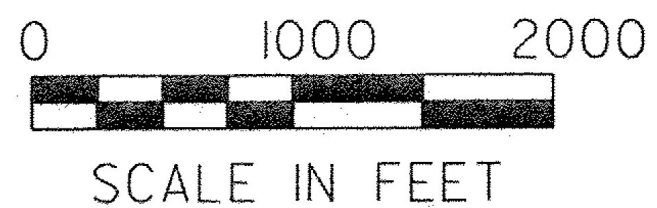

STATE OF VERMONT
 GREGORY A. EDWARDS
 No. 5342
 REGISTERED PROFESSIONAL ENGINEER

Joshua Hulett
 2-15-17

Stantec

Stantec Consulting Services Inc.
 55 Green Mountain Drive
 South Burlington VT U.S.A. 05403
 Phone: (802) 864-0223
 Fax: (802) 864-0165
 www.stantec.com

DIRECTOR OF PROJECT DELIVERY	APPROVED <i>[Signature]</i> DATE 2/16/2017
PROJECT MANAGER : MICHAEL FOWLER, P.E.	
PROJECT NAME : SOUTH BURLINGTON-WILLISTON AND WILLISTON	
PROJECT NUMBER : NH 2944 (1) AND NH 2949 (1)	
SHEET 1 OF 249 SHEETS	