


SIDE ROAD TRANSITION DETAIL NO. 1

SOUTH BURLINGTON
MILLHAM CT. TH#49 STA. 121+15, RT (44'-0")

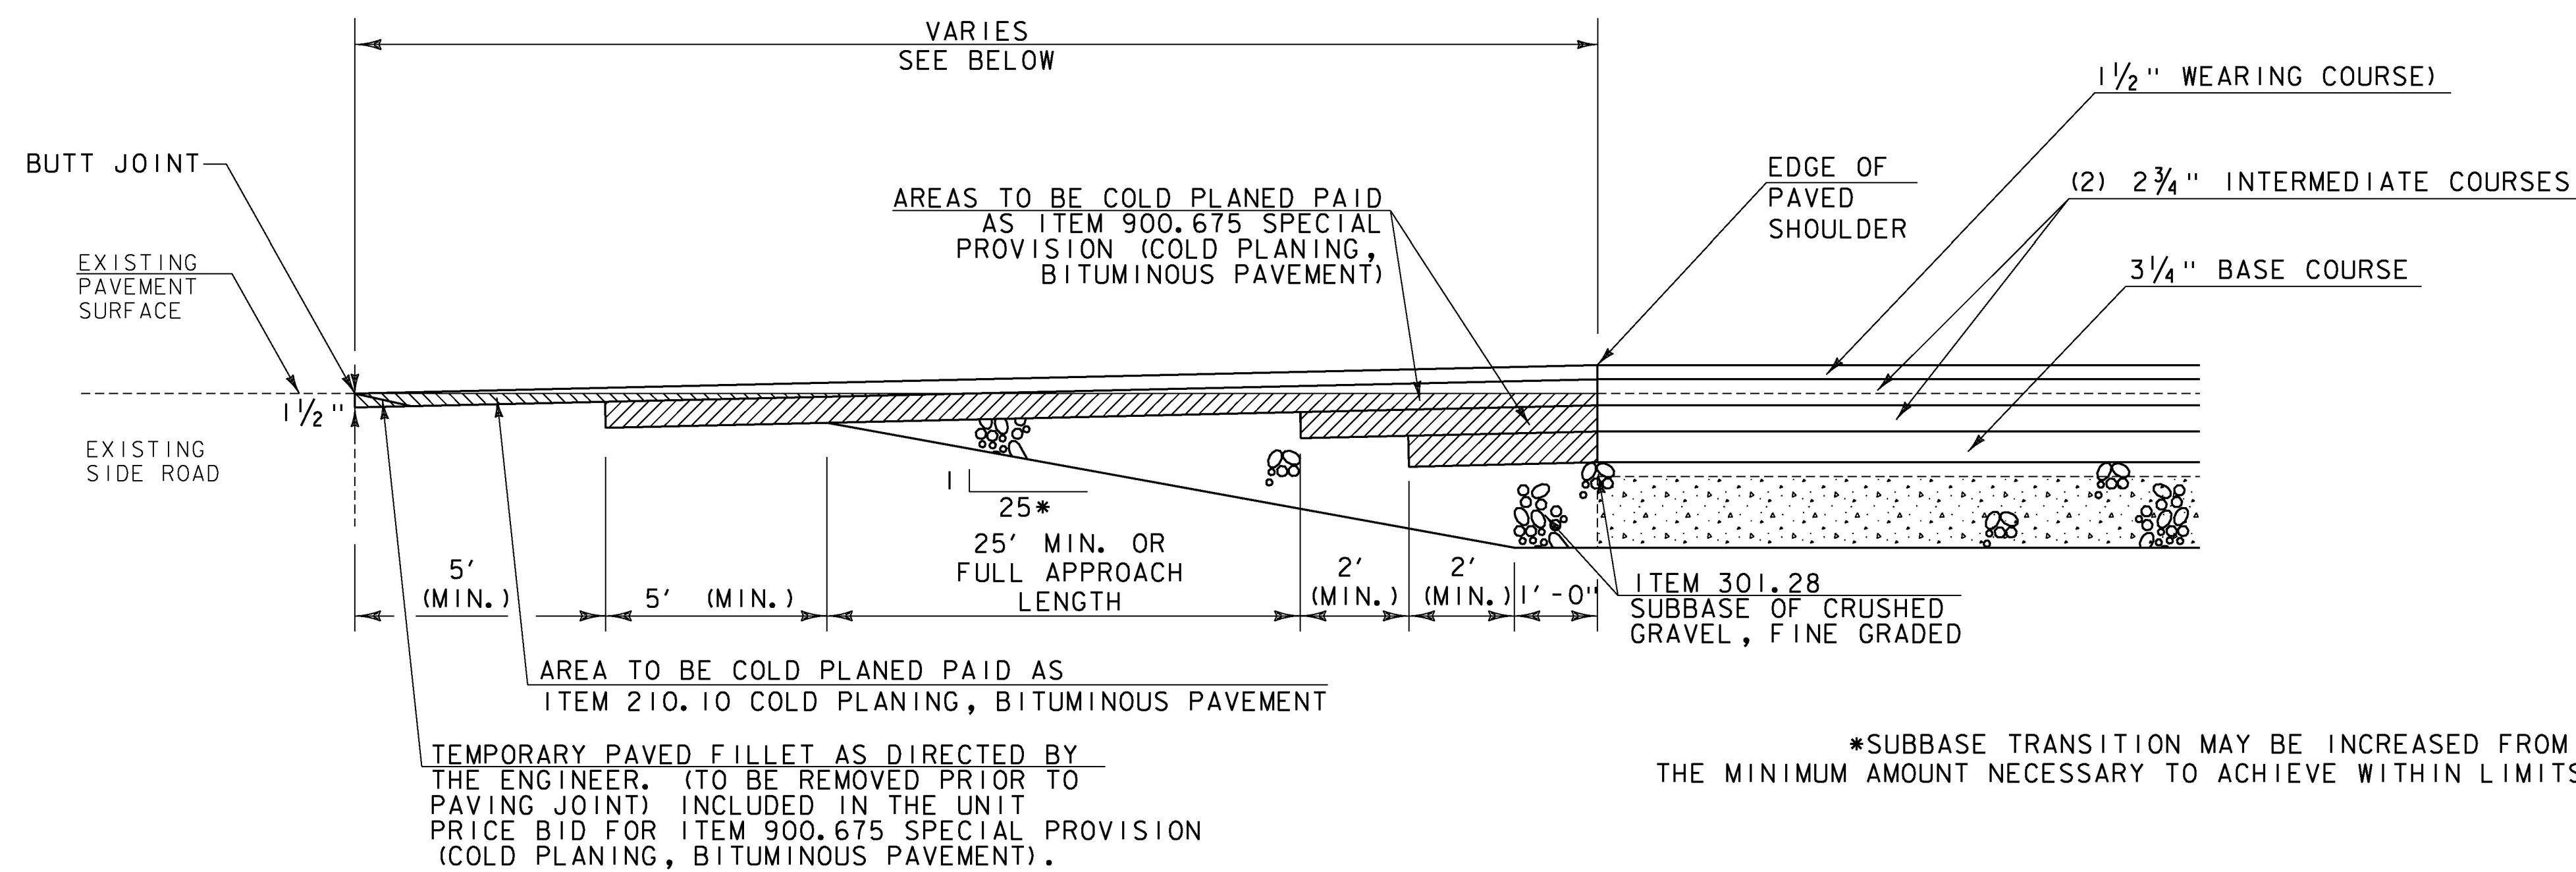

SIDE ROAD TRANSITION DETAIL NO. 1

SOUTH BURLINGTON
CALKINS CT. TH#183 STA. 133+60, LT (28'-7")
SHUNPIKE RD. TH#13 STA. 135+83, RT (25'-0")
VALLEY RD. STA. 135+91, LT (25'-0")
PALMER CT. TH#185 STA. 149+07, LT (94'-6")
GREGORY DR. TH#184 STA. 149+22, RT (48'-0")

*SUBBASE TRANSITION MAY BE INCREASED FROM 1:25
THE MINIMUM AMOUNT NECESSARY TO ACHIEVE WITHIN LIMITS SHOWN ON PLANS

 = EXISTING CONCRETE SLAB

NOT TO SCALE

PROJECT NAME: SOUTH BURLINGTON-WILLISTON
PROJECT NUMBER: NH 2944(1)

FILE NAME: zild340typ.dgn
PROJECT LEADER: G. EDWARDS
DESIGNED BY: D. DRAPER
TYPICAL SECTION SHEET 6

PLOT DATE: 2/15/2017
DRAWN BY: D. DRAPER
CHECKED BY: J. LITTLE
SHEET 17 OF 249

