



LOCATION				FEET OF DITCHING		MISCELLANEOUS ITEMS				REMARKS	LOCATION				FEET OF DITCHING		MISCELLANEOUS ITEMS				REMARKS
SITE	STATION	STATION	POS.	PERCENT GRADE		613.10 STONE FILL, TYPE 1 CY	649.31 GEOT. UNDER STONE FILL SY	651.15 SEED LB	653.20 TEMP. EROS. MATT. SY		SITE	STATION	STATION	POS.	PERCENT GRADE		613.10 STONE FILL, TYPE 1 CY	649.31 GEOT. UNDER STONE FILL SY	651.15 SEED LB	653.20 TEMP. EROS. MATT. SY	
				0-2.5	≥2.5										0-2.5	≥2.5					
SOUTH BURLINGTON U.S. ROUTE 2																					
1	127+10	128+75	LT	165				1	73	AS DIRECTED BY THE ENGINEER											
2	134+30	135+50	RT	120				1	53	AS DIRECTED BY THE ENGINEER											
3	136+05	138+26	RT	201				1	89	AS DIRECTED BY THE ENGINEER											
4	147+07 147+00	148+81 148+76	LT	174	92	87				AS DIRECTED BY THE ENGINEER											
DITCHING TOTALS				486	174	92		3*	215*	*TOTALS CARRIED FORWARD TO THE QUANTITY SHEETS, DETAILED SUMMARY OF QUANTITIES (SEE SHEETS 41-44)											

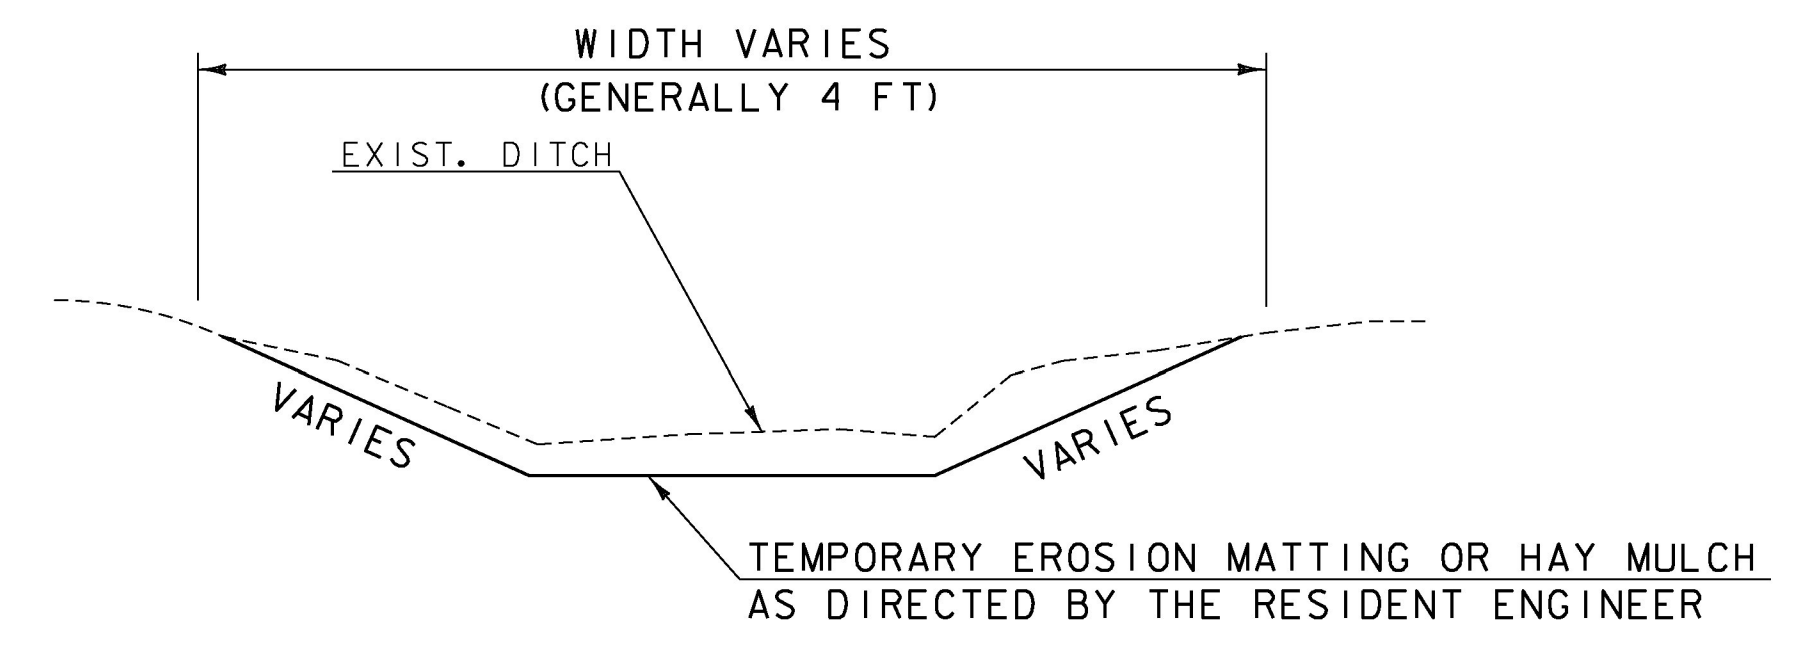

DITCH DETAIL < 2.5 PERCENT
NOT TO SCALE

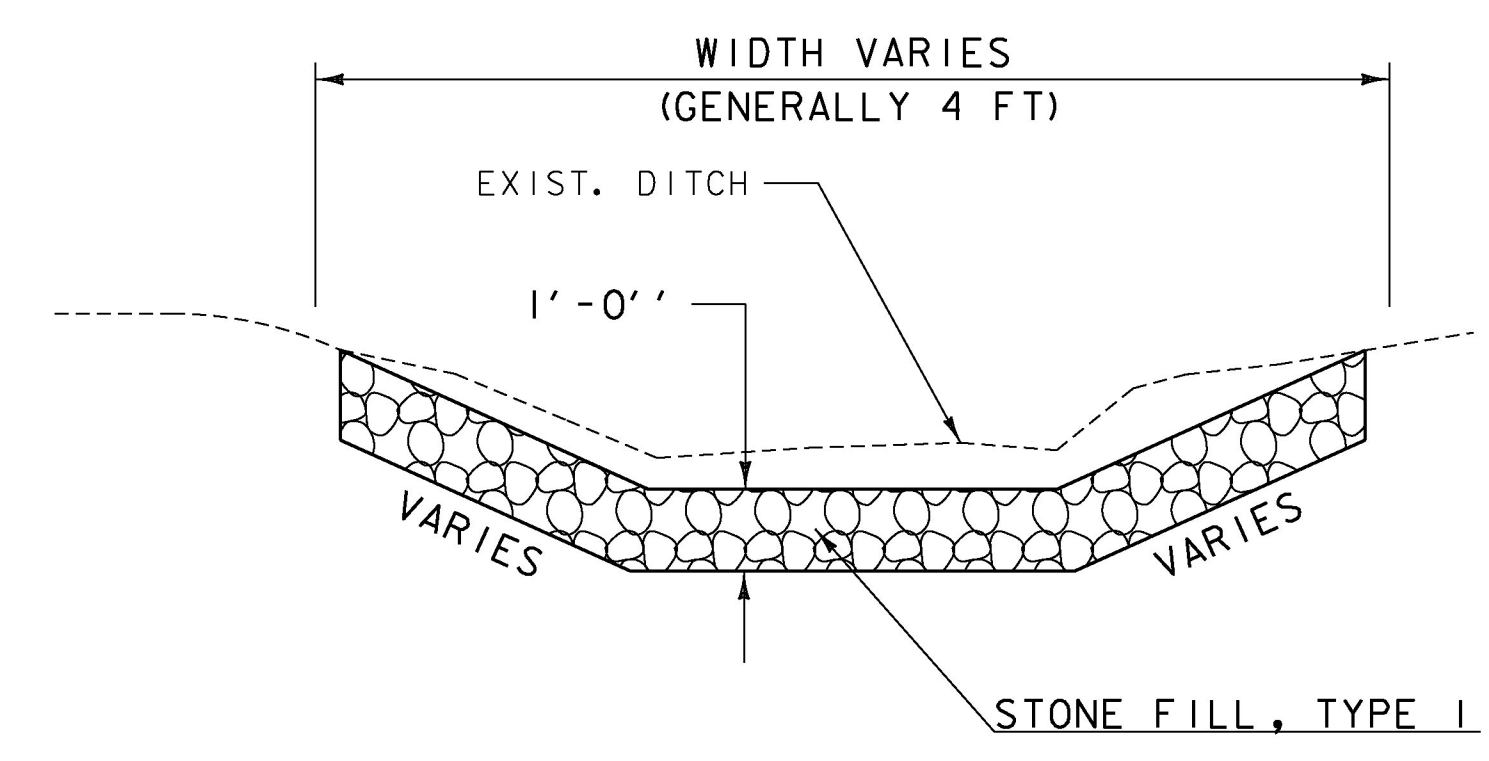

DITCH DETAIL 2.5 PERCENT TO 10 PERCENT
NOT TO SCALE

NOTES:

- GRADES BETWEEN 0 AND 2.5 PERCENT SHALL USE ITEM 651.15, SEED AND EITHER ITEM 651.25, HAY MULCH OR ITEM 653.20, TEMPORARY EROSION MATTING AS DIRECTED BY THE ENGINEER.
- GRADES BETWEEN 2.5 PERCENT TO 10 PERCENT SHALL USE ITEM 613.10, STONE FILL TYPE 1, AS DIRECTED BY THE ENGINEER.
- PIPE INLET AND OUTLET AREAS, AND DITCH CLEANING THROUGHOUT THE PROJECT, SHALL BE PERFORMED AT LOCATIONS IDENTIFIED ON THIS SHEET AND AS DIRECTED BY THE ENGINEER. PAYMENT WILL BE UNDER THE APPLICABLE EQUIPMENT RENTAL ITEM(S).

SEE SITEMANAGER / E-BOOKS FOR
LOCATIONS AND QUANTITIES
UTILIZED ON THIS PROJECT

NOT TO SCALE

PROJECT NAME:	SOUTH BURLINGTON-WILLISTON
PROJECT NUMBER:	NH 2944(I)
FILE NAME:	z1ld340de+alls.dgn
PROJECT LEADER:	G. EDWARDS
DESIGNED BY:	J. BURKE
DITCH CLEANING DETAIL SHEET	
PLOT DATE:	2/15/2017
DRAWN BY:	J. BURKE
CHECKED BY:	J. LITTLE
SHEET	26 OF 249

