



GREEN PAINTED BIKE LANE /
RIGHT TURN LANE PAVEMENT MARKINGS

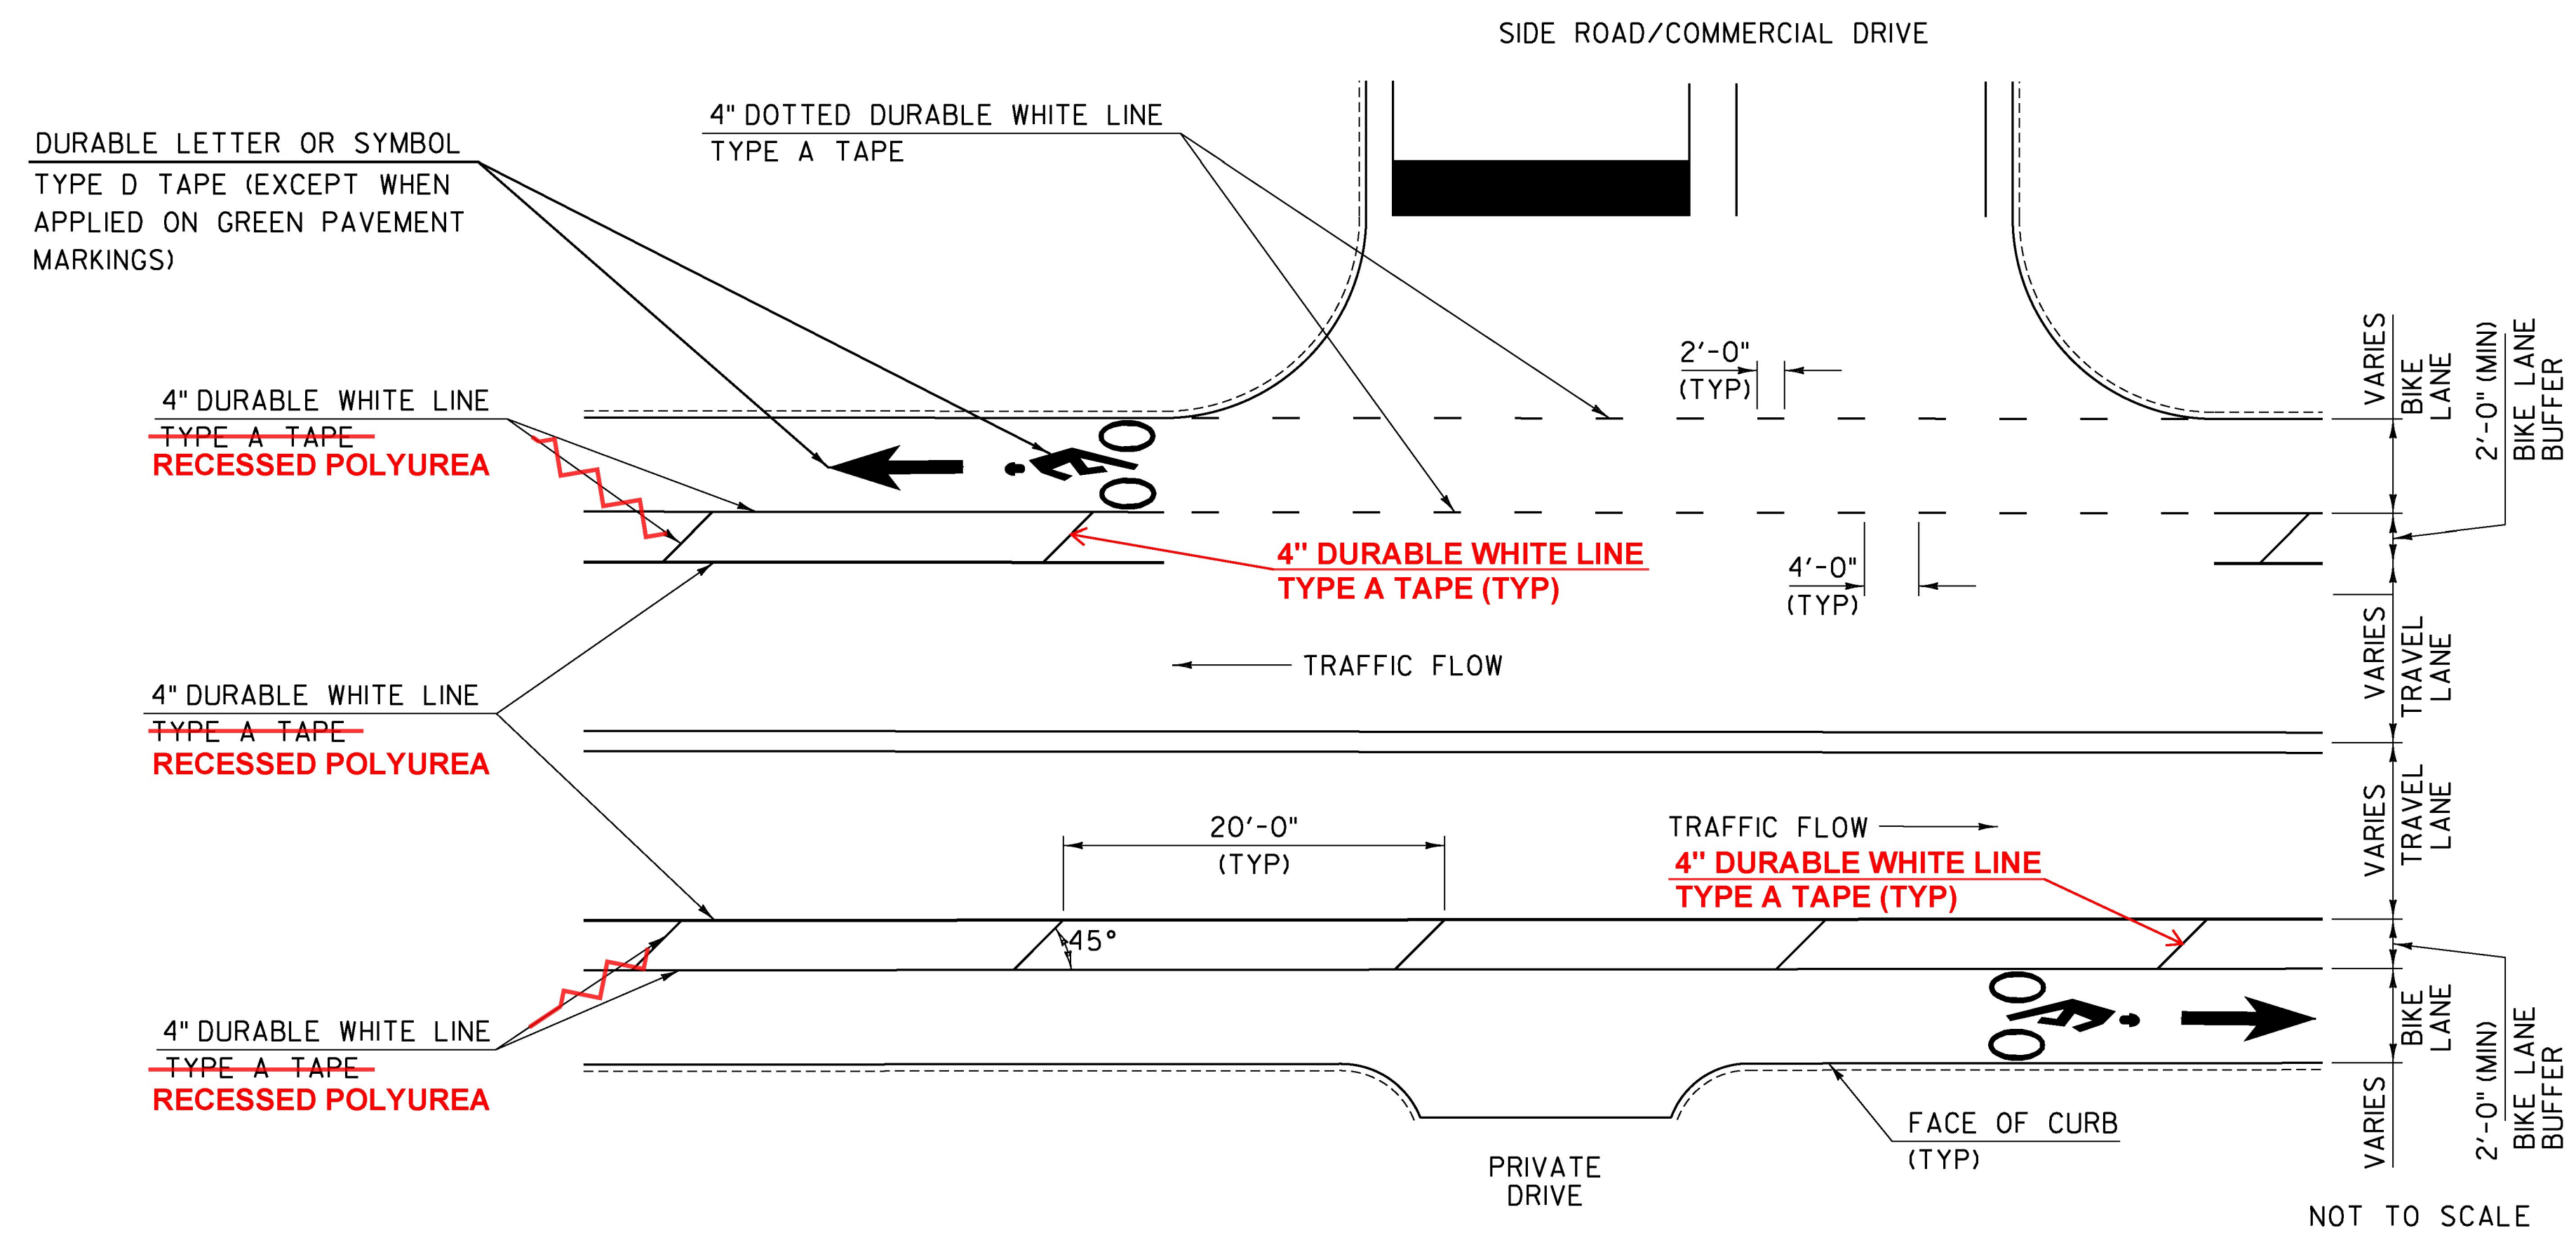

BIKE LANE BUFFER DETAIL

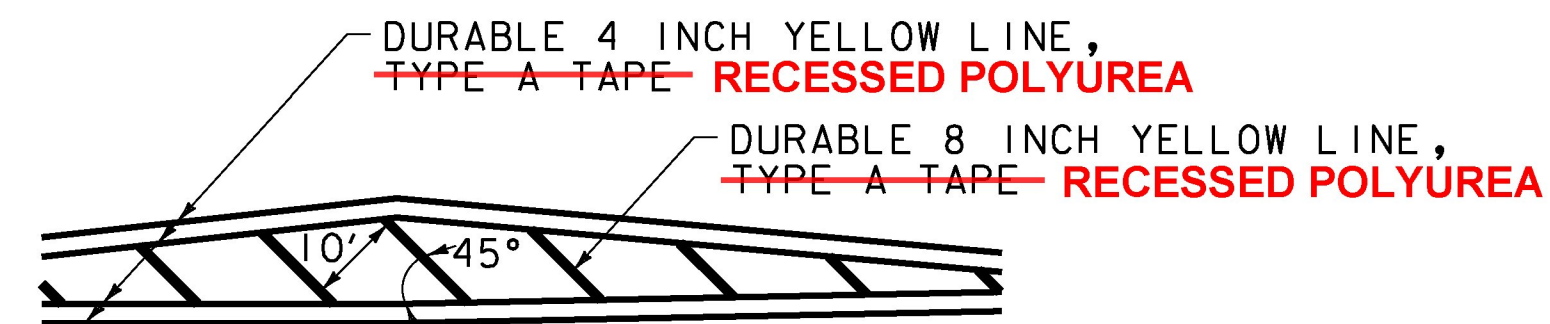

GORE MARKING DETAIL
SEE LAYOUT SHEETS FOR LOCATIONS

NOT TO SCALE

PROJECT NAME:	SOUTH BURLINGTON-WILLISTON
PROJECT NUMBER:	NH 2944(I)
FILE NAME:	zild340detalls.dgn
PROJECT LEADER:	G. EDWARDS
DESIGNED BY:	D. DRAPER
MISCELLANEOUS DETAIL SHEET 1	
PLOT DATE:	2/15/2017
DRAWN BY:	D. DRAPER
CHECKED BY:	J. LITTLE
	SHEET 27 OF 249

