
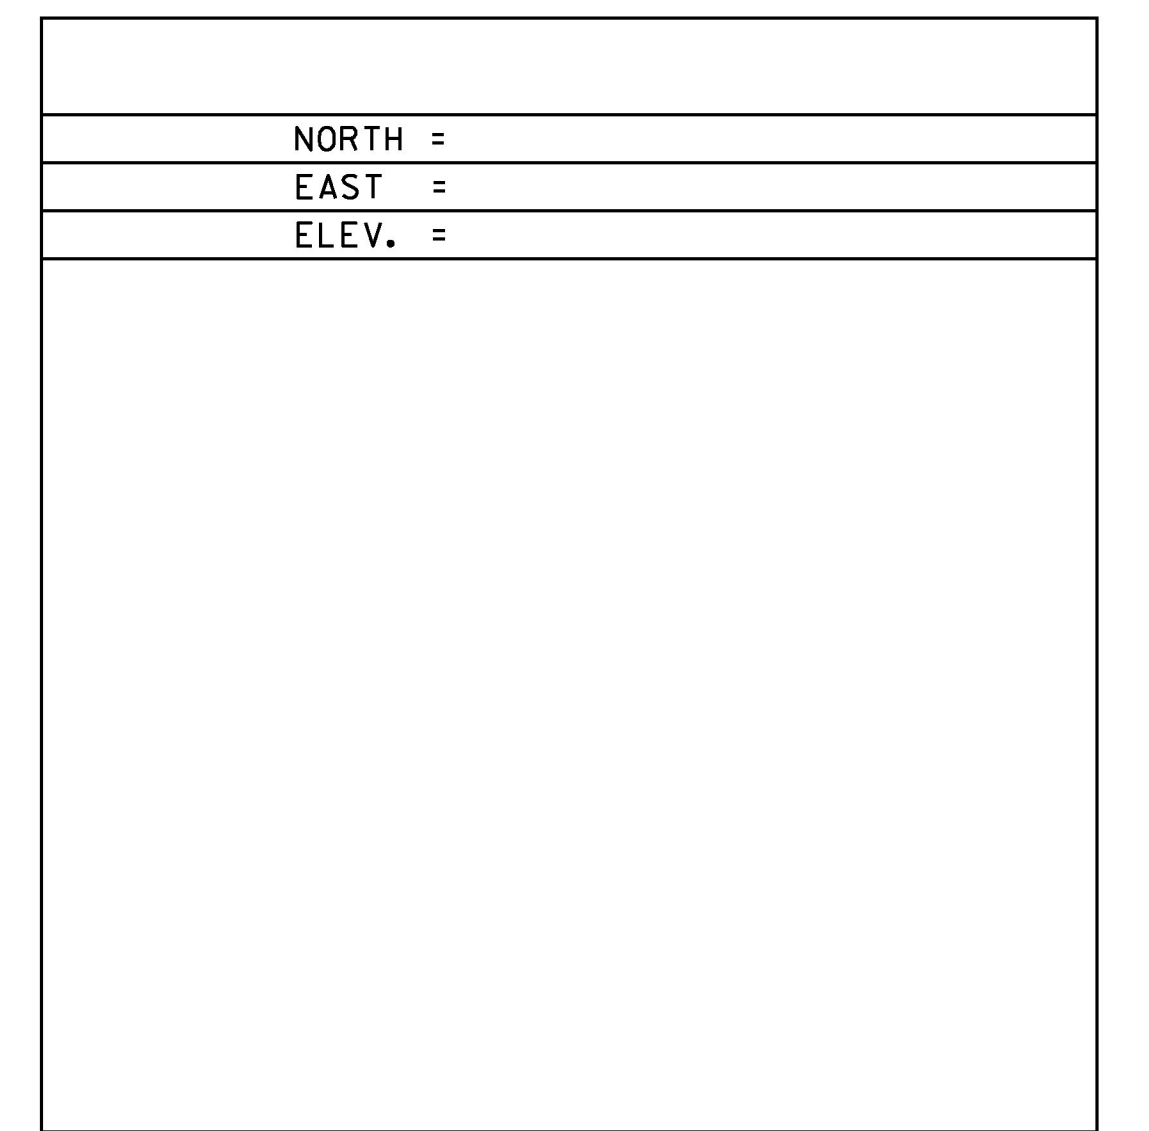
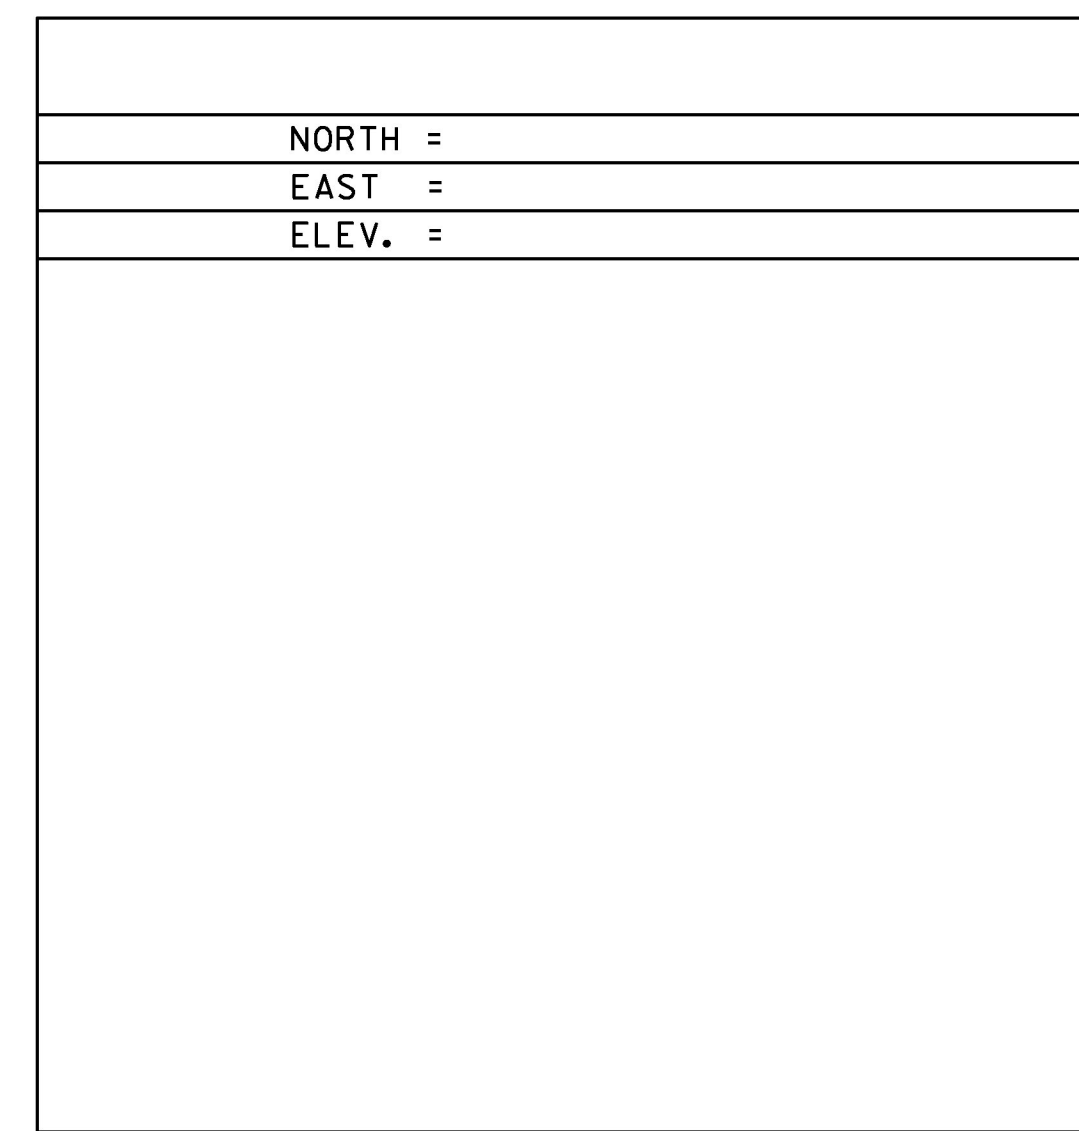
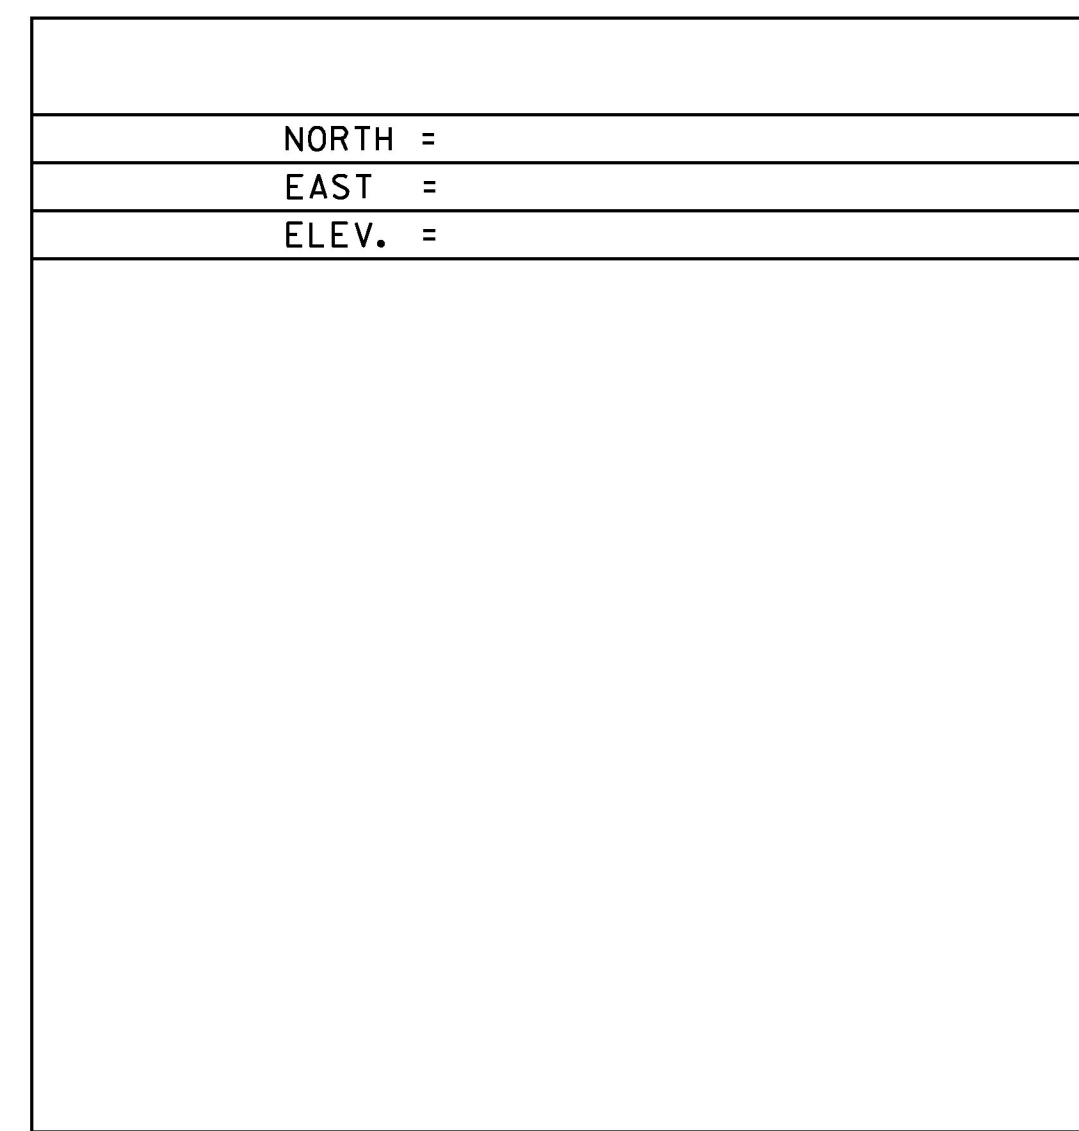
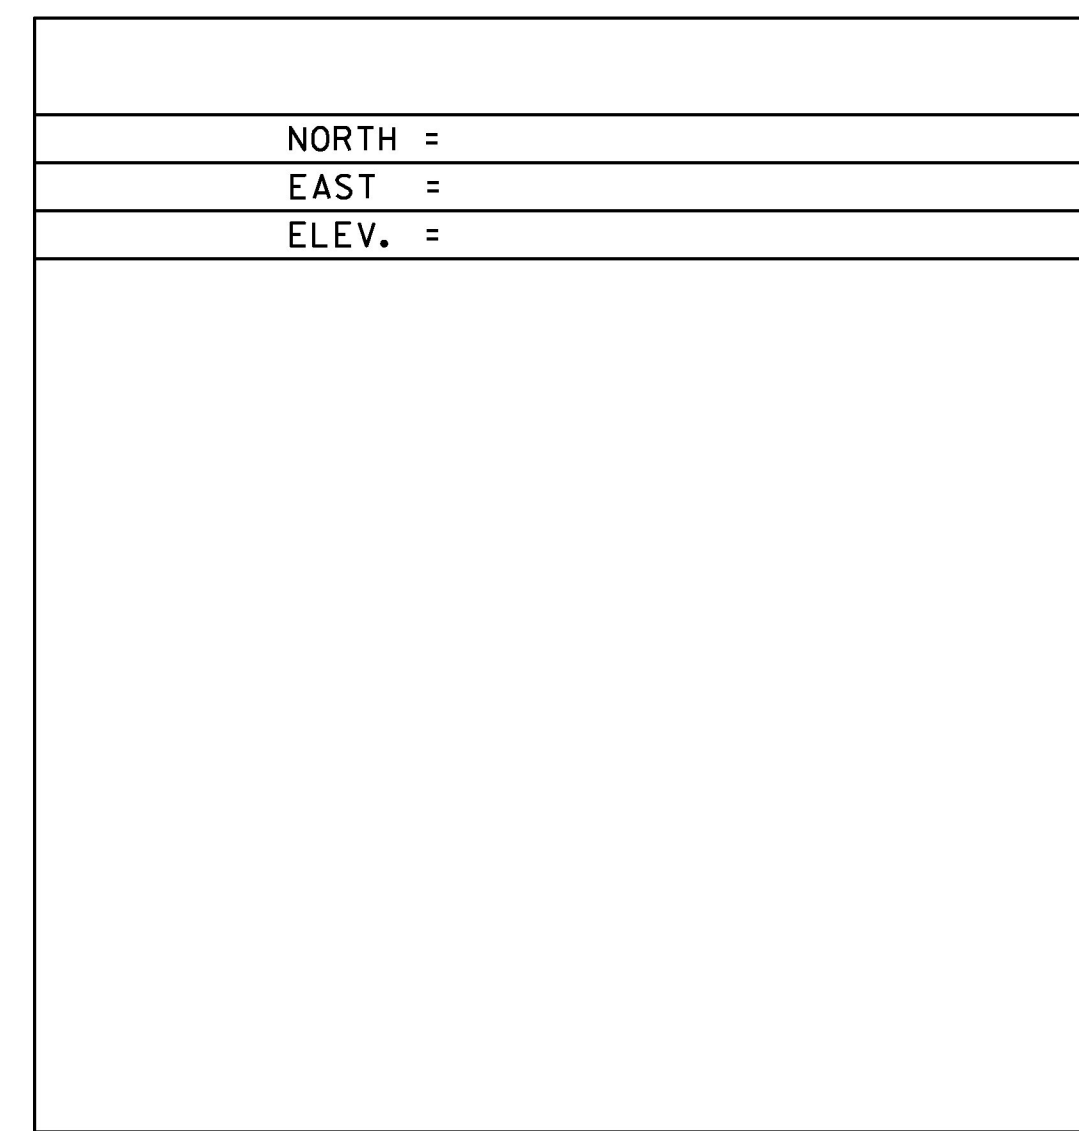
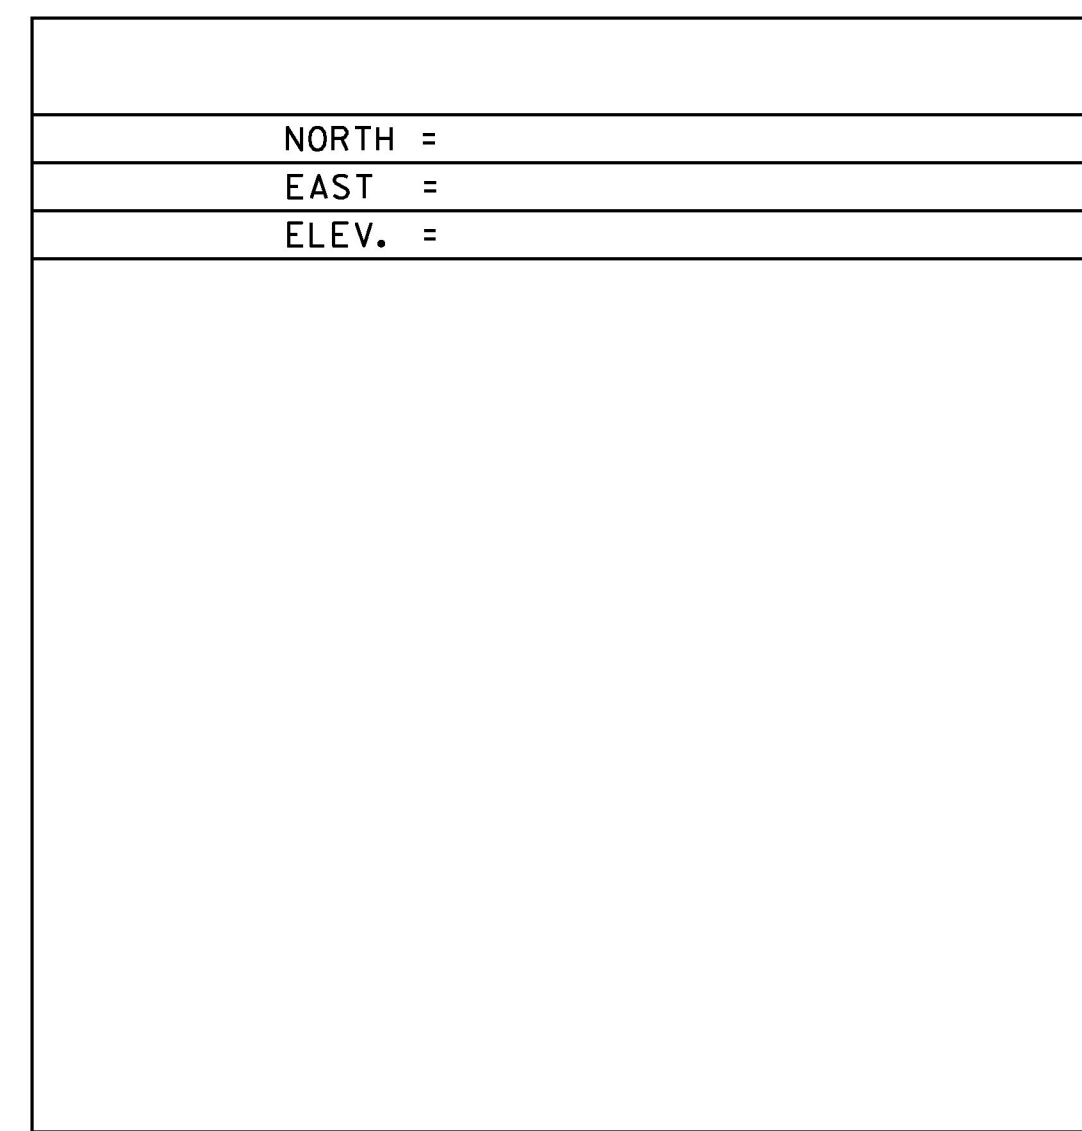
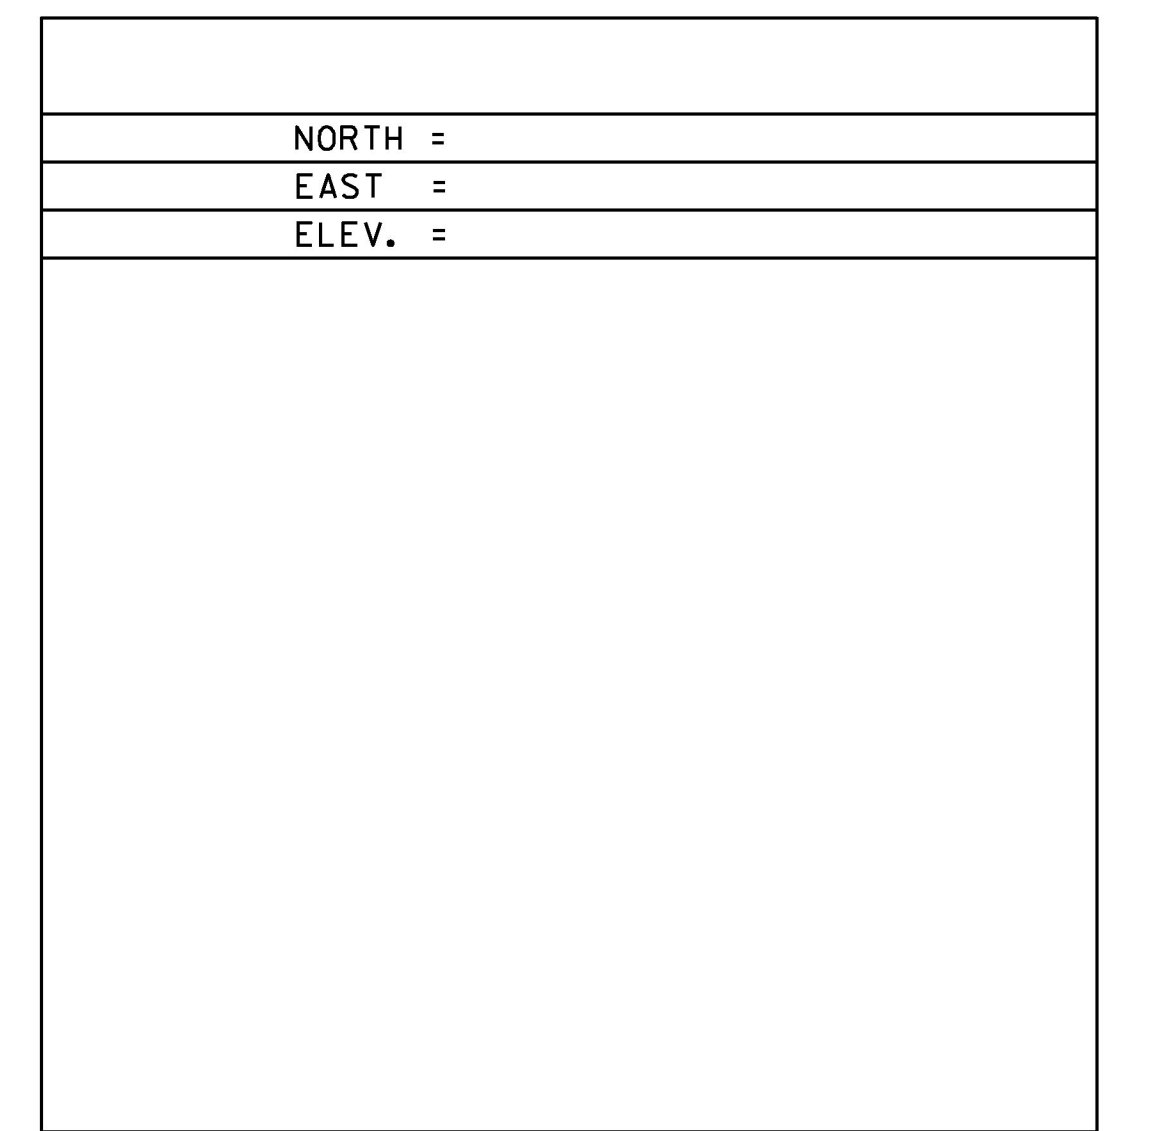
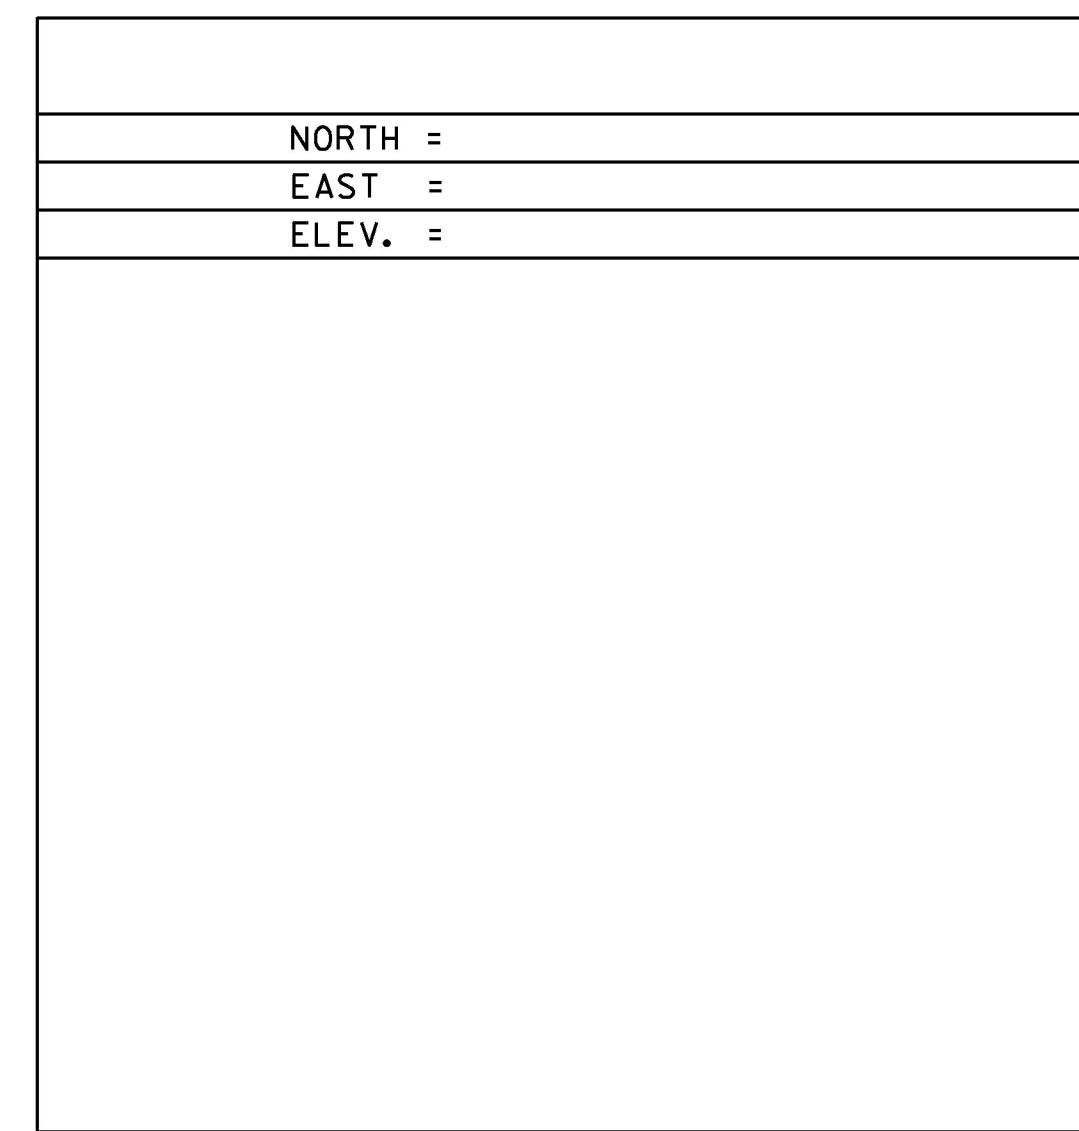
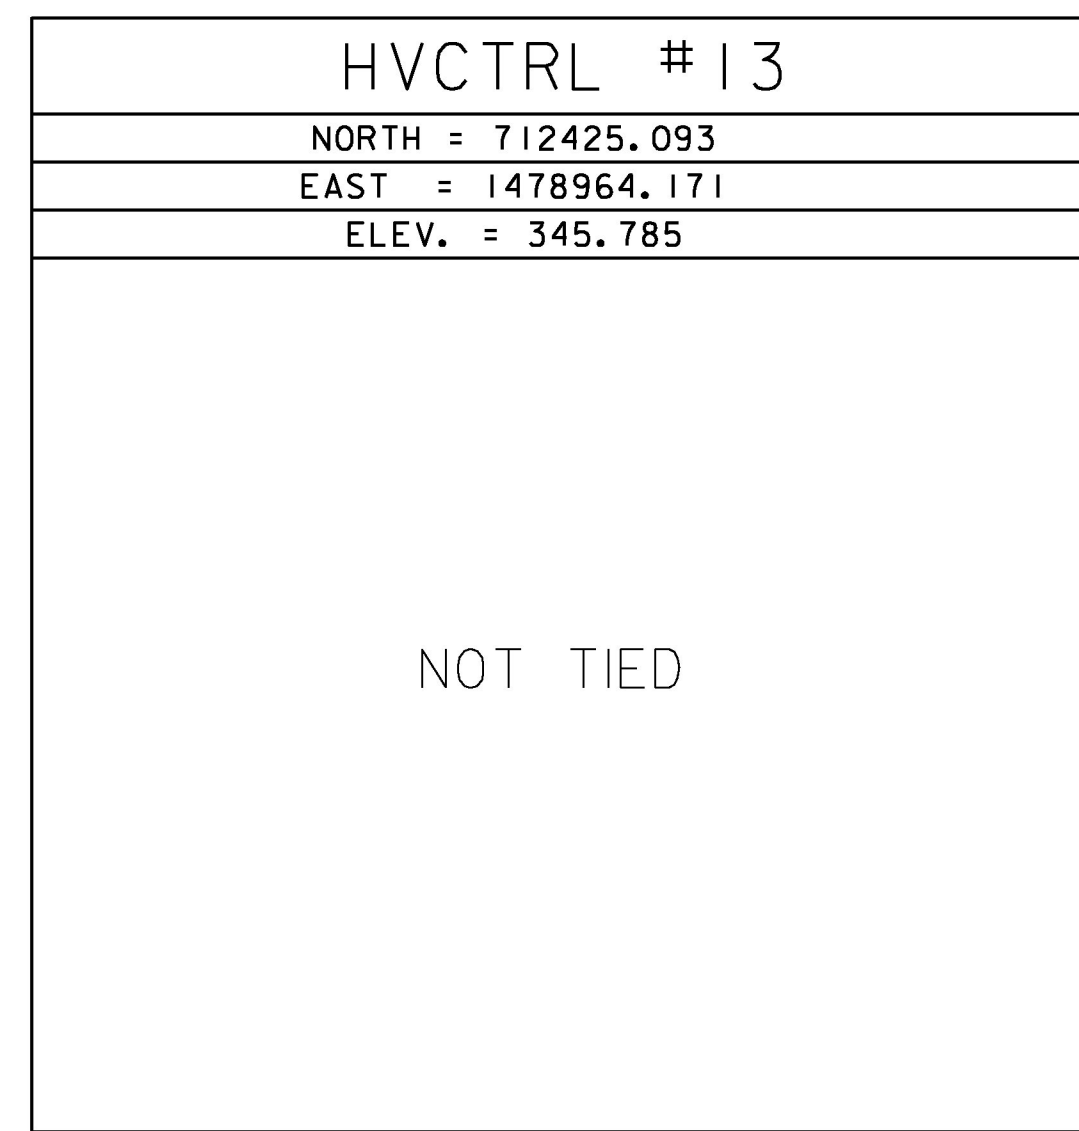
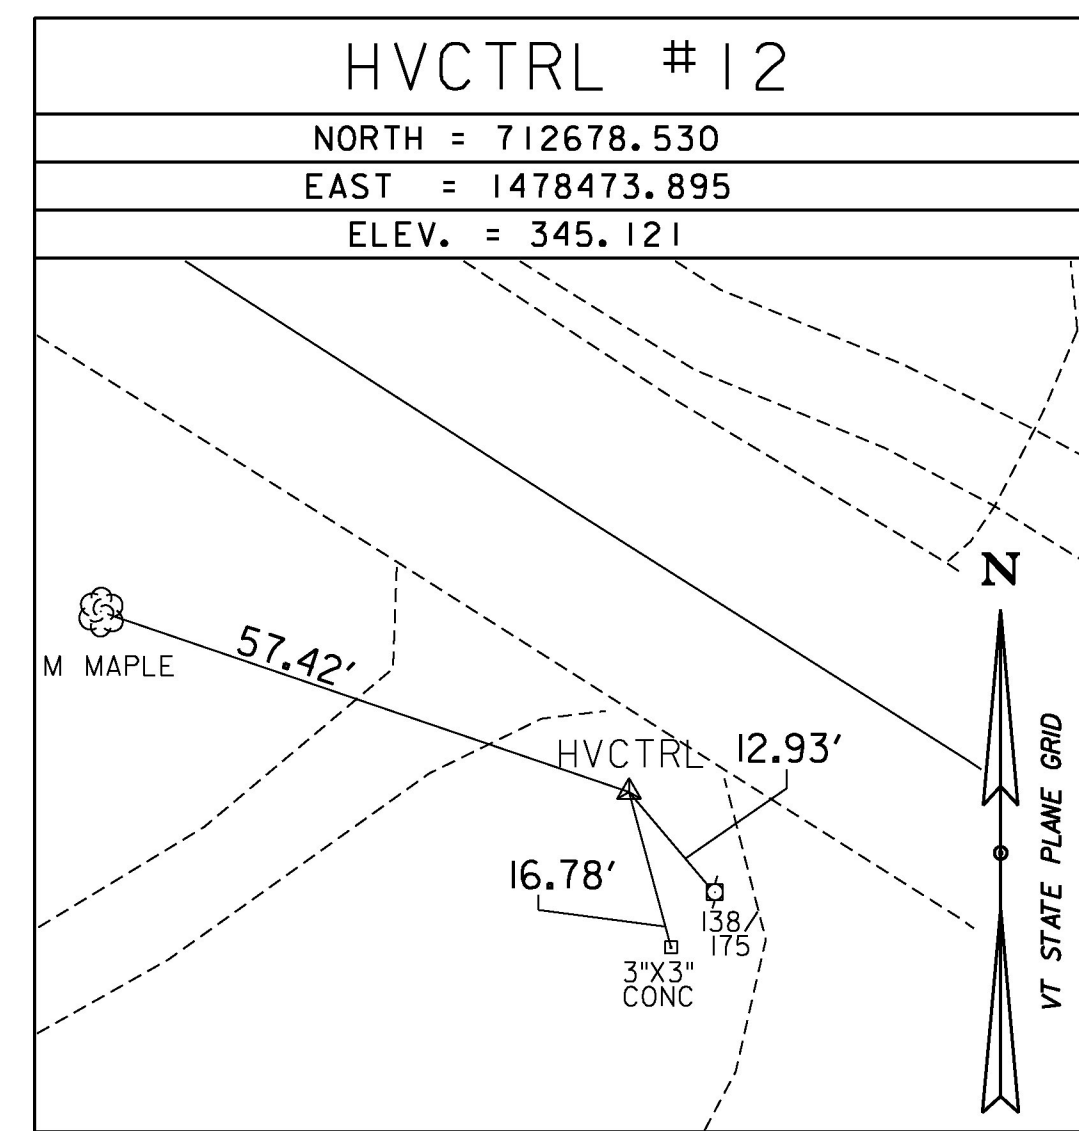


GPS CONTROL POINTS

TRAVERSE TIES

ALIGNMENT TIES

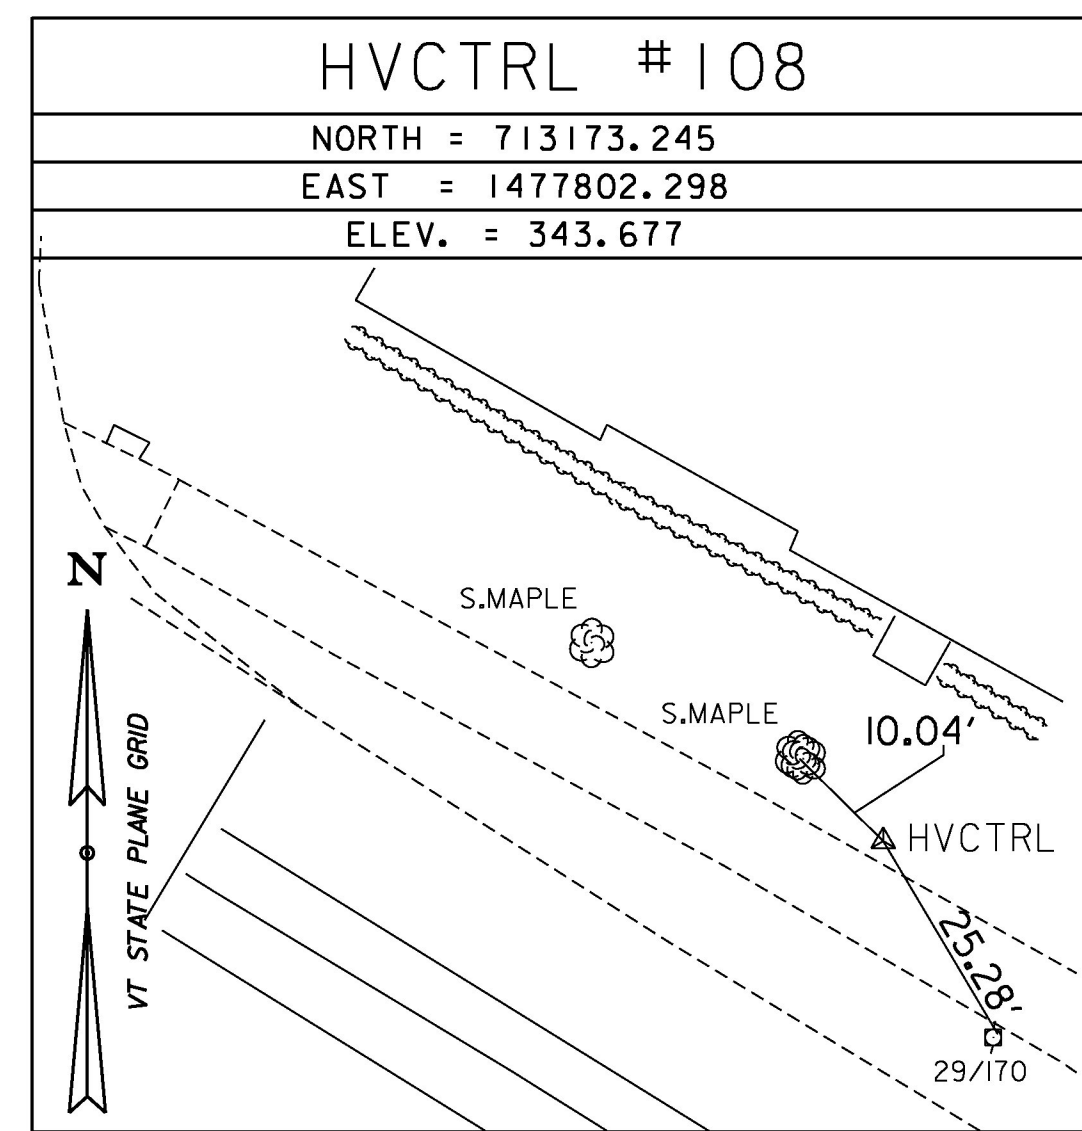

DATUM	
VERTICAL	NAVD 88
HORIZONTAL	NAD 83(1996)
ADJUSTMENT	COMPASS

PROJECT NAME: SOUTH BURLINGTON-WILLISTON	
PROJECT NUMBER: NH 2944(I)	
FILE NAME: Ild340/Survey/xld340+1	PLOT DATE: 2/15/2017
PROJECT LEADER: G. EDWARDS	DRAWN BY: D. DRAPER
DESIGNED BY: D. DRAPER	CHECKED BY: J. LITTLE
TIE SHEET 3	SHEET 32 OF 249