

CHANGING ELEVATION OF Dis, CBs OR MHS
SEE SHEET 21

REHAB.
Dis, CBs OR MHS, CLASS I OR II
SEE SHEET 21

BOX BEAM GUARDRAIL
SOUTH BURLINGTON STA. 151+00 TO 153+56.00, LT
WILLISTON STA. 0+00.00 TO 1+13.0, LT
SOUTH BURLINGTON STA. 152+07.0 TO 153+56.00, RT
WILLISTON STA. 0+00.00 TO 1+92.0, RT

REMOVAL AND DISPOSAL OF GUARDRAIL
SOUTH BURLINGTON STA. 151+00 TO 153+56.00, LT
SOUTH BURLINGTON STA. 152+27 TO 153+56.00, RT
WILLISTON STA. 0+00.00 TO 0+99.5, LT
WILLISTON STA. 0+00.00 TO 1+83, RT

DURABLE & TEMPORARY 4 INCH WHITE LINE
(ALL LINES WILL INCLUDE EDGE LINE BREAKS AND RADII FOR SIDE ROADS)
SOUTH BURLINGTON STA. 151+00 TO 153+56.00, EDGE LINE LT & RT
SOUTH BURLINGTON STA. 151+00 TO 153+56.00, BIKE LANE LINE LT & RT
SOUTH BURLINGTON STA. 151+00 TO 153+56.00, HATCH BUFFER LT & RT
SOUTH BURLINGTON STA. 151+00 TO 151+81, DOTTED LT
WILLISTON STA. 0+00.00 TO 2+00, EDGE LINE LT & RT
WILLISTON STA. 0+00.00 TO 1+26.72, BIKE LANE LINE LT & RT
WILLISTON STA. 0+00.00 TO 1+26.72, HATCH BUFFER LT & RT

DURABLE & TEMPORARY 4 INCH YELLOW LINE
(ALL LINES WILL INCLUDE EBREAKS FOR SIDE ROADS)
SOUTH BURLINGTON STA. 151+00 TO 153+56.00, SOLID LT & RT
WILLISTON STA. 0+00.00 TO 2+00, SOLID LT & RT

REMOVING SIGNS
AS SHOWN - 7

ERECTING SALVAGED SIGNS
AS SHOWN - 1

CAST IN PLACE CONCRETE CURB, TYPE B
STA 151+25 TO 151+29 RT (EAST END AUTO)
STA 152+01 TO 152+05 RT (EAST END AUTO)


DELINEATOR WITH STEEL POST
1+90 TO 2+00 RT

REMOVAL OF EXISTING CURB
151+30 RT
152+00 RT

SOUTH BURLINGTON
P.O.T. STA. 153+56.00 (MM 2.908) BACK =
WILLISTON
P.O.T. STA. 0+00.00 (MM 0.000) AHEAD

WILLISTON STA. 0+26.72
STOP CONCRETE REMOVAL
BEGIN TRANSITION

WILLISTON STA. 1+26.72
END TRANSITION
BEGIN COLD PLANE,
LEVEL & OVERLAY

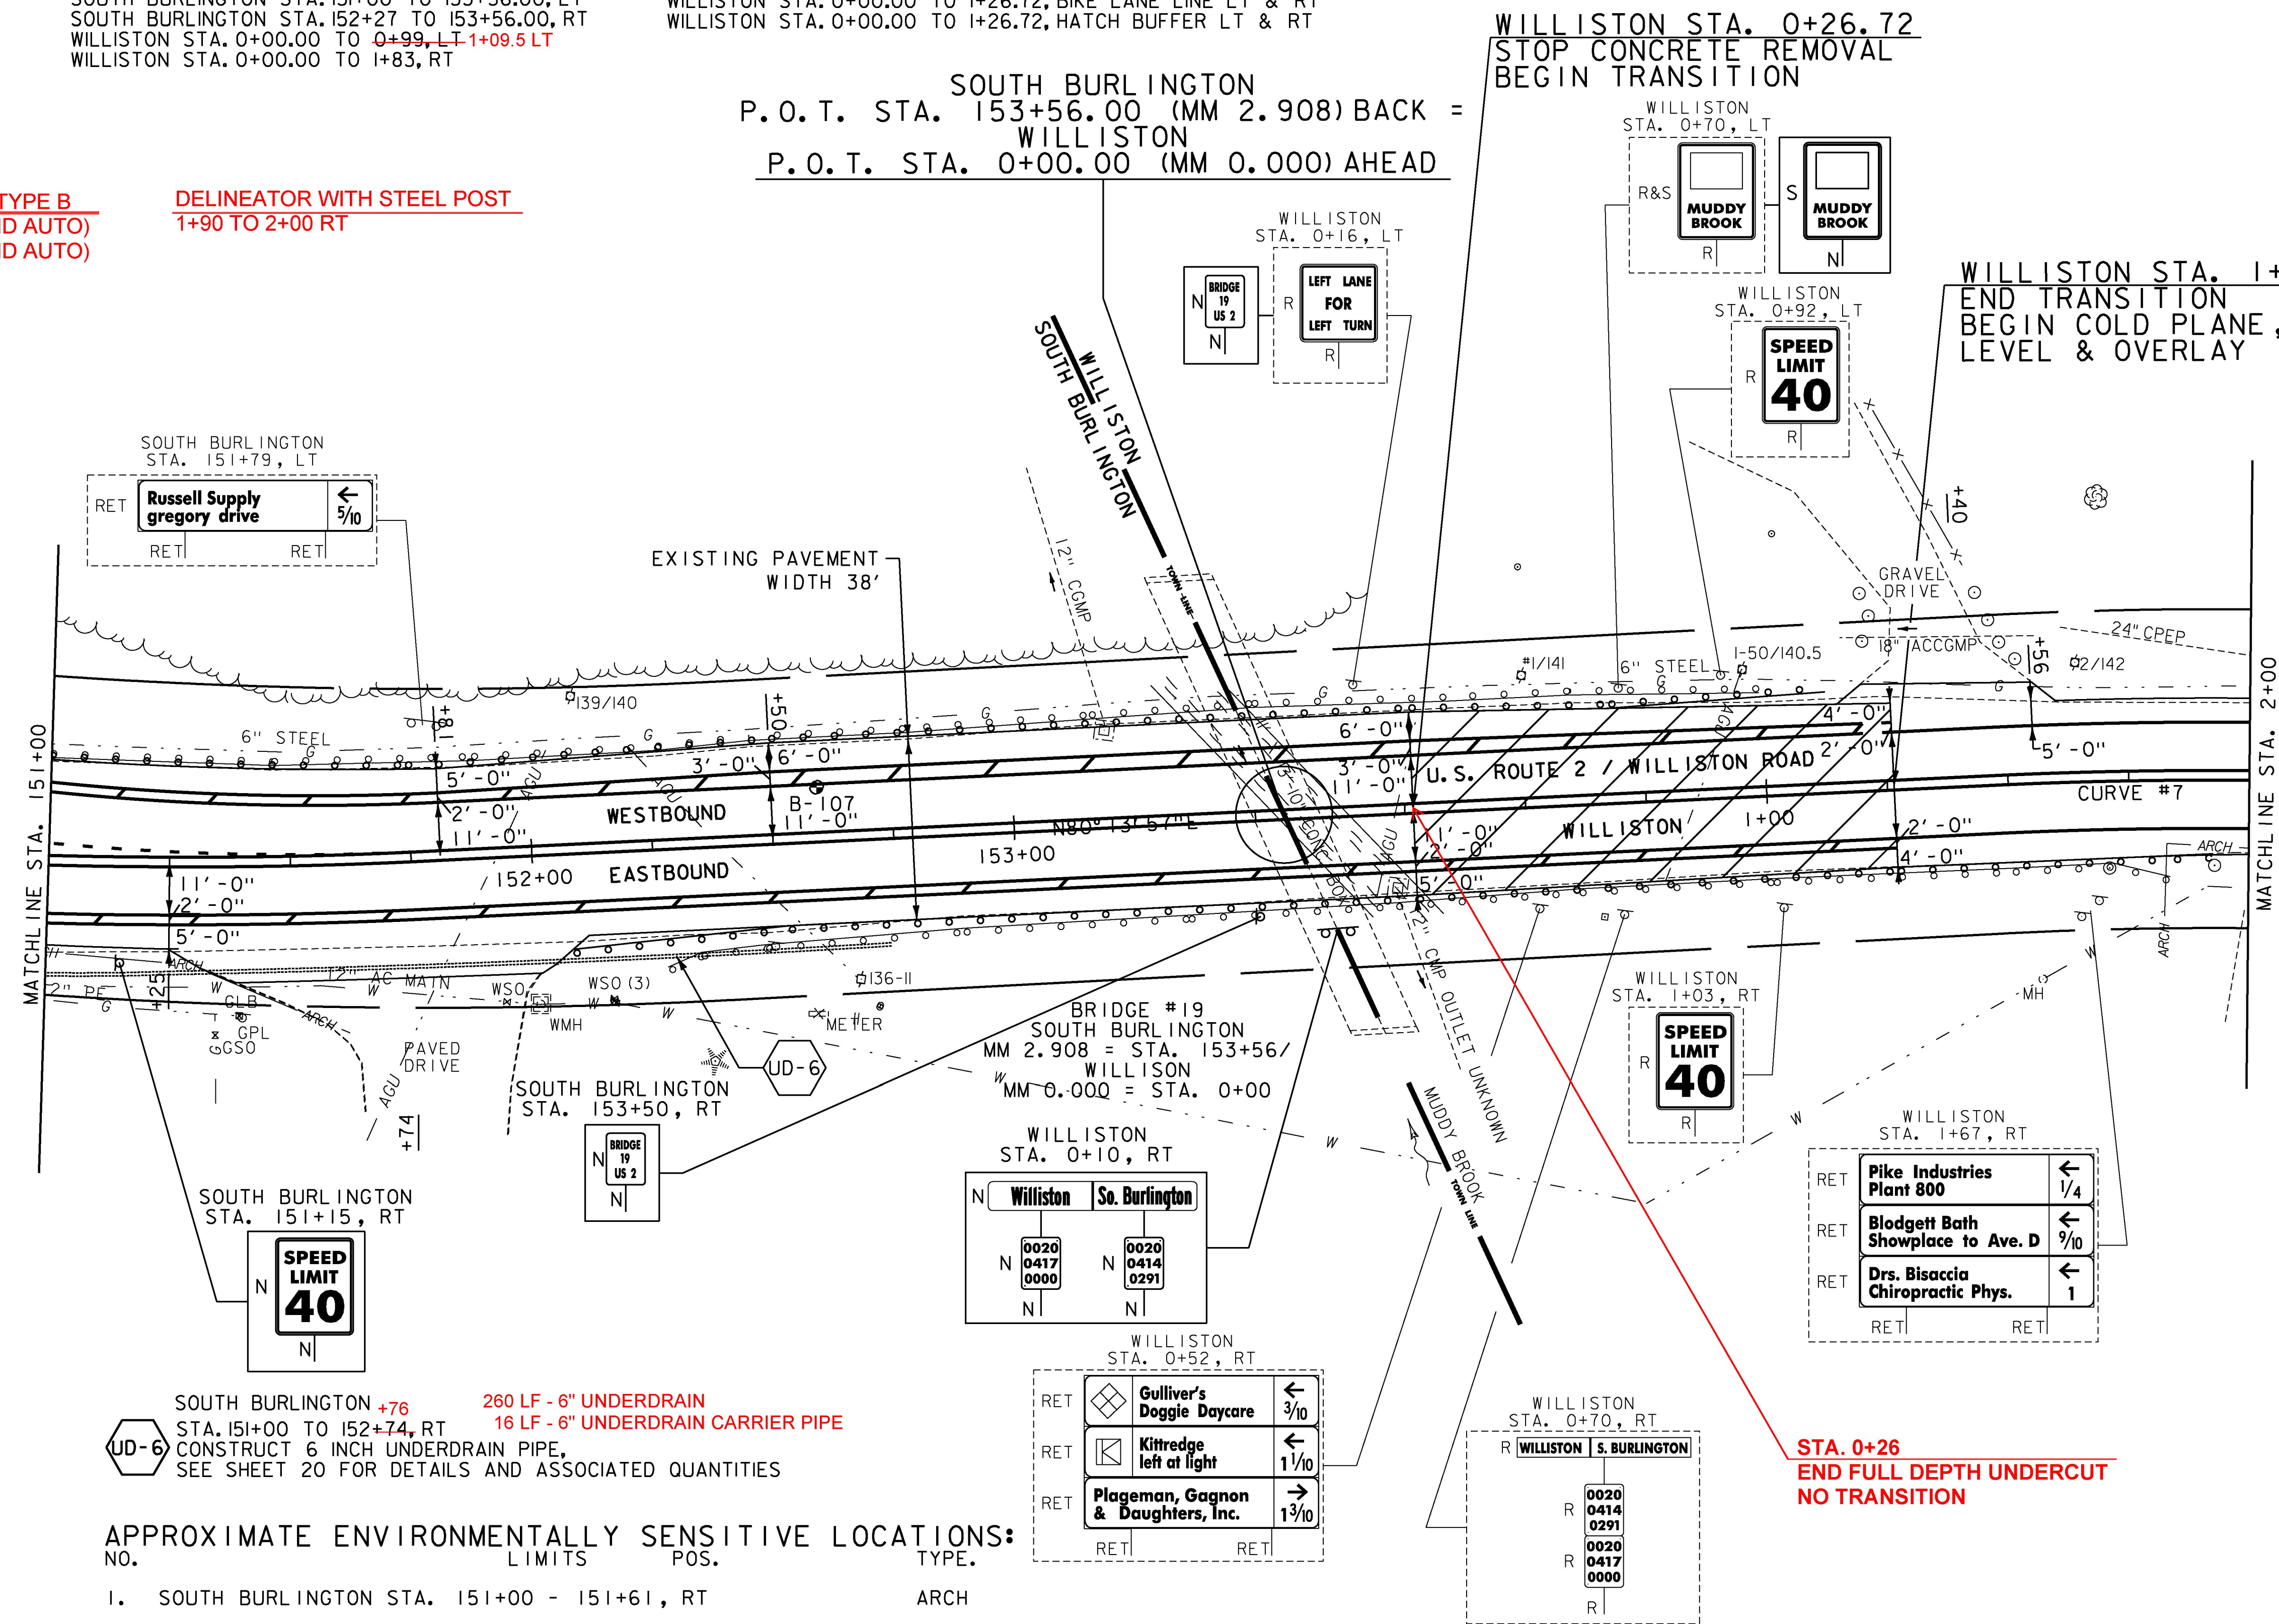

UD-6 SOUTH BURLINGTON +76
STA. 151+00 TO 152+74, RT
CONSTRUCT 6 INCH UNDERDRAIN PIPE,
SEE SHEET 20 FOR DETAILS AND ASSOCIATED QUANTITIES

260 LF - 6" UNDERDRAIN
16 LF - 6" UNDERDRAIN CARRIER PIPE


APPROXIMATE ENVIRONMENTALLY SENSITIVE LOCATIONS:

NO.	LIMITS	POS.	TYPE.
1.	SOUTH BURLINGTON STA. 151+00 - 151+61, RT		ARCH

- NOTES:**
- FOR LEGENDS, SEE SHEETS 3-4.
 - ALL EXISTING SIGNS NOT SHOWN ON THE PLANS SHALL BE RETAINED.
 - ALL WORK SHALL BE CONSTRUCTED WITHIN THE ROADWAY RIGHT OF WAY.

SOIL BORING DATA

BORING#	DEPTH (FT.)	PCC	COMMENTS
B-107	5.0'	NO	

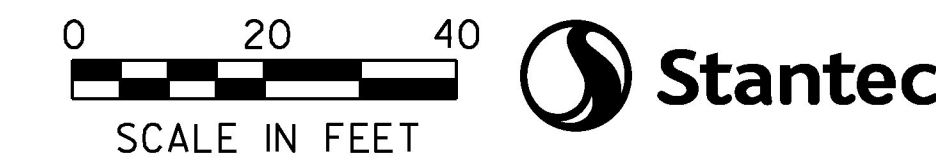

PROJECT NAME: SOUTH BURLINGTON-WILLISTON
PROJECT NUMBER: NH 2944(I)

FILE NAME: zild340bdr.dgn
PROJECT LEADER: G. EDWARDS
DESIGNED BY: D. DRAPER
LAYOUT SHEET 7

PLOT DATE: 2/15/2017
DRAWN BY: D. DRAPER
CHECKED BY: J. LITTLE
SHEET 55 OF 249