

**DURABLE & TEMPORARY 4 INCH WHITE LINE**  
 (ALL LINES WILL INCLUDE EDGE LINE BREAKS AND RADII FOR SIDE ROADS)  
 STA. 12+00 TO 12+79, SOLID CL (LANE LINE)  
 STA. 12+00 TO 16+00, EDGE LINE RT  
 STA. 12+00 TO 12+80, EDGE LINE LT  
 STA. 12+80 TO 14+06, DOTTED LANE LINE LT  
 STA. 12+80 TO 14+17, DOTTED LANE LINE LT  
 STA. 13+20, SOLID LT (EDGELINES, INDUSTRIAL AVE. TH-2)  
 STA. 14+17 TO 15+86, BIKE LANE LINE LT  
 STA. 14+17 TO 15+86, HATCH BUFFER LT  
 STA. 14+17 TO 16+00, EDGE LINE LT


**DURABLE & TEMPORARY 4 INCH YELLOW LINE**  
 (ALL LINES WILL INCLUDE C BREAKS FOR SIDE ROADS)  
 STA. 12+00 TO 12+39, DOUBLE SOLID LT  
 STA. 14+16 TO 16+00, SOLID LT & RT

**DURABLE & TEMPORARY LETTER OR SYMBOL**  
 STA. 12+22, LT BIKE LANE ARROW  
 STA. 12+25, LT ARROW  
 STA. 12+33, LT BIKE LANE SYMBOL  
 STA. 12+83, RT BIKE LANE SYMBOL  
 STA. 12+95, RT BIKE LANE ARROW  
 STA. 14+54, LT BIKE LANE ARROW  
 STA. 14+55, RT BIKE LANE SYMBOL  
 STA. 14+66, LT BIKE LANE SYMBOL  
 STA. 14+66, RT BIKE LANE ARROW

**DURABLE & TEMPORARY 24 INCH STOP BAR**  
 STA. 12+38, LT  
 STA. 12+78, RT  
 STA. 14+18, LT

**REMOVING SIGNS**  
 AS SHOWN - 10


**SPECIAL PROVISION (GREEN PAVEMENT MARKINGS - BICYCLE LANE)**  
 STA. 12+80 TO 14+17, BIKE LANE LT  
 SEE SHEET 27

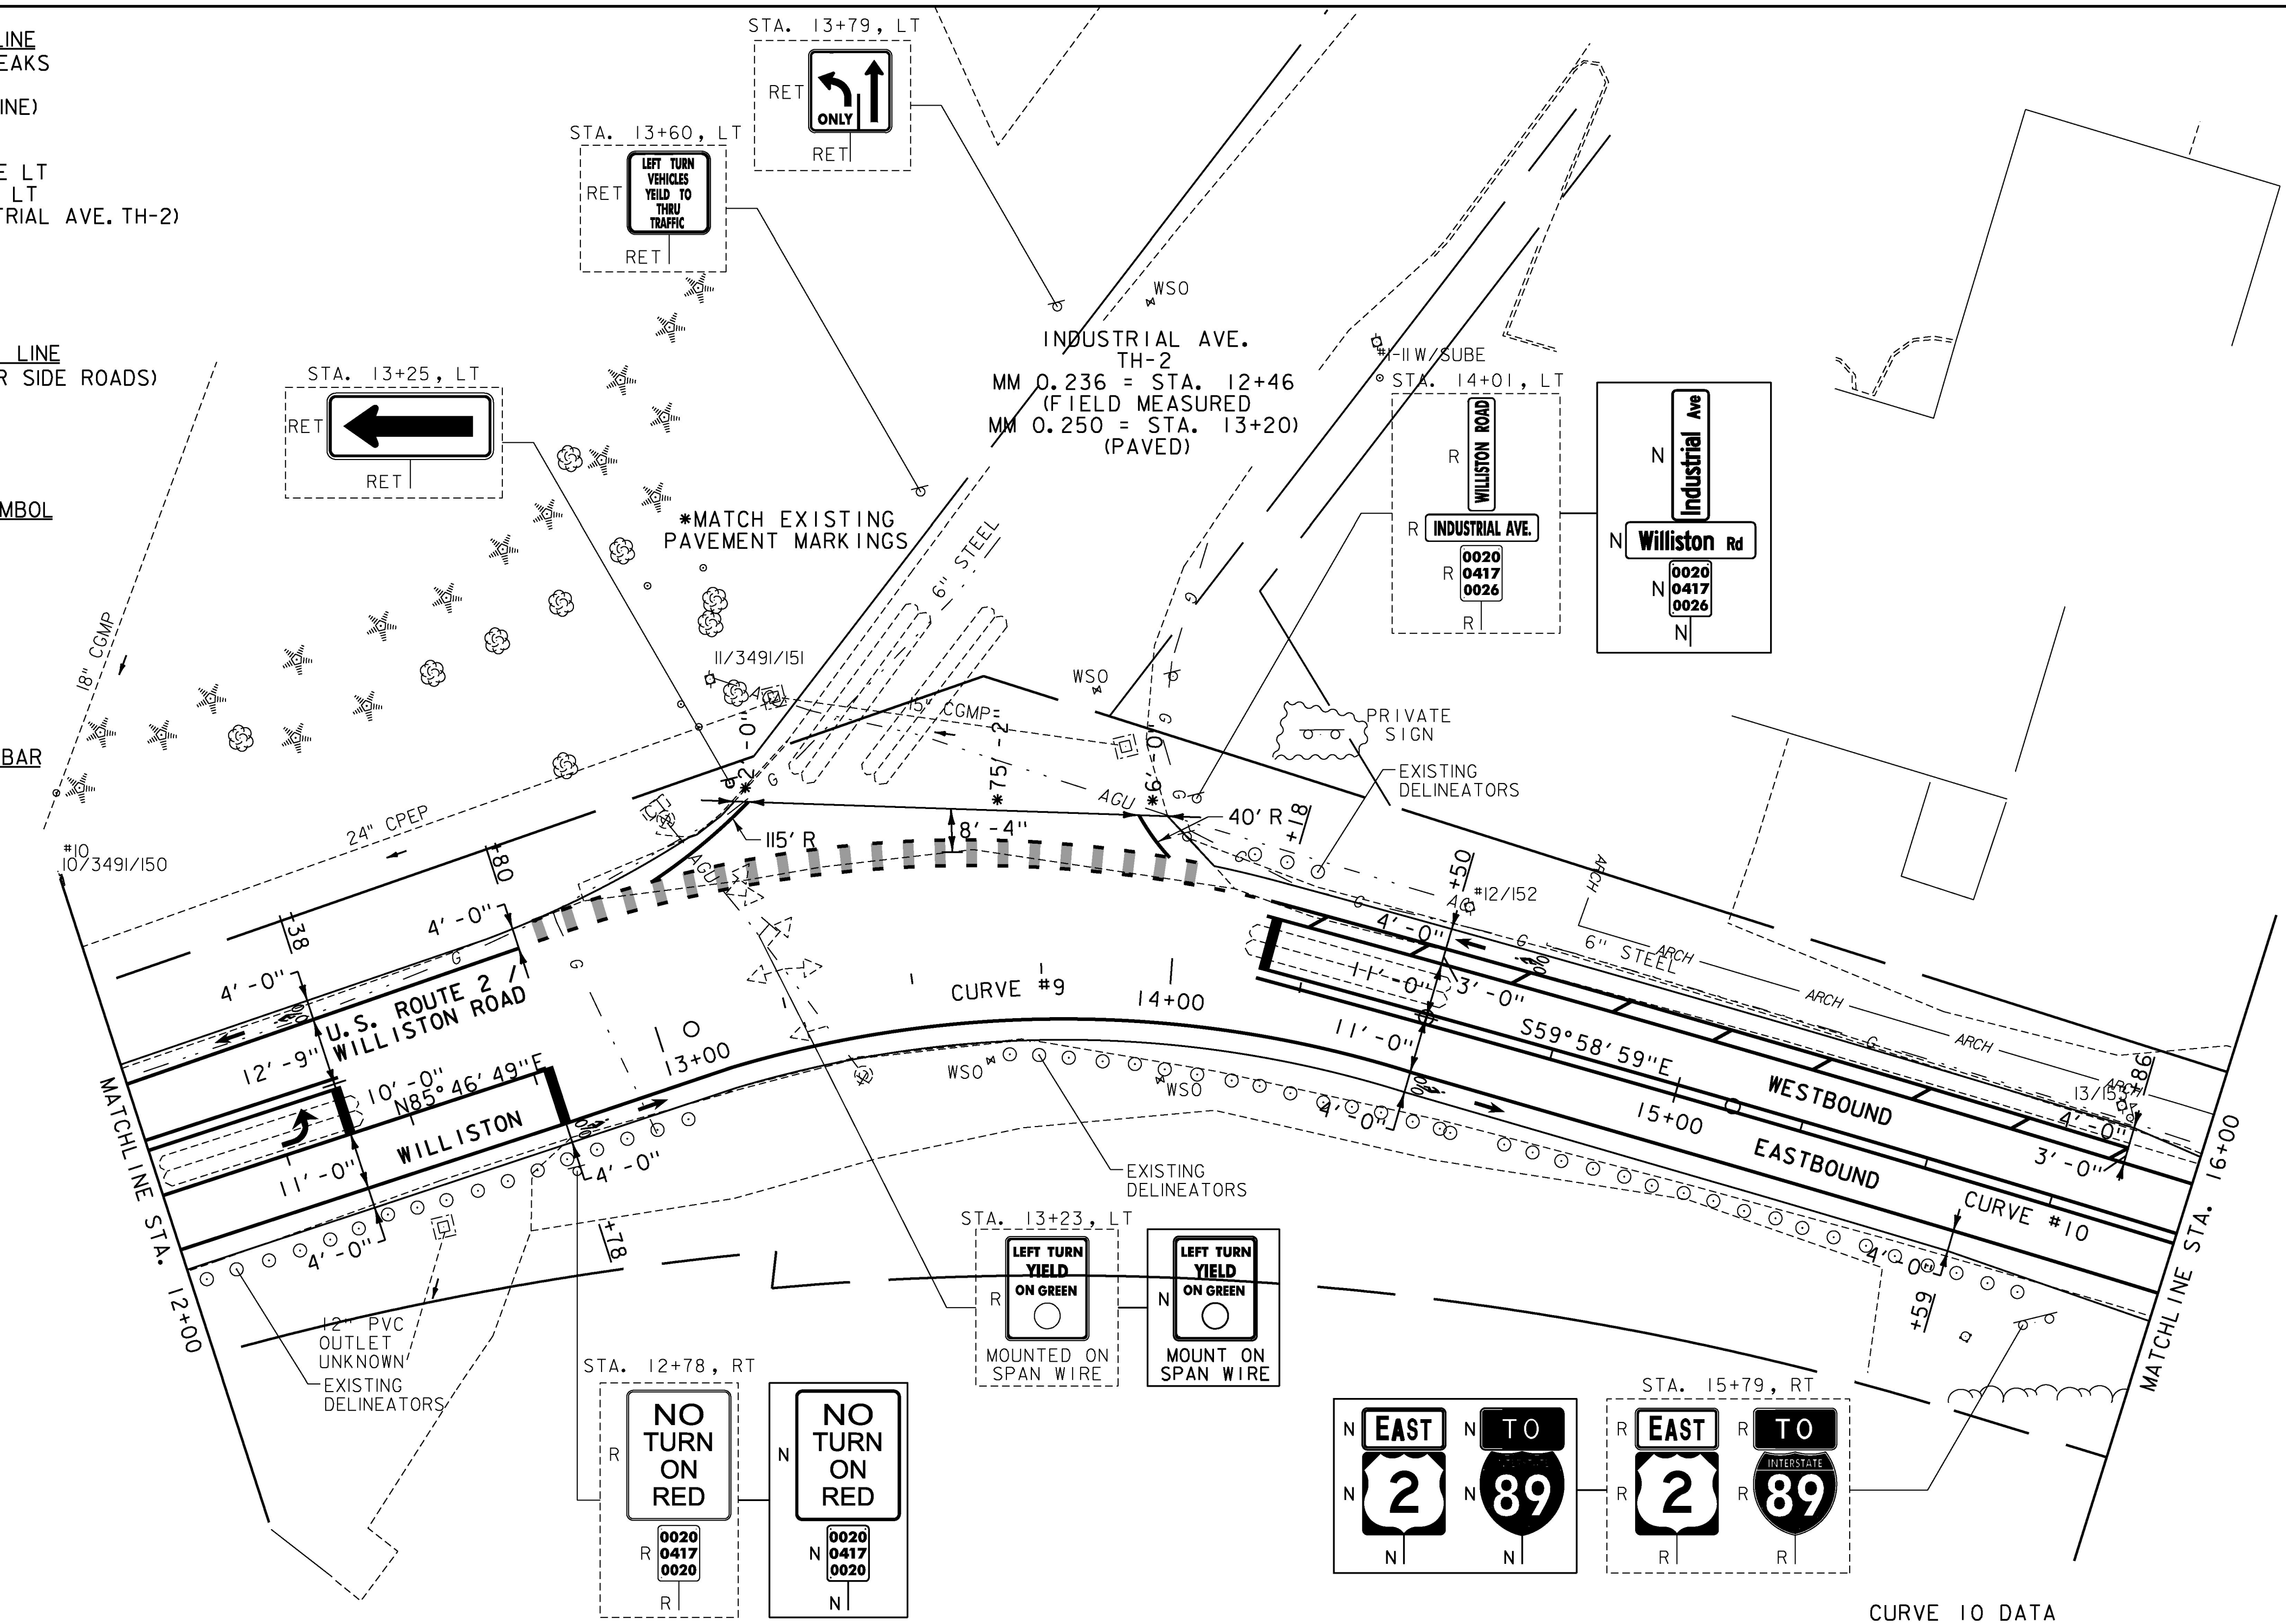

**CURVE 9 DATA**  
 PC = STA 13+06.47  
 PT = STA 14+49.88  
 $\Delta = 34^\circ 14' 11.59''$  RT  
 D = 23° 52' 23.67"  
 R = 240.00'  
 T = 73.92'  
 L = 143.41'  
 E = 11.13'  
 e = 6.0%

**CURVE 10 DATA**  
 PC = STA 15+11.2  
 PT = STA 16+17.24  
 $\Delta = 1^\circ 07' 21.41''$  RT  
 D = 1° 03' 32.66"  
 R = 5410.00'  
 T = 53.00'  
 L = 106.00'  
 E = 0.26'  
 e = NC

- NOTES:**
- FOR LEGENDS, SEE SHEETS 3-4.
  - ALL EXISTING SIGNS NOT SHOWN ON THE PLANS SHALL BE RETAINED.

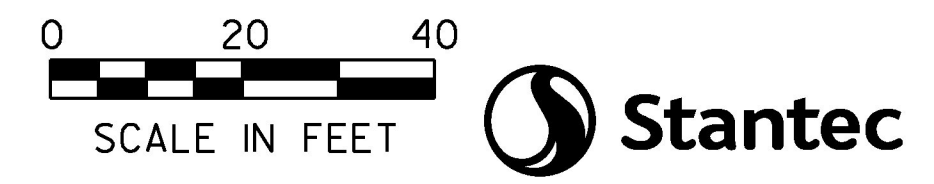

PROJECT NAME:	SOUTH BURLINGTON-WILLISTON
PROJECT NUMBER:	NH 2944(I)
FILE NAME:	zild340bdr.dgn
DESIGNED BY:	D. DRAPER
LAYOUT SHEET 10	
PLOT DATE:	2/15/2017
DRAWN BY:	D. DRAPER
CHECKED BY:	J. LITTLE
SHEET	58 OF 249

