
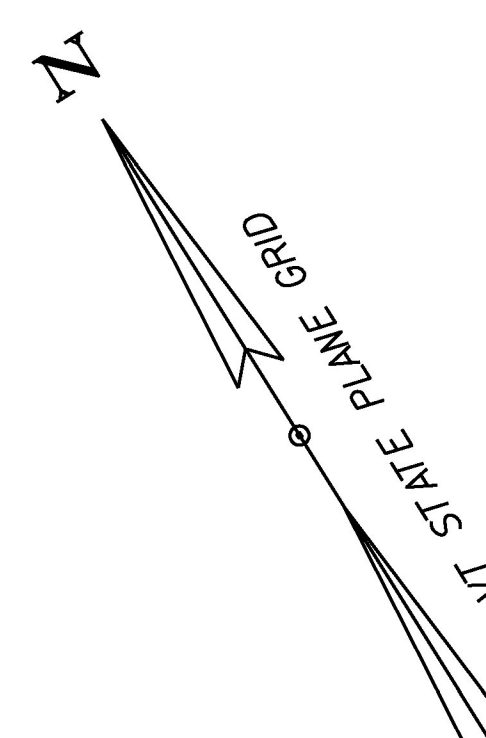


FOR ALL REMAINING DIMENSIONS AND CONSTRUCTION NOTES SEE SHEET 64

REMOVING SIGNS
AS SHOWN - 18

ERECTING SALVAGED SIGNS
AS SHOWN - 1

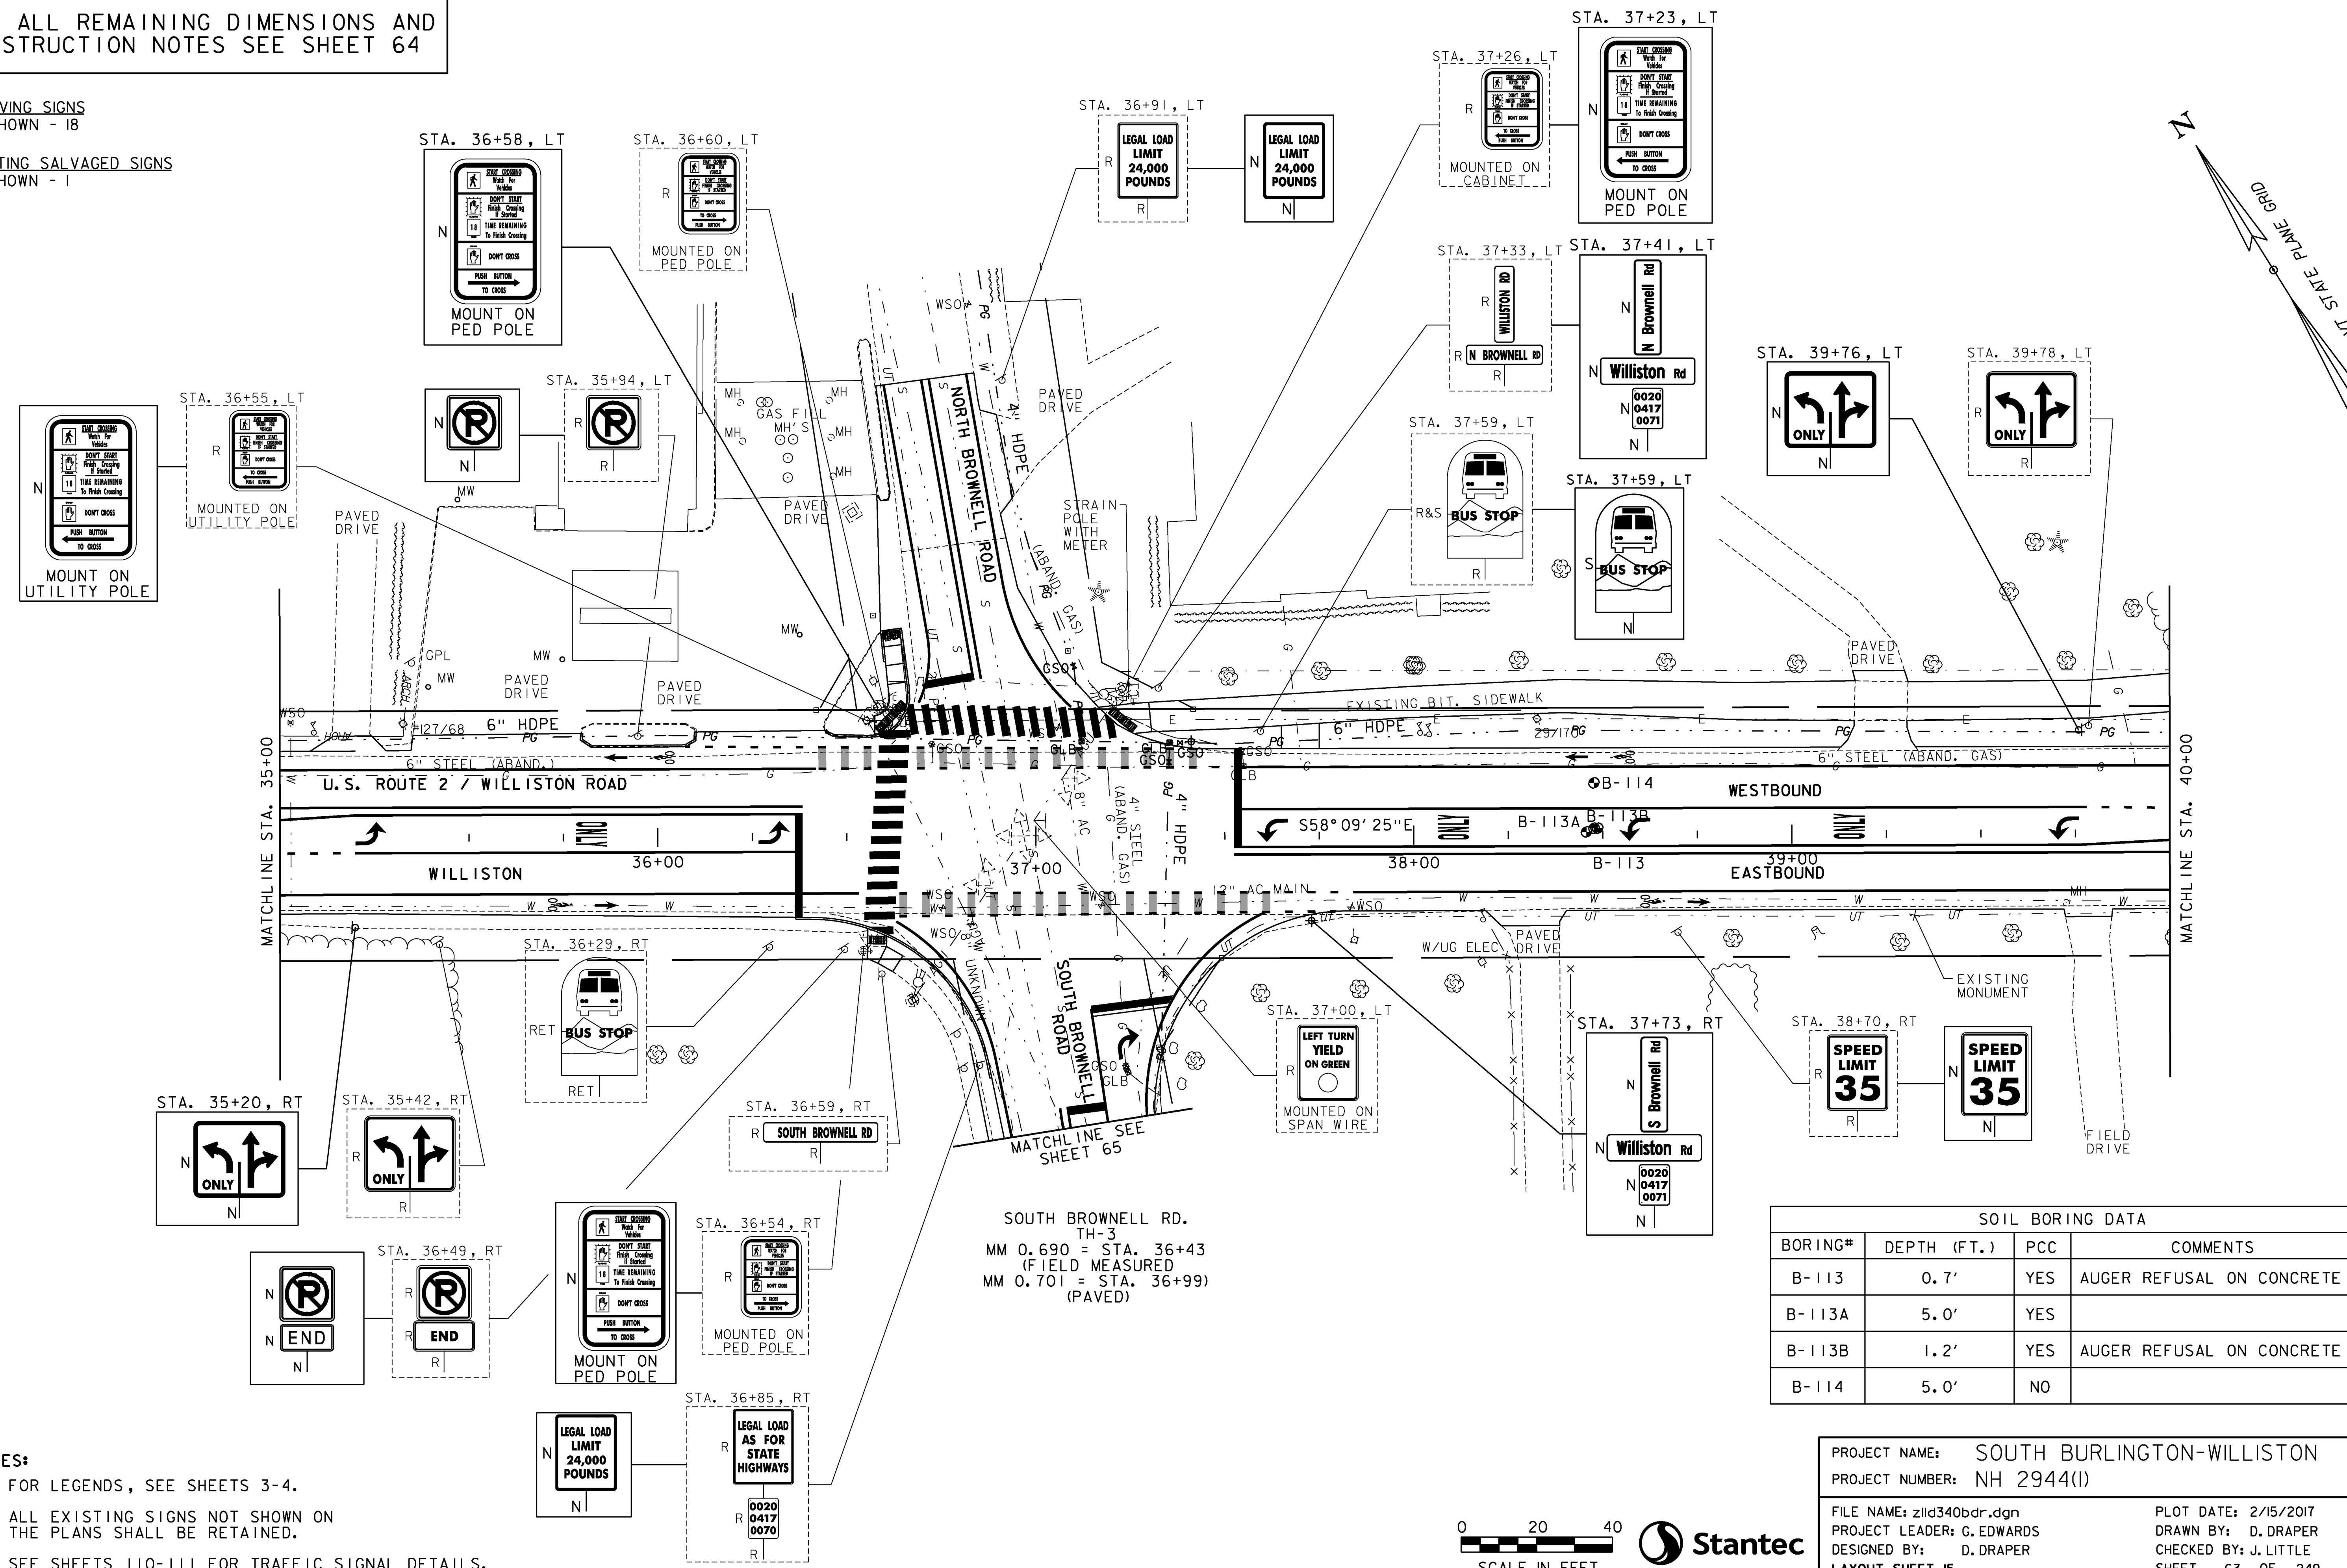

NOTES:

1. FOR LEGENDS, SEE SHEETS 3-4.
2. ALL EXISTING SIGNS NOT SHOWN ON THE PLANS SHALL BE RETAINED.
3. SEE SHEETS 110-111 FOR TRAFFIC SIGNAL DETAILS.

SOIL BORING DATA			
BORING#	DEPTH (FT.)	PCC	COMMENTS
B-113	0.7'	YES	AUGER REFUSAL ON CONCRETE
B-113A	5.0'	YES	
B-113B	1.2'	YES	AUGER REFUSAL ON CONCRETE
B-114	5.0'	NO	

PROJECT NAME: SOUTH BURLINGTON-WILLISTON
 PROJECT NUMBER: NH 2944(I)
 FILE NAME: zlid340bdr.dgn
 PROJECT LEADER: G. EDWARDS
 DESIGNED BY: D. DRAPER
 LAYOUT SHEET 15
 PLOT DATE: 2/15/2017
 DRAWN BY: D. DRAPER
 CHECKED BY: J. LITTLE
 SHEET 63 OF 249

