

THINNING AND TRIMMING FOR SIGNS
 STA. 35+20, RT
 (FOR DETAIL, SEE SHEET 29)

REHAB.
 Dis. CBs OR MHS, CLASS 1 OR II
 SEE SHEET 21

CHANGING ELEVATION OF Dis. CBs OR MHS
 SEE SHEET 21

CAST-IN-PLACE CONCRETE CURB, TYPE B
 STA. 35+79 TO 36+10, LT (ISLAND BY SHELL STATION)
 STA. 36+36 TO 36+87, RT (SOUTH BROWNELL ROAD)
 STA. 36+44 TO 36+67, LT (NORTH BROWNELL ROAD)

REMOVAL OF EXISTING CURB
 STA. 35+79 TO 36+10, LT STA. 36+50 LT
 STA. 36+36 TO 36+87, RT
 STA. 36+44 TO 36+67, LT

RELOCATE MAILBOX, SINGLE SUPPORT
 STA. 35+09, LT
 STA. 38+03, LT (2)
 STA. 38+18, RT

PORTLAND CEMENT CONCRETE SIDEWALK, 5 INCH
 STA. 36+58, RT
 STA. 36+57 TO STA. 36+65, LT 36+62 LT
 STA. 37+22, LT 36+75 RT

BITUMINOUS CONCRETE SIDEWALK
 STA. 37+70, LT 37+27 LT
 SEE SHEET 29 37+59 LT


DETECTABLE WARNING SURFACE
 STA. 36+58, RT
 STA. 36+62, LT
 STA. 36+65, LT
 STA. 37+22, LT

DURABLE & TEMPORARY 4 INCH YELLOW LINE
 (ALL LINES WILL INCLUDE C BREAKS FOR SIDE ROADS)
 STA. 35+00 TO 40+00, DOUBLE SOLID LT & RT
 STA. 36+90, DOUBLE SOLID LT (NORTH BROWNELL RD. TH-8)
 STA. 36+99, DOUBLE SOLID RT (SOUTH BROWNELL RD. TH-3)

DURABLE & TEMPORARY 24 INCH STOP BAR
 STA. 36+37, LT-RT
 STA. 36+90, LT (NORTH BROWNELL RD. TH-8)
 STA. 36+99, RT (2) (SOUTH BROWNELL RD. TH-3)
 STA. 37+53, LT-RT

DURABLE LETTER OR SYMBOL, TYPE D TAPE
 STA. 35+24, CL ARROW
 STA. 35+74, RT BIKE LANE SYMBOL
 STA. 35+83, CL "ONLY"
 STA. 35+86, RT BIKE LANE ARROW
 STA. 35+89, LT BIKE LANE ARROW
 STA. 36+01, LT BIKE LANE SYMBOL
 STA. 36+31, CL ARROW
 STA. 37+25, RT ARROW (SOUTH BROWNELL RD. TH-3)
 STA. 37+63, CL ARROW
 STA. 38+10, CL "ONLY"
 STA. 38+43, LT BIKE LANE ARROW
 STA. 38+55, LT BIKE LANE SYMBOL
 STA. 38+59, CL ARROW
 STA. 38+63, RT BIKE LANE SYMBOL
 STA. 38+75, RT BIKE LANE ARROW
 STA. 39+15, CL "ONLY"
 STA. 39+72, CL ARROW

DURABLE & TEMPORARY CROSSWALK MARKING
 STA. 36+63, LT - RT
 STA. 36+90, LT (NORTH BROWNELL RD. TH-8)
 SEE SHEET 28 (TYPICAL)

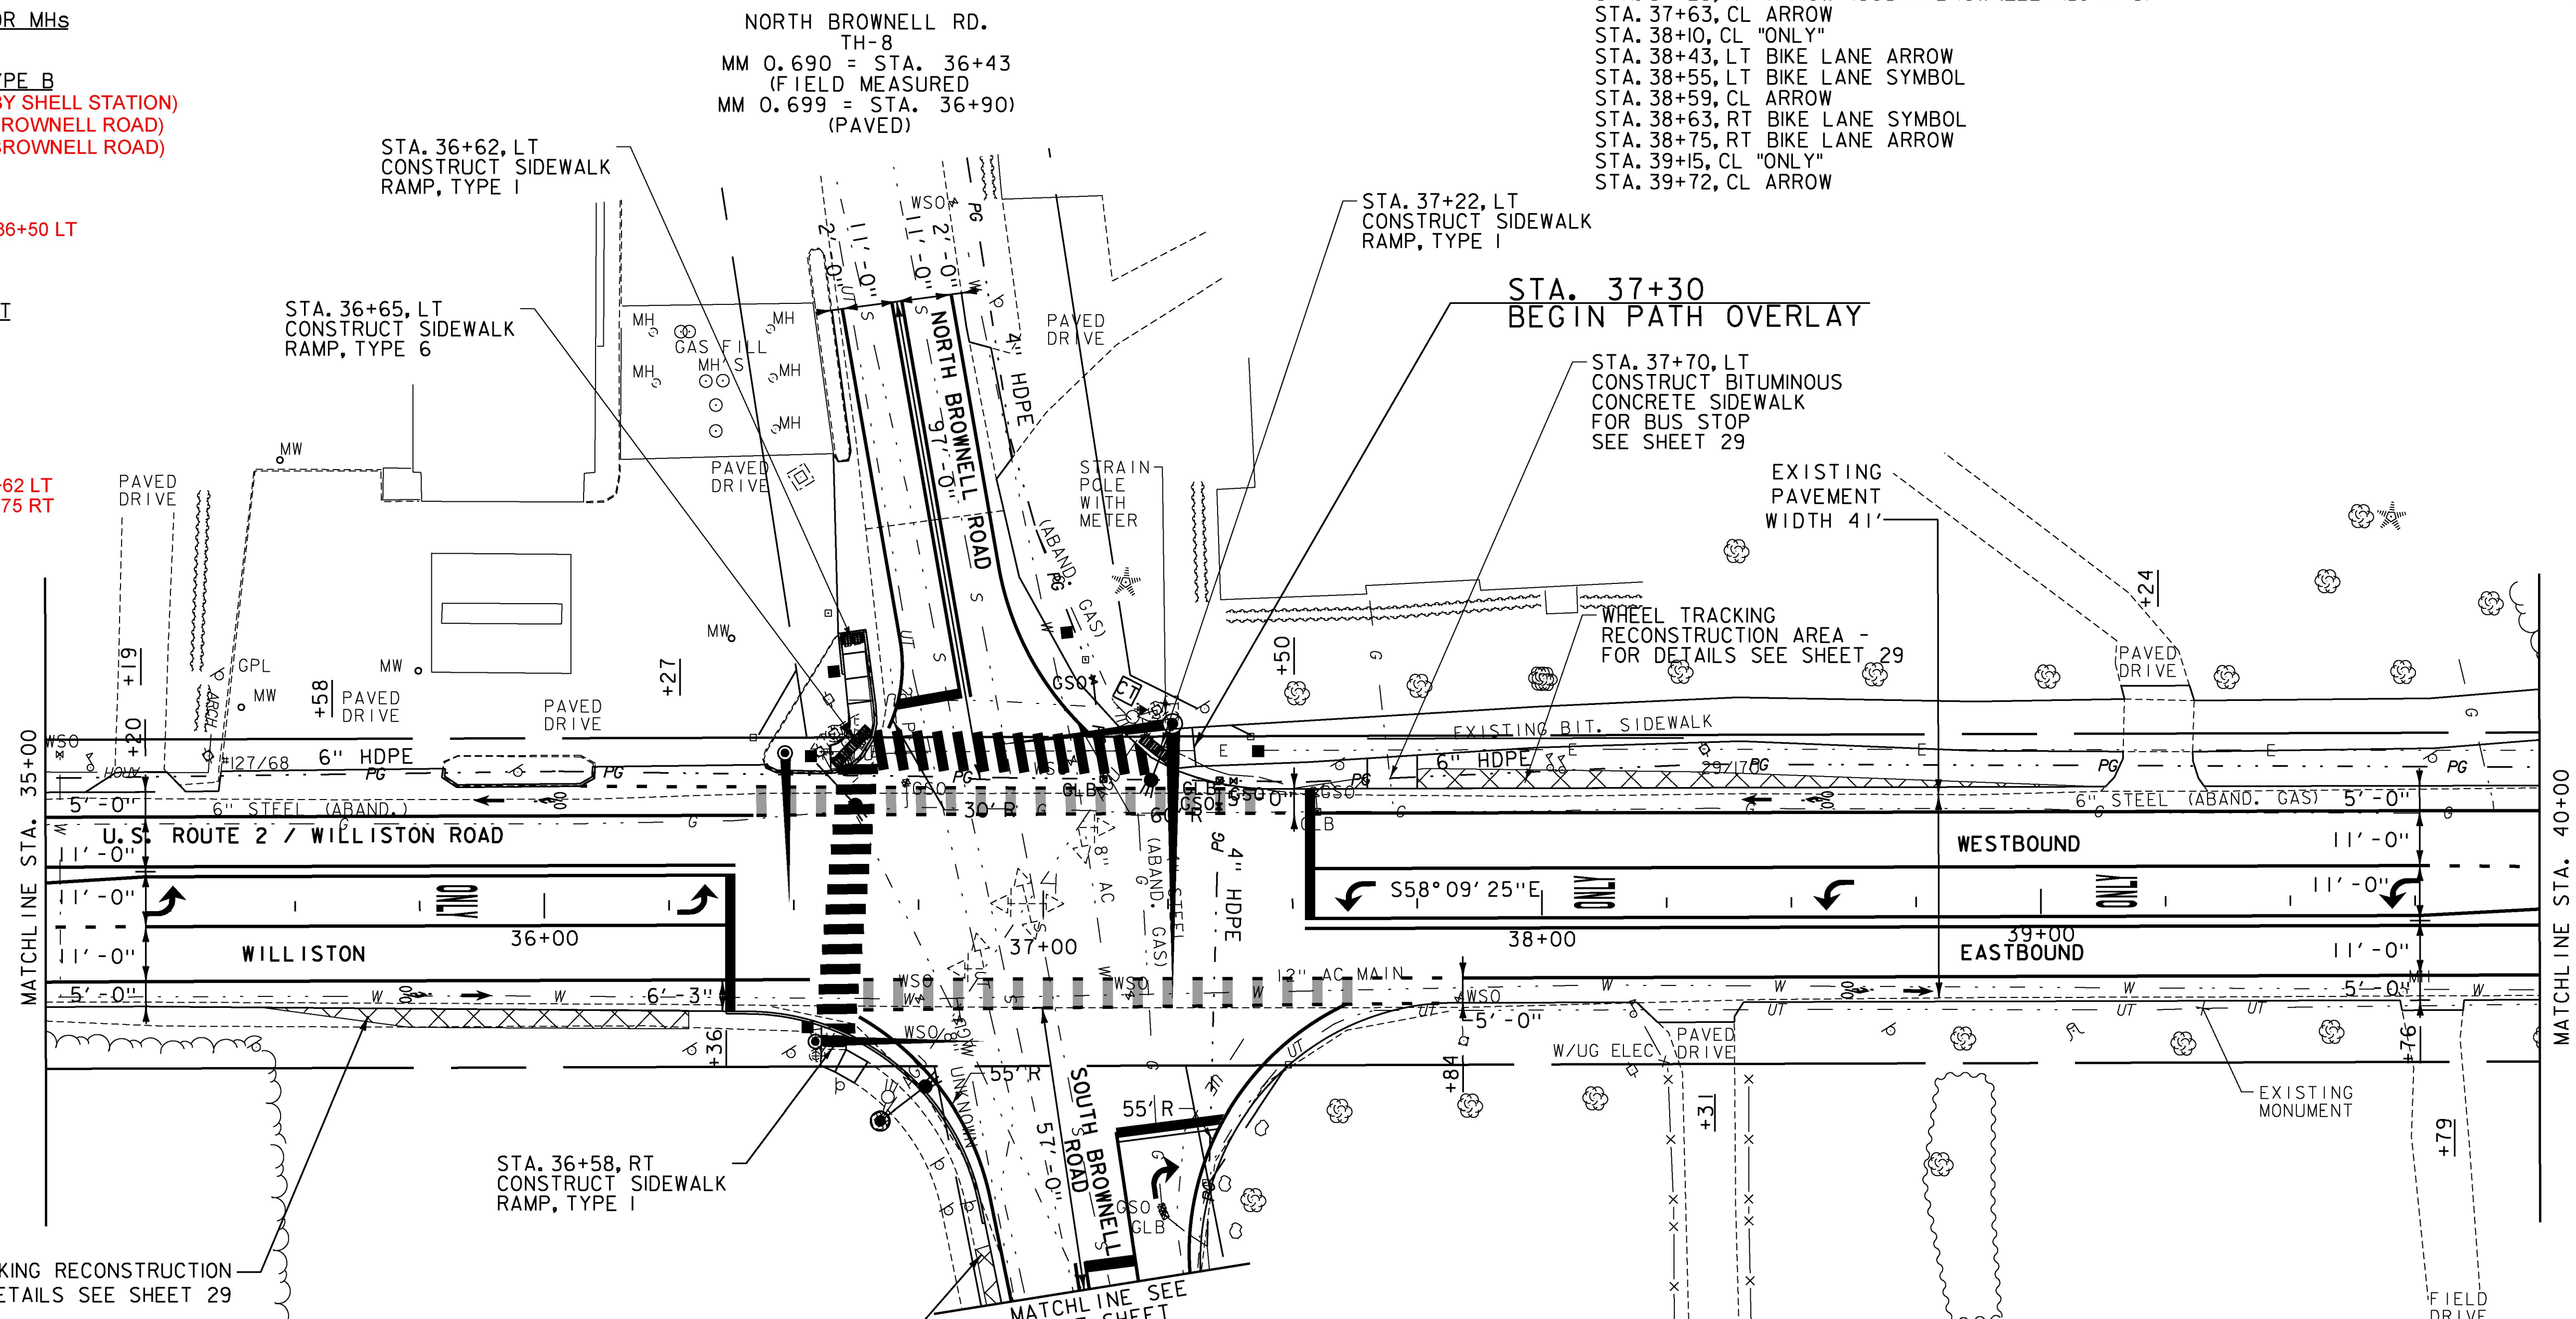

DURABLE & TEMPORARY 4 INCH WHITE LINE
 (ALL LINES WILL INCLUDE EDGE LINE BREAKS AND RADIIFOR SIDE ROADS)
 STA. 35+00 TO 36+42, EDGE LINE LT
 STA. 35+00 TO 36+53, EDGE LINE RT
 STA. 35+00 TO 35+20, DOTTED RT
 STA. 35+20 TO 36+36, SOLID RT (LANE LINE)
 STA. 36+07 TO 37+44, DOTTED LANE LINE LT
 STA. 36+42 TO 37+53, DOTTED LANE LINE LT
 STA. 36+64 TO 37+84, DOTTED LANE LINE RT
 STA. 36+64 TO 37+84, DOTTED LANE LINE RT
 STA. 36+90, SOLID LT (EDGELINES, NORTH BROWNELL RD. TH-8)
 STA. 36+99, SOLID RT (EDGELINES, SOUTH BROWNELL RD. TH-3)
 STA. 36+99, SOLID RT (LANE LINE, SOUTH BROWNELL RD. TH-3)
 STA. 37+53 TO 39+76, SOLID LT (LANE LINE)
 STA. 37+53 TO 40+00, EDGE LINE LT
 STA. 37+84 TO 40+00, EDGE LINE RT
 STA. 39+76 TO 40+00, DOTTED LT

NOTES:
 1. FOR LEGENDS, SEE SHEETS 3-4.
 2. SEE SHEETS 110-111 FOR TRAFFIC SIGNAL DETAILS.

WHEEL TRACKING RECONSTRUCTION AREA - FOR DETAILS SEE SHEET 29

APPROXIMATE ENVIRONMENTALLY SENSITIVE LOCATIONS:


NO.	LIMITS	POS.	TYPE.
1.	STA. 35+00 - 35+33, LT		ARCH

TEMPORARY LETTER OR SYMBOL, PAINT
 STA. 35+24, CL ARROW
 STA. 35+74, RT BIKE LANE SYMBOL
 STA. 35+86, RT BIKE LANE ARROW
 STA. 35+89, LT BIKE LANE ARROW
 STA. 36+01, LT BIKE LANE SYMBOL
 STA. 36+31, CL ARROW
 STA. 37+25, RT ARROW (SOUTH BROWNELL RD. TH-3)
 STA. 37+63, CL ARROW
 STA. 38+43, LT BIKE LANE ARROW
 STA. 38+55, LT BIKE LANE SYMBOL
 STA. 38+59, CL ARROW
 STA. 38+63, RT BIKE LANE SYMBOL
 STA. 38+75, RT BIKE LANE ARROW
 STA. 39+72, CL ARROW

SPECIAL PROVISION (GREEN PAVEMENT MARKINGS - BICYCLE LANE)
 STA. 36+42 TO 37+43, BIKE LANE LT
 STA. 36+64 TO 37+62, BIKE LANE RT
 SEE SHEET 27

SPECIAL PROVISION (BITUMINOUS CONCRETE PAVEMENT, SMALL QUANTITY)
 STA. 37+30 TO 40+00, LT (PATH)

SPECIAL PROVISION (ADJUST ELEVATION OF VALVE BOX)
 SEE SHEET 21

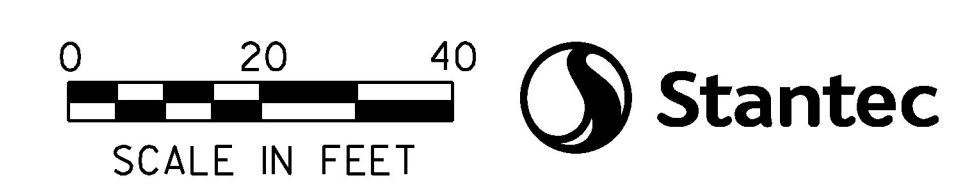

PROJECT NAME: SOUTH BURLINGTON-WILLISTON	PLOT DATE: 2/15/2017
PROJECT NUMBER: NH 2944(I)	DRAWN BY: D. DRAPER
FILE NAME: zild340bdr.dgn	DESIGNED BY: D. DRAPER
LAYOUT SHEET 15A	CHECKED BY: J. LITTLE
	SHEET 64 OF 249