

REHAB.
Dis, CBs OR MHS, CLASS I OR II
SEE SHEET 21

CHANGING ELEVATION OF Dis, CBs OR MHS
SEE SHEET 21

REMOVAL OF EXISTING CURB
STA. 46+98 TO 47+23, RT

CAST-IN-PLACE CONCRETE CURB, TYPE B
STA. 46+98 TO 47+23, RT (COMMERCE STREET)

RELOCATE MAILBOX, SINGLE SUPPORT
STA. 46+49, LT (4)
STA. 47+78, LT
STA. 48+34, LT

ADJUST ELEVATION OF VALVE BOX
SEE SHEET 21

DURABLE & TEMPORARY 4 INCH WHITE LINE
STA. 45+00 TO 49+00, EDGE LINE LT
STA. 45+00 TO 46+40, EDGE LINE RT
STA. 46+40 TO 47+27, DOTTED LANE LINE RT
STA. 46+40 TO 47+27, DOTTED LANE LINE RT
STA. 47+27 TO 49+00, EDGE LINE RT

DURABLE & TEMPORARY 4 INCH YELLOW LINE
(ALL LINES WILL INCLUDE $\frac{1}{2}$ BREAKS FOR SIDE ROADS)
STA. 45+00 TO 49+00, SOLID LT & RT
STA. 46+76, DOUBLE SOLID RT (COMMERCE ST. TH-I9)

DURABLE & TEMPORARY 24 INCH STOP BAR
STA. 46+76, RT (COMMERCE ST. TH-I9)

DURABLE & TEMPORARY LETTER OR SYMBOL
STA. 46+09, RT BIKE LANE SYMBOL
STA. 46+20, RT BIKE LANE ARROW
STA. 46+76, RT "STOP" (COMMERCE ST. TH-I9)
STA. 47+95, RT BIKE LANE SYMBOL
STA. 48+07, RT BIKE LANE ARROW




REMOVING SIGNS
AS SHOWN - 5

SPECIAL PROVISION (GREEN PAVEMENT MARKINGS - BICYCLE LANE)
STA. 46+40 TO 47+27, BIKE LANE RT
SEE SHEET 27


SPECIAL PROVISION (ADJUST ELEVATION OF VALVE BOX)
SEE SHEET 21

SPECIAL PROVISION (BITUMINOUS CONCRETE PAVEMENT, SMALL QUANTITY)
STA. 45+00 TO 49+00, LT (PATH)

DELINEATOR WITH STEEL POST
47+00 47+75 LT

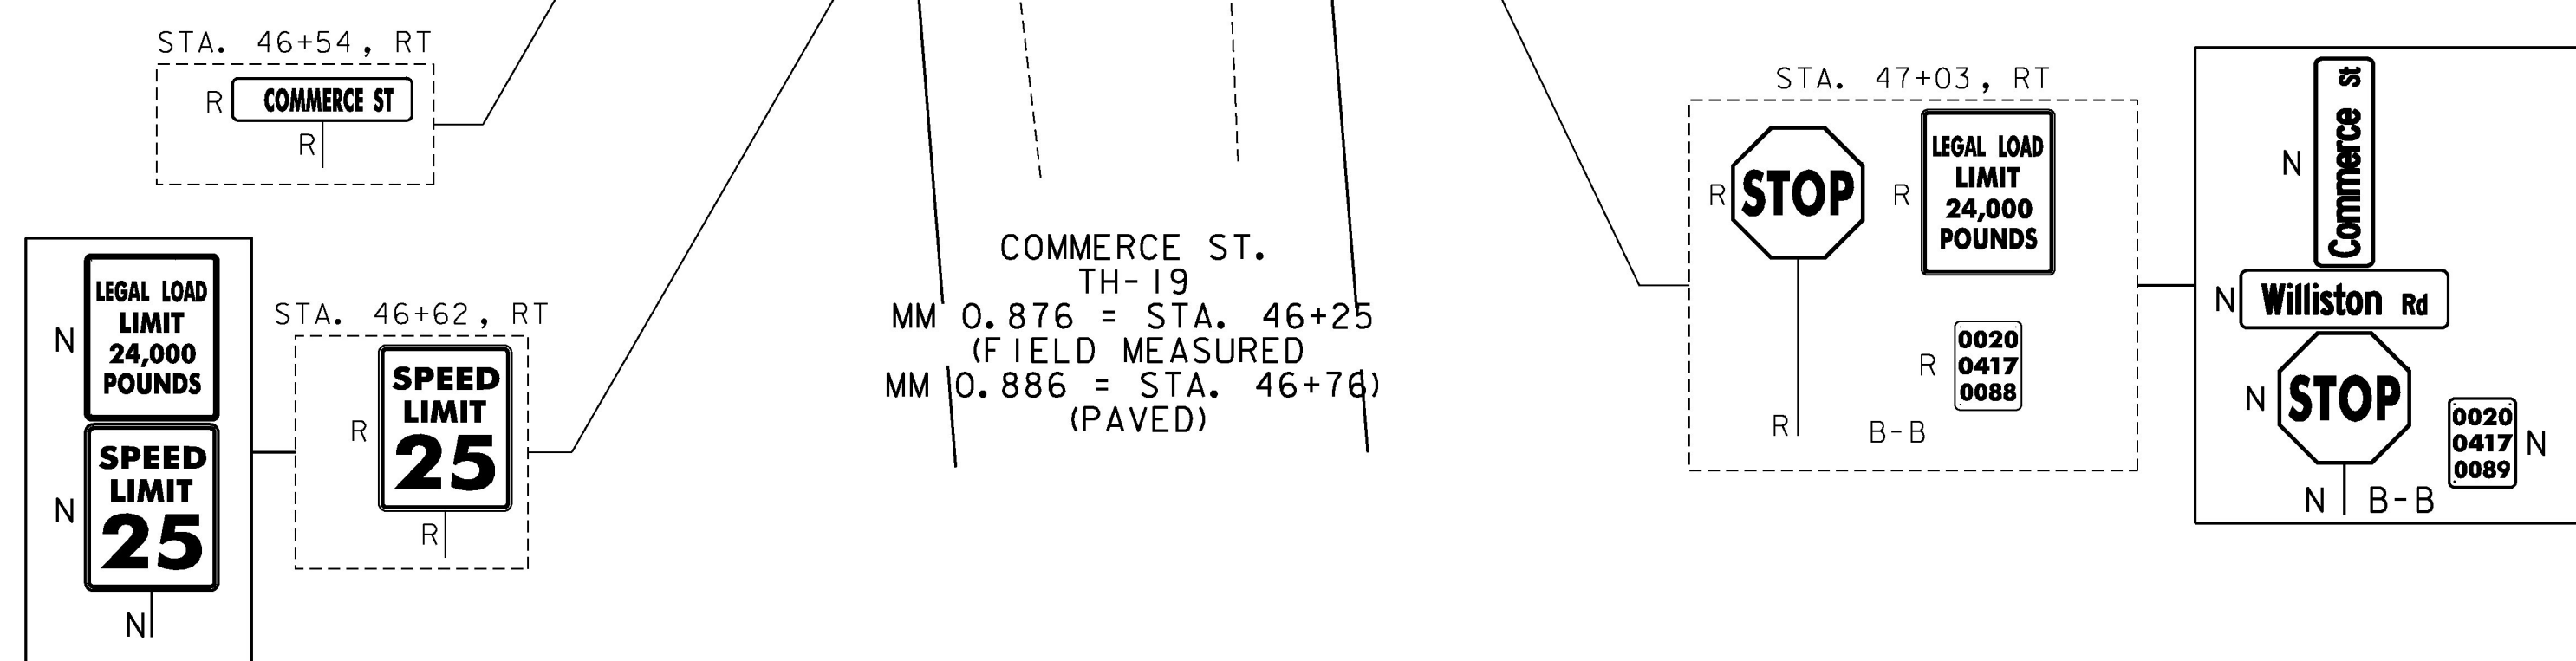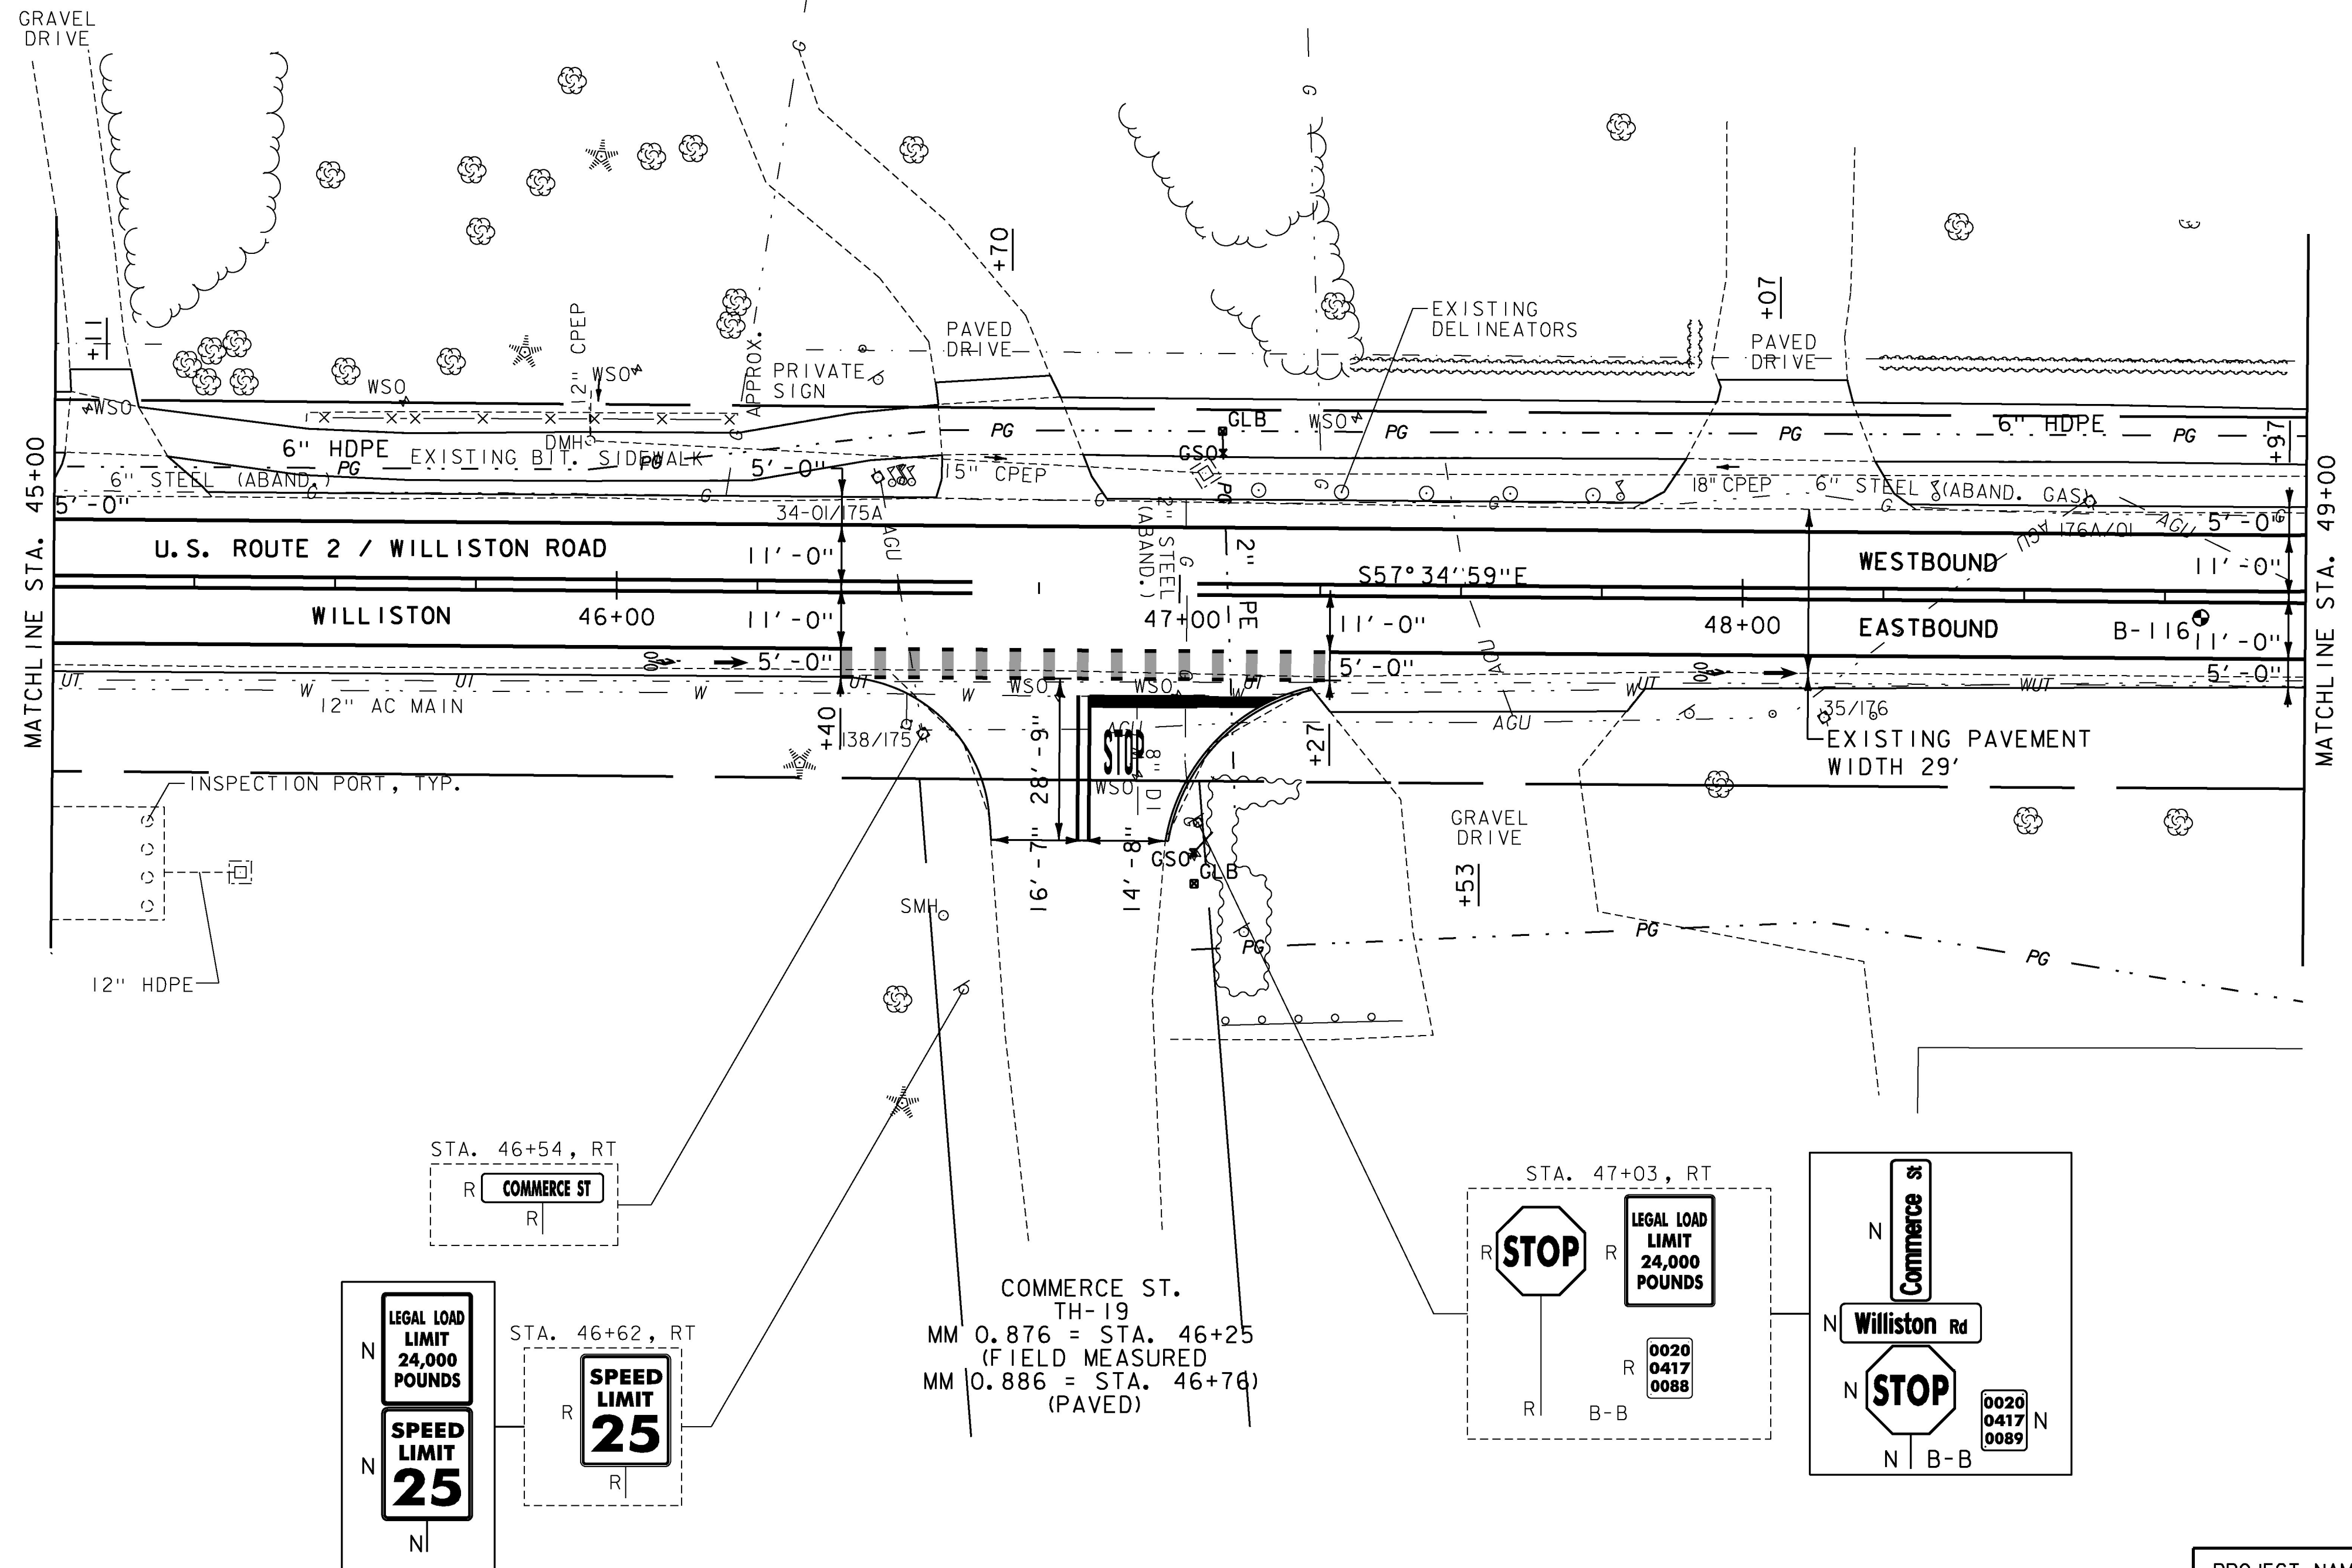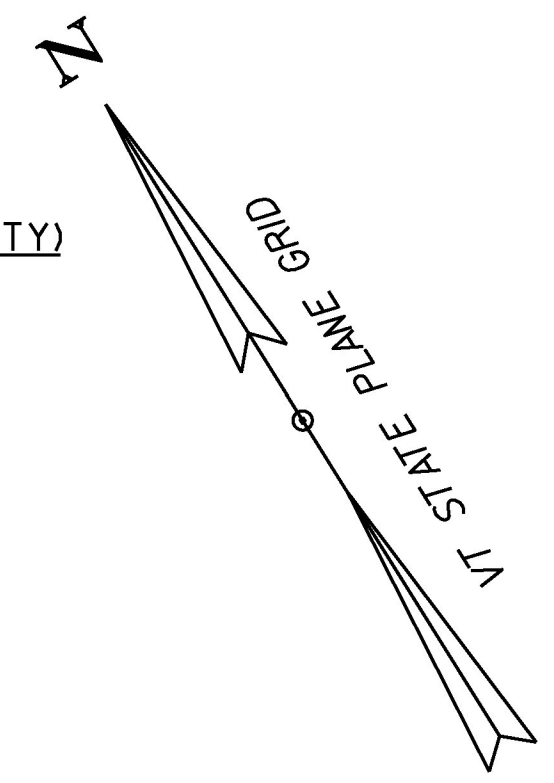

SOIL BORING DATA			
BORING#	DEPTH (FT.)	PCC	COMMENTS
B-116	5.0'	YES	

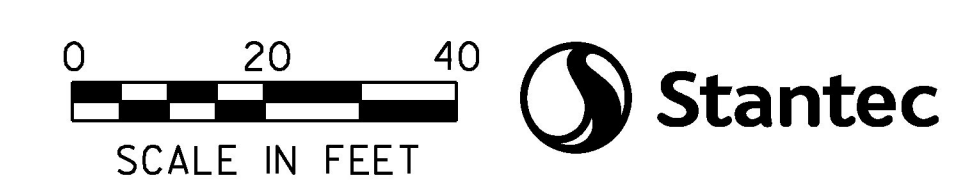

- NOTES:
- FOR LEGENDS, SEE SHEETS 3-4.
 - ALL EXISTING SIGNS NOT SHOWN ON THE PLANS SHALL BE RETAINED.

PROJECT NAME: SOUTH BURLINGTON-WILLISTON
PROJECT NUMBER: NH 2944(I)
FILE NAME: zild340bdr.dgn
PROJECT LEADER: G. EDWARDS
DESIGNED BY: D. DRAPER
LAYOUT SHEET 17
PLOT DATE: 2/15/2017
DRAWN BY: D. DRAPER
CHECKED BY: J. LITTLE
SHEET 67 OF 249