

CHANGING ELEVATION OF Dis, CBs OR MHS
SEE SHEET 21

REHAB.
Dis, CBs OR MHS, CLASS I, II OR III
SEE SHEET 21

CHANGING ELEVATION OF SEWER MANHOLES
SEE SHEET 21

CAST-IN-PLACE CONCRETE CURB, TYPE B
STA. 54+36 TO 54+75, LT (BLAIR PARK)
STA. 55+04, RT (HARVEST LN. TH-16)
(SEE NEXT SHEET FOR INSTRUCTIONS)
STA. 55+30 TO 55+64, LT (BLAIR PARK)
STA. 54+30 TO 54+65 RT (HARVEST LANE)

REMOVAL OF EXISTING CURB
STA. 54+36 TO 54+75, LT
STA. 55+04, RT (HARVEST LN. TH-16 LT & RT)
(SEE NEXT SHEET FOR INSTRUCTIONS)
STA. 55+30 TO 55+64, LT
STA. 55+65 TO 55+75 RT 54+04 TO 54+80 RT
PORTLAND CEMENT 55+30 TO 55+75 RT
CONCRETE SIDEWALK, 5 INCH
STA. 54+77, LT
STA. 55+29, LT
STA. 55+65, RT
STA. 55+66, LT

DETECTABLE WARNING SURFACE
STA. 54+77, LT
STA. 55+29, LT
STA. 55+65, RT
STA. 55+66, LT

CURVE 14 DATA
PC = STA 51+91.40
PT = STA 52+71.71
 $\Delta = 0^{\circ}27'36.49''$ LT
 $D = 0^{\circ}34'22.65''$
 $R = 10000.00'$
 $T = 40.15'$
 $L = 80.31'$
 $E = 0.08'$
 $e = NC$

DURABLE & TEMPORARY 4 INCH YELLOW LINE
(ALL LINES WILL INCLUDE $\frac{1}{2}$ BREAKS FOR SIDE ROADS)
STA. 53+00, TO 54+57, DOUBLE SOLID LT
STA. 55+74, TO 57+00, DOUBLE SOLID RT
STA. 55+04, DOUBLE SOLID RT (HARVEST LN. TH-16)
STA. 55+06, DOUBLE SOLID LT (BLAIR PARK RD. TH-62)

DURABLE & TEMPORARY 24 INCH STOP BAR
STA. 54+44, LT-RT
STA. 55+04, RT (HARVEST LN. TH-16)
STA. 55+06, LT (BLAIR PARK RD. TH-62)
STA. 55+75, LT

DURABLE LETTER OR SYMBOL, TYPE D TAPE
STA. 53+20, LT & RT "ONLY" (8)
STA. 53+65, LT & RT ARROW (3)
STA. 53+93, LT BIKE LANE ARROW
STA. 54+00, LT & RT "ONLY" (8)
STA. 54+05, LT BIKE LANE SYMBOL
STA. 54+34, LT & RT ARROW (3)
STA. 55+04, RT ARROW (3) (HARVEST LN. TH-16)
STA. 55+06, LT ARROW (3) (BLAIR PARK RD. TH-62)
STA. 55+85, LT ARROW (3)
STA. 55+93, LT BIKE LANE ARROW
STA. 55+95, RT BIKE LANE SYMBOL
STA. 56+05, LT BIKE LANE SYMBOL
STA. 56+07, RT BIKE LANE ARROW
STA. 56+46, LT "ONLY"
STA. 56+46, LT ARROW (2)

STA. 55+35
RESUME PATH OVERLAY

DURABLE LETTER OR SYMBOL, (OPTION ITEMS)
STA. 54+23, RT BIKE LANE SYMBOL
STA. 54+35, RT BIKE LANE ARROW
SEE NOTE 35 ON SHEET II

DURABLE & TEMPORARY CROSSWALK MARKING
STA. 55+06, LT (BLAIR PARK RD. TH-62)
STA. 55+65, RT TO 55+66, LT
SEE SHEET 28 (TYPICAL)

TEMPORARY LETTER OR SYMBOL, PAINT
STA. 53+65, LT & RT ARROW (3)
STA. 53+93, LT BIKE LANE ARROW
STA. 54+05, LT BIKE LANE SYMBOL
STA. 54+23, RT BIKE LANE SYMBOL
STA. 54+34, LT & RT ARROW (3)
STA. 54+35, RT BIKE LANE ARROW
STA. 55+04, RT ARROW (3) (HARVEST LN. TH-16)
STA. 55+06, LT ARROW (3) (BLAIR PARK RD. TH-62)
STA. 55+85, LT ARROW (3)
STA. 55+93, LT BIKE LANE ARROW
STA. 55+95, RT BIKE LANE SYMBOL
STA. 56+05, LT BIKE LANE SYMBOL
STA. 56+07, RT BIKE LANE ARROW
STA. 56+46, LT ARROW (2)

ERECTING SALVAGED SIGNS
AS SHOWN - 1

SPECIAL PROVISION (ADJUST
ELEVATION OF VALVE BOX)
SEE SHEET 21

SPECIAL PROVISION (GREEN PAVEMENT
MARKINGS - BICYCLE LANE)
STA. 53+00, TO 55+77, BIKE LANE RT
STA. 54+27 TO 55+62, BIKE LANE LT
SEE SHEET 27

SPECIAL PROVISION (BITUMINOUS
CONCRETE PAVEMENT, SMALL QUANTITY)
STA. 53+00 TO 54+72, LT (PATH)
STA. 55+35 TO 57+00, LT (PATH)



SPECIAL PROVISION
(REPLACEMENT OF VALVE BOX)
SEE SHEET 22

DURABLE & TEMPORARY 4 INCH WHITE LINE
(ALL LINES WILL INCLUDE EDGE LINE BREAKS
AND RADII FOR SIDE ROADS)
STA. 53+00 TO 54+43, SOLID RT (LANE LINE)
STA. 53+00 TO 54+43, SOLID LANE LINES RT (2)
STA. 53+00 TO 54+27, EDGE LINE LT
STA. 53+84 TO 55+62, DOTTED LANE LINE LT
STA. 54+27 TO 55+62, DOTTED LANE LINE LT
STA. 54+45 TO 55+61, DOTTED LANE LINES RT (2)
STA. 55+04, SOLID RT (EDGELINES & LANE LINE, HARVEST LN. TH-16)
STA. 55+06, SOLID LT (EDGELINES & LANE LINE, BLAIR PARK RD. TH-62)
STA. 55+70 TO 55+80, DOTTED LANE LINE RT (2)
STA. 55+76 TO 57+00, SOLID LT (LANE LINE)
STA. 55+76 TO 57+00, BIKE LANE LINE LT
STA. 55+76 TO 57+00, HATCH BUFFER LT
STA. 55+76 TO 57+00, EDGE LINE LT
STA. 55+80 TO 57+00, EDGE LINE RT

NOTES:

- FOR LEGENDS, SEE SHEETS 3-4.
- SEE SHEETS 112-113 FOR TRAFFIC SIGNAL DETAILS.

UD-24
STA. 55+38 TO 56+50 RT
CONSTRUCT 6 INCH UNDERDRAIN PIPE
SEE SHEET 20 FOR DETAILS & ASSOCIATED QUANTITIES

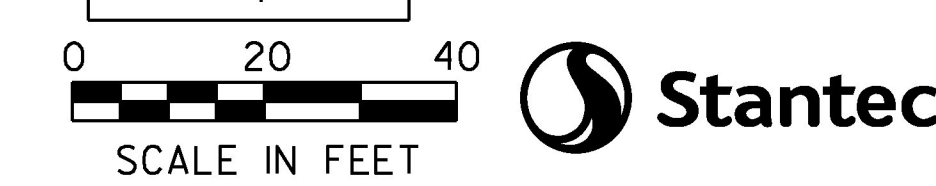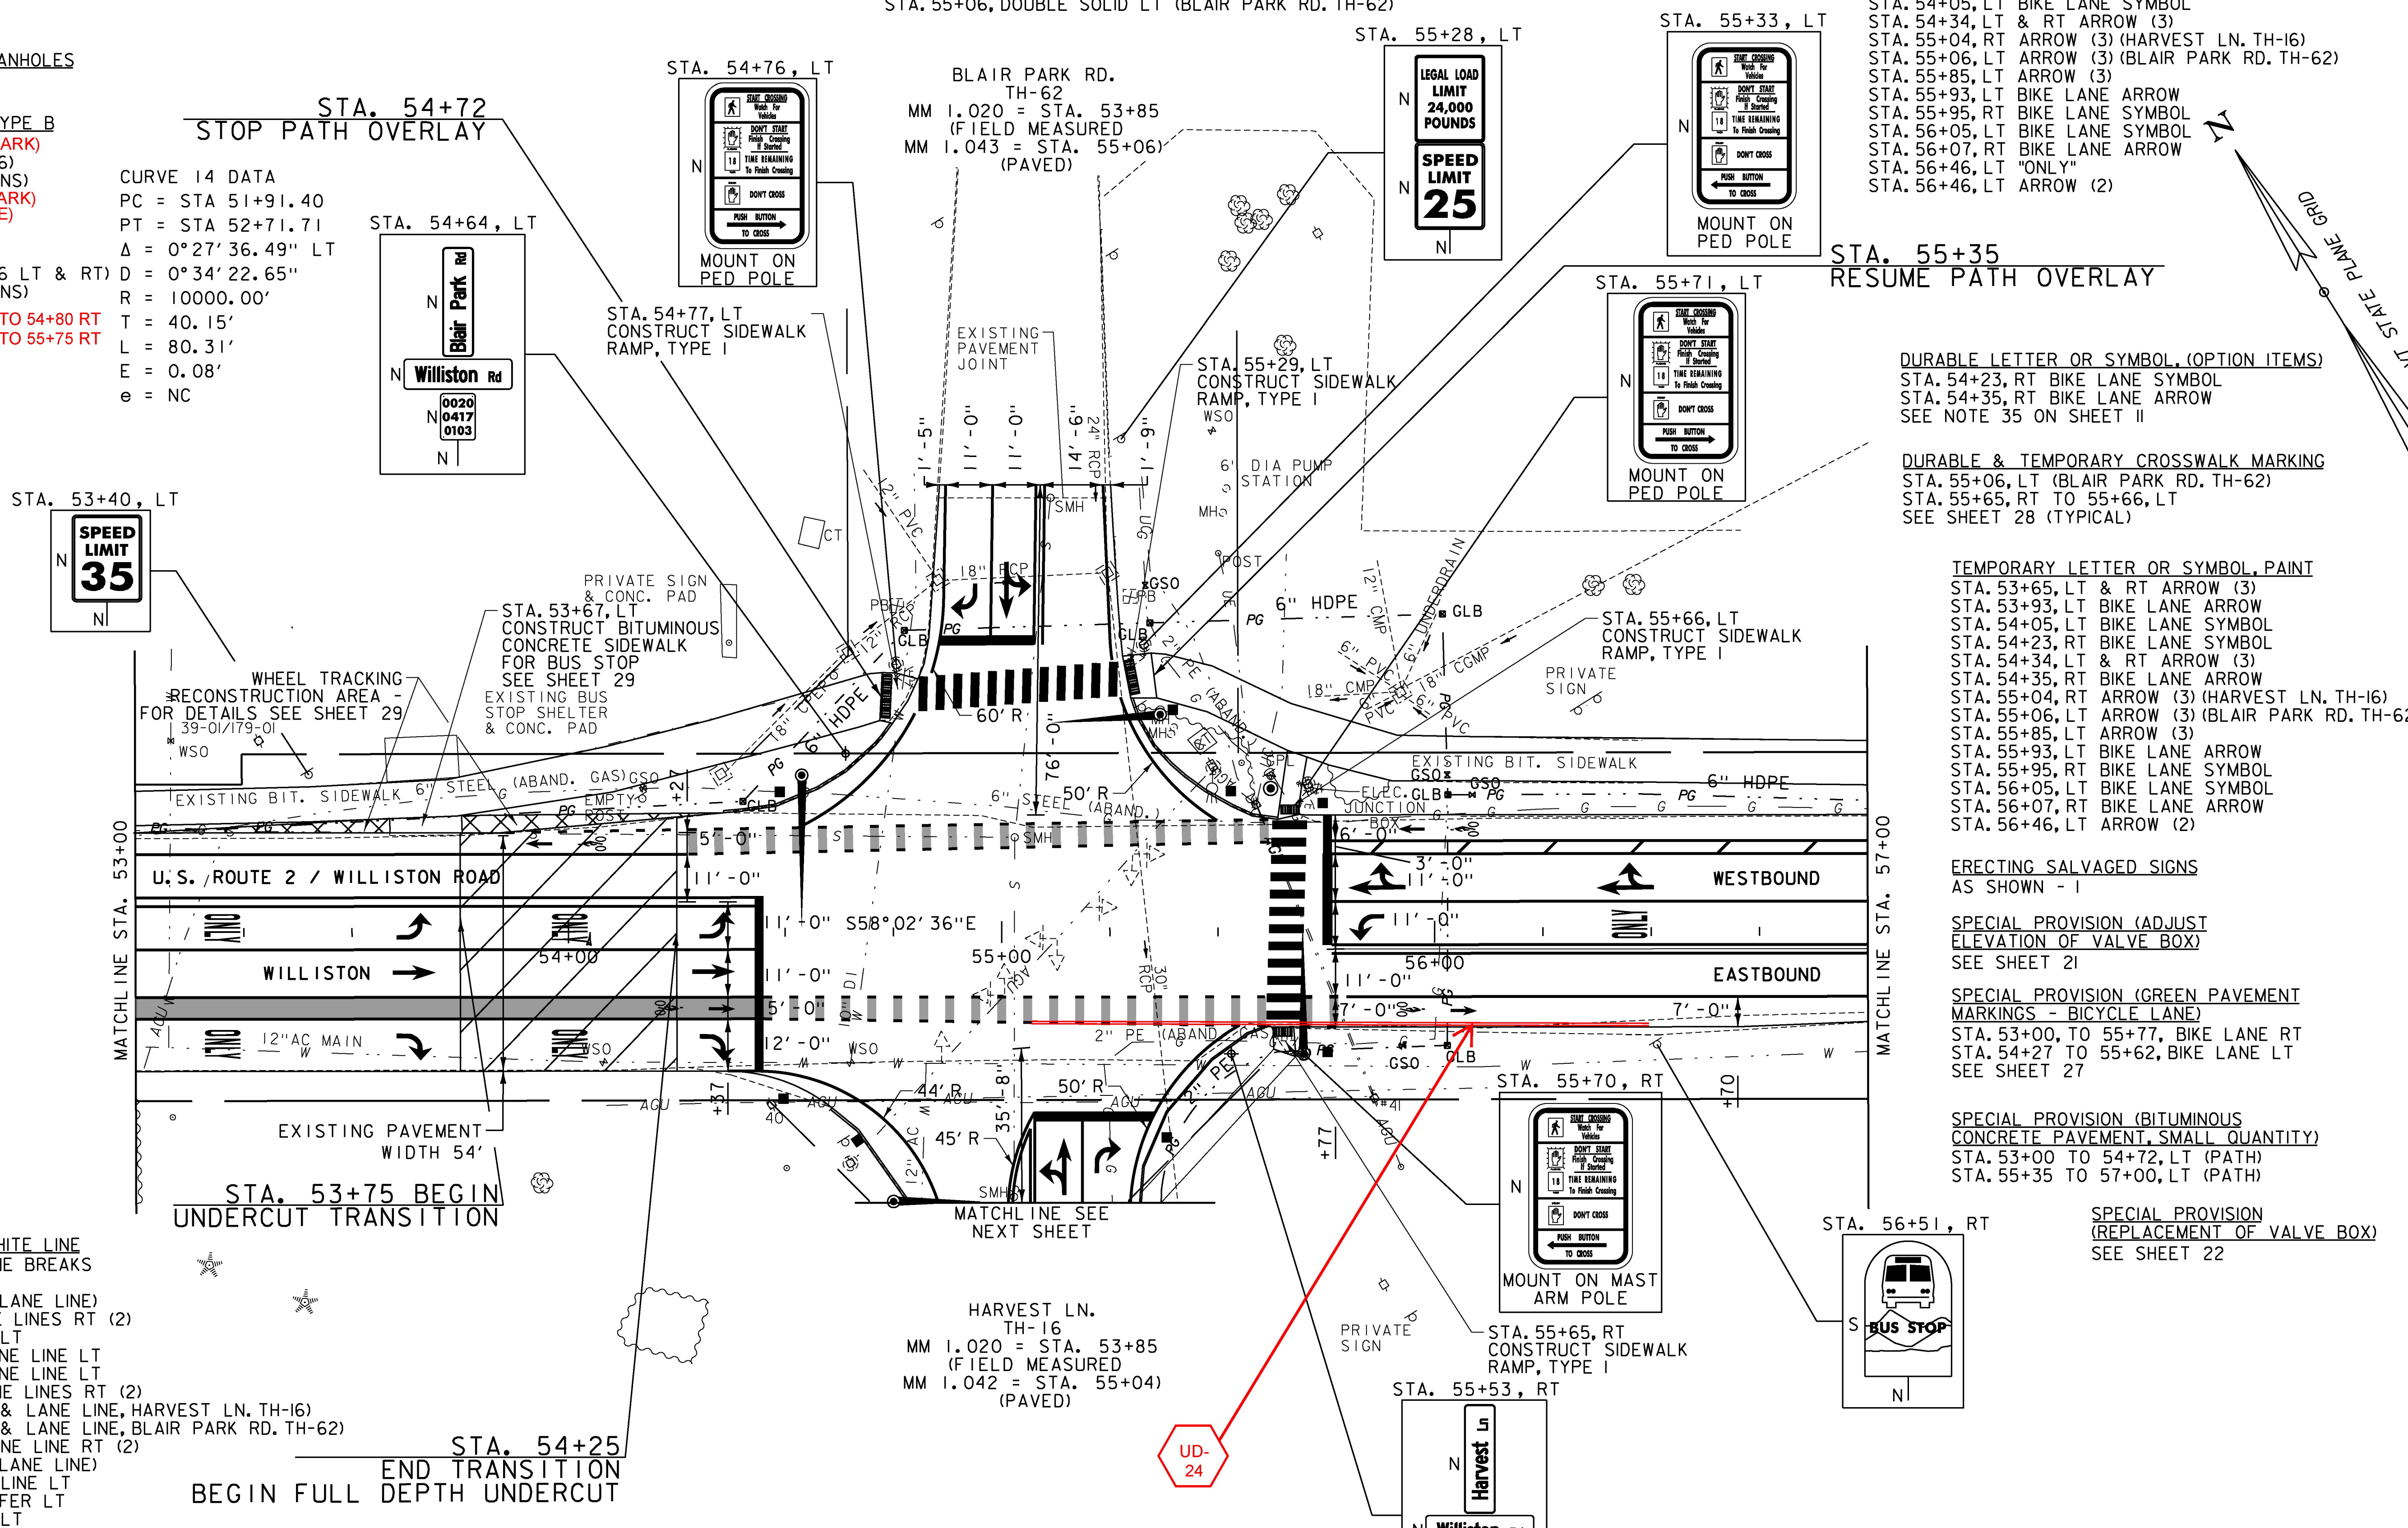

| | |
|------------------|----------------------------|
| PROJECT NAME: | SOUTH BURLINGTON-WILLISTON |
| PROJECT NUMBER: | NH 2944(I) |
| FILE NAME: | zild340bdr.dgn |
| DESIGNED BY: | D. DRAPER |
| CHECKED BY: | J. LITTLE |
| LAYOUT SHEET 19A | |
| PLOT DATE: | 2/15/2017 |
| DRAWN BY: | D. DRAPER |
| CHECKED BY: | J. LITTLE |
| SHEET | 70 OF 249 |