

CAST-IN-PLACE CONCRETE CURB, TYPE B
 STA. 55+04, RT (HARVEST LN. TH-16 LT & RT)
REMOVAL OF EXISTING CURB
 STA. 55+04, RT (HARVEST LN. TH-16 LT & RT)


DURABLE & TEMPORARY 4 INCH WHITE LINE
 (ALL LINES WILL INCLUDE EDGE LINE BREAKS AND RADII FOR SIDE ROADS)
 STA. 55+04, SOLID RT (EDGELINES, HARVEST LN. TH-16)
 STA. 55+04, SOLID RT (LANE LINE, HARVEST LN. TH-16)
 STA. 55+04, DOTTED RT (HARVEST LN. TH-16)

DURABLE & TEMPORARY 4 INCH YELLOW LINE
 (ALL LINES WILL INCLUDE \oslash BREAKS FOR SIDE ROADS)
 STA. 55+04, SOLID RT (HARVEST LN. TH-16)

DURABLE & TEMPORARY LETTER OR SYMBOL
 STA. 55+04, RT ARROW (3) (HARVEST LN. TH-16)


REMOVING SIGNS
 AS SHOWN - 4

CAST-IN-PLACE CONCRETE CURB, TYPE B
 STA 55+04 TO 55+04 RT (HARVEST LN.)
 STA 55+04 TO 55+80 RT (HARVEST LN.)

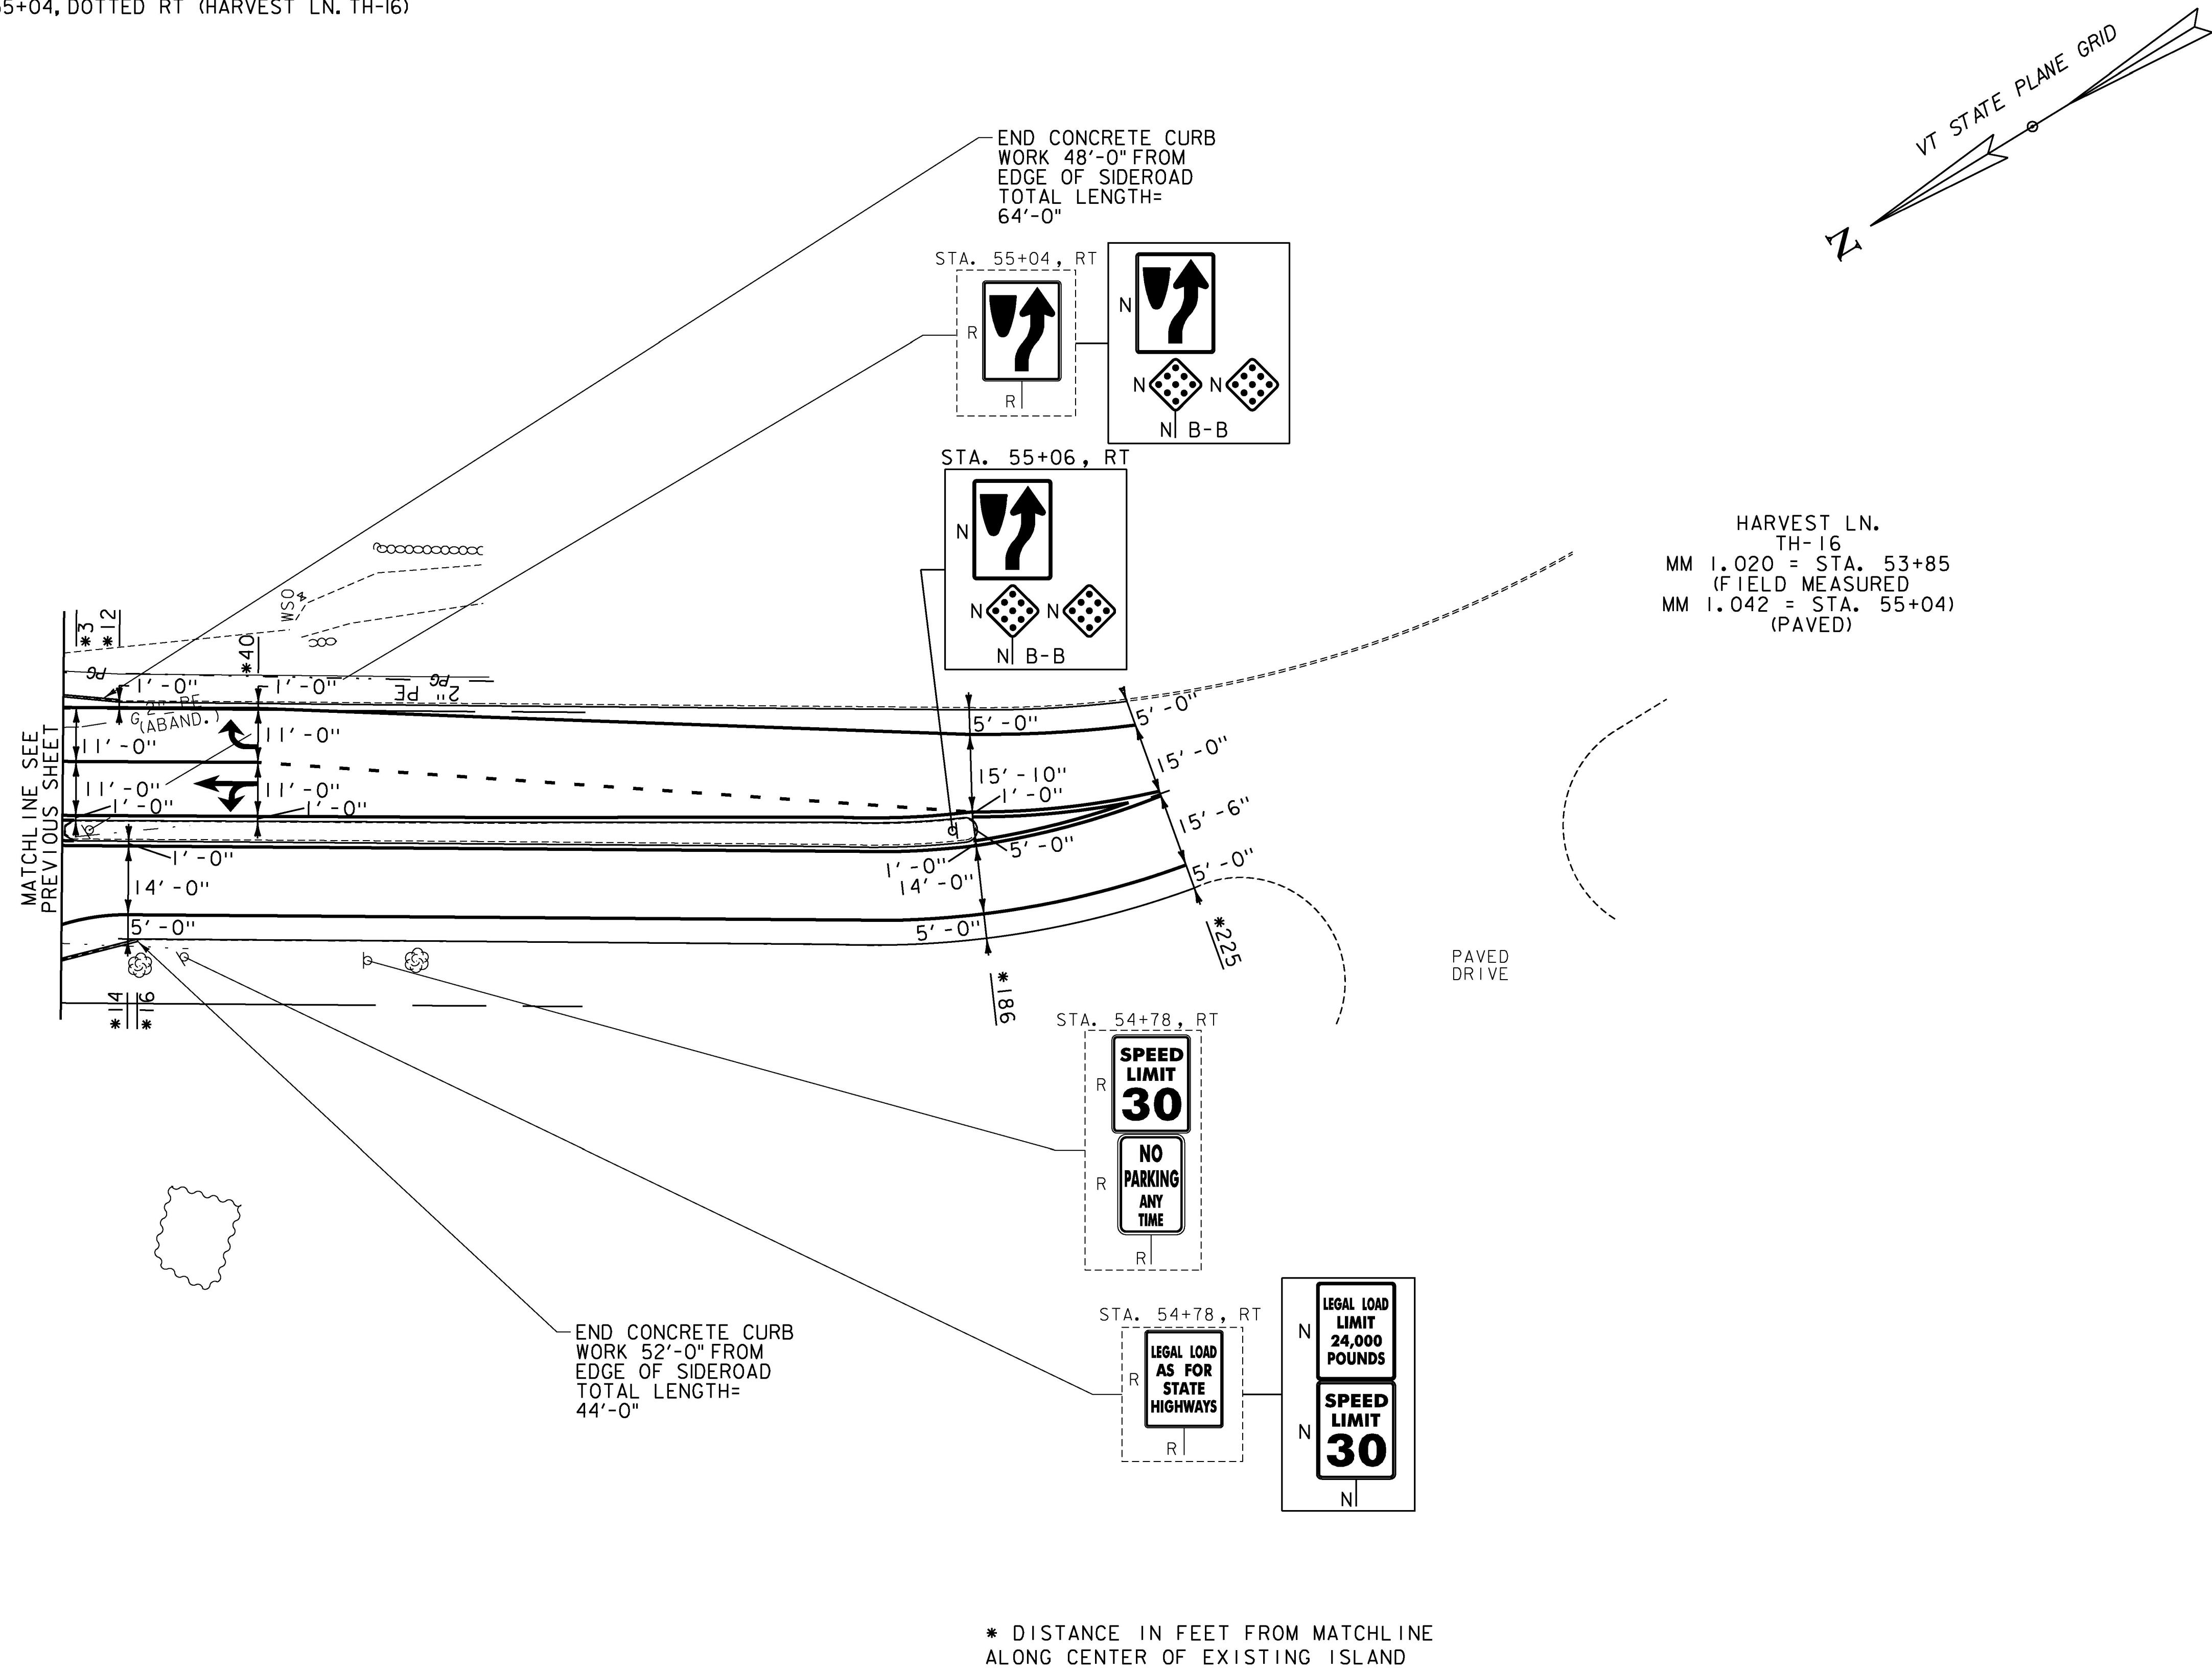

HARVEST LN.
 TH-16
 MM 1.020 = STA. 53+85
 (FIELD MEASURED)
 MM 1.042 = STA. 55+04
 (PAVED)

- NOTES:**
- FOR LEGENDS, SEE SHEETS 3-4.
 - ALL EXISTING SIGNS NOT SHOWN ON THE PLANS SHALL BE RETAINED.

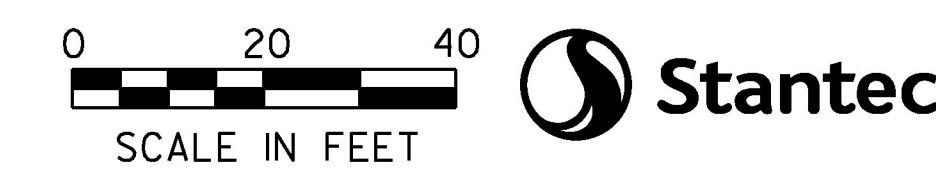

PROJECT NAME:	SOUTH BURLINGTON-WILLISTON
PROJECT NUMBER:	NH 2944(I)
FILE NAME:	zlld340bdr.dgn
PROJECT LEADER:	G. EDWARDS
DESIGNED BY:	D. DRAPER
LAYOUT SHEET	19B
PLOT DATE:	2/15/2017
DRAWN BY:	D. DRAPER
CHECKED BY:	J. LITTLE
SHEET	71 OF 249