

CHANGING ELEVATION OF DIS, CBS OR MHS
SEE SHEET 21
RELOCATE MAILBOX, SINGLE SUPPORT
STA. 65+30, LT


DURABLE & TEMPORARY 4 INCH WHITE LINE
(ALL LINES WILL INCLUDE EDGE LINE BREAKS
AND RADII FOR SIDE ROADS)
STA. 62+00 TO 67+00, EDGE LINE LT & RT
STA. 65+60 TO 67+00, DOTTED CL

DURABLE & TEMPORARY 4 INCH YELLOW LINE
(ALL LINES WILL INCLUDE C BREAKS FOR SIDE ROADS)
STA. 62+00 TO 64+01, SOLID LT & RT
STA. 64+01 TO 66+82, DOUBLE SOLID CL & LT
STA. 66+82 TO 67+00, DOUBLE SOLID LT

DURABLE & TEMPORARY 8 INCH YELLOW LINE
STA. 64+74 TO 66+28, RT (DIAGONALS)
SEE SHEET 27


SPECIAL PROVISION (BITUMINOUS
CONCRETE PAVEMENT, SMALL QUANTITY)
STA. 62+00 TO 64+70, LT (PATH)

REMOVING SIGNS
AS SHOWN - 8

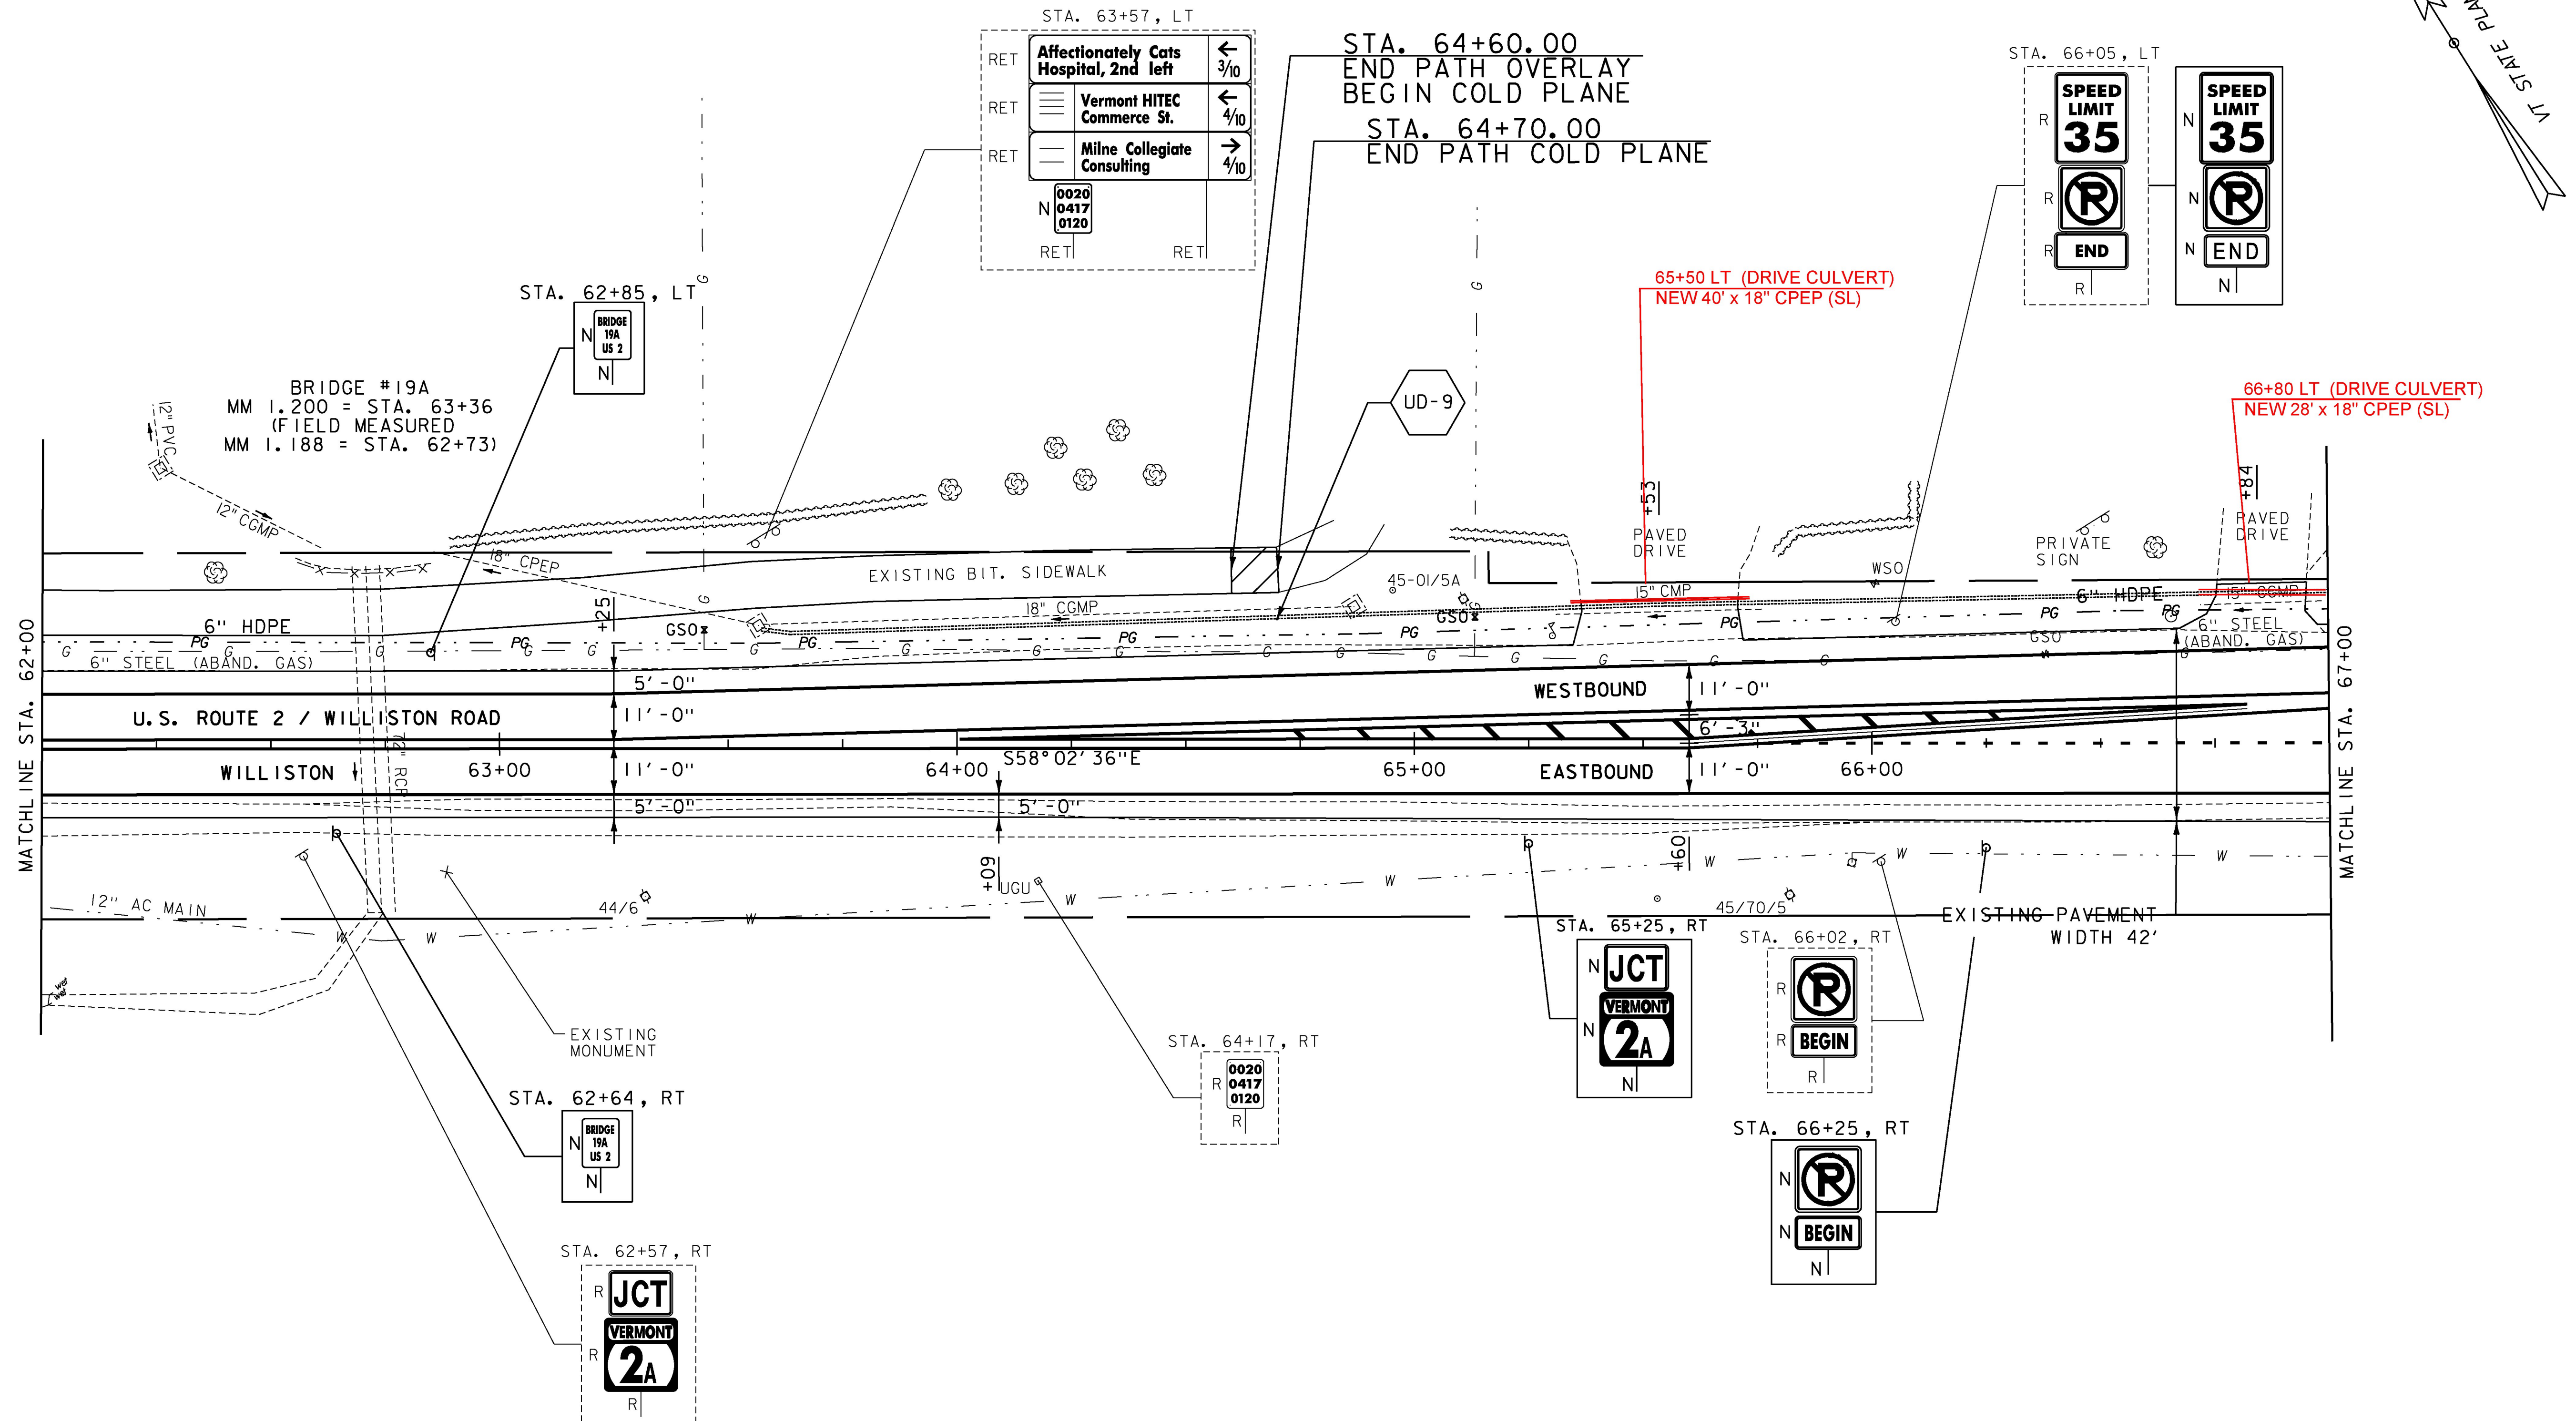

- NOTES:**
- FOR LEGENDS, SEE SHEETS 3-4.
 - ALL EXISTING SIGNS NOT SHOWN ON THE PLANS SHALL BE RETAINED.

UD-9
64+89
STA. 63+57 TO 67+00, LT
CONSTRUCT 6 INCH UNDERDRAIN PIPE,
SEE SHEET 20 FOR DETAILS AND ASSOCIATED QUANTITIES

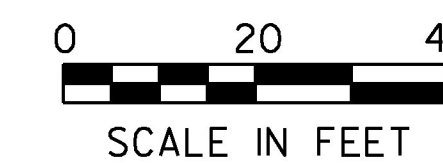

PROJECT NAME:	SOUTH BURLINGTON-WILLISTON
PROJECT NUMBER:	NH 2944(I)
FILE NAME:	zild340bdr.dgn
PROJECT LEADER:	G. EDWARDS
DESIGNED BY:	D. DRAPER
LAYOUT SHEET 21	
PLOT DATE:	2/15/2017
DRAWN BY:	D. DRAPER
CHECKED BY:	J. LITTLE
SHEET	73 OF 249