

**DURABLE & TEMPORARY 4 INCH WHITE LINE**  
 (ALL LINES WILL INCLUDE EDGE LINE BREAKS AND RADII FOR SIDE ROADS)  
 STA. 77+00 TO 77+10, EDGE LINE LT  
 STA. 77+00 TO 81+00, EDGE LINE RT  
 STA. 77+00 TO 77+50, SOLID RT (LANE LINE)  
 STA. 77+00 TO 77+10, SOLID LANE LINES LT (2)  
 STA. 77+10 TO 77+87, DOTTED LANE LINES LT (2)  
 STA. 77+60, SOLID LT (LANE LINE, TAFT CORNERS DR.)  
 STA. 77+87 TO 79+12, SOLID CL (LANE LINE)  
 STA. 77+87 TO 78+37, SOLID LANE LINES LT (2)  
 STA. 77+92 TO 80+59, SOLID LT  
 STA. 78+37 TO 80+59, DOTTED LANE LINES LT (2)  
 STA. 79+12 TO 80+92, DOTTED LT  
 STA. 80+59 TO 81+00, EDGE LINE LT

**DURABLE & TEMPORARY 4 INCH YELLOW LINE**  
 (ALL LINES WILL INCLUDE C BREAKS FOR SIDE ROADS)  
 STA. 77+00 TO 77+50, SOLID LT & RT  
 STA. 77+59, DOUBLE SOLID LT (TAFT CORNERS DR.)  
 STA. 77+87 TO 79+45, DOUBLE SOLID RT  
 STA. 79+45 TO 81+00, DOUBLE SOLID LT & RT

**DURABLE & TEMPORARY 8 INCH YELLOW LINE**  
 STA. 79+78 TO 81+00, LT & RT (DIAGONALS)  
 SEE SHEET 27

**DURABLE & TEMPORARY 24 INCH STOP BAR**  
 STA. 77+60, LT (TAFT CORNERS DR.)

**DURABLE LETTER OR SYMBOL, TYPE D TAPE**  
 STA. 77+04, RT ARROW  
 STA. 77+45, LT ARROW  
 STA. 77+46, LT ARROW  
 STA. 77+46, RT ARROW  
 STA. 77+60, LT "STOP" (8) (TAFT CORNERS DR.)  
 STA. 77+60, LT ARROW (2) (TAFT CORNERS DR.)  
 STA. 77+91, RT ARROW  
 STA. 78+32, LT ARROW  
 STA. 78+33, LT ARROW  
 STA. 78+50, RT "ONLY"  
 STA. 79+08, RT ARROW

**DURABLE LETTER OR SYMBOL, (OPTION ITEMS)**  
 STA. 77+03, LT BIKE LANE SYMBOL  
 STA. 78+18, LT BIKE LANE ARROW  
 STA. 78+30, LT BIKE LANE SYMBOL  
 STA. 78+32, LT ARROW  
 STA. 79+08, RT ARROW

**TEMPORARY LETTER OR SYMBOL, PAINT**  
 STA. 77+03, LT BIKE LANE SYMBOL  
 STA. 77+04, RT ARROW  
 STA. 77+45, LT ARROW  
 STA. 77+46, LT ARROW  
 STA. 77+46, RT ARROW  
 STA. 77+60, LT "STOP" (8) (TAFT CORNERS DR.)  
 STA. 77+60, LT ARROW (2) (TAFT CORNERS DR.)  
 STA. 77+91, RT ARROW  
 STA. 78+18, LT BIKE LANE ARROW  
 STA. 78+30, LT BIKE LANE SYMBOL  
 STA. 78+32, LT ARROW  
 STA. 78+33, LT ARROW  
 STA. 79+08, RT ARROW

**REMOVING SIGNS**  
 AS SHOWN - 21

**ERECTING SALVAGED SIGNS**  
 AS SHOWN - 1

**SPECIAL PROVISION (GREEN PAVEMENT MARKINGS - BICYCLE LANE)**  
 STA. 77+00 TO 80+59, BIKE LANE LT  
 SEE SHEET 27

**CHANGING ELEVATION OF Dis, CBs OR MHs**  
 SEE SHEET 21

**REHAB. Dis, CBs OR MHs, CLASS I OR II**  
 SEE SHEET 21

**CHANGING ELEVATION OF SEWER MANHOLES**  
 SEE SHEET 21

**CAST-IN-PLACE CONCRETE CURB, TYPE B**  
 STA. 77+00 TO 77+37, LT STA 77+25 TO 77+40 LT  
 (INCLUDES TAFT CORNERS DR.)


**REMOVAL OF EXISTING CURB**  
 STA. 77+00 TO 77+37, LT  
 (INCLUDES TAFT CORNERS DR.)

**RELOCATE MAILBOX, SINGLE SUPPORT**  
 STA. 77+99, RT

**PORTLAND CEMENT CONCRETE SIDEWALK, 5 INCH**  
 STA. 77+00 TO 77+37, LT  
 (INCLUDES TAFT CORNERS DR.)

**DETECTABLE WARNING SURFACE**  
 STA. 77+30 LT

**STRUCTURE PAID AS:**  
 ITEM 604.18 - PRECAST REINFORCED CONCRETE  
 DROP INLET WITH CAST IRON GRATE  
 STRUCTURE TO BE MAINTAINED BY VTRANS

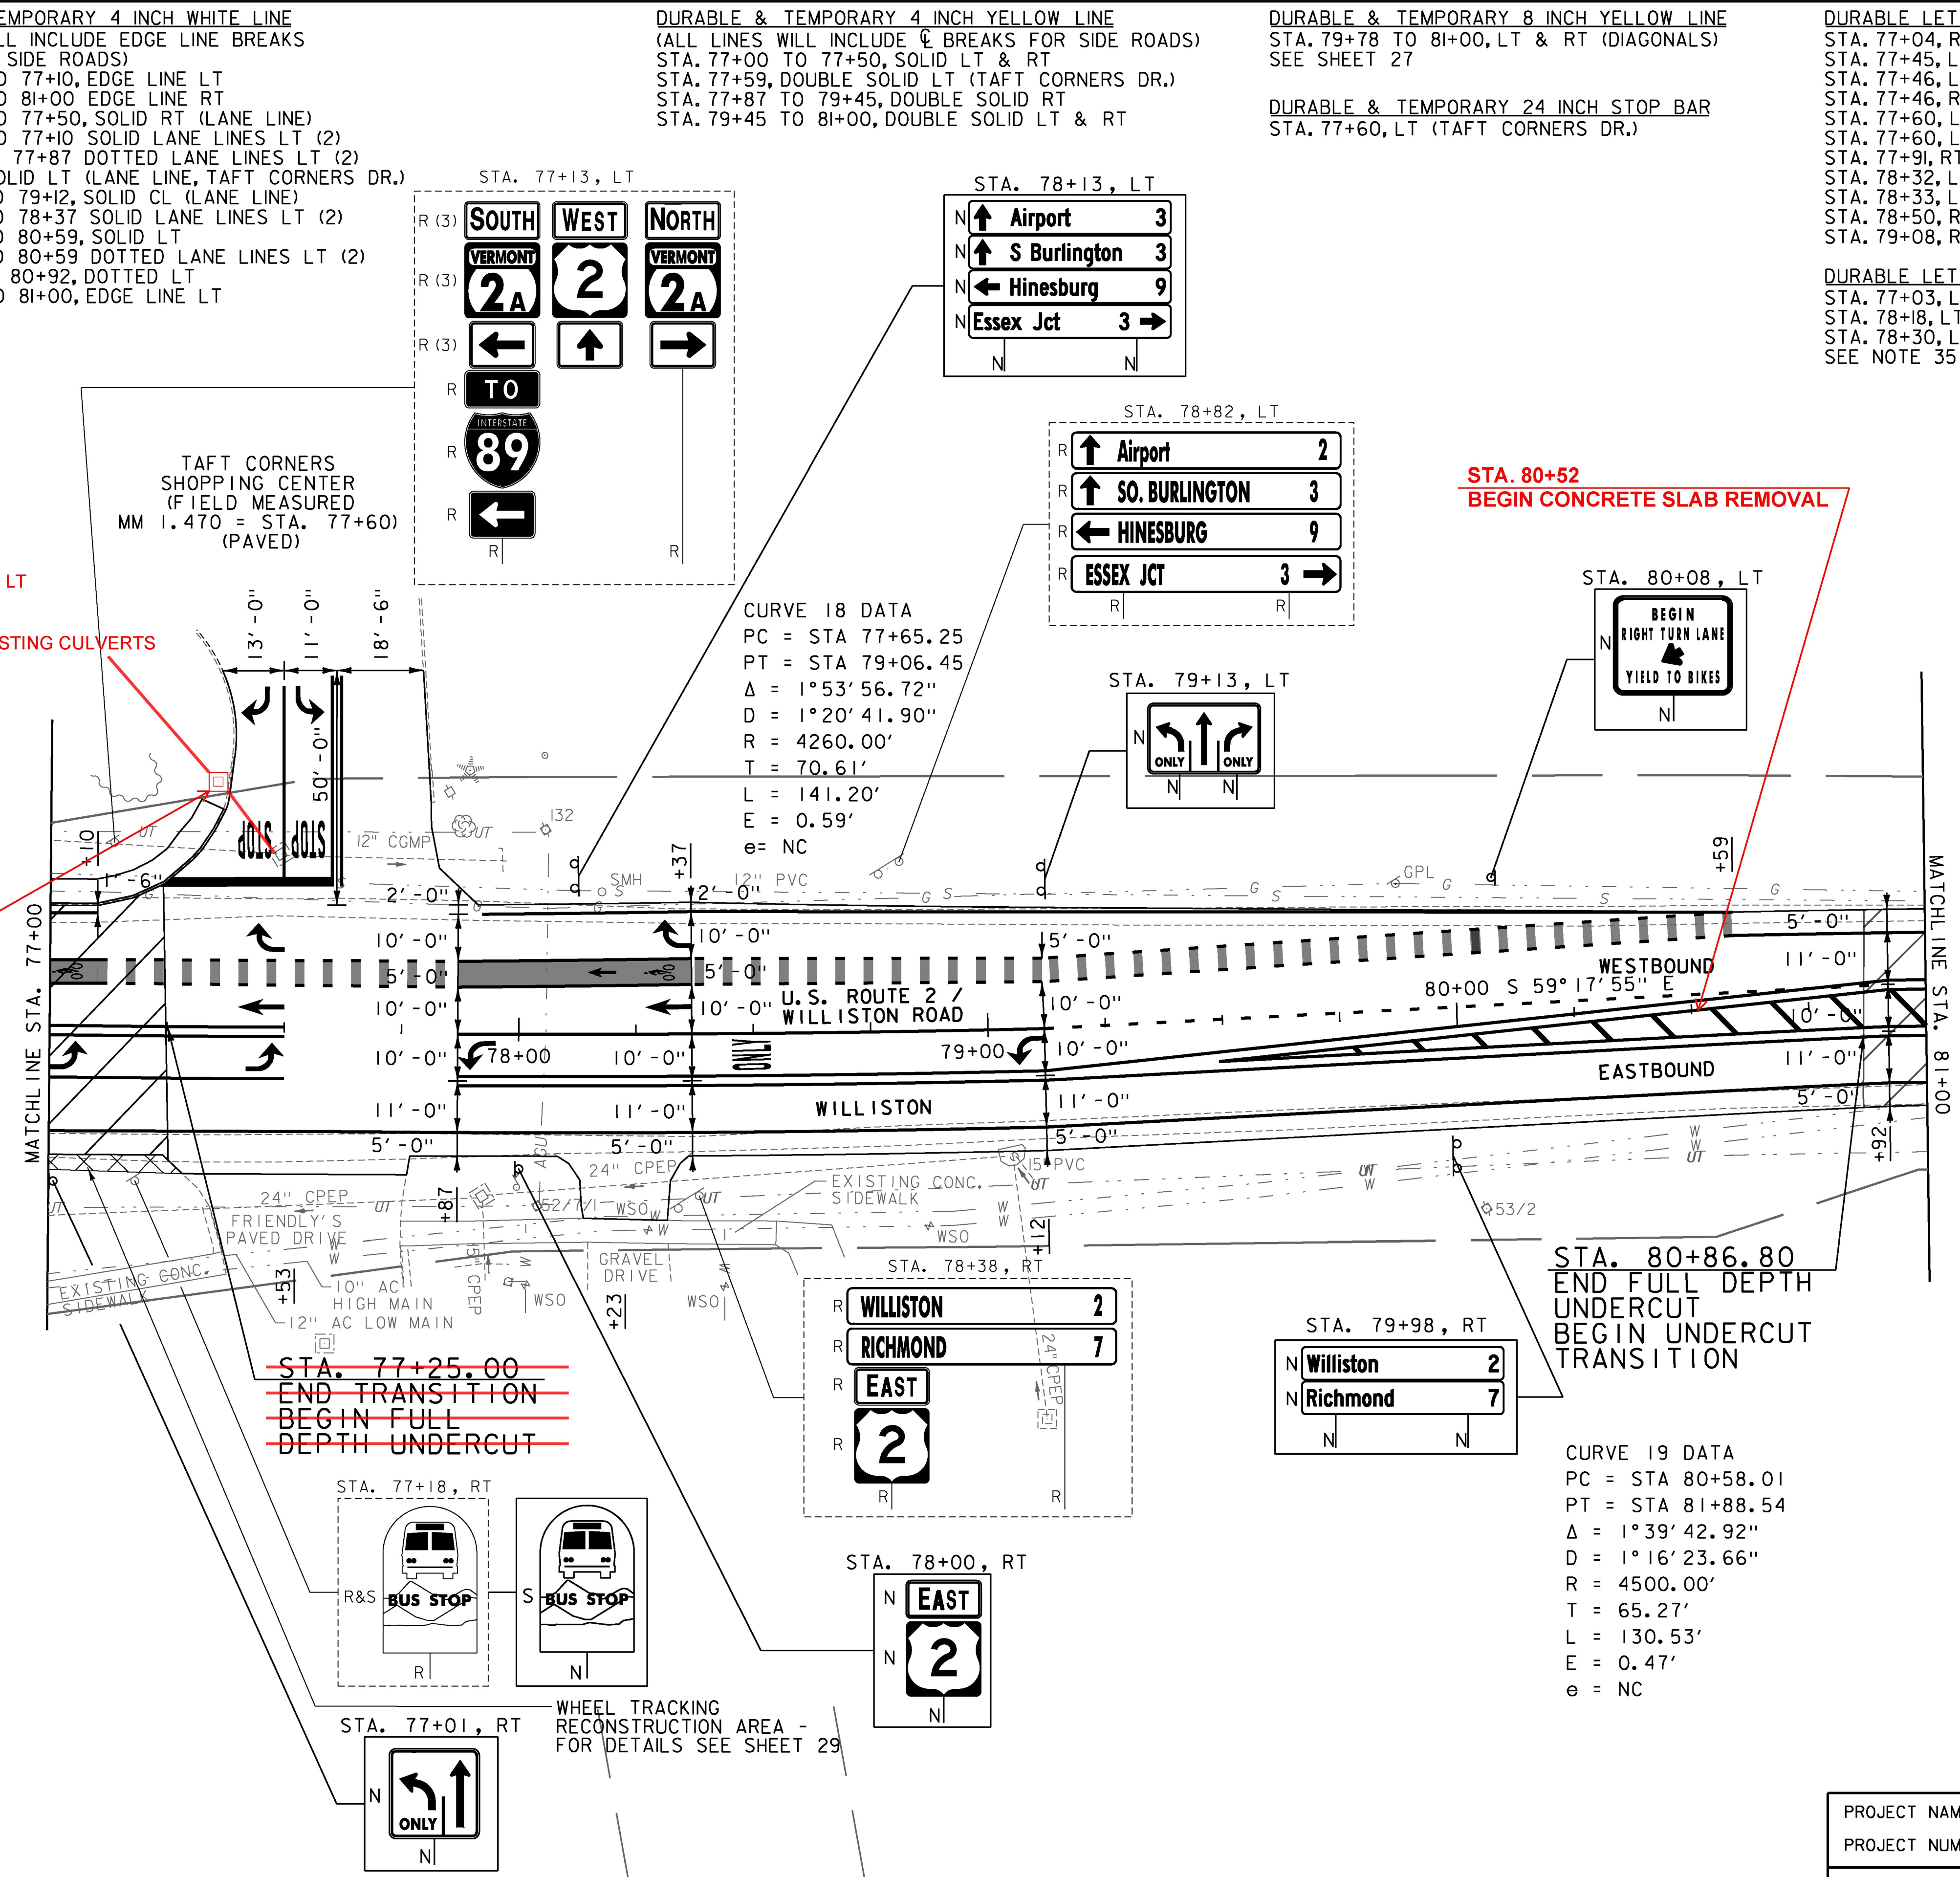

- NOTES:**
- FOR LEGENDS, SEE SHEETS 3-4.
  - ALL EXISTING SIGNS NOT SHOWN ON THE PLANS SHALL BE RETAINED.

0 20 40  
 SCALE IN FEET

PROJECT NAME: SOUTH BURLINGTON-WILLISTON	PLOT DATE: 2/15/2017
PROJECT NUMBER: NH 2944(I)	DRAWN BY: D. DRAPER
FILE NAME: zild340bdr.dgn	CHECKED BY: J. LITTLE
LAYOUT SHEET 24	SHEET 76 OF 249