

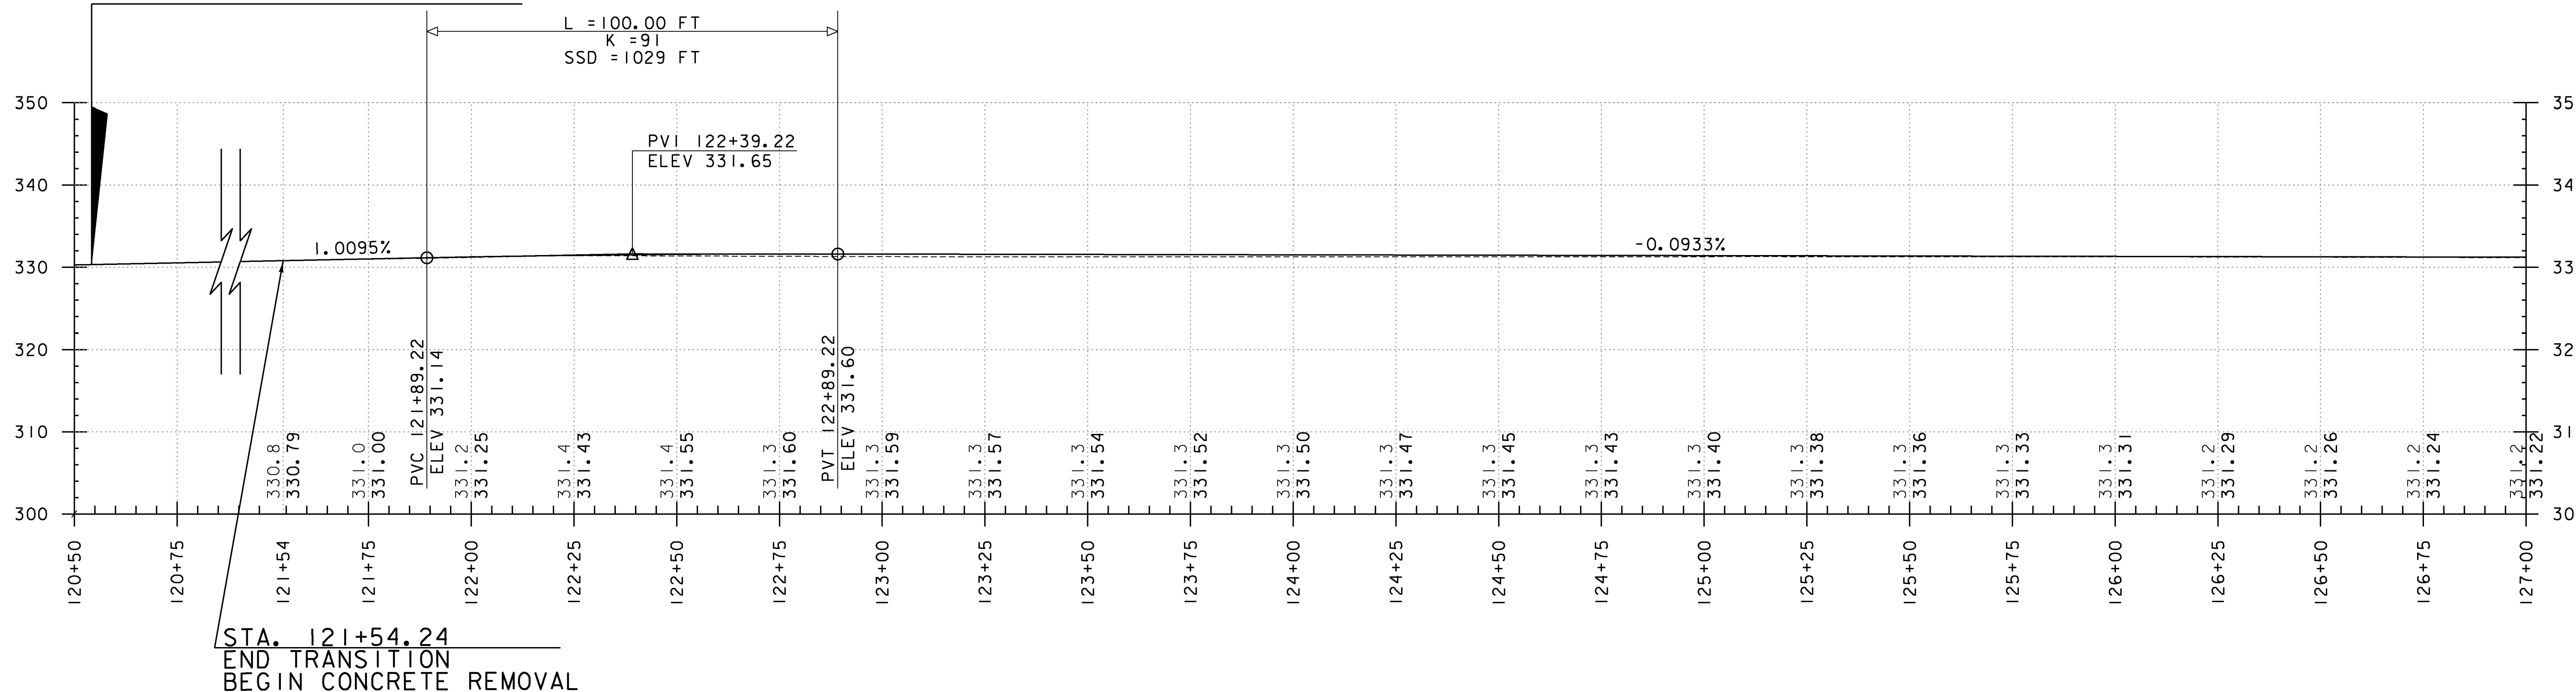


SOUTH BURLINGTON  
 STA. 120+54.24 (MM 2.283)  
 BEGIN NH 2944 (I)

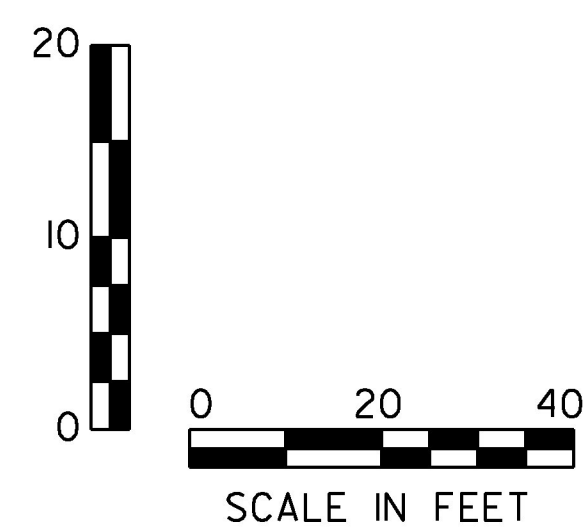

STA. 121+54.24  
 END TRANSITION  
 BEGIN CONCRETE REMOVAL

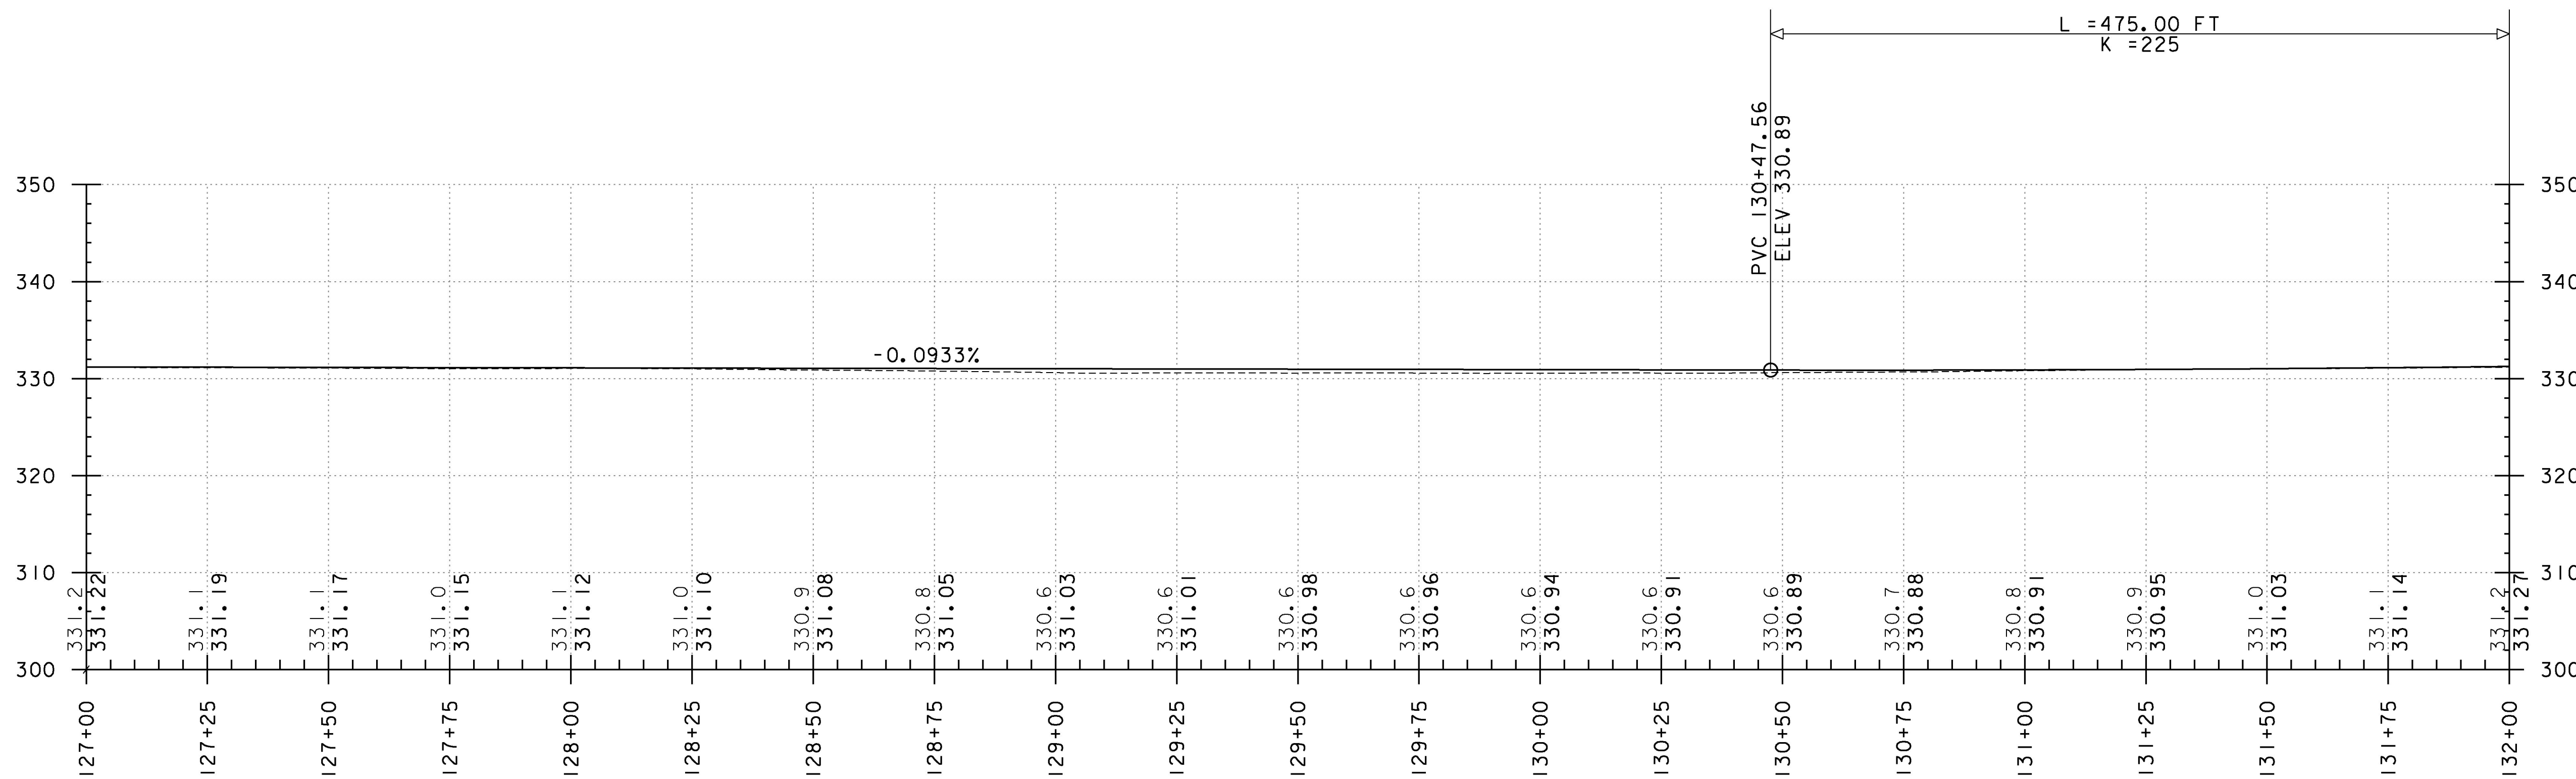

PROJECT NAME:	SOUTH BURLINGTON-WILLISTON
PROJECT NUMBER:	NH 2944(I)
FILE NAME:	zild340pro.dgn
PROJECT LEADER:	G. EDWARDS
DESIGNED BY:	G. BURGMEIER
PROFILE SHEET I	
PLOT DATE:	2/15/2017
DRAWN BY:	D. DRAPER
CHECKED BY:	J. LITTLE
SHEET	78 OF 249

