



WILLISTON
 STA. 82+36.80 (MM 1.560)
 END NH 2944 (1)

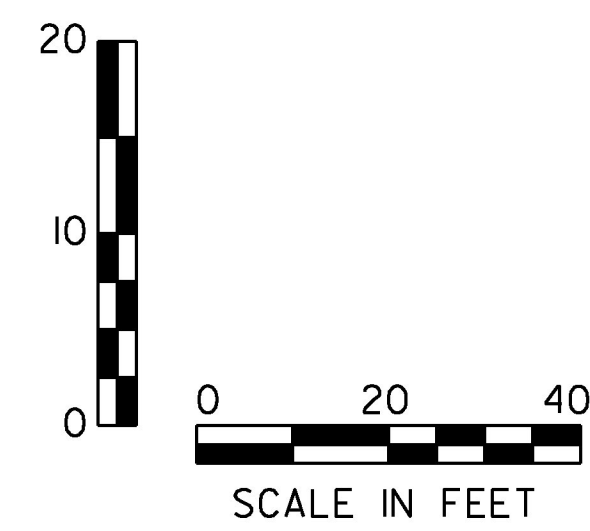

PROJECT NAME:	SOUTH BURLINGTON-WILLISTON
PROJECT NUMBER:	NH 2944(1)
FILE NAME:	zild340pro.dgn
PROJECT LEADER:	G. EDWARDS
DESIGNED BY:	G. BURGMEIER
PROFILE SHEET	13
PLOT DATE:	2/15/2017
DRAWN BY:	D. DRAPER
CHECKED BY:	J. LITTLE
SHEET	90 OF 249

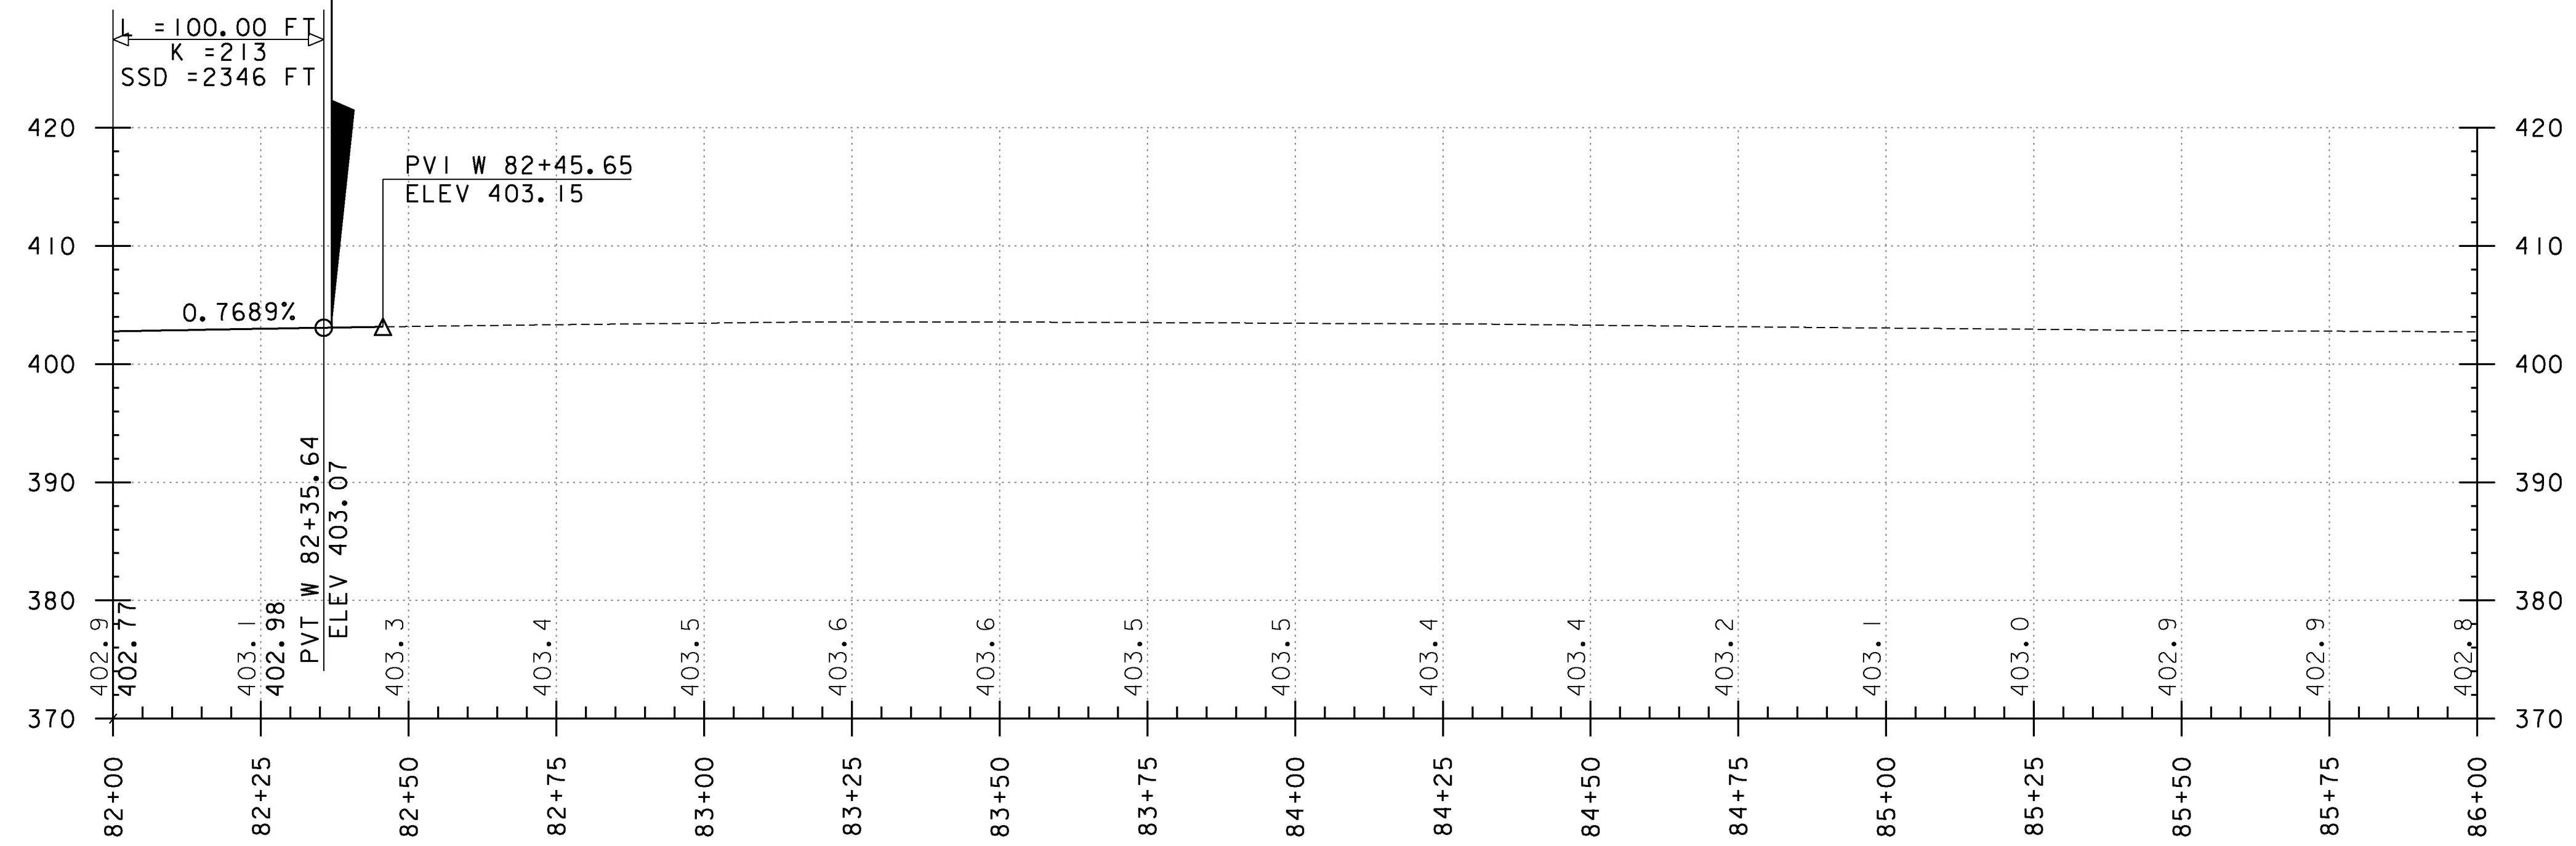