




122+00

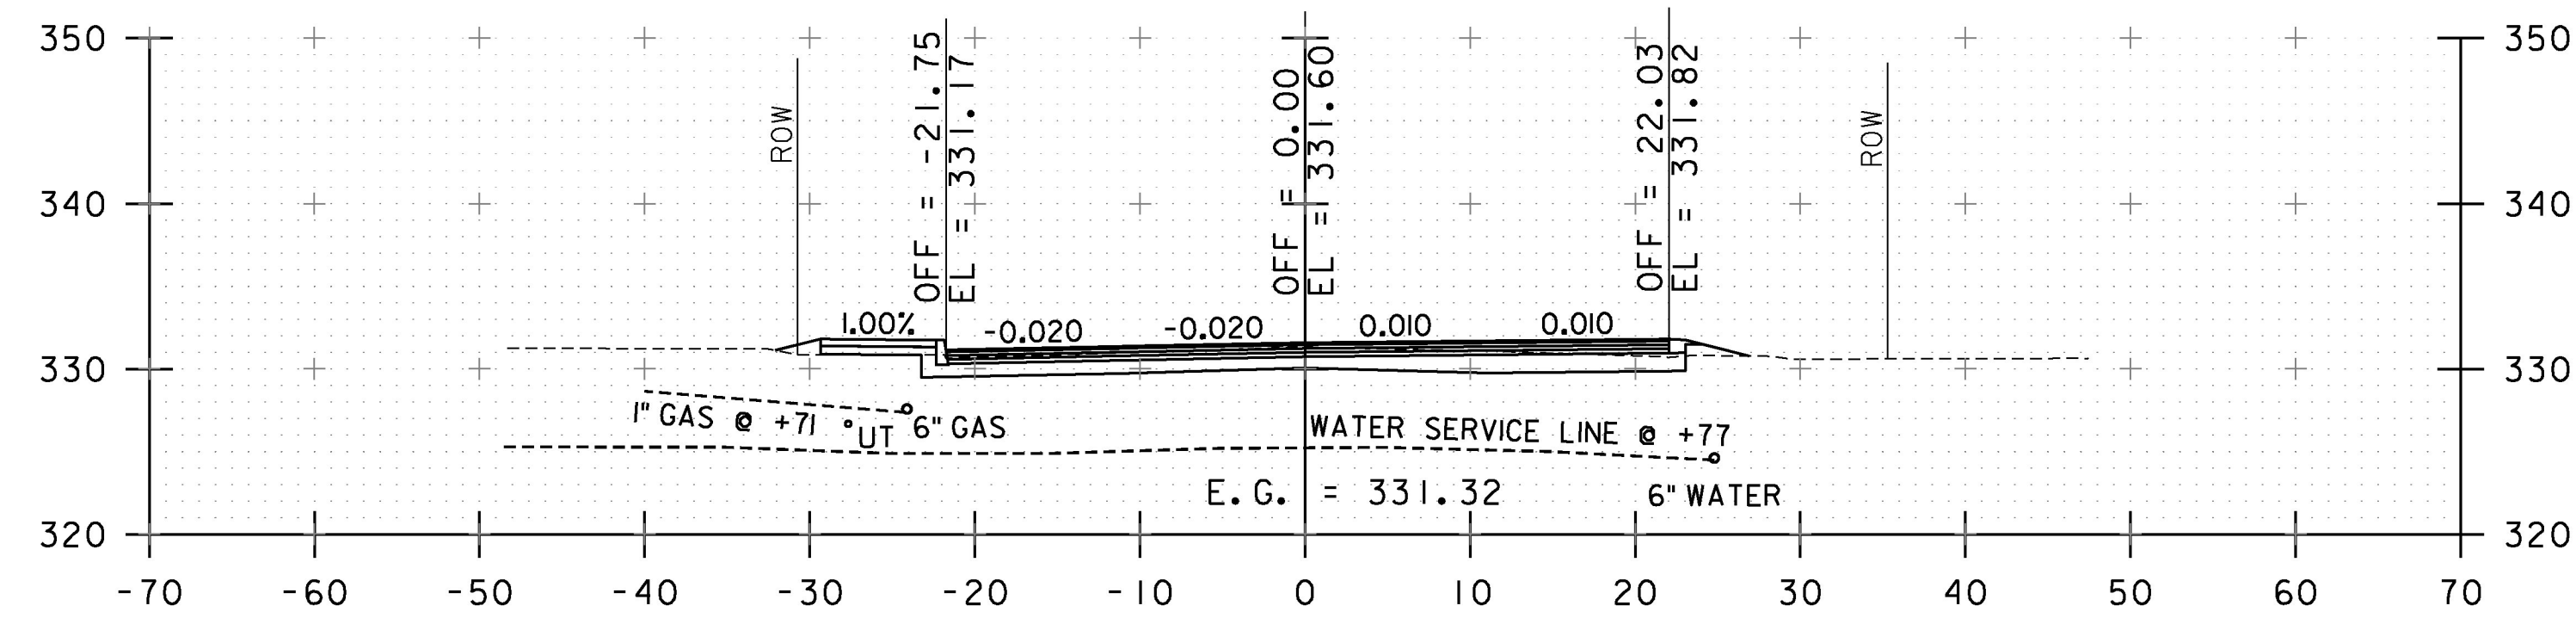


122+75

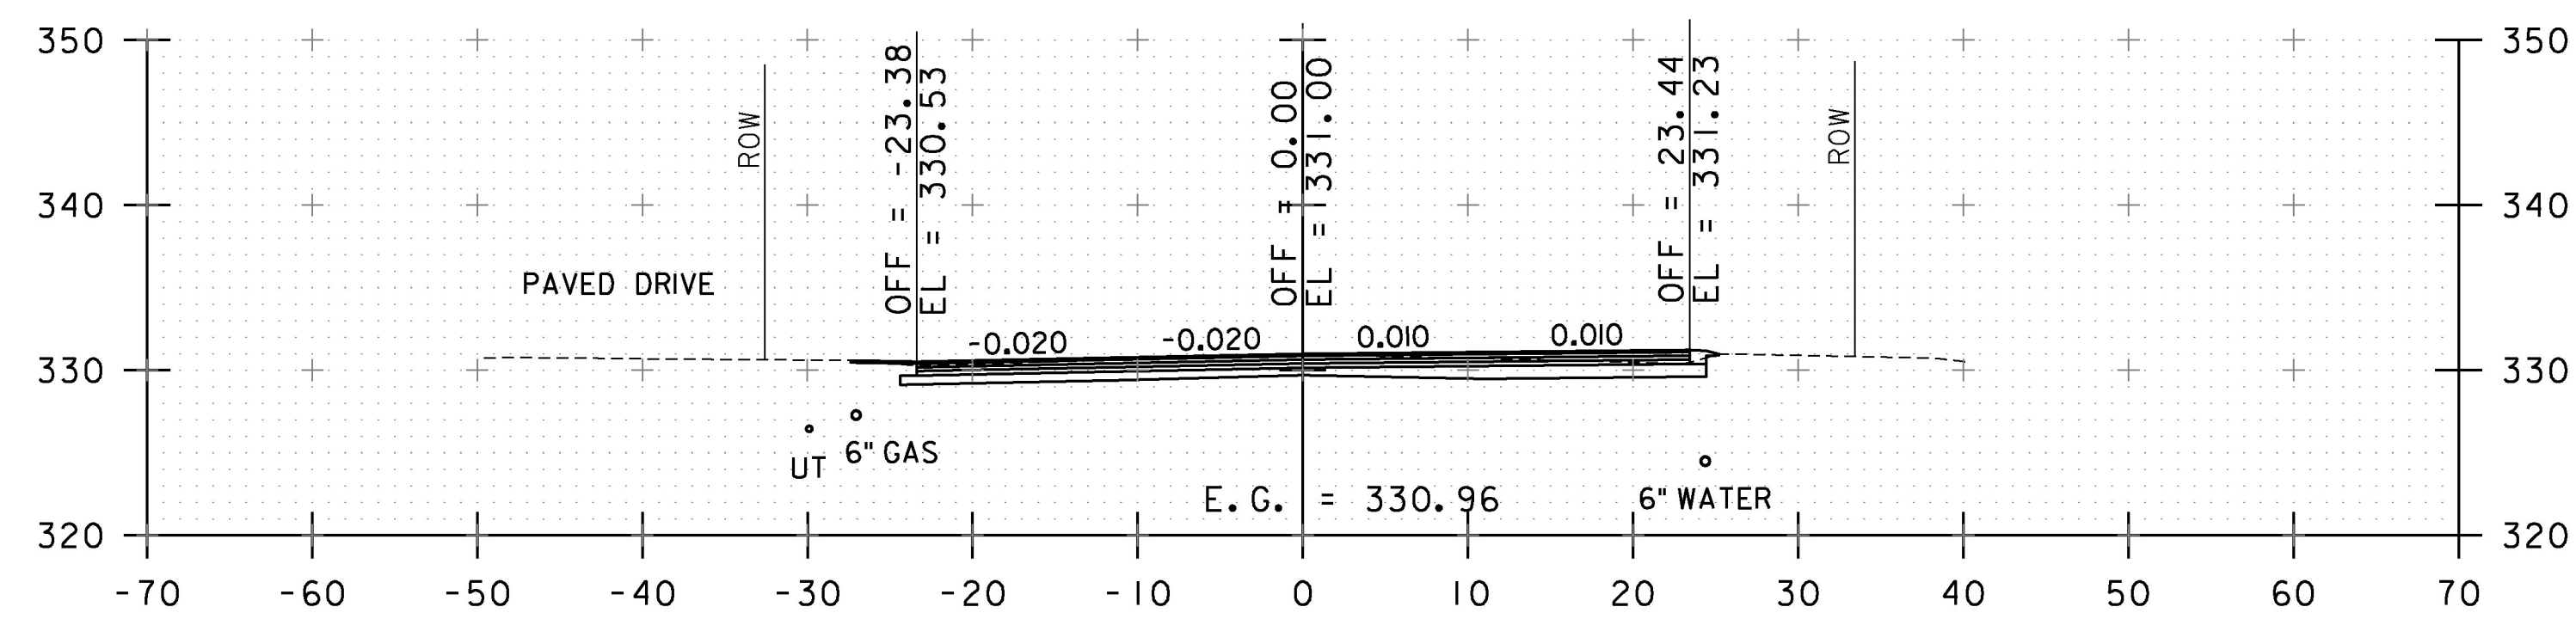

121+75

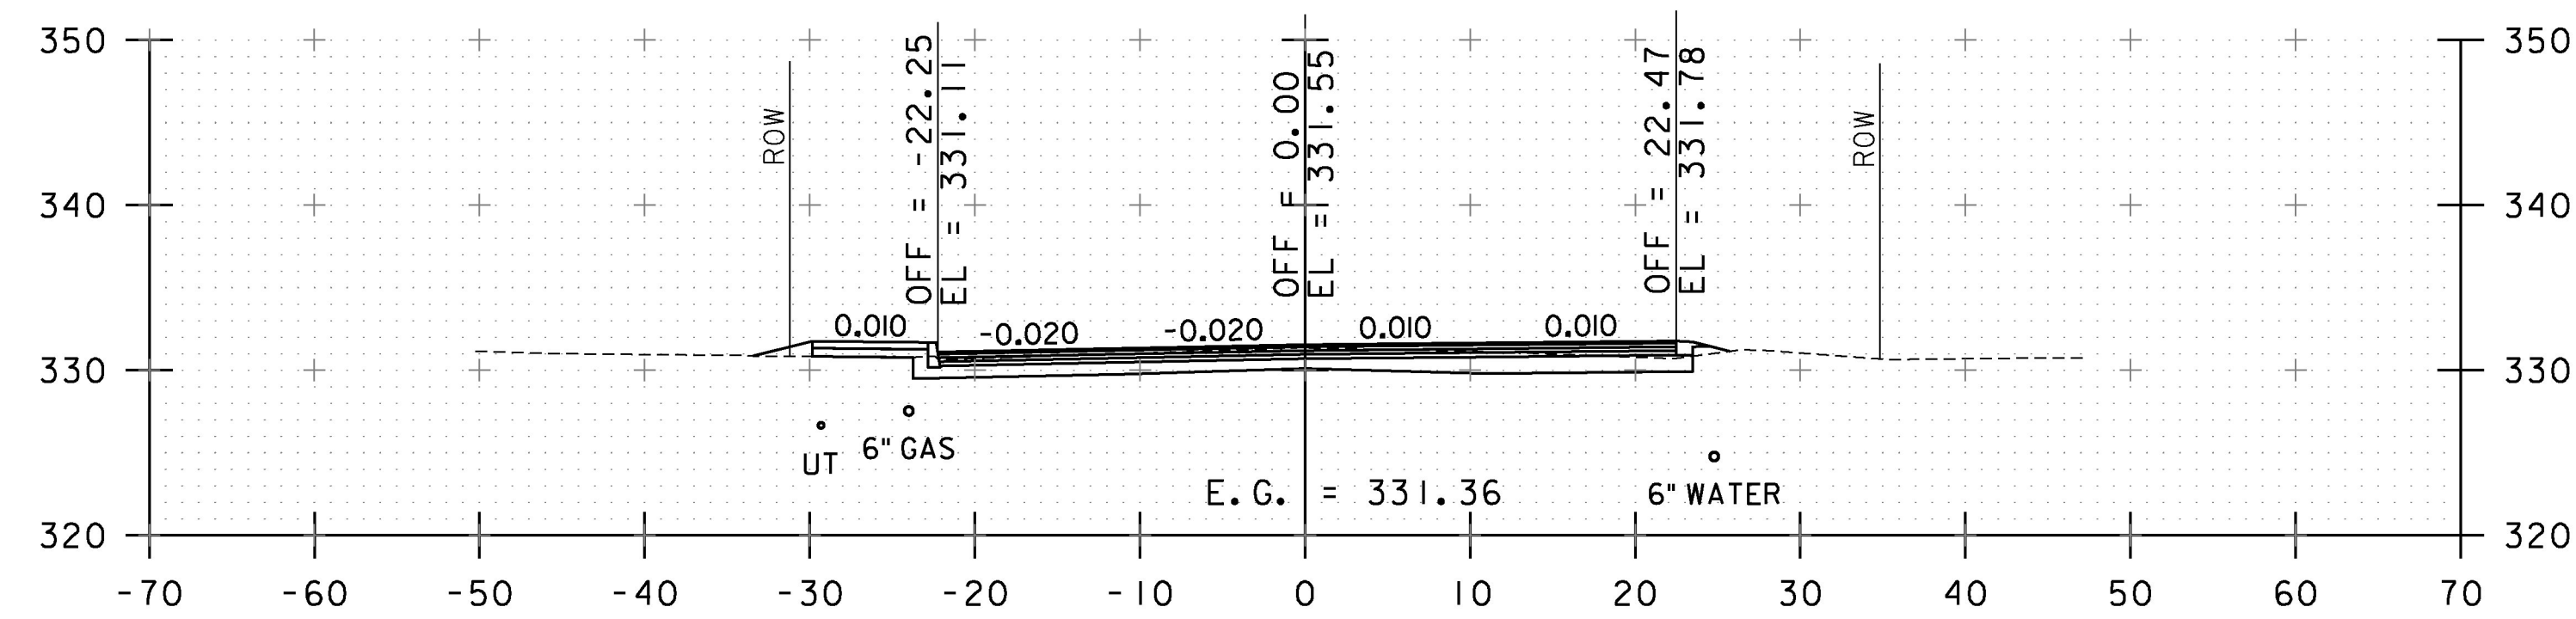


122+50

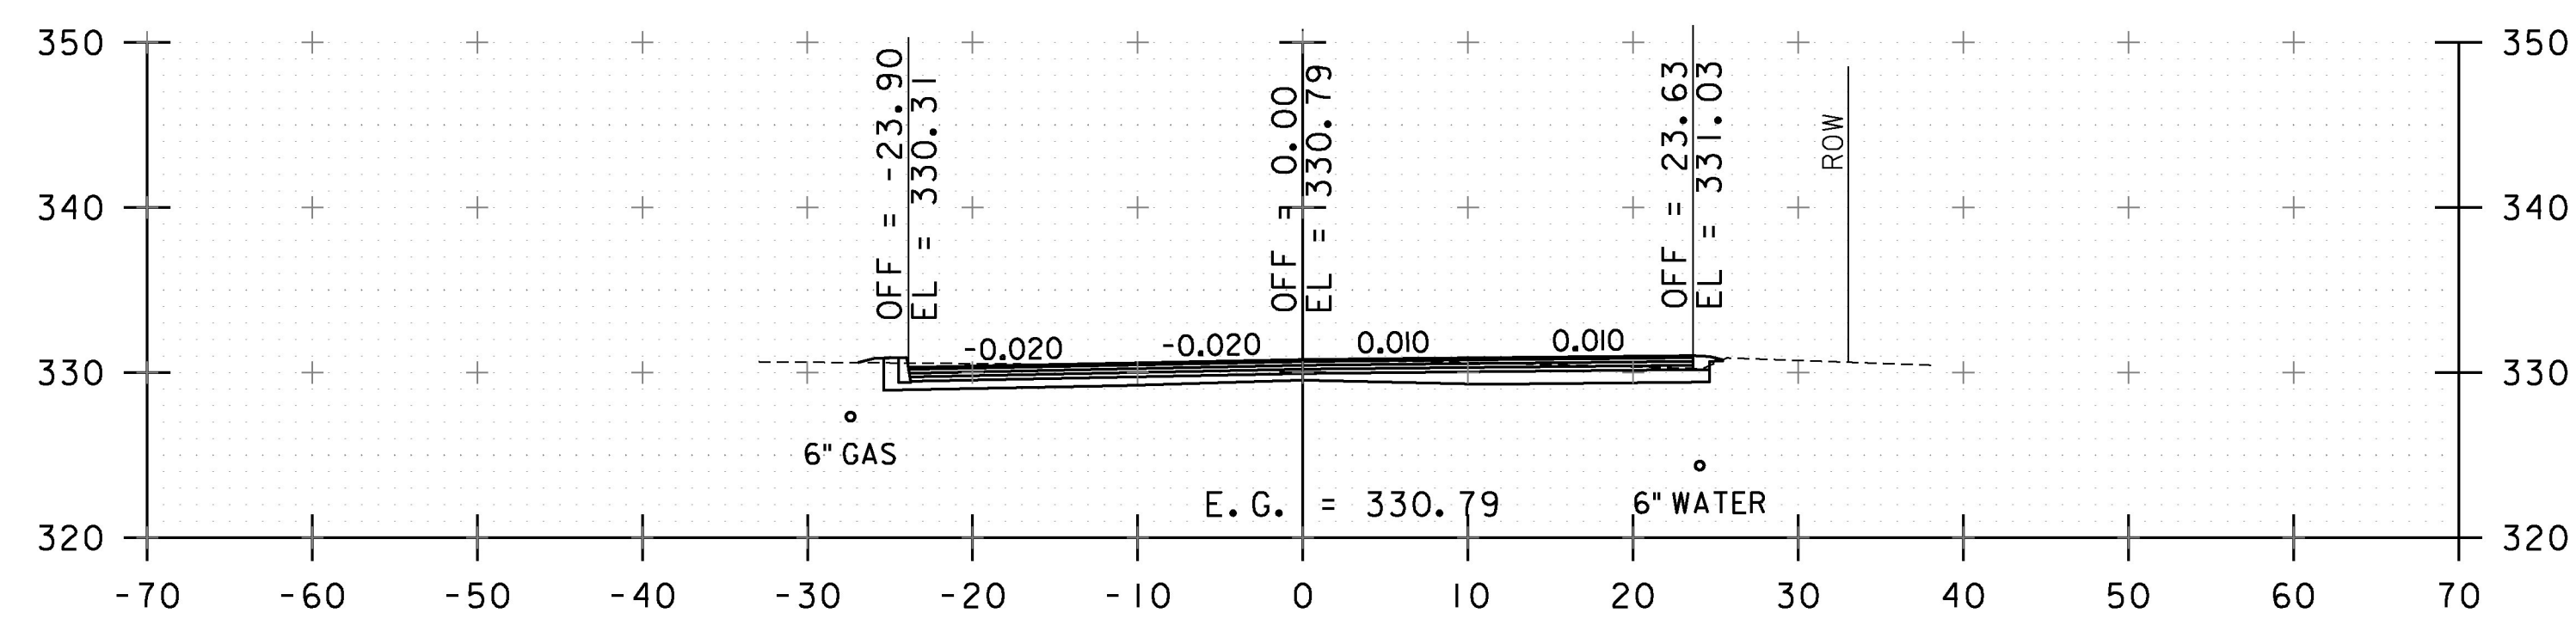


121+54.24

END TRANSITION BEGIN CONCRETE REMOVAL

120+54.24 (MM 2.283) BEGIN NH 2944 (I)

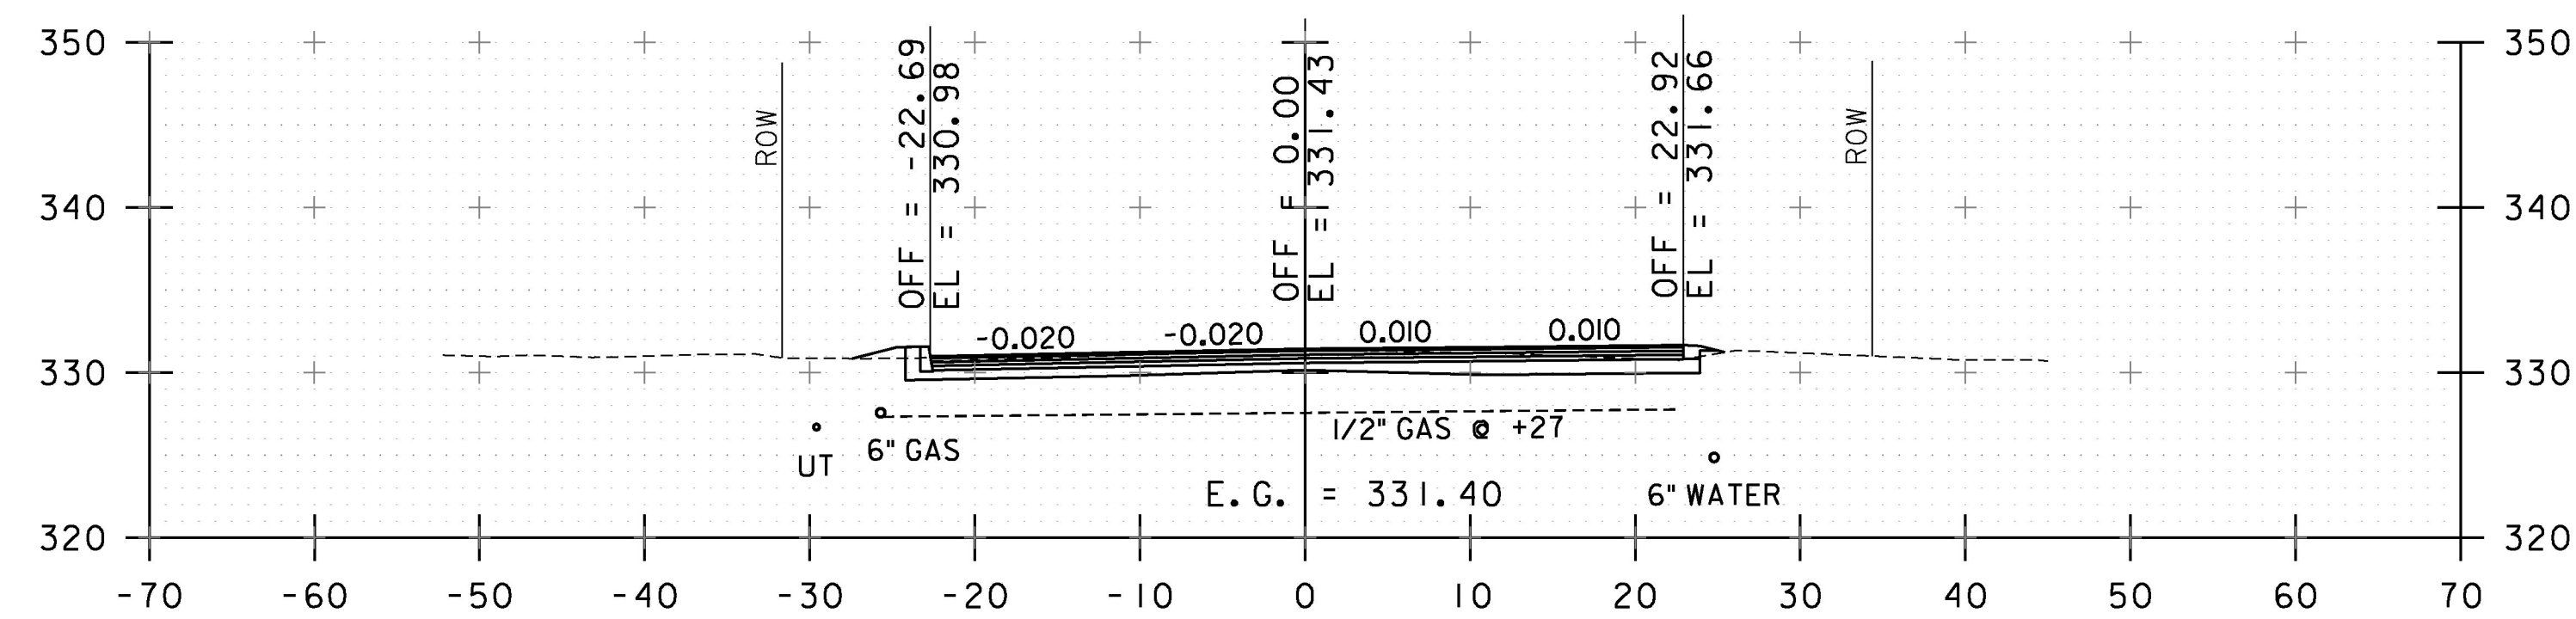

122+25

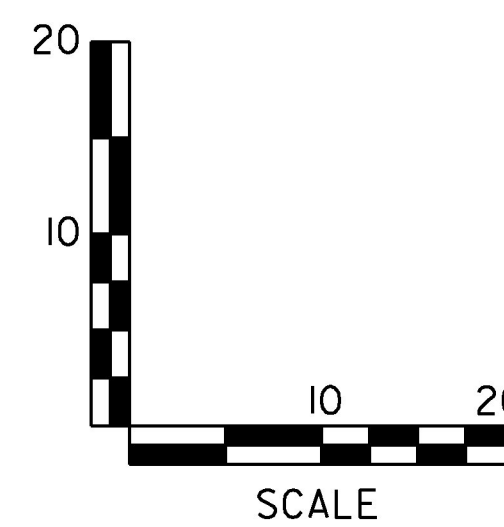

STA. 121+54 TO STA. 122+75

PROJECT NAME:	SOUTH BURLINGTON-WILLISTON
PROJECT NUMBER:	NH 2944(I)
FILE NAME:	z11d340xst.dgn
PROJECT LEADER:	G. EDWARDS
DESIGNED BY:	I. MAYNARD
CROSS SECTION SHEET I	
PLOT DATE:	2/15/2017
DRAWN BY:	I. MAYNARD
CHECKED BY:	J. LITTLE
SHEET	121 OF 249