




134+00

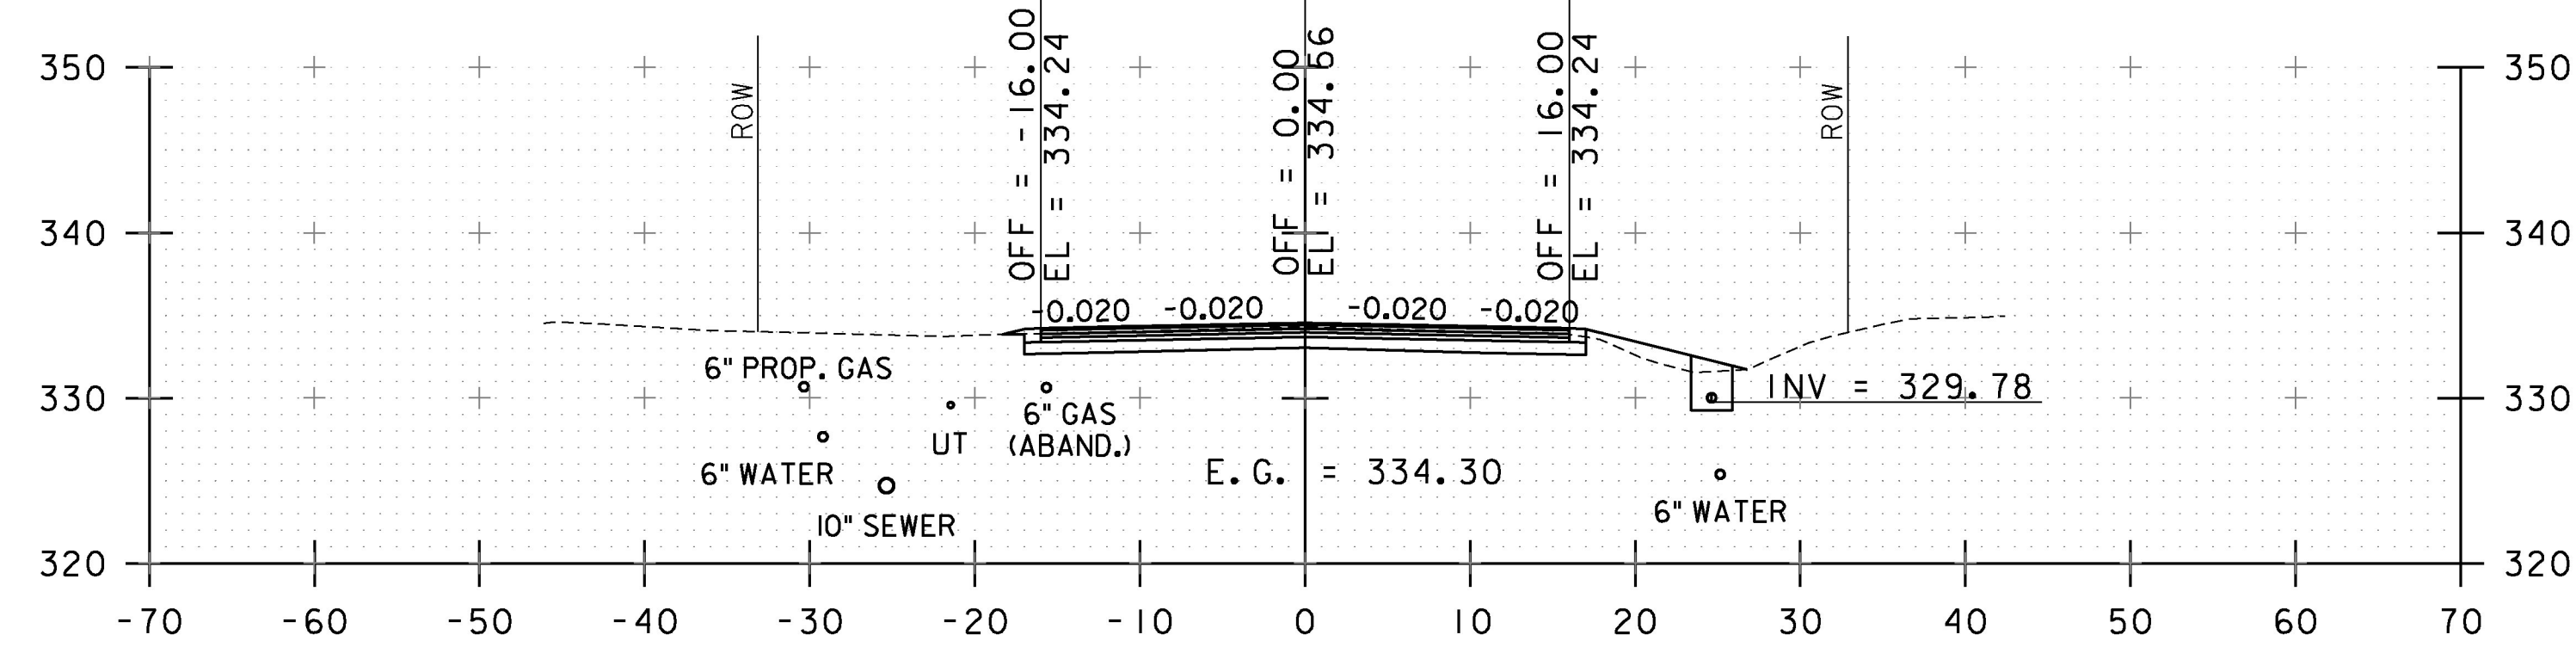


134+75

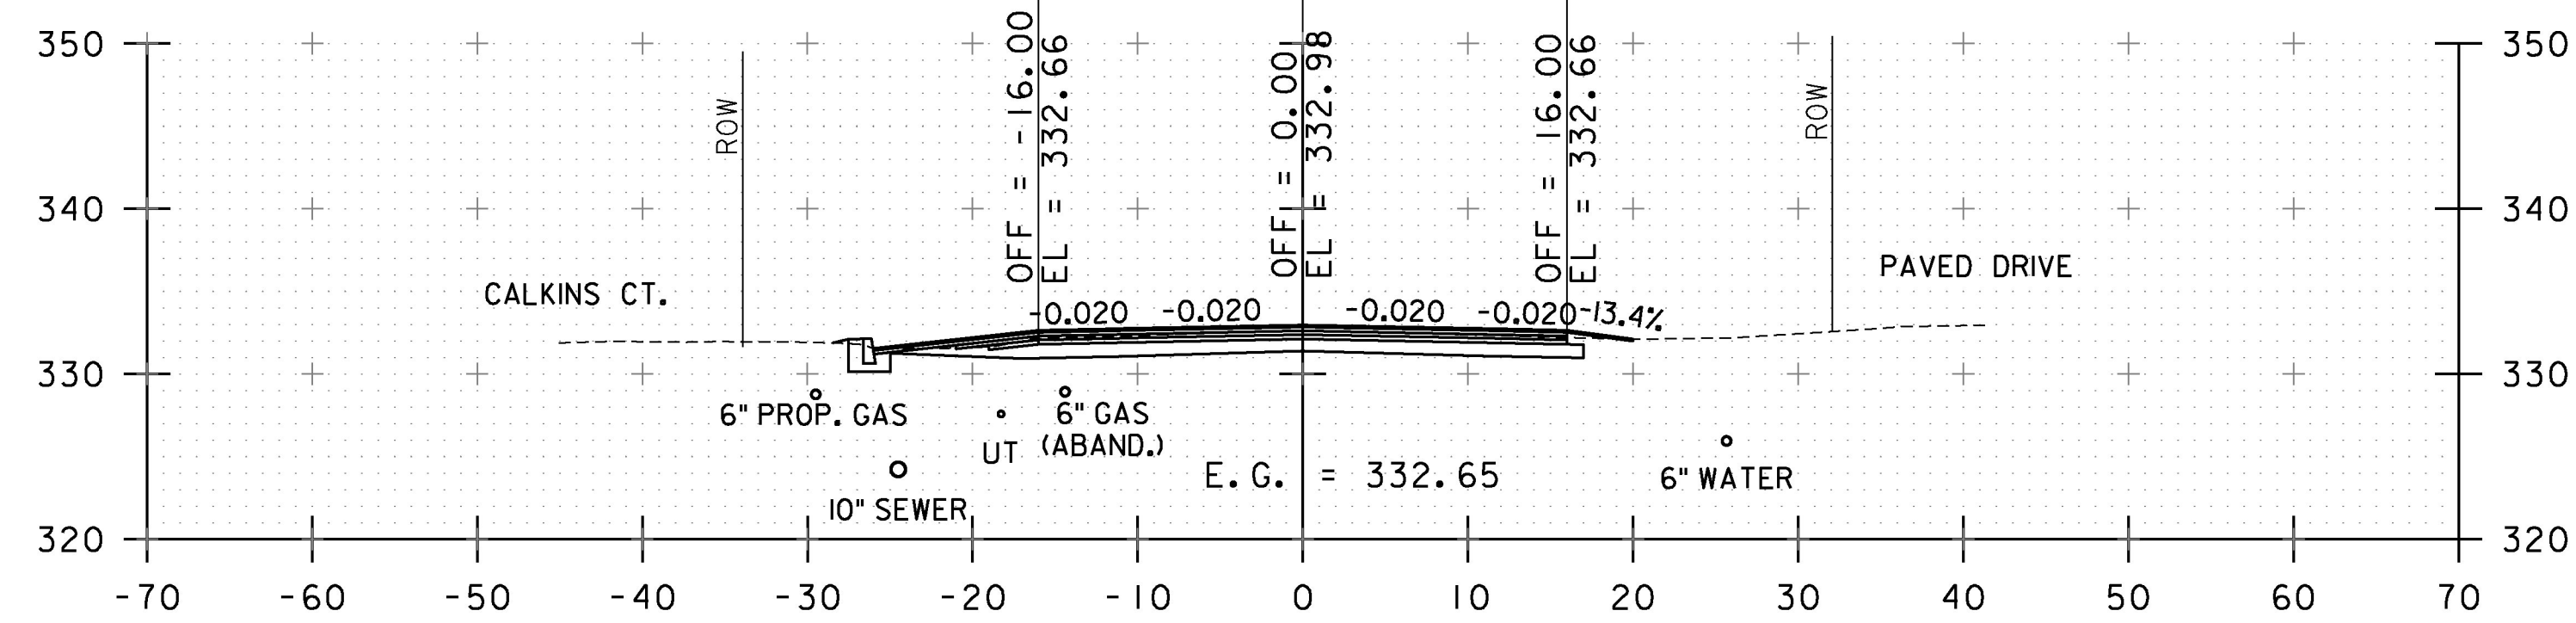


133+75

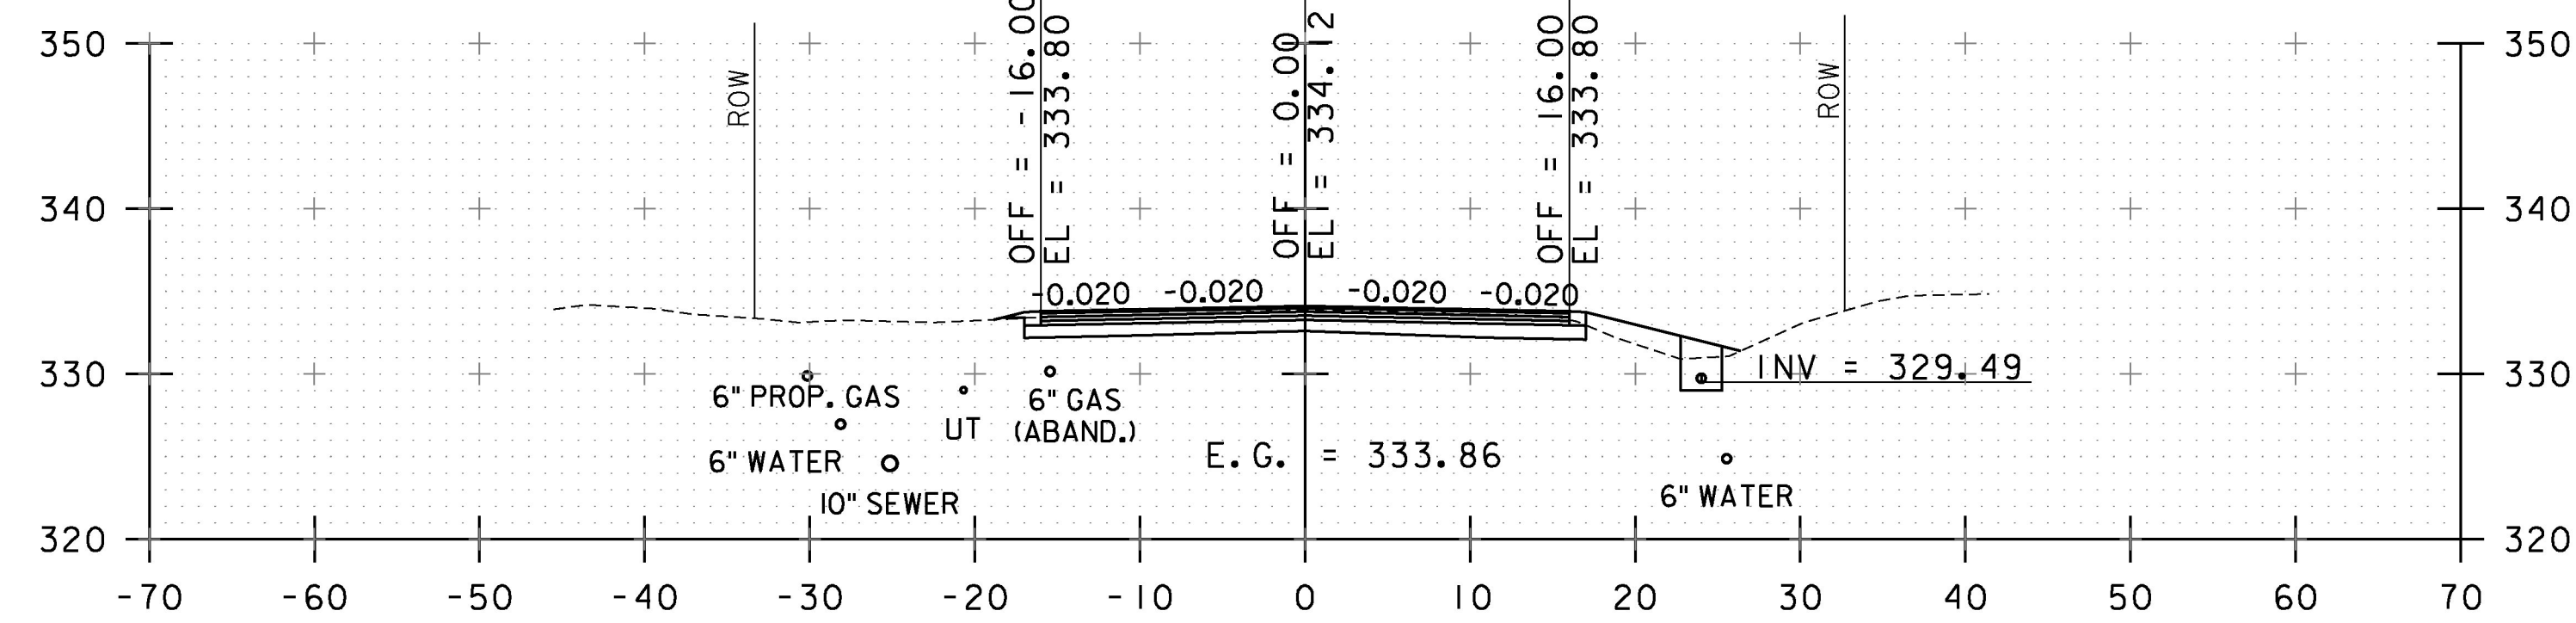


134+50

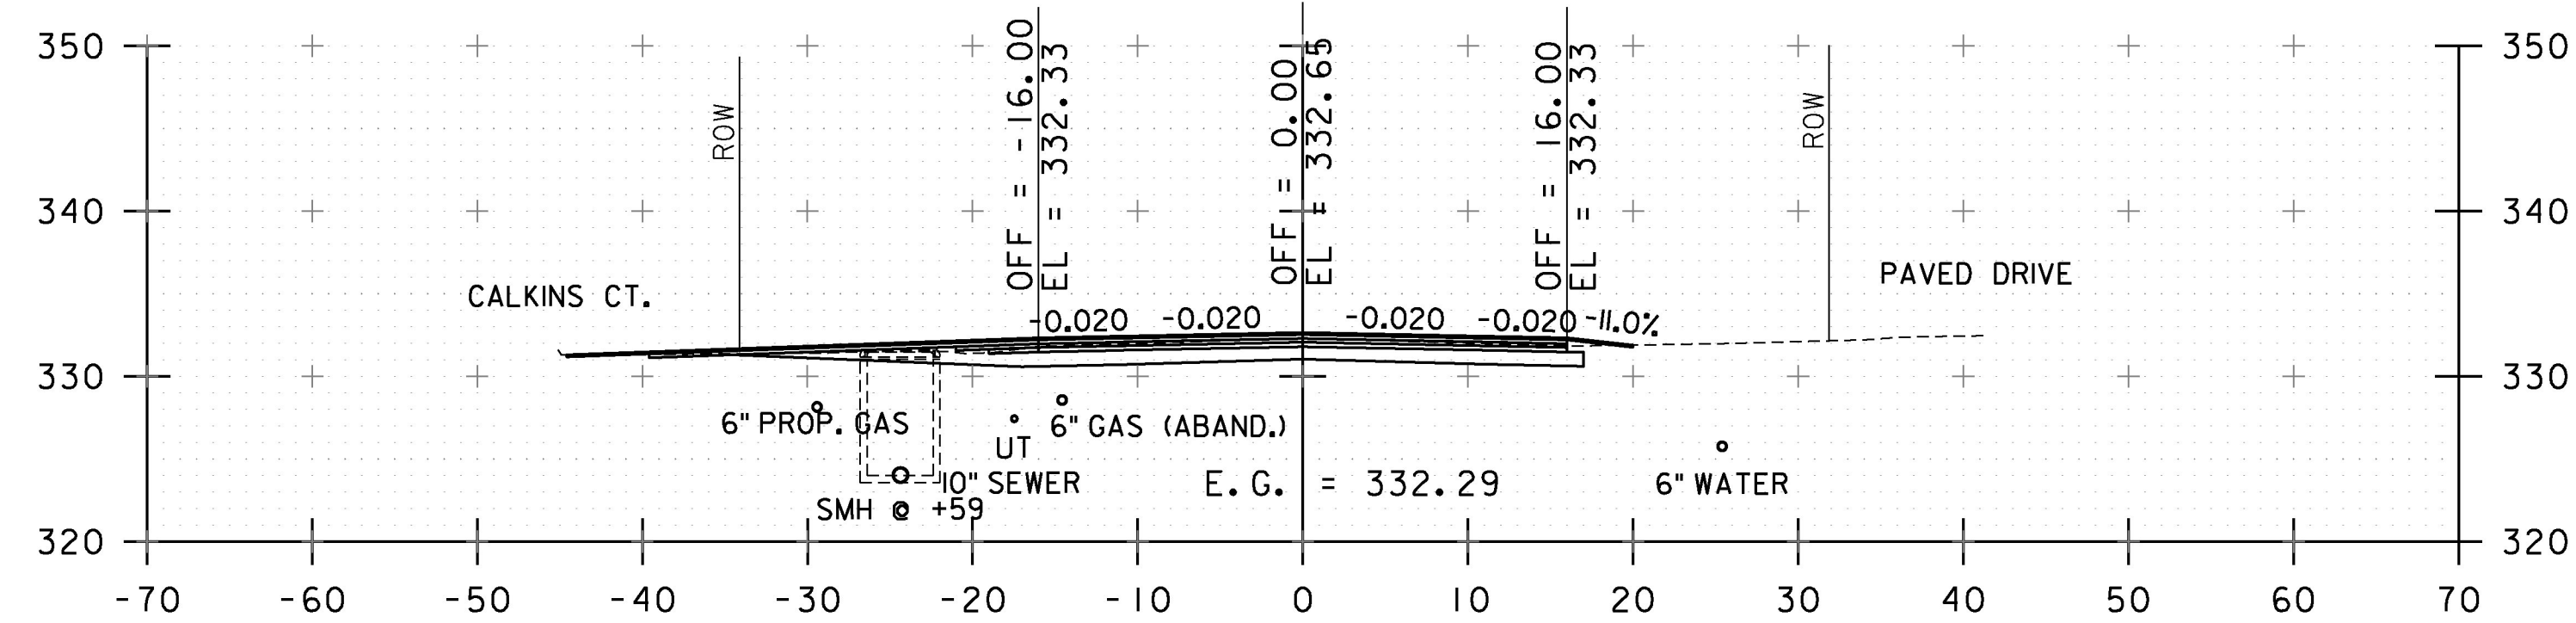

133+50

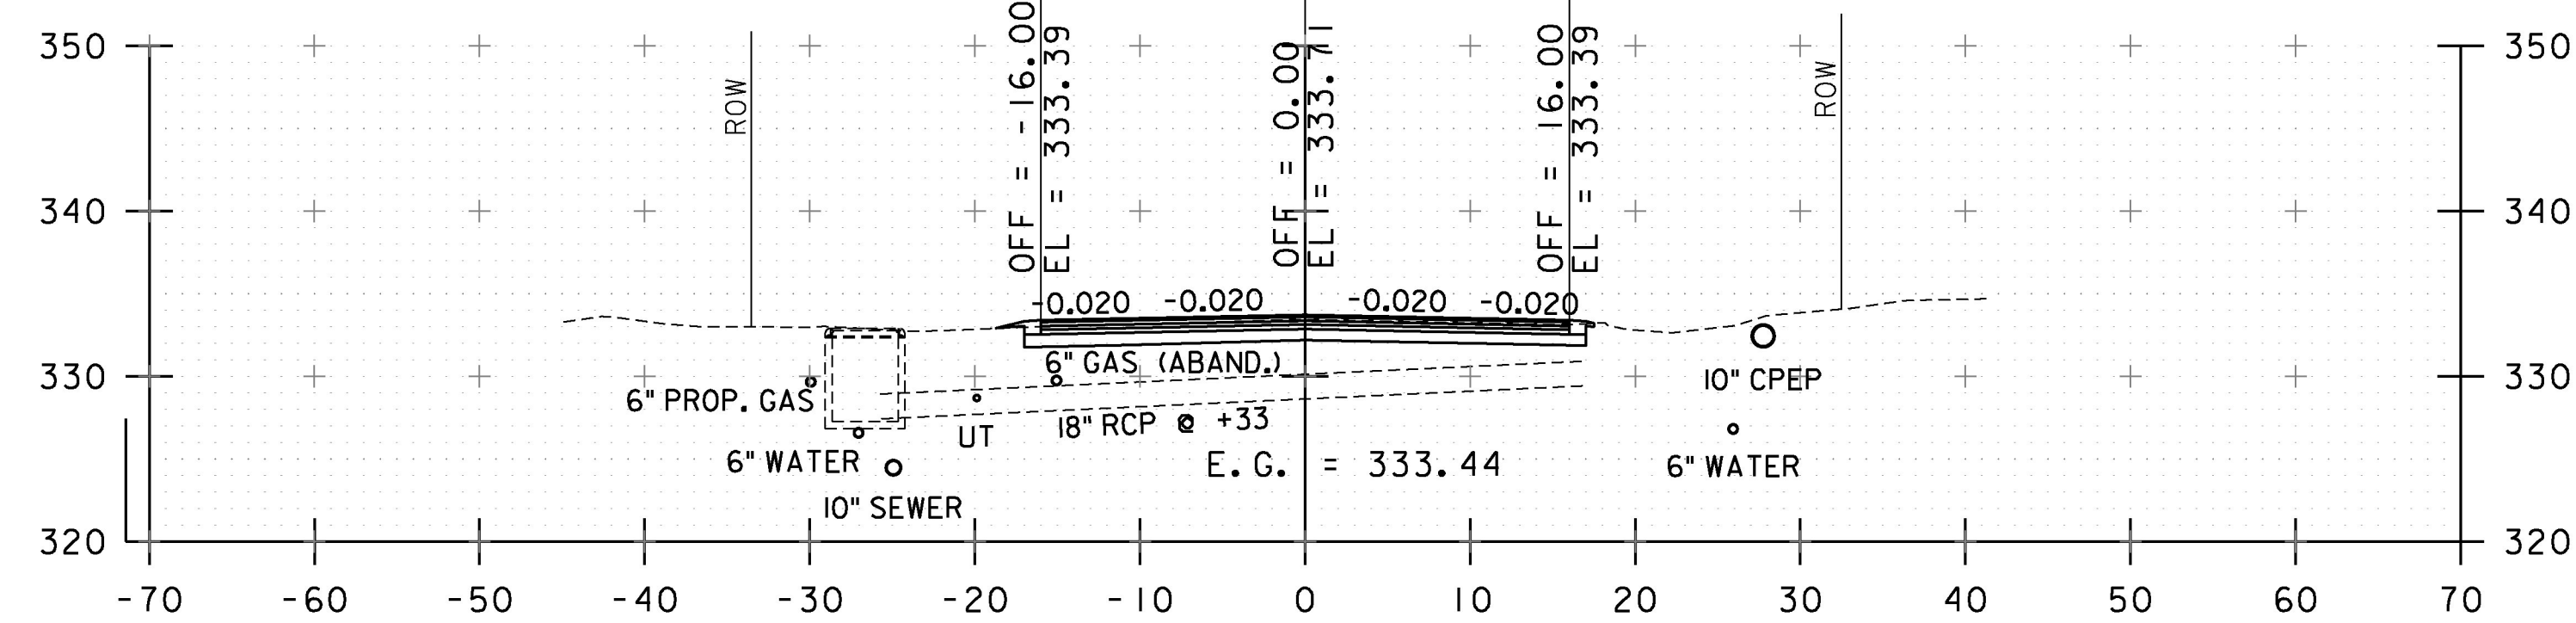

134+25

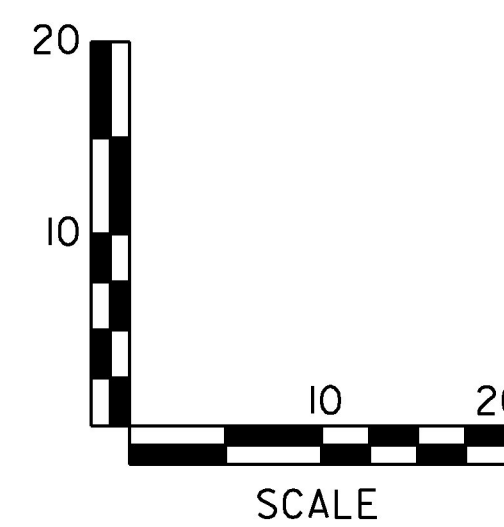

STA. 133+50 TO STA. 134+75

PROJECT NAME: SOUTH BURLINGTON-WILLISTON	
PROJECT NUMBER: NH 2944(I)	
FILE NAME: zild340xst.dgn	PLOT DATE: 2/15/2017
PROJECT LEADER: G. EDWARDS	DRAWN BY: I. MAYNARD
DESIGNED BY: I. MAYNARD	CHECKED BY: J. LITTLE
CROSS SECTION SHEET 9	SHEET 129 OF 249