




137+00

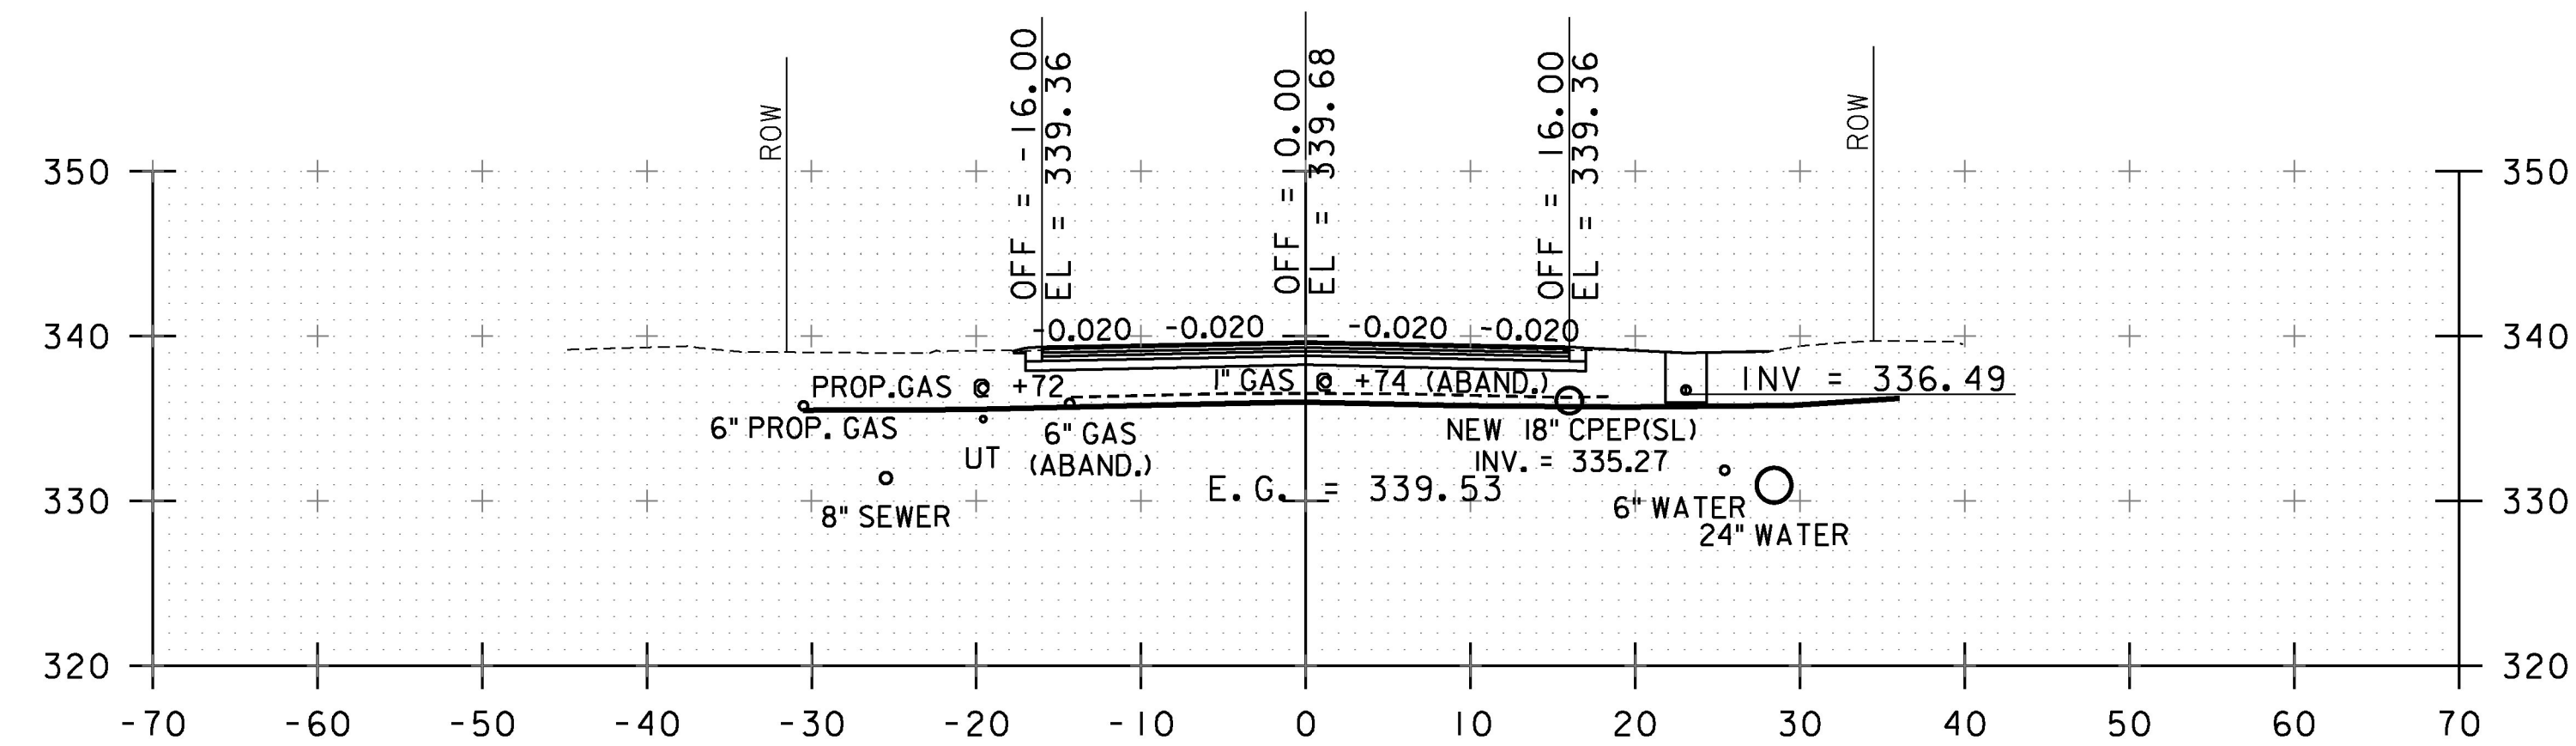


136+75

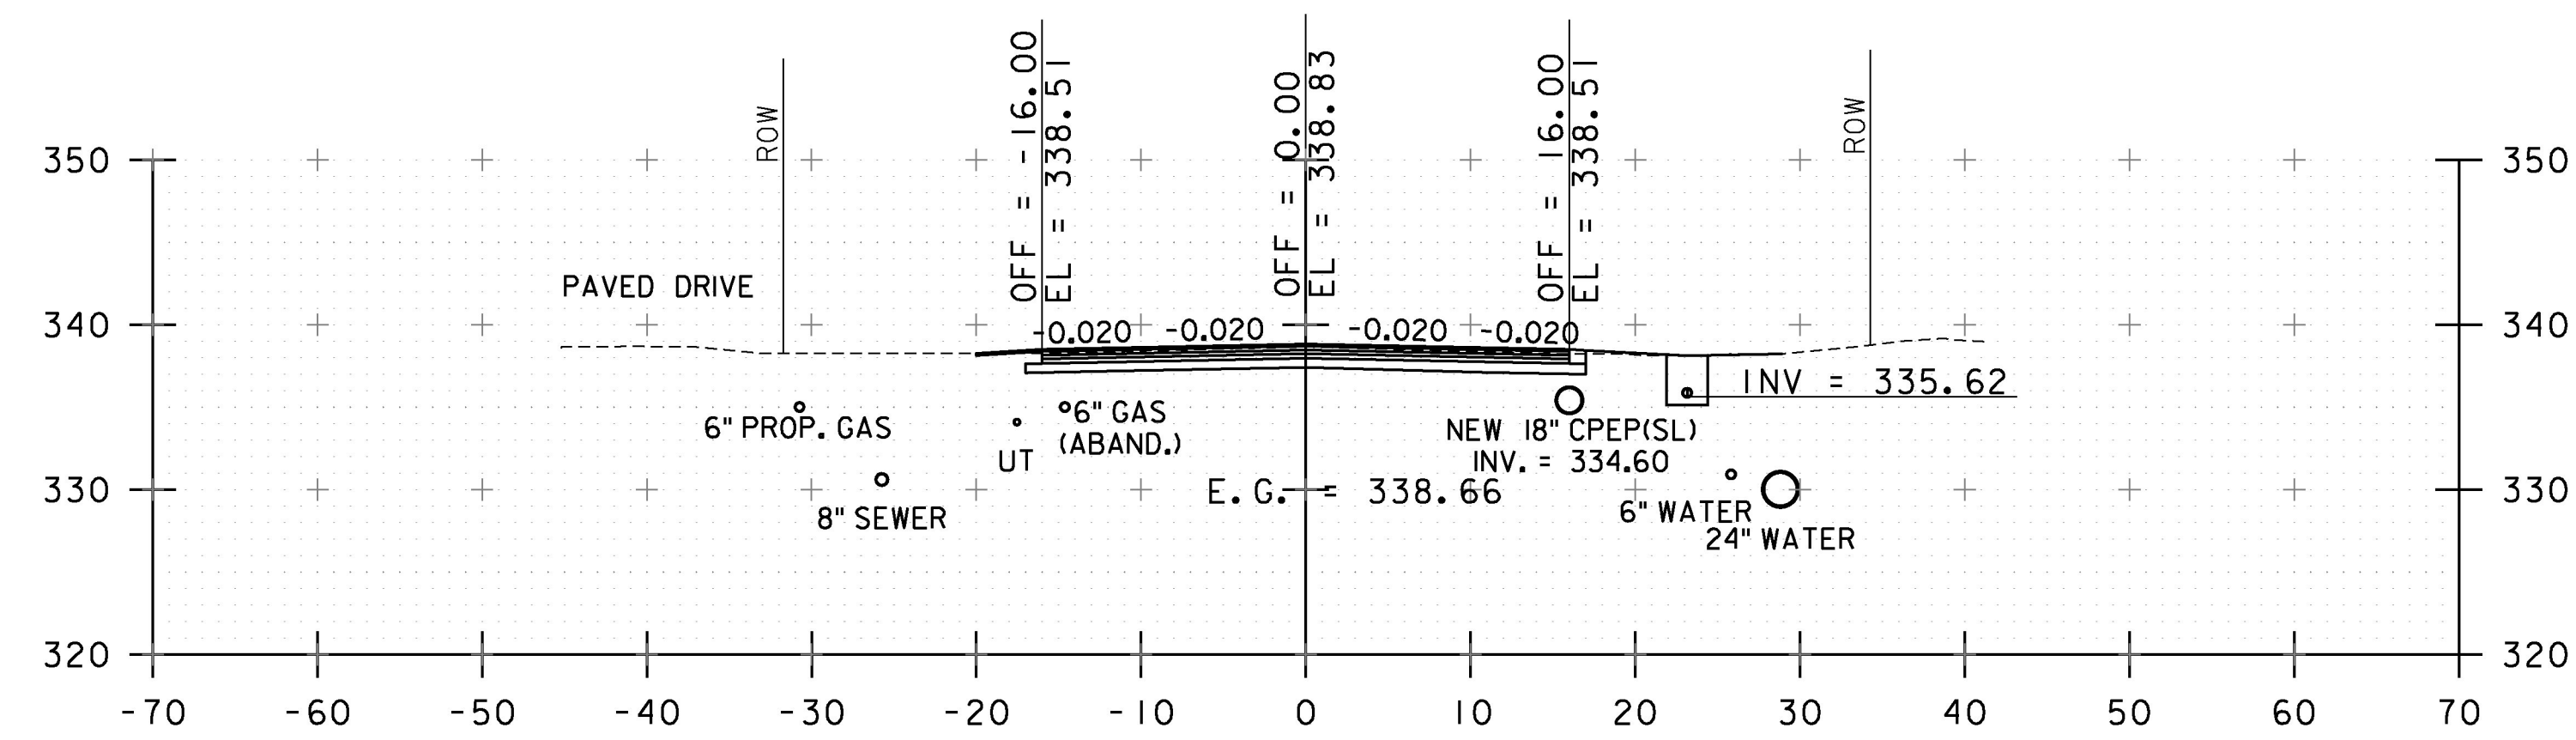


136+50

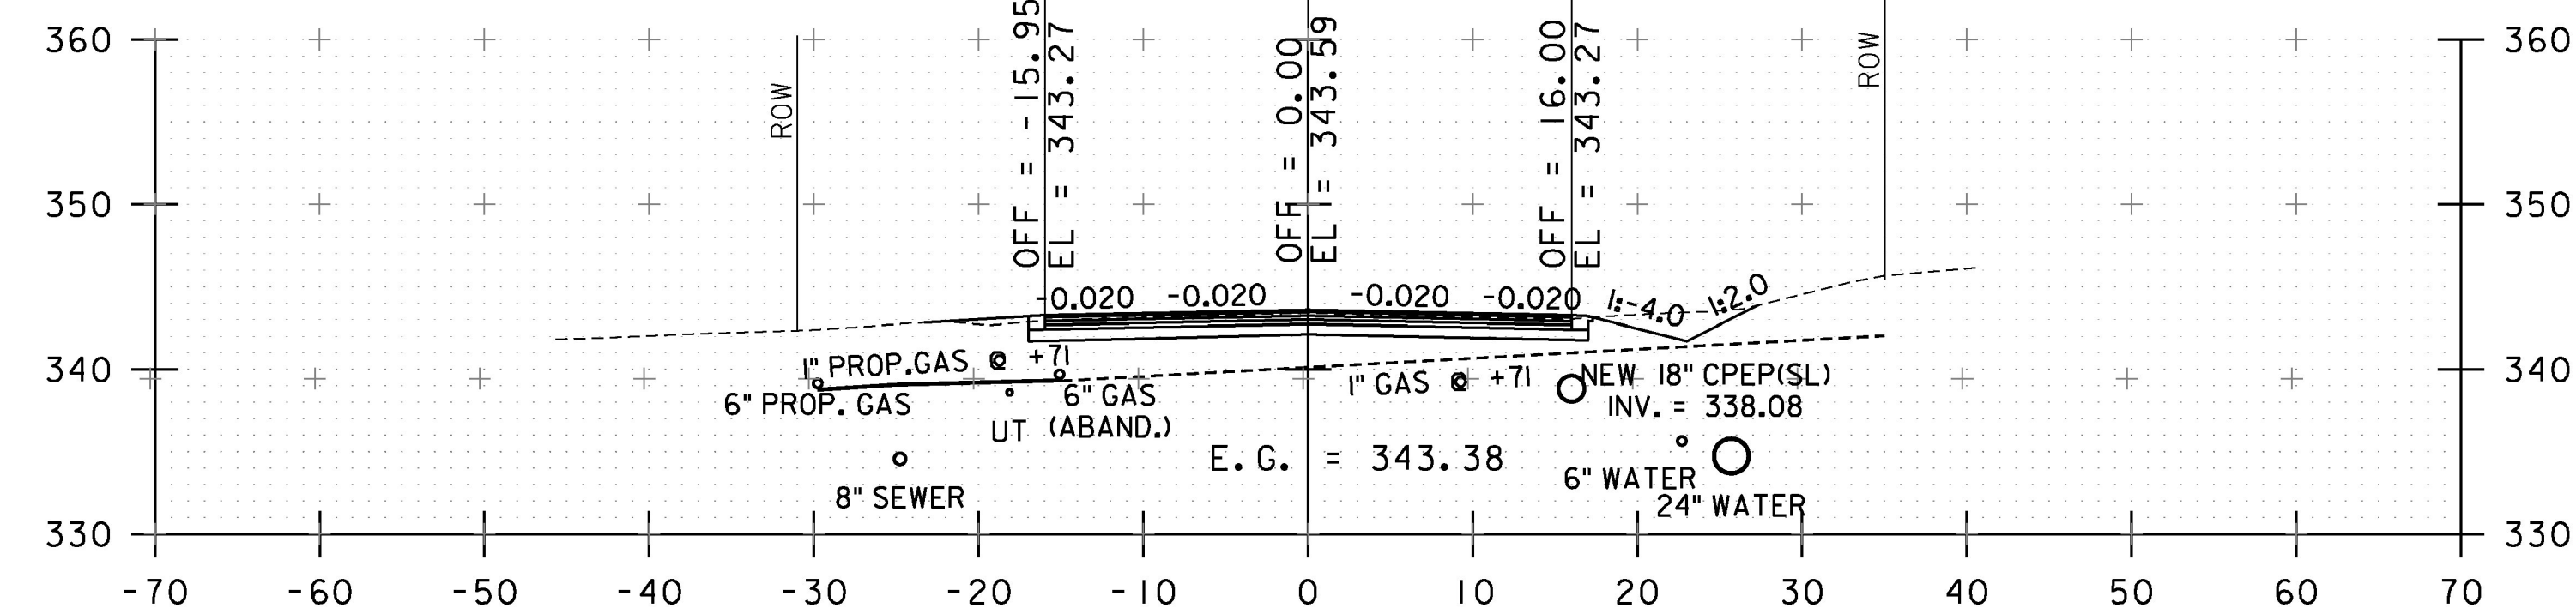


137+75

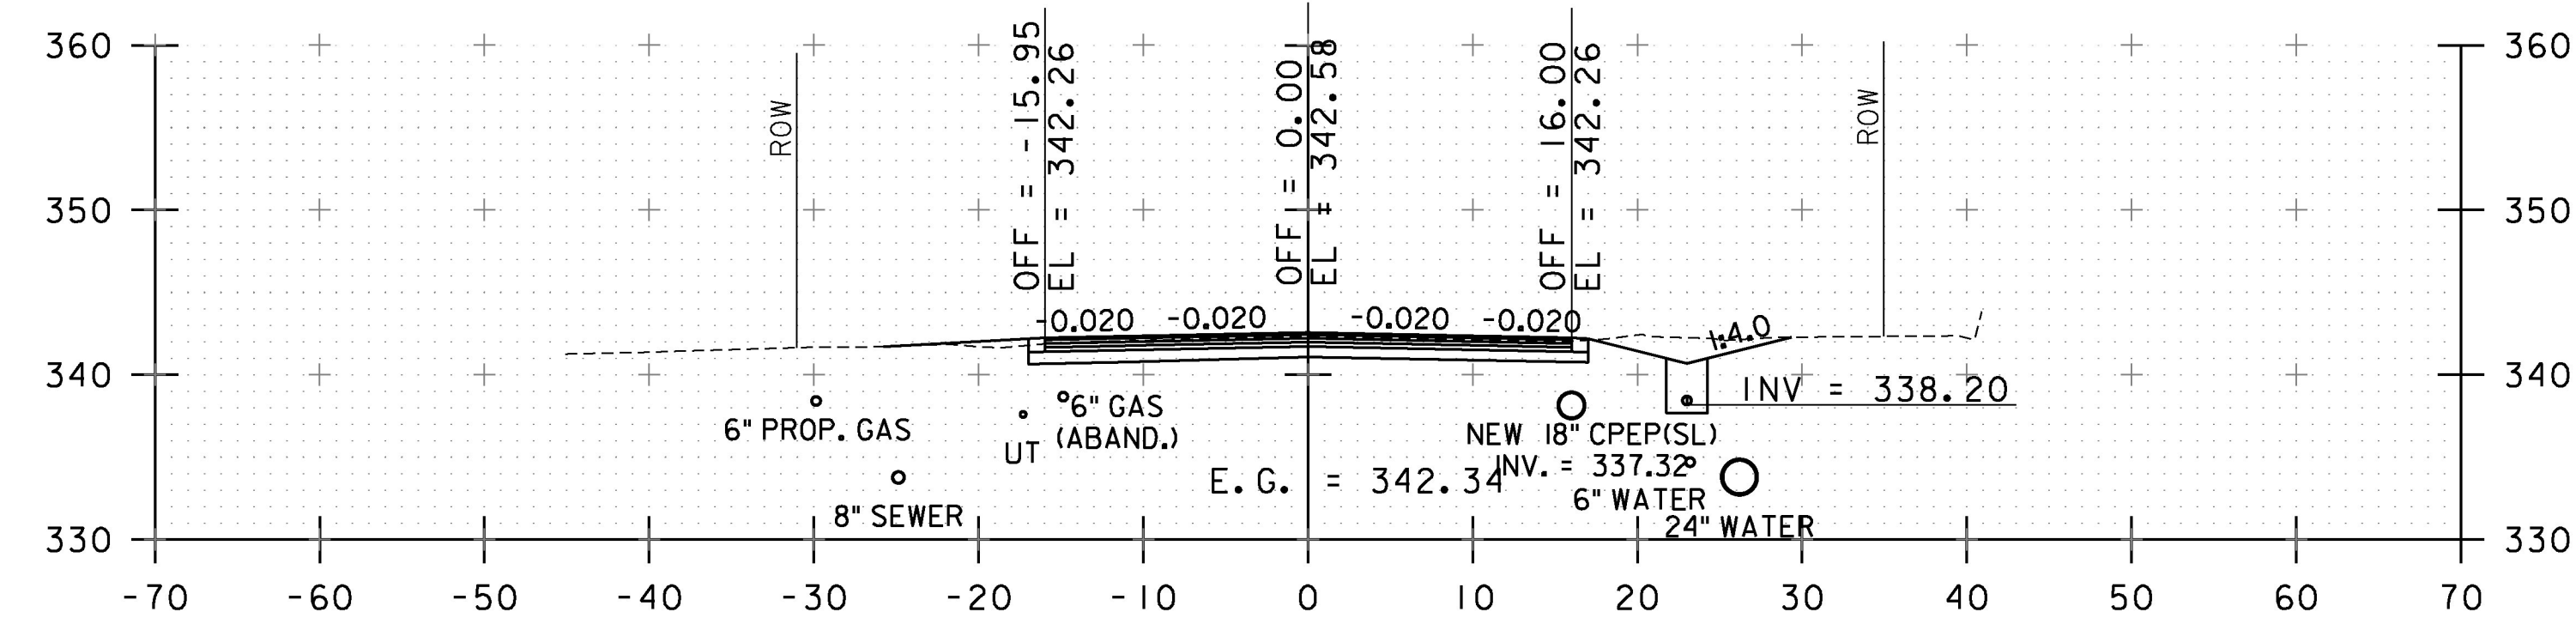

137+50

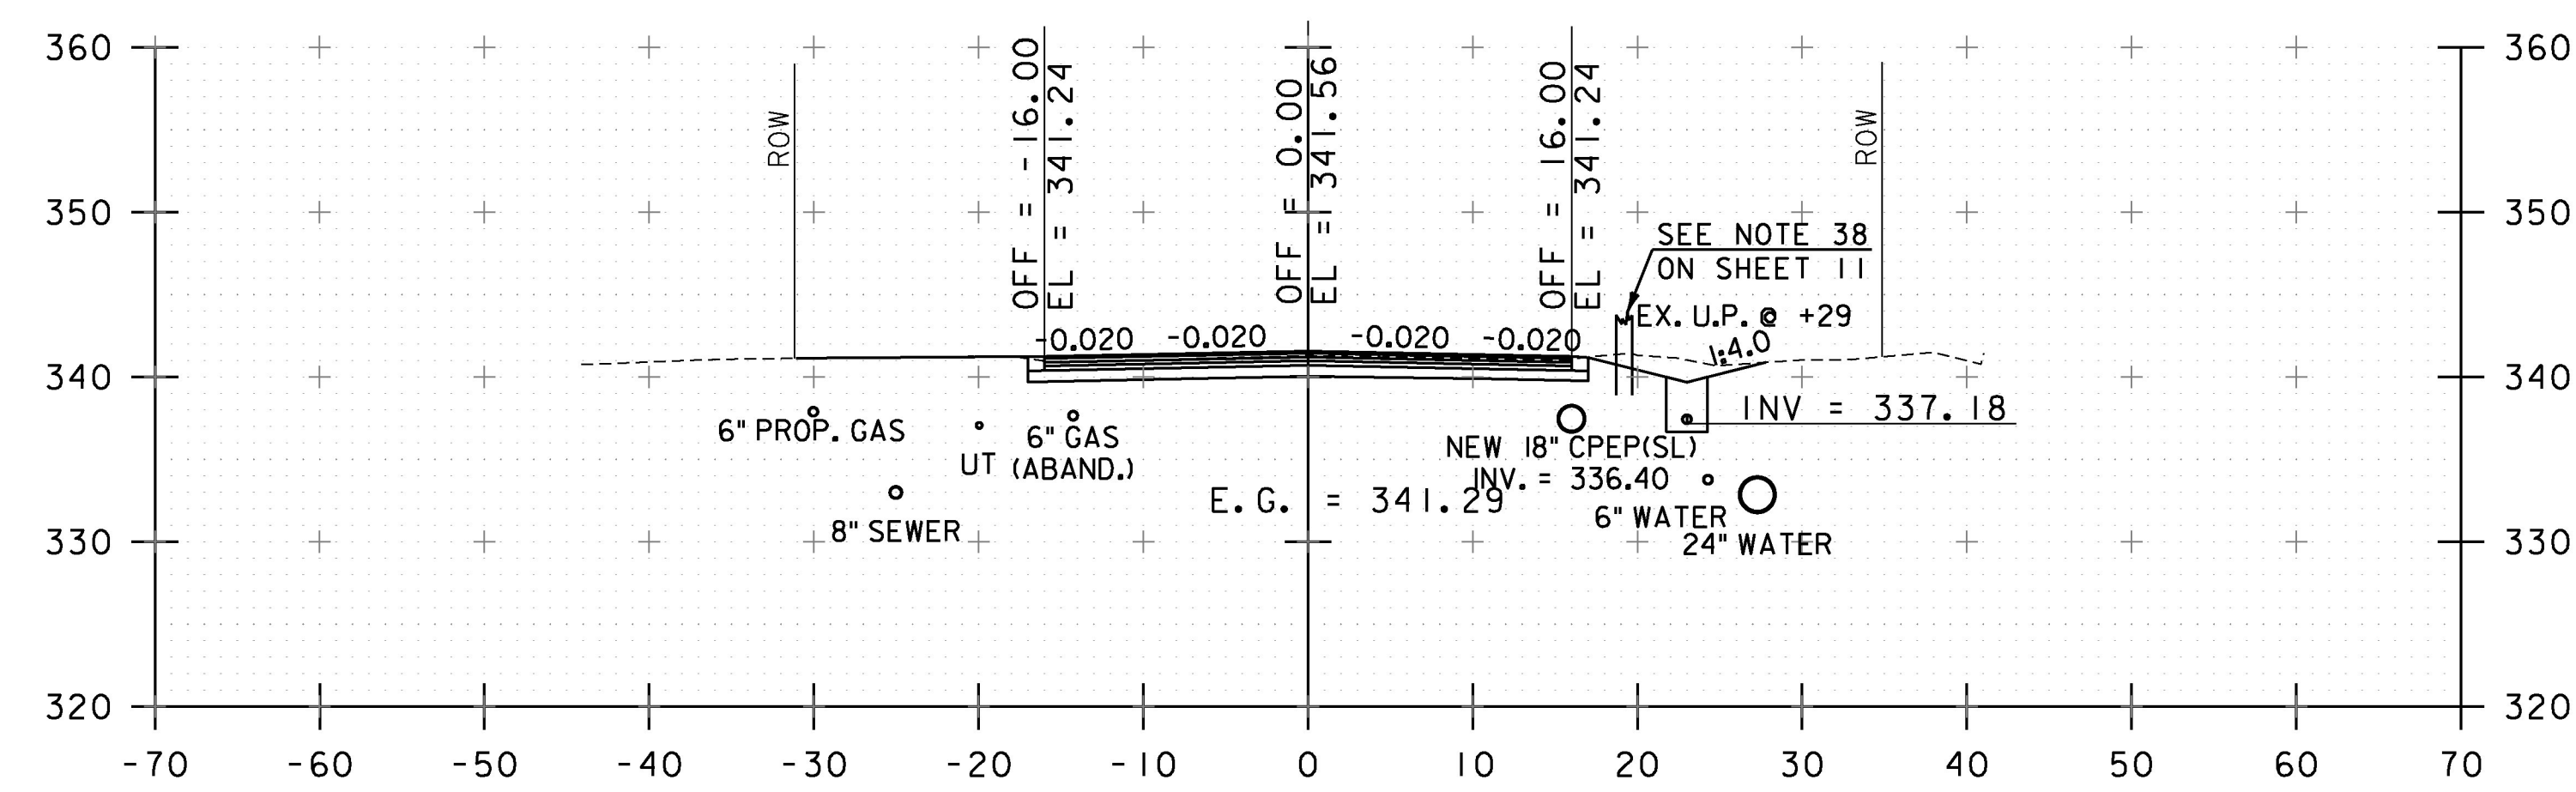

137+25

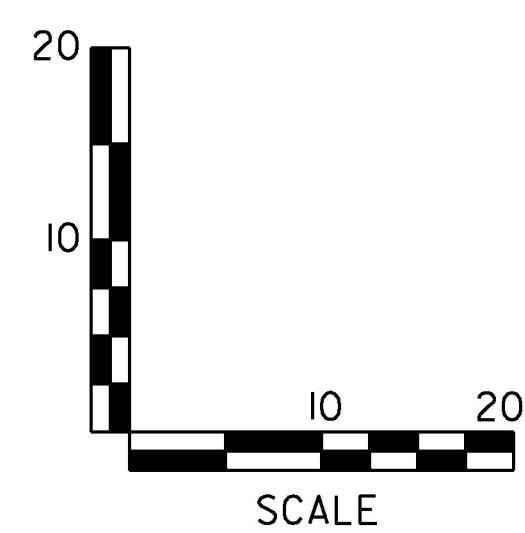

STA. 136+50 TO STA. 137+75

PROJECT NAME:	SOUTH BURLINGTON-WILLISTON
PROJECT NUMBER:	NH 2944(I)
FILE NAME:	z1ld340xsl.dgn
PROJECT LEADER:	G. EDWARDS
DESIGNED BY:	I. MAYNARD
CROSS SECTION SHEET #	II
PLOT DATE:	2/15/2017
DRAWN BY:	I. MAYNARD
CHECKED BY:	CROSS SECTION
SHEET	131 OF 249