




144+50

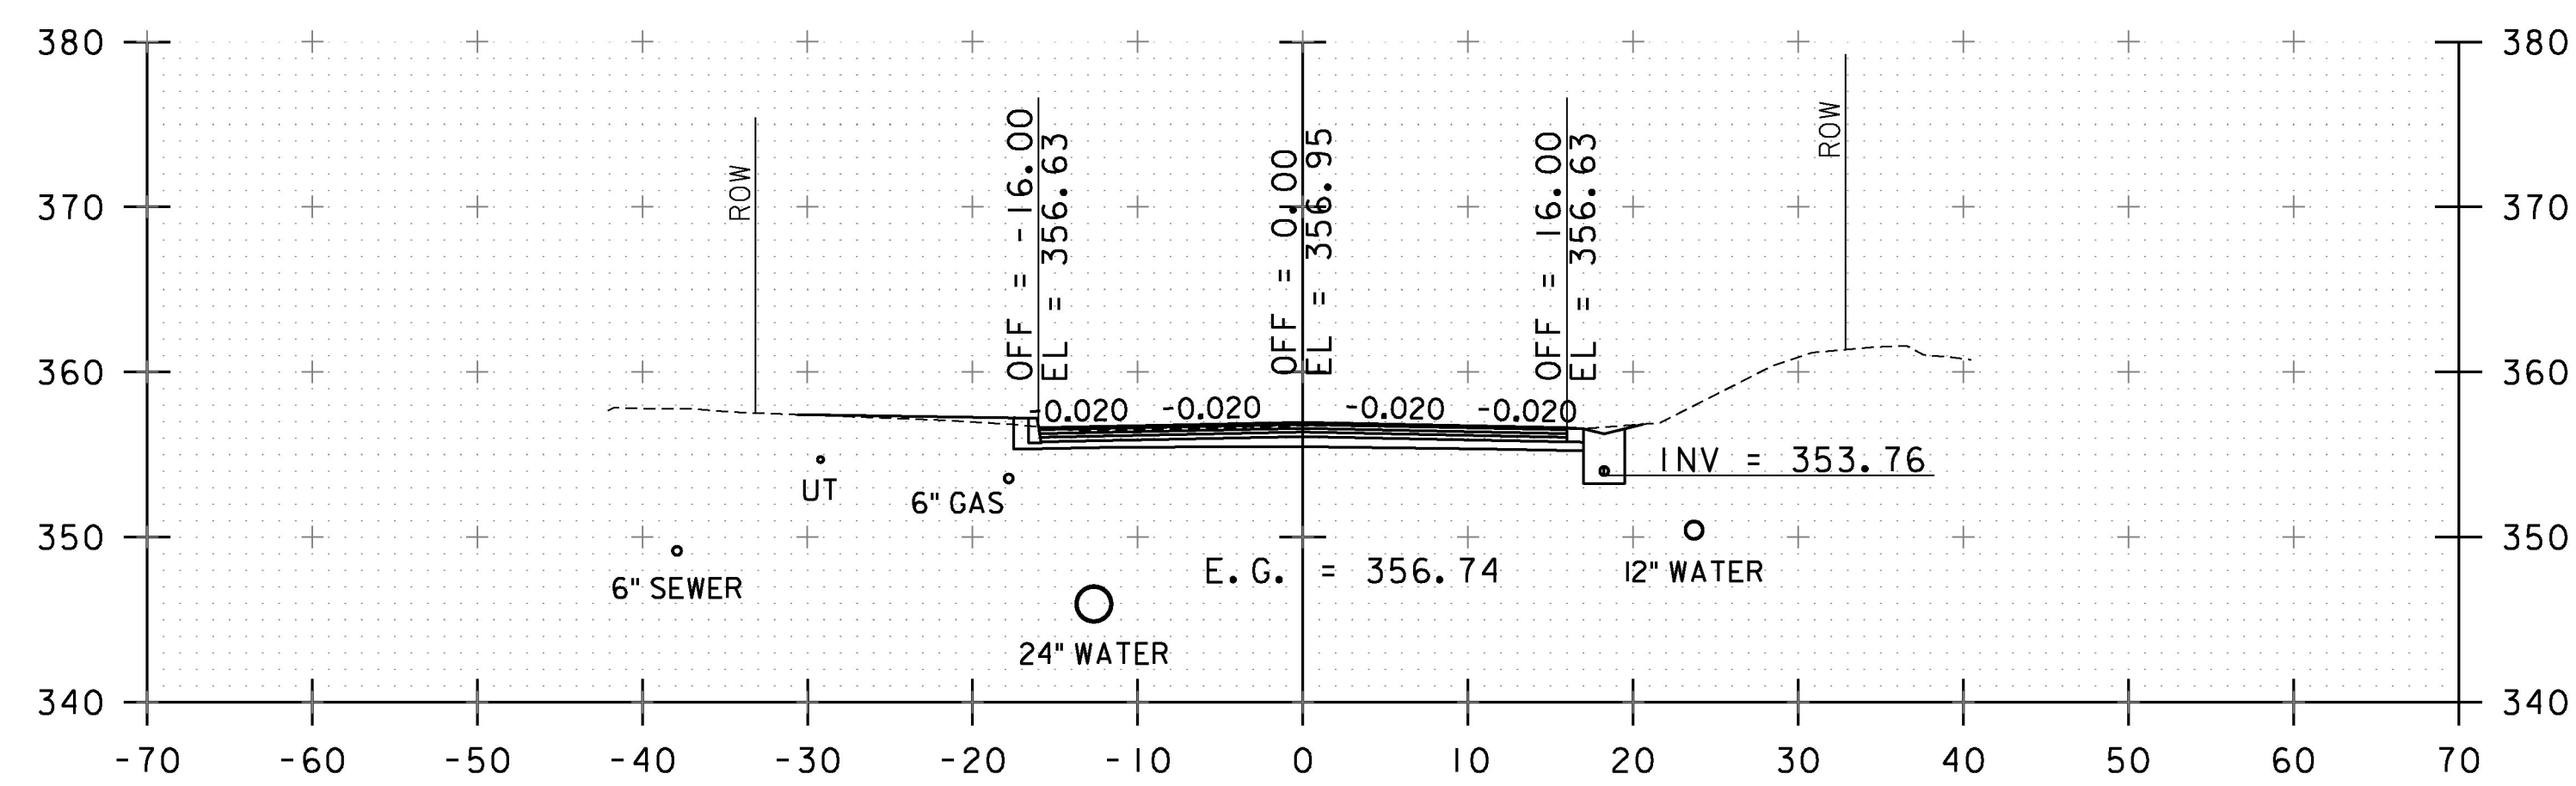


144+25

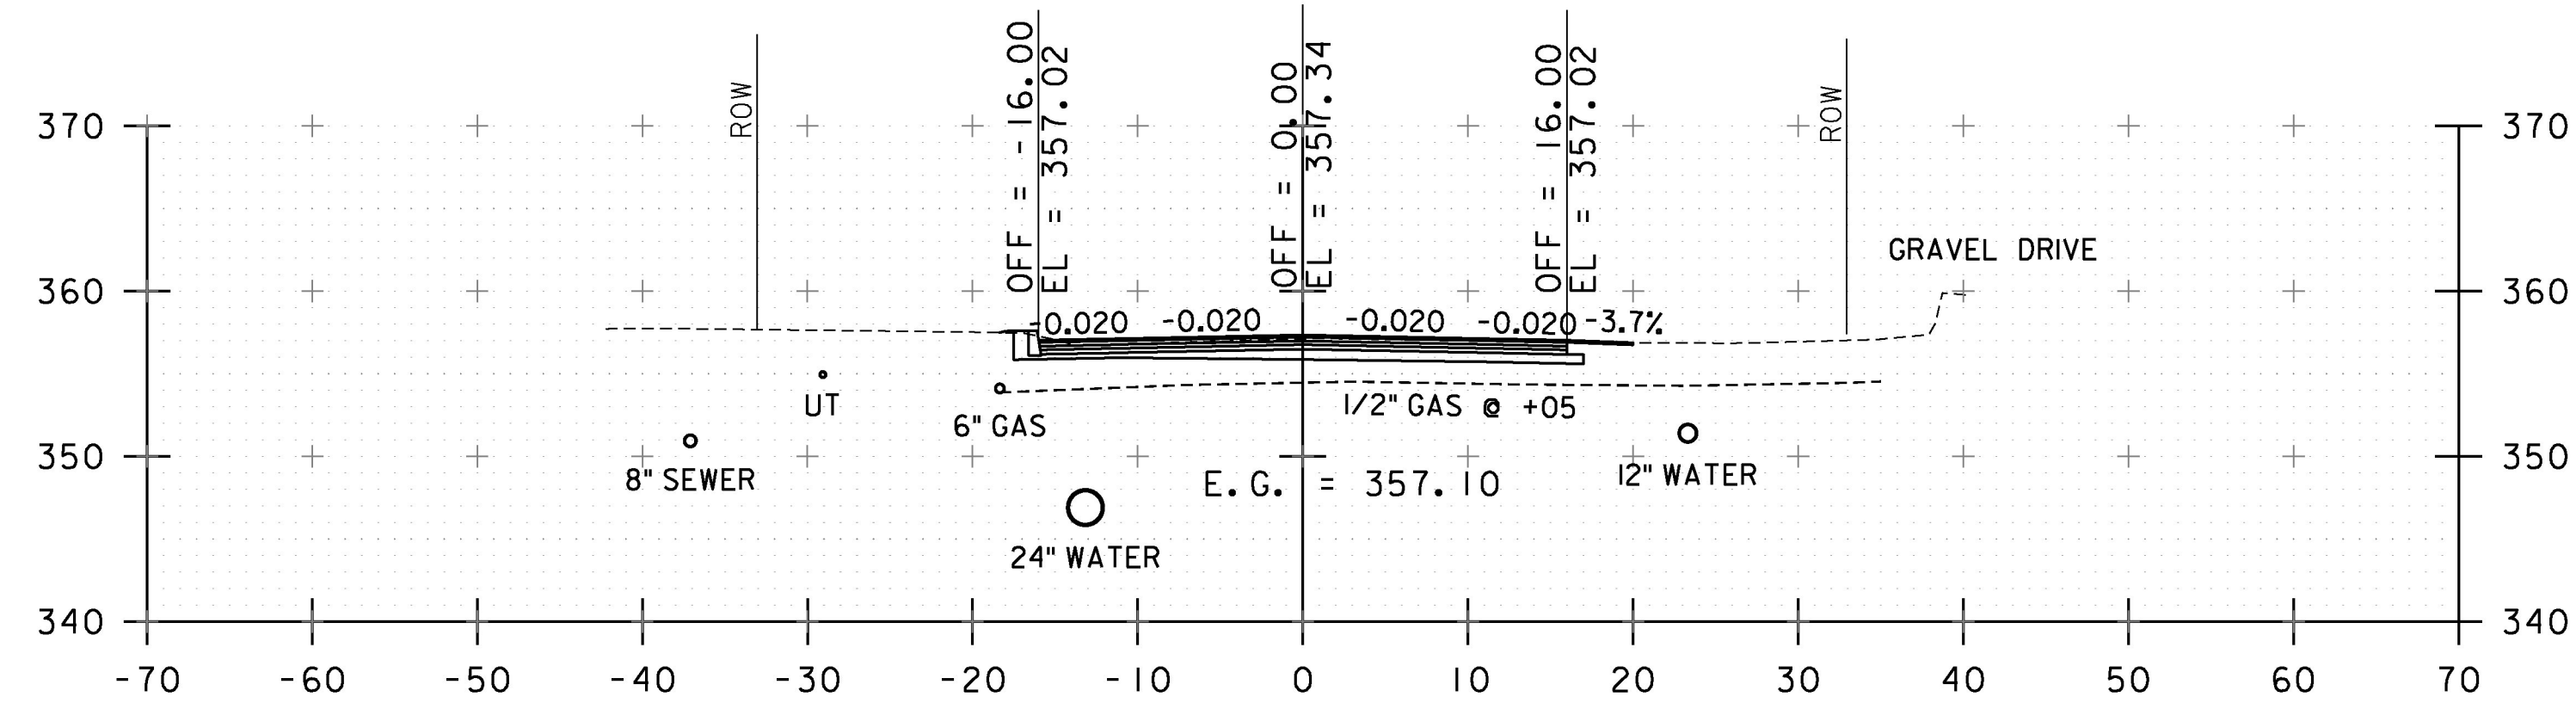


144+00

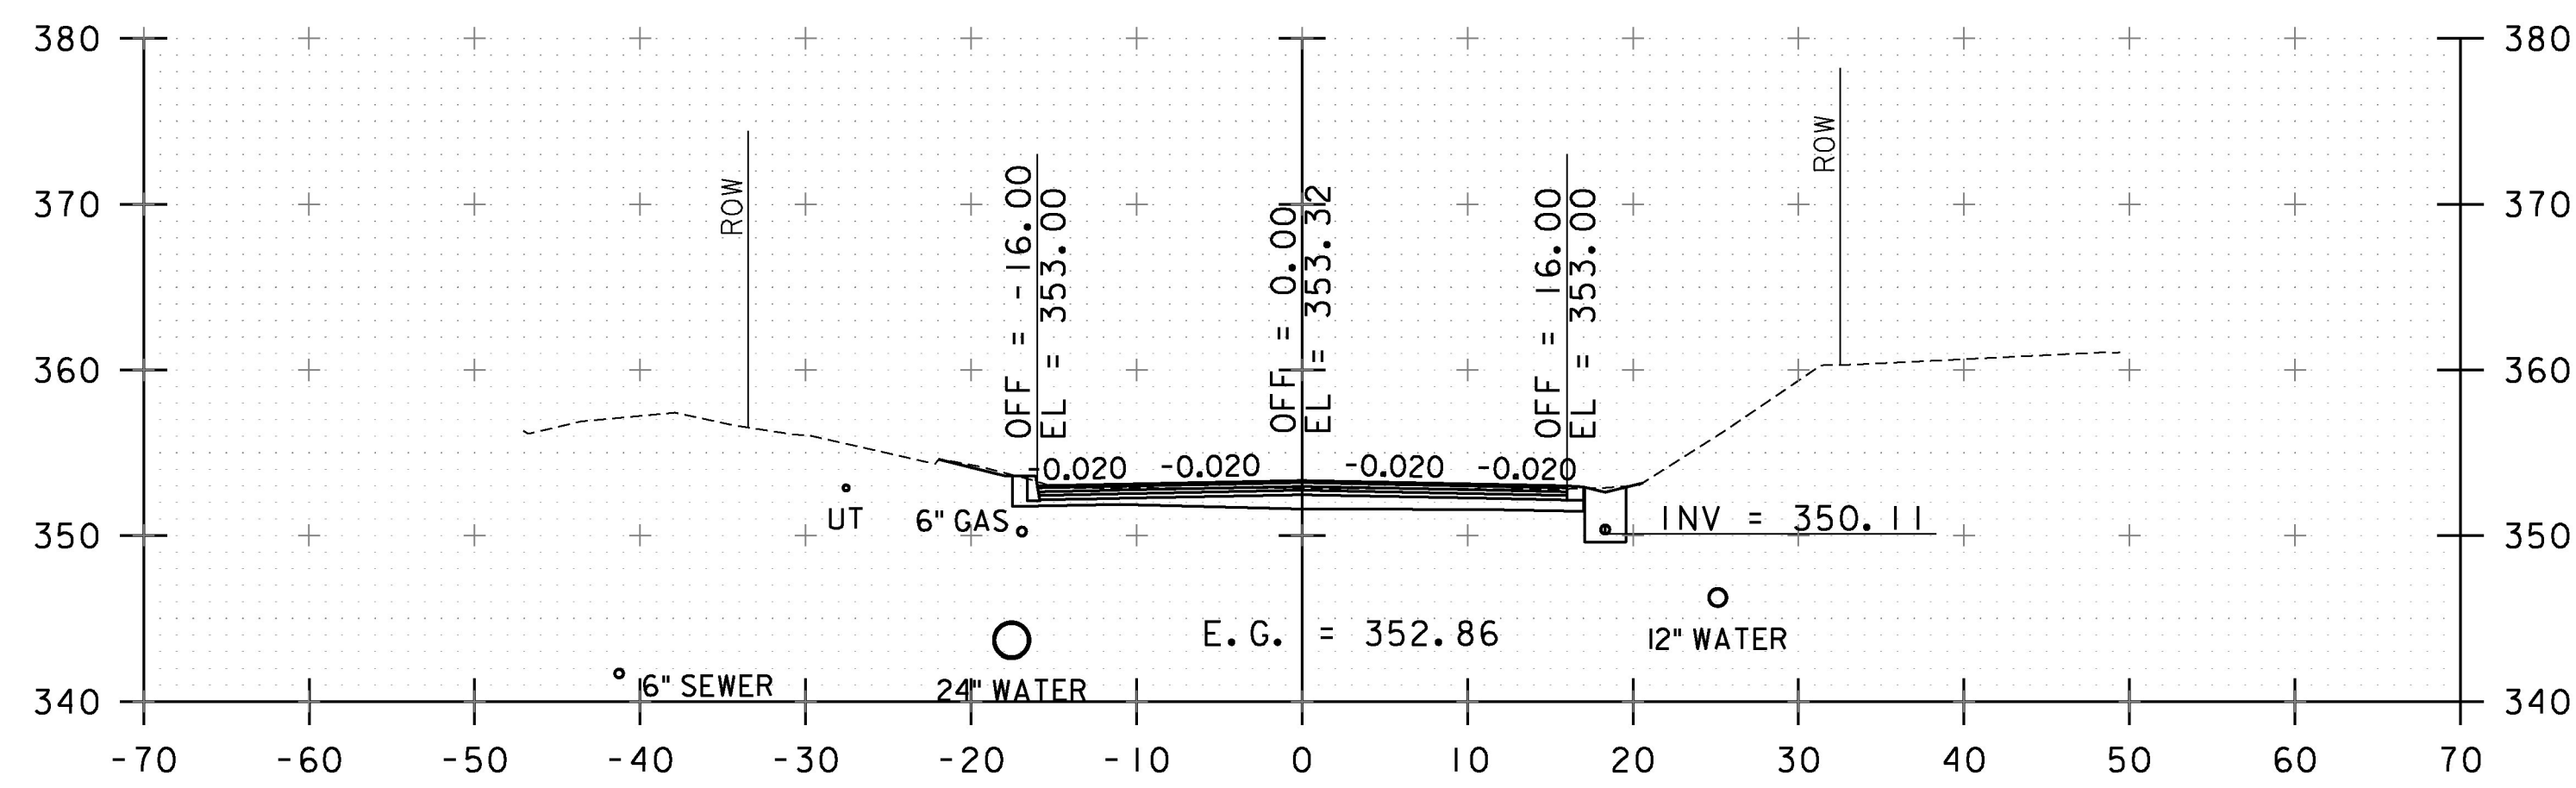


145+25

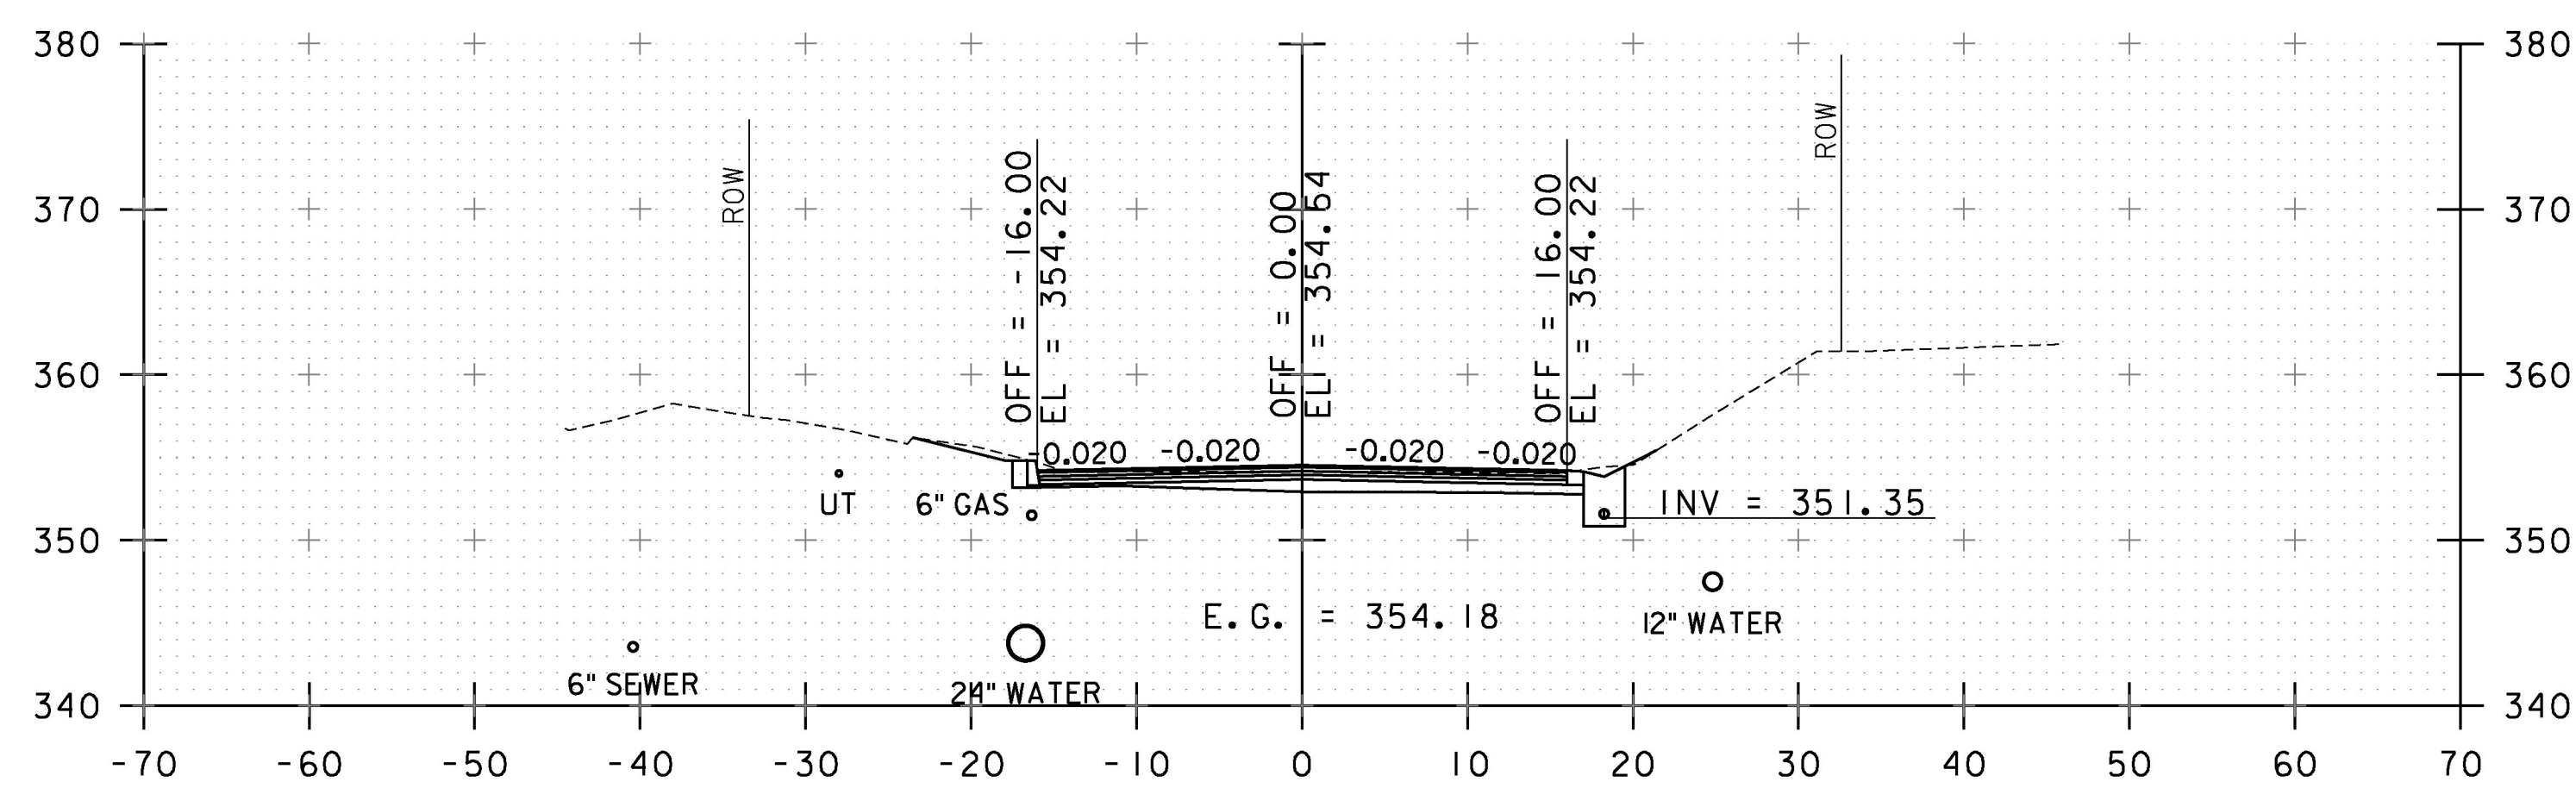

145+00

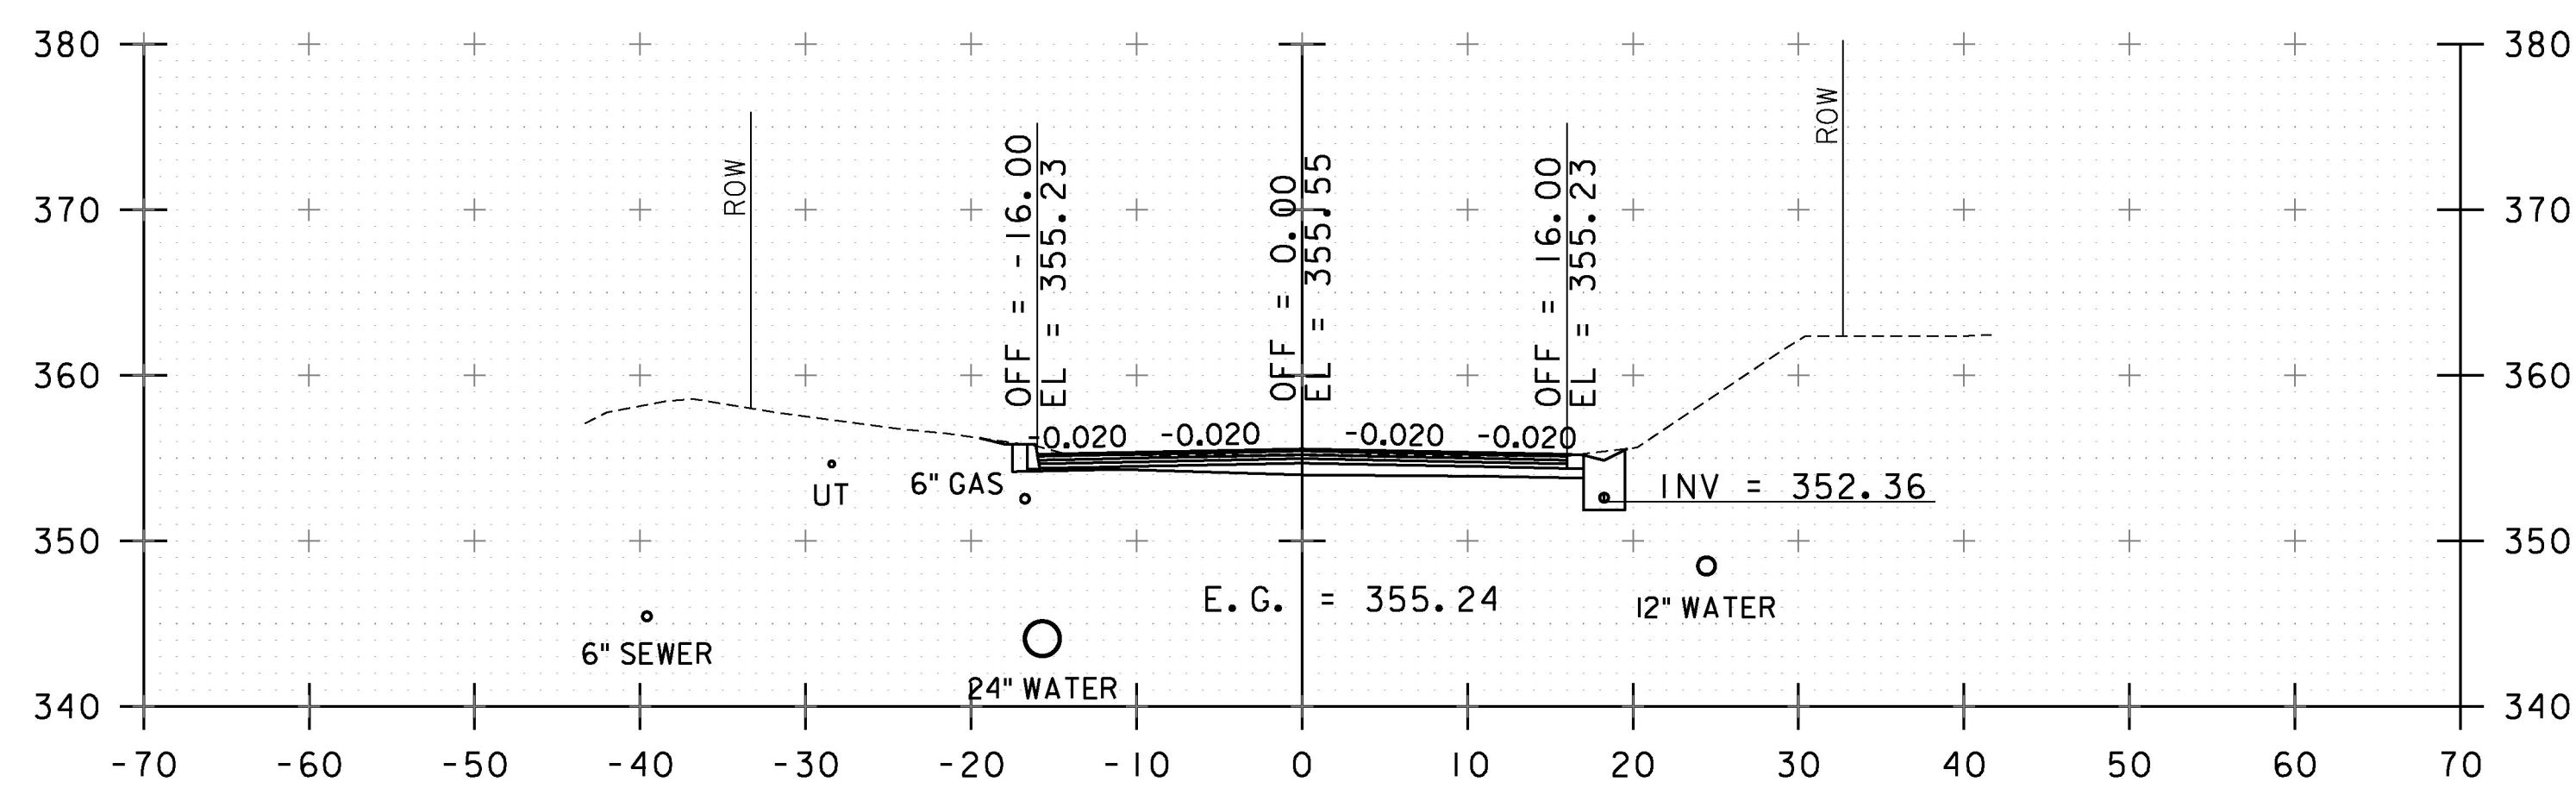

144+75

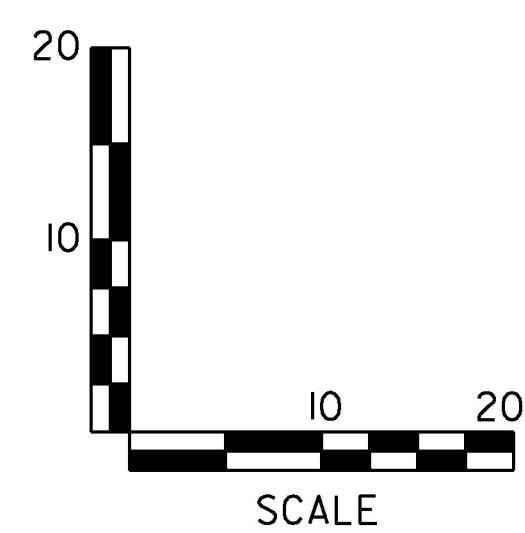

STA. 144+00 TO STA. 145+25

PROJECT NAME: SOUTH BURLINGTON-WILLISTON	PLOT DATE: 2/15/2017
PROJECT NUMBER: NH 2944(I)	DRAWN BY: I. MAYNARD
FILE NAME: zild340xsl.dgn	CHECKED BY: J. LITTLE
PROJECT LEADER: G. EDWARDS	SHEET 136 OF 249
DESIGNED BY: I. MAYNARD	
CROSS SECTION SHEET 16	