




146+00

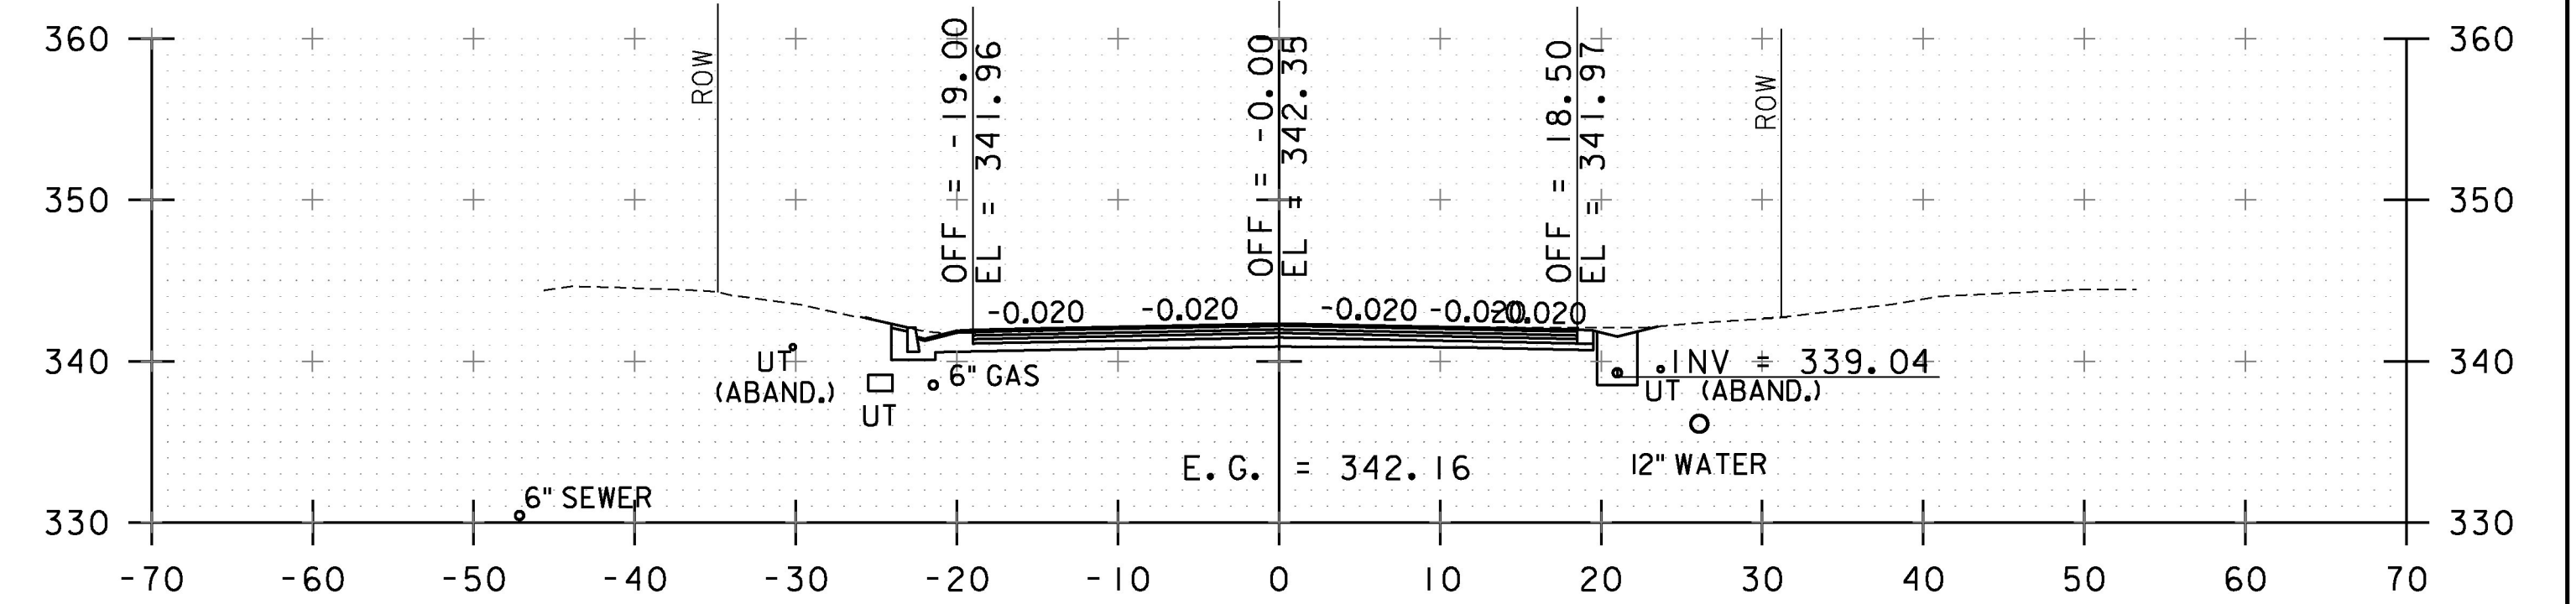


146+75

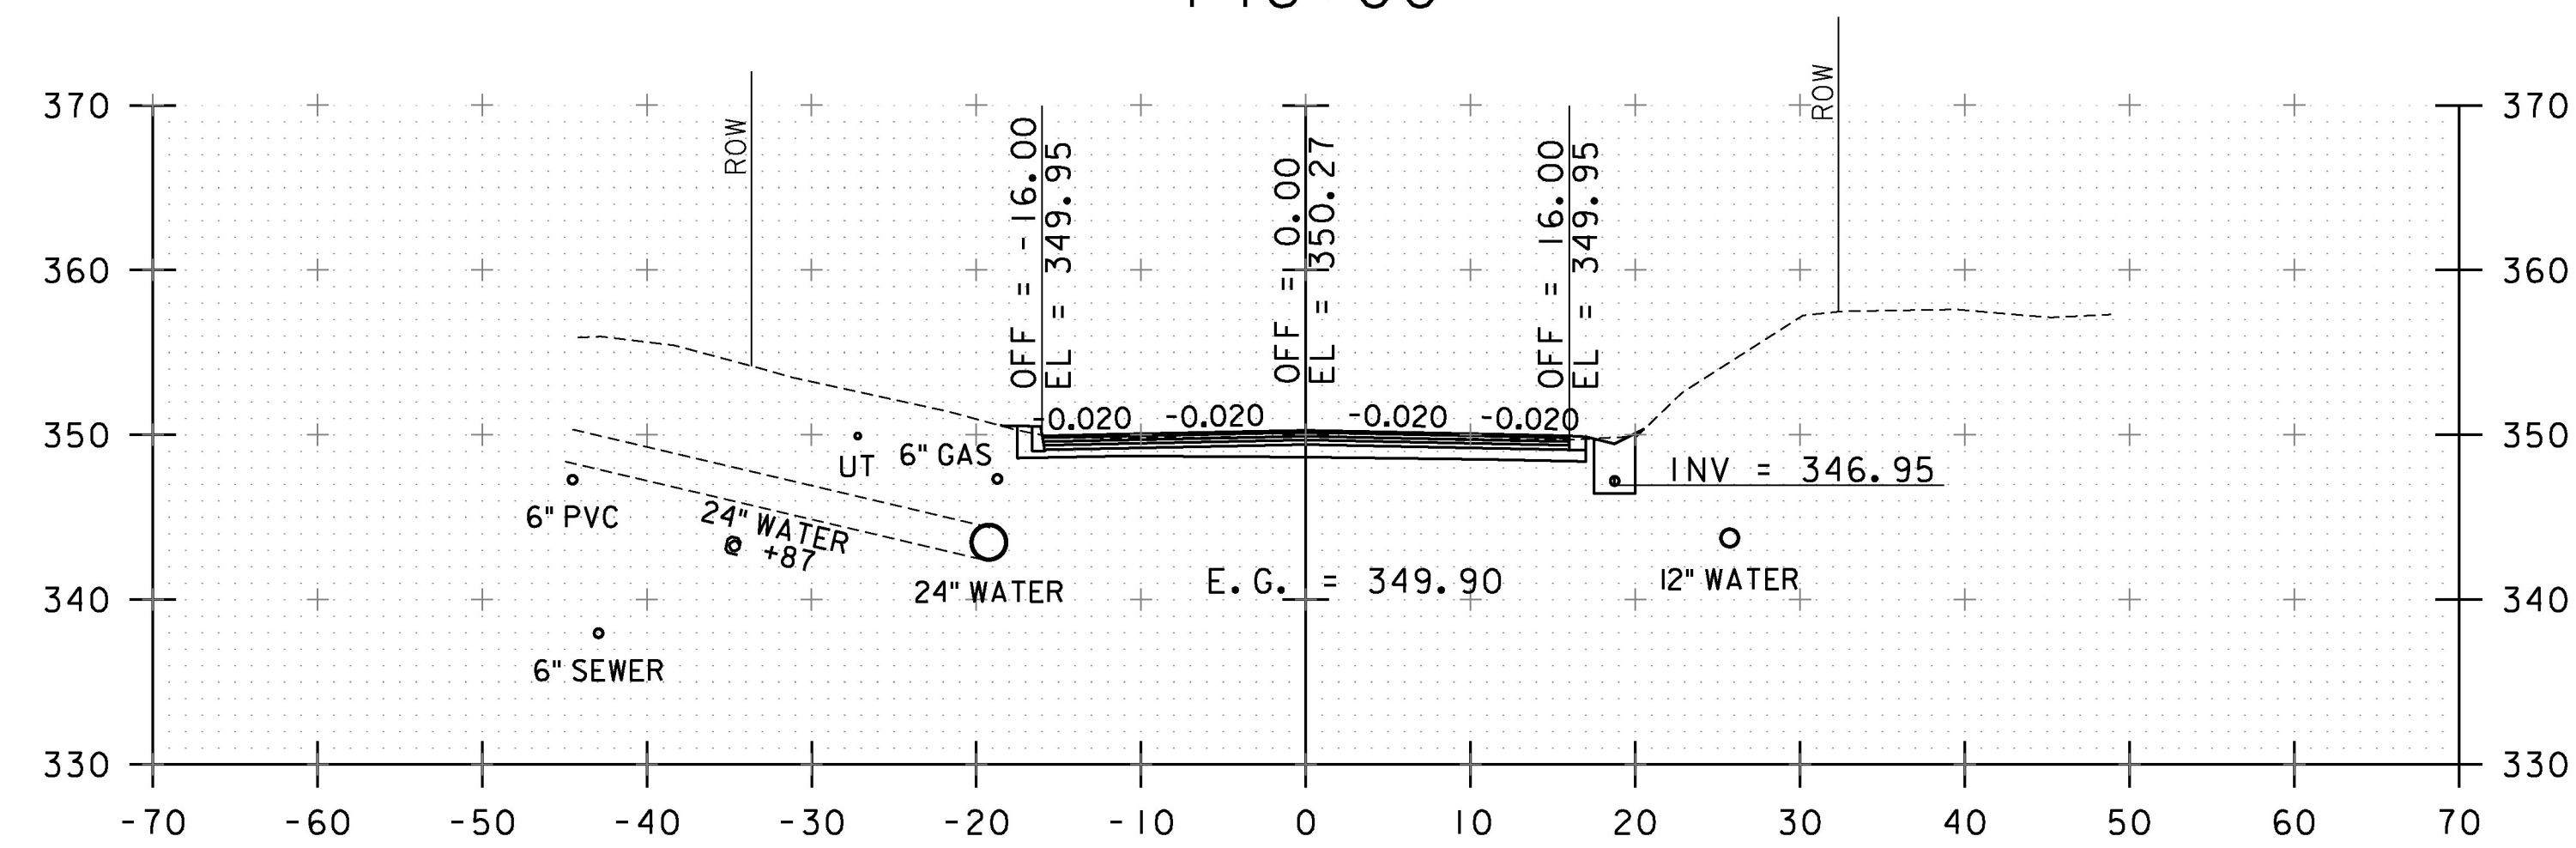


145+75

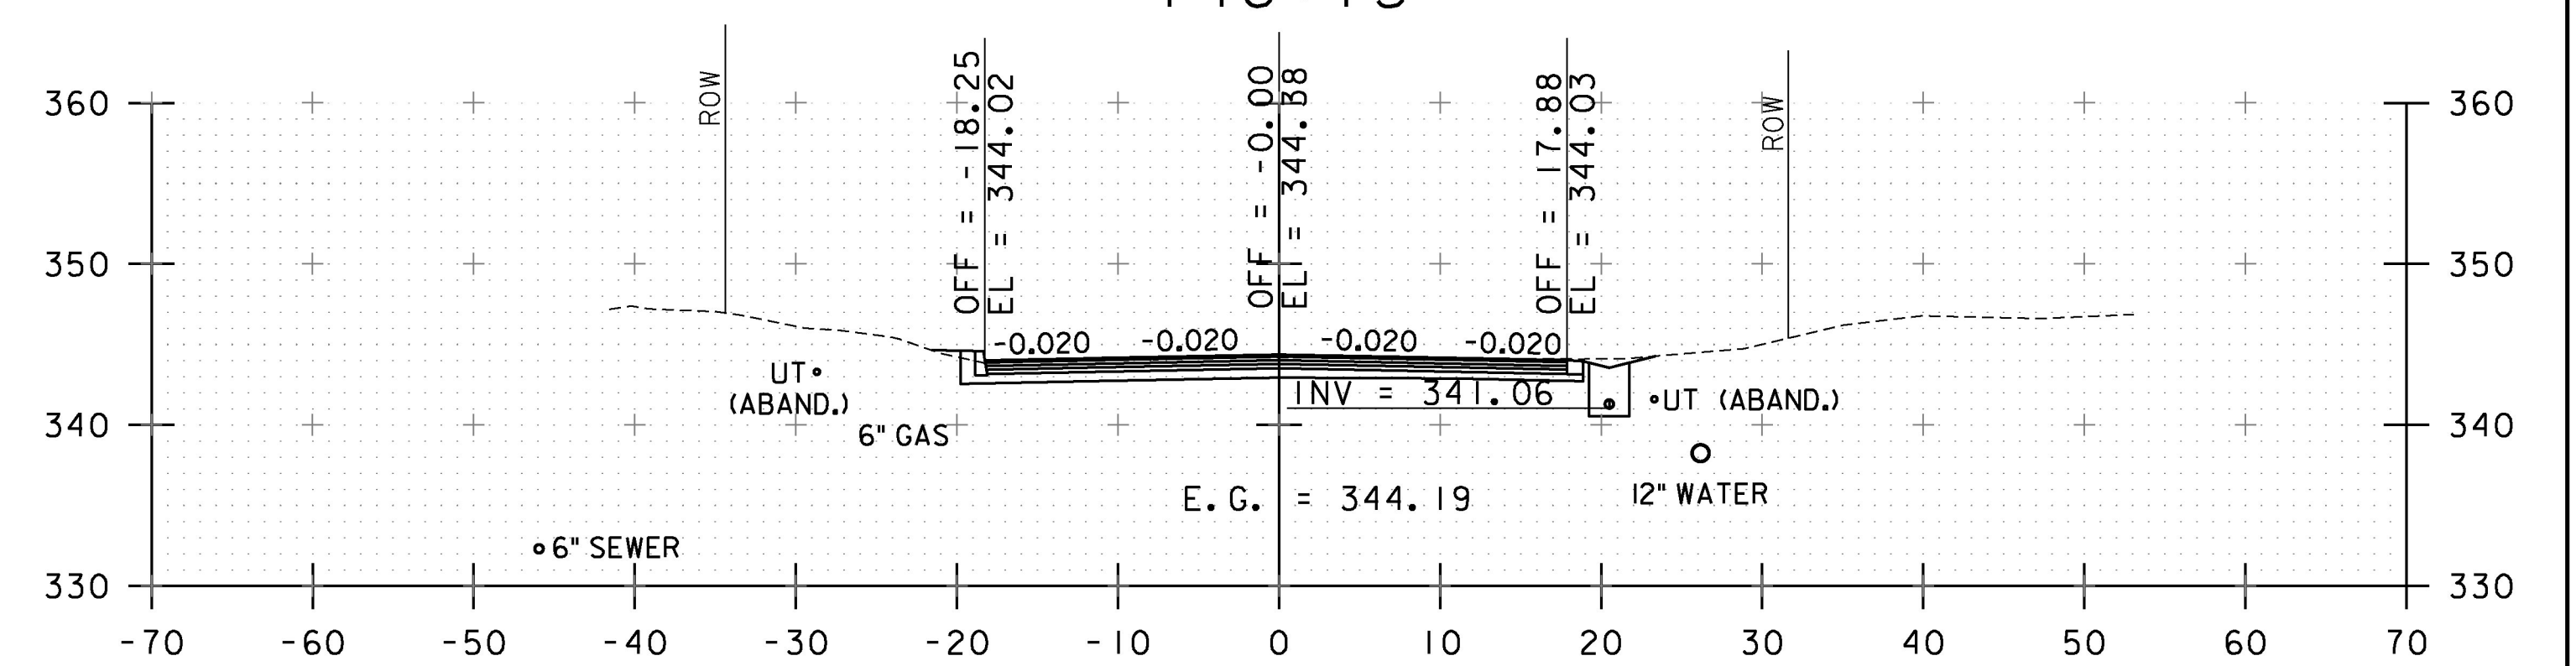


146+50

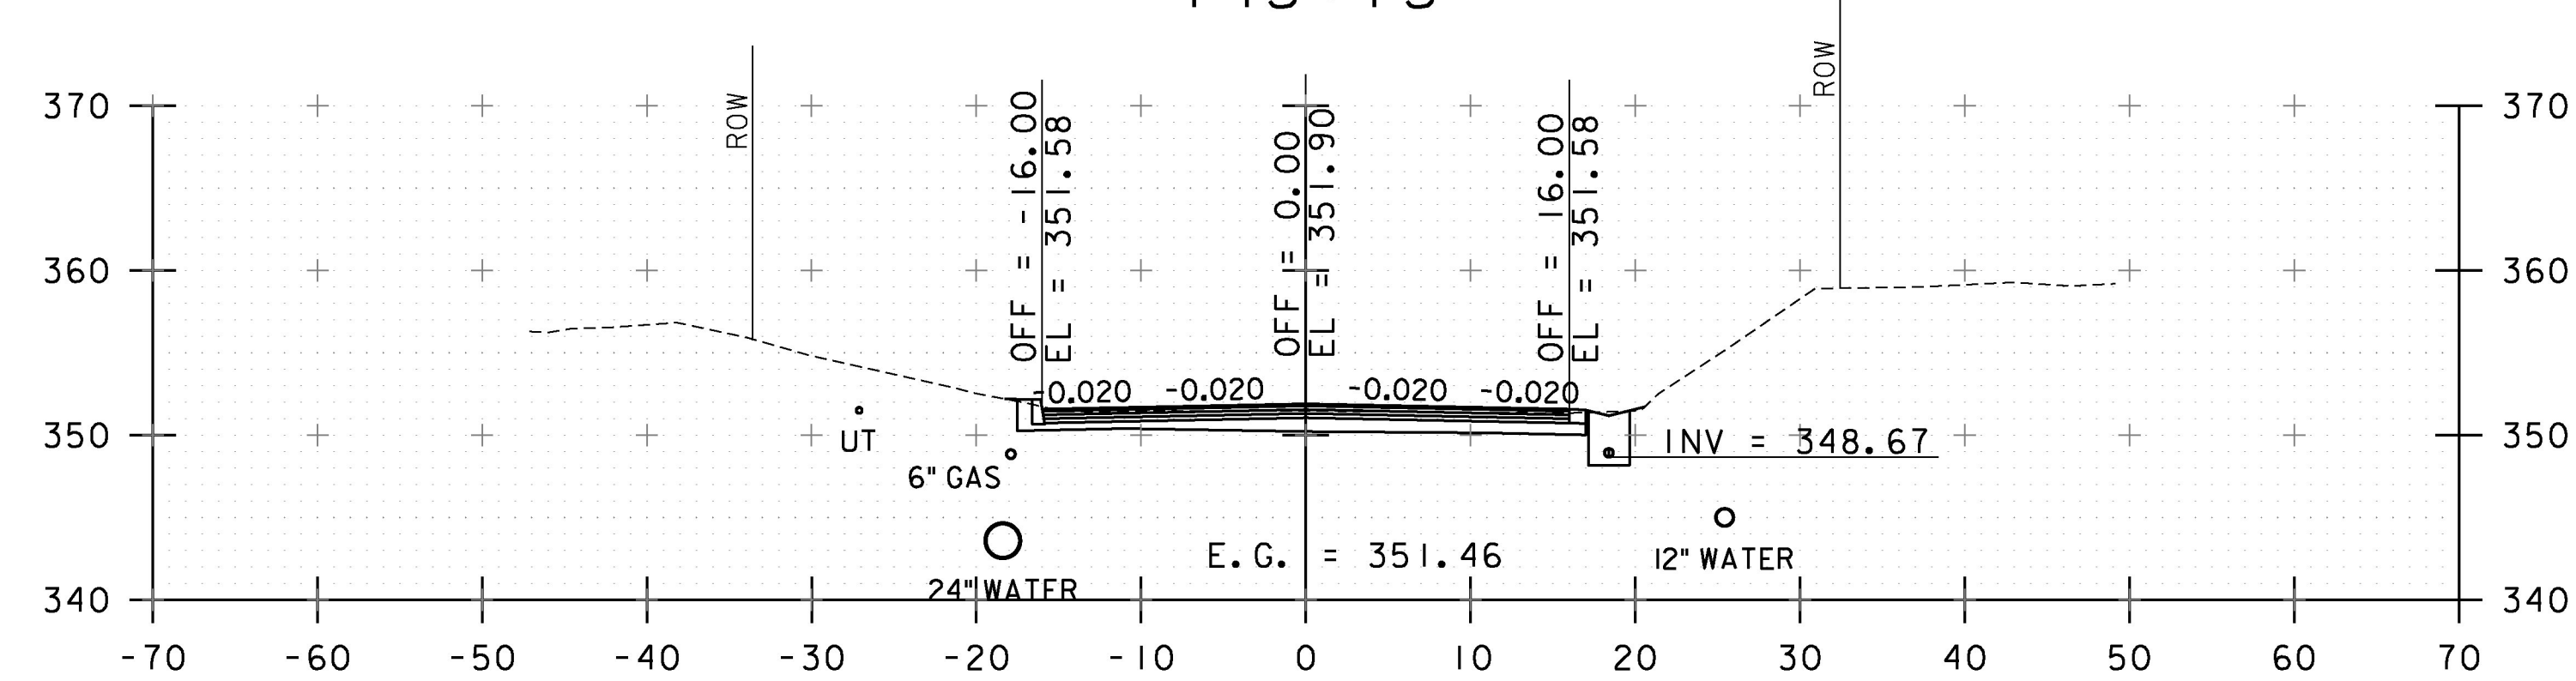

145+50

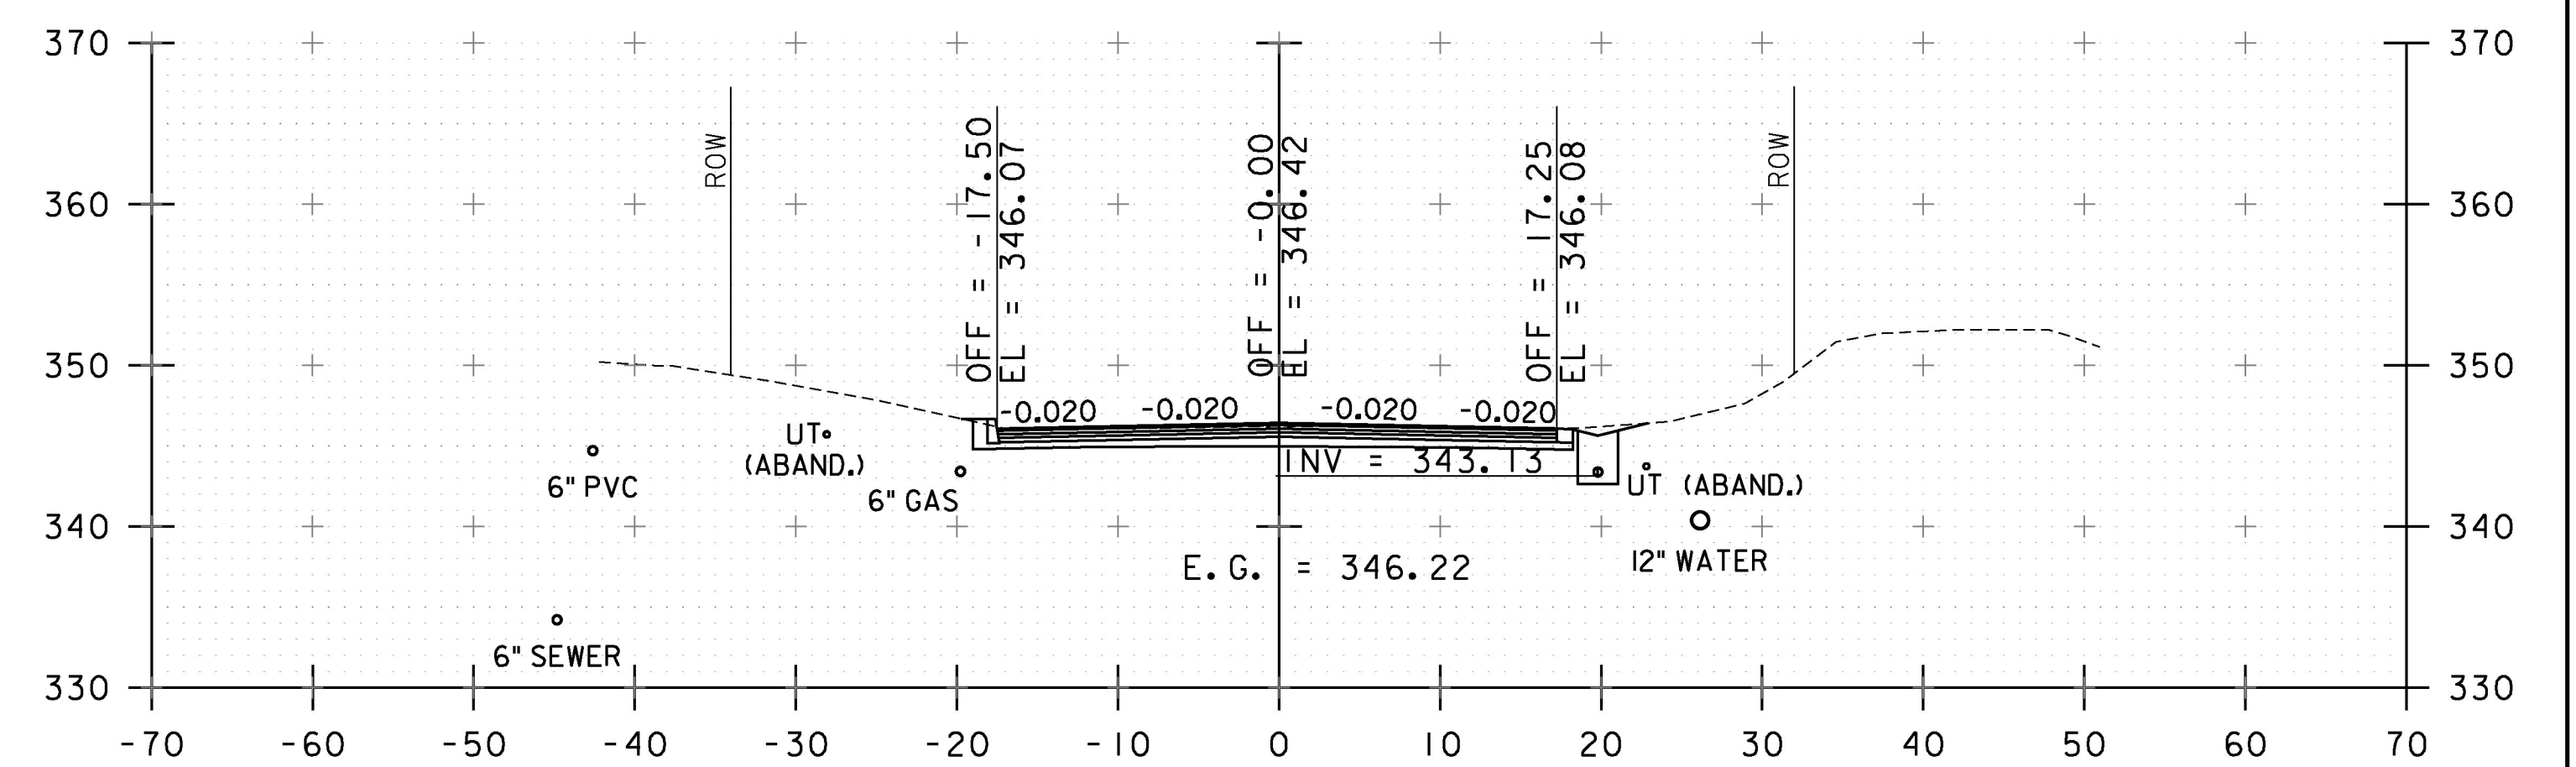

146+25

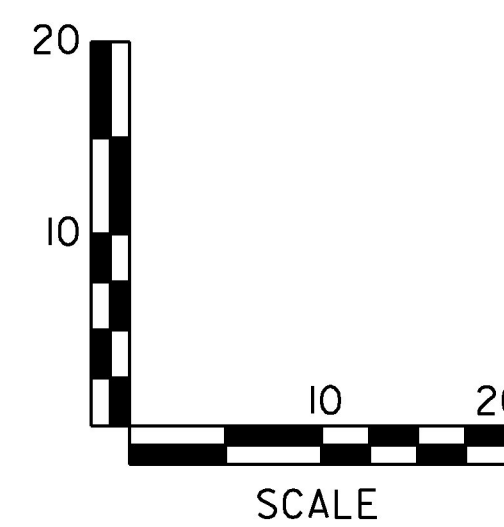

STA. 145+50 TO STA. 146+75

PROJECT NAME:	SOUTH BURLINGTON-WILLISTON
PROJECT NUMBER:	NH 2944(I)
FILE NAME:	z1d340xsl.dgn
PROJECT LEADER:	G. EDWARDS
DESIGNED BY:	CROSS SECTION SHEET 18
CROSS SECTION SHEET 17	CHECKED BY: J. LITTLE
	PLOT DATE: 2/15/2017
	DRAWN BY: I. MAYNARD
	SHEET 137 OF 249