




0+25 SOUTH BURLINGTON 153+56.00 (MM2.908) BACK
 = WILLISTON 0+00.00 (MM 0.000) AHEAD

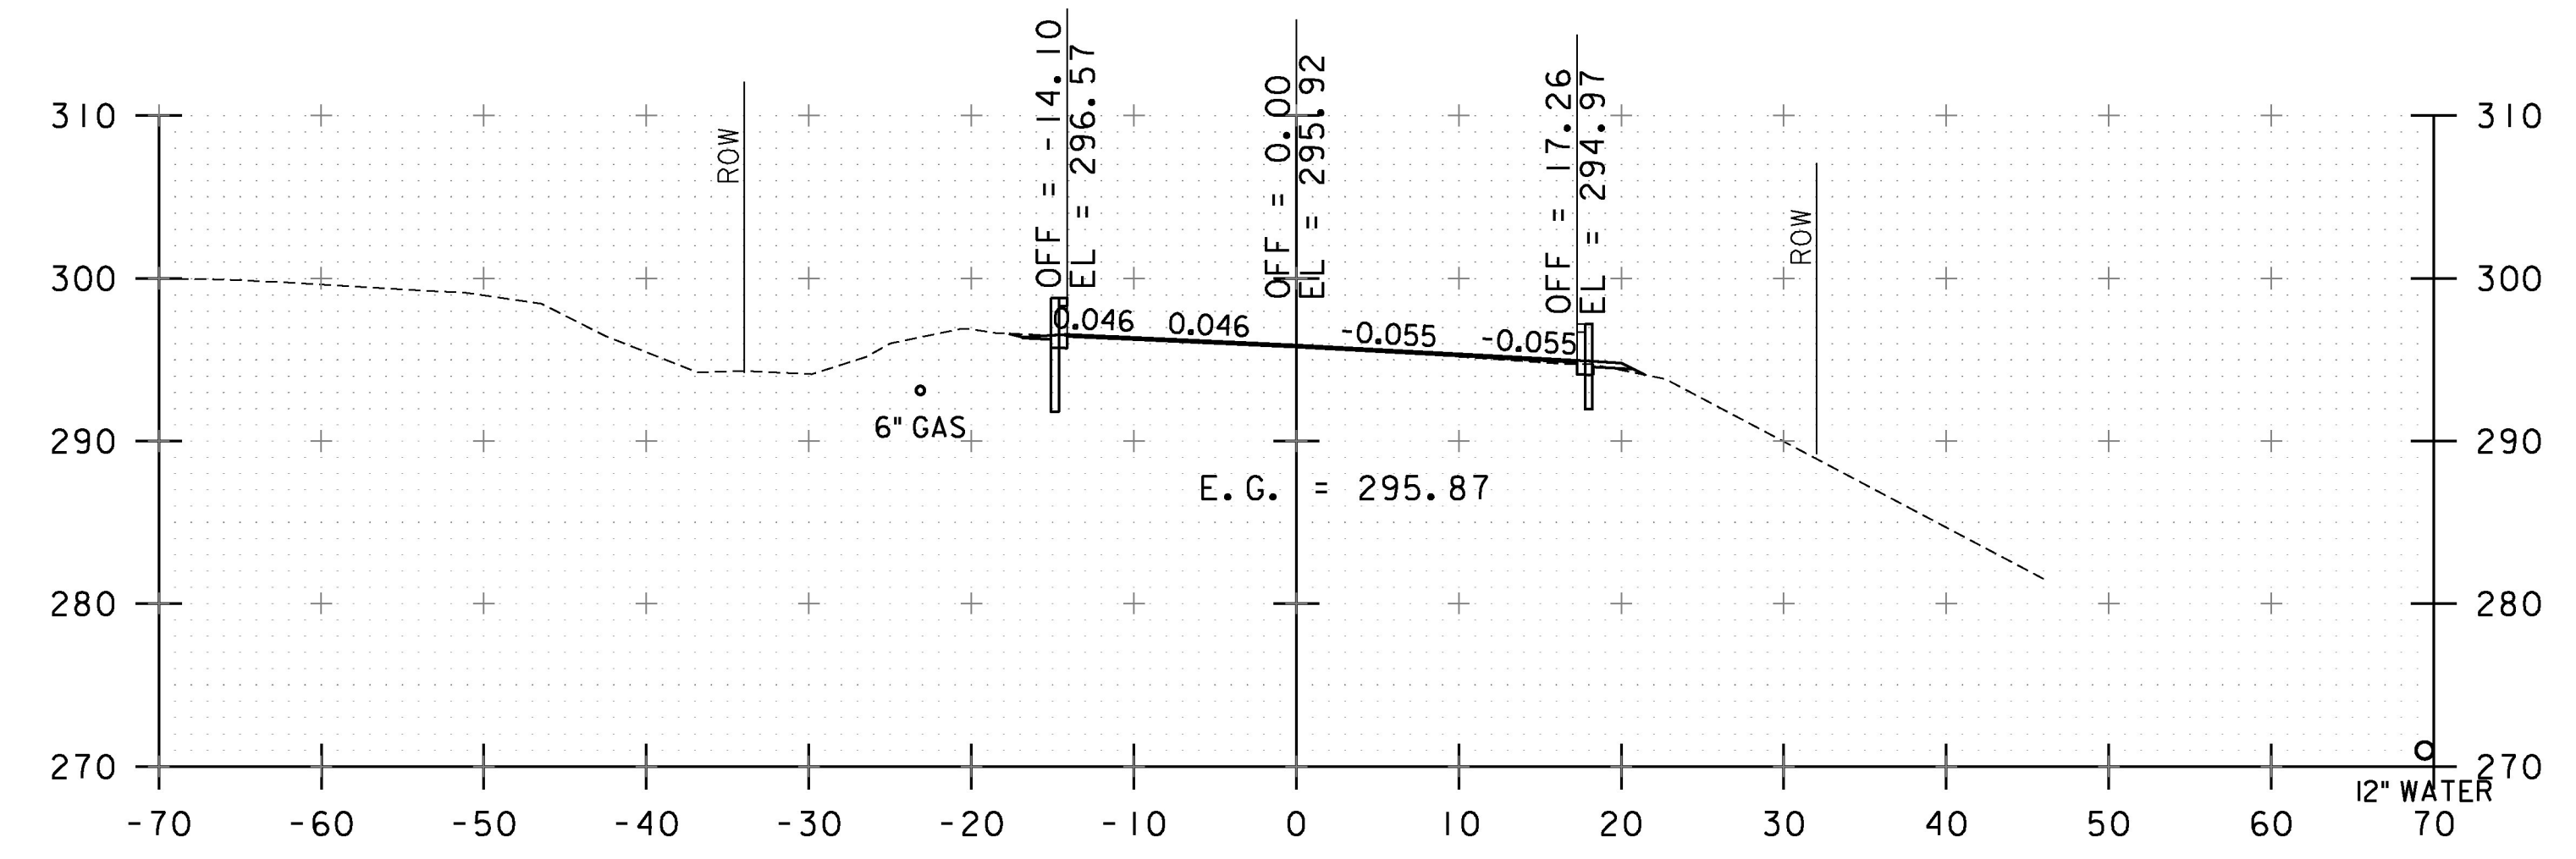


1+00

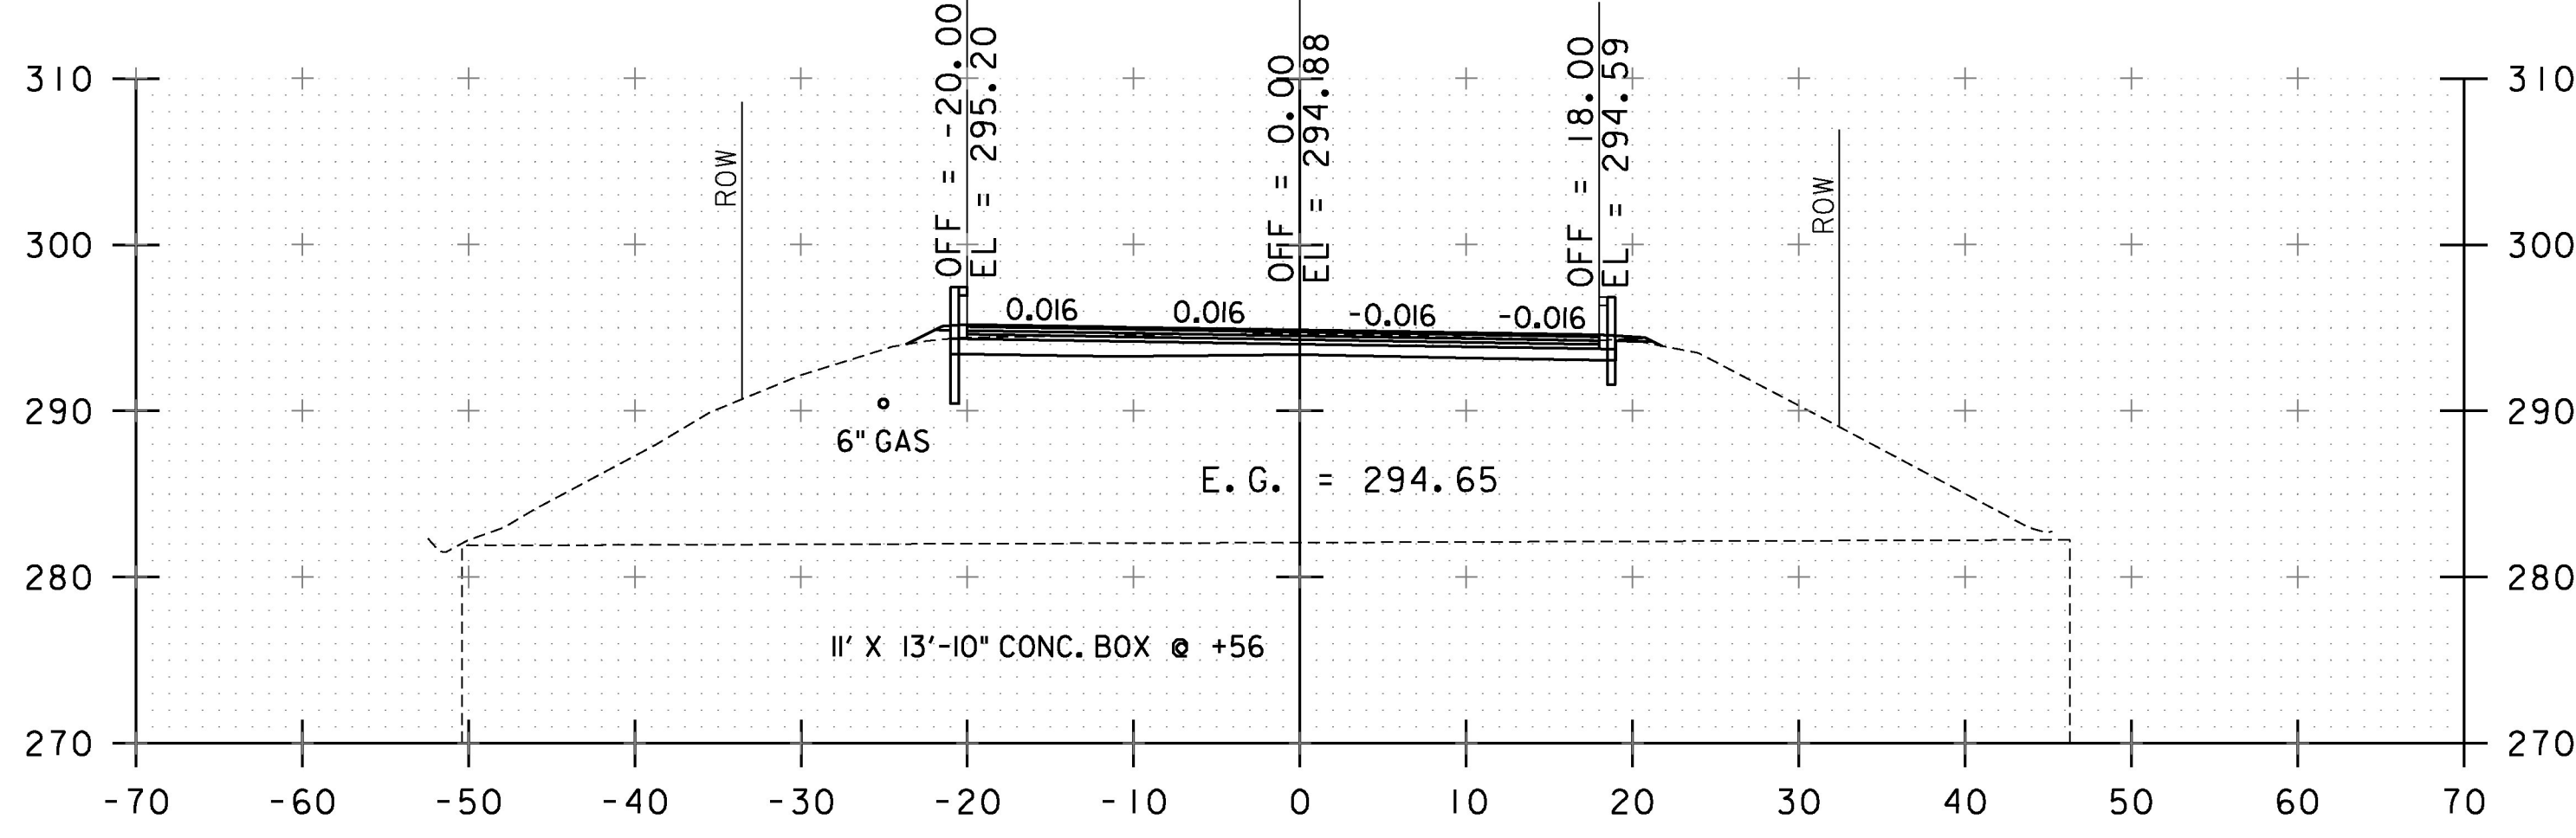


153+50

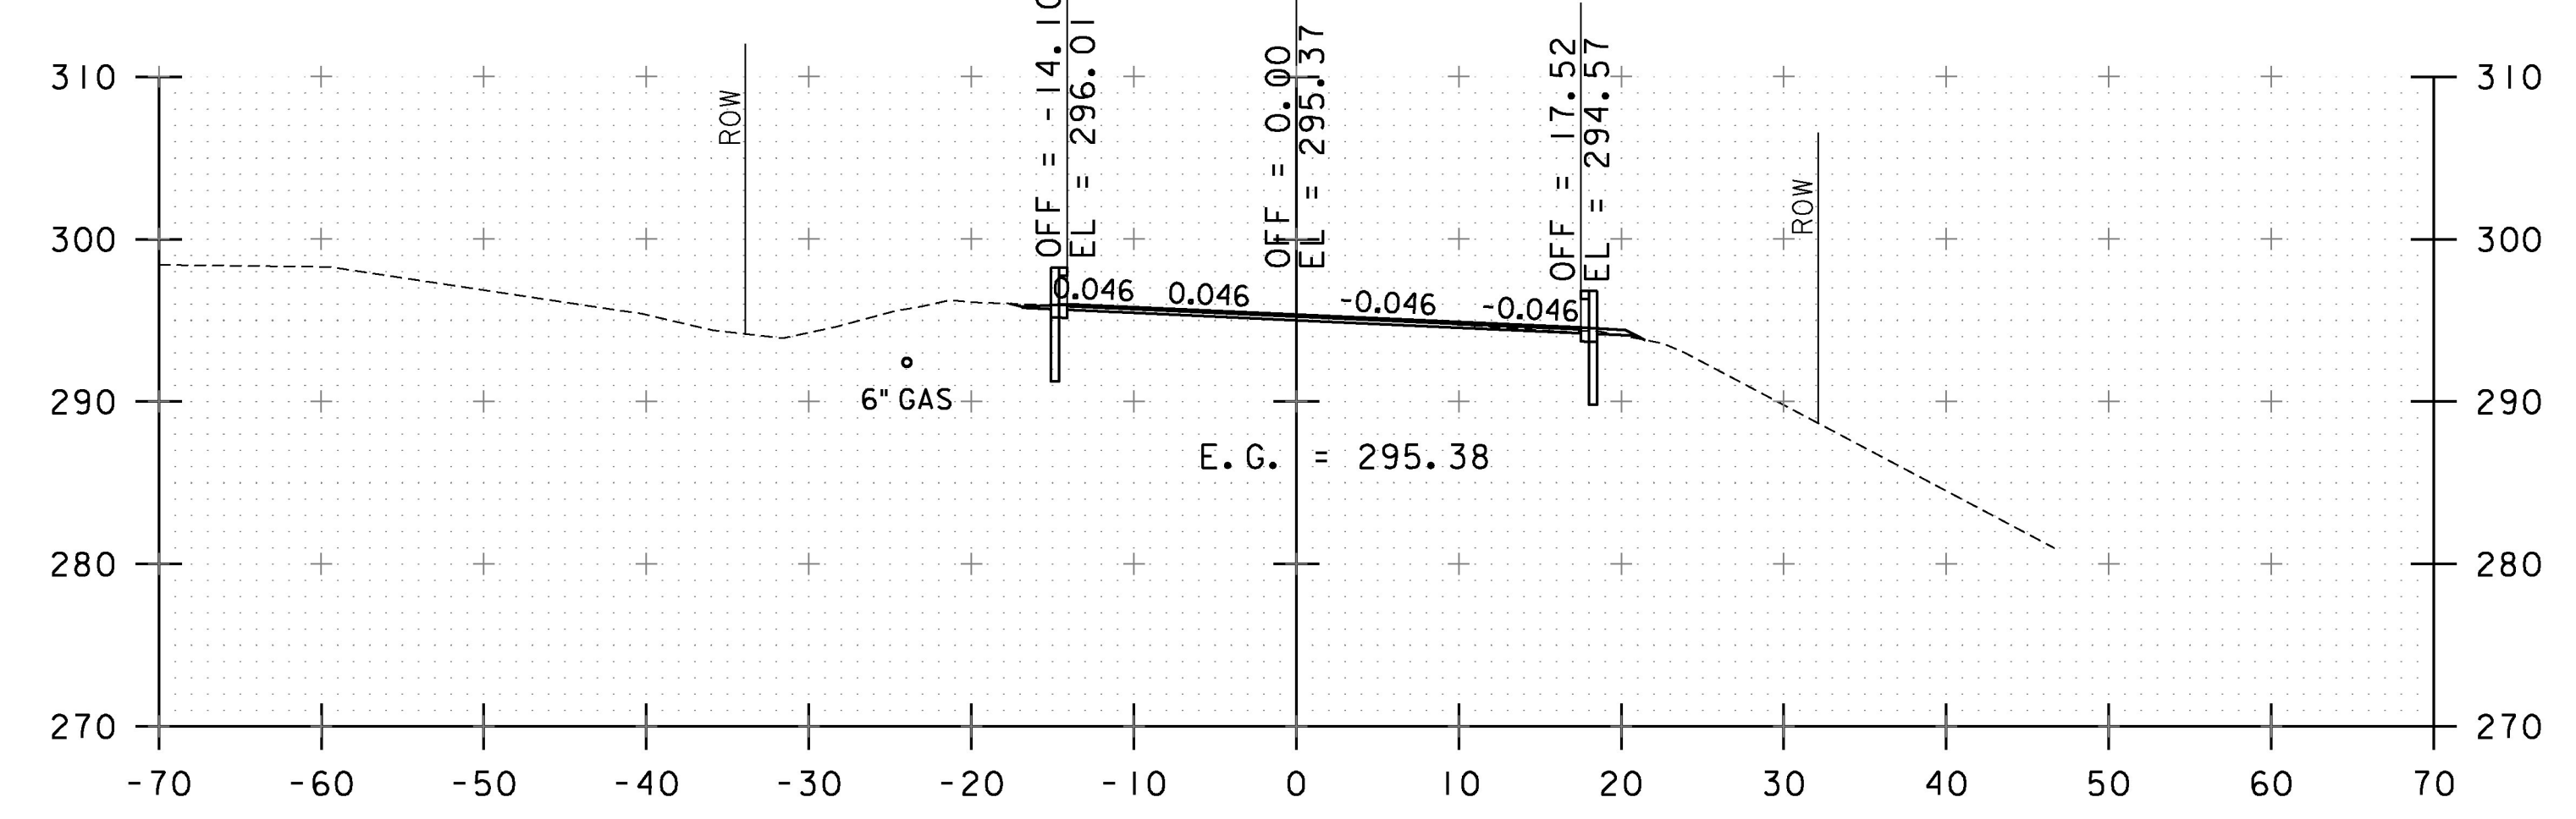

0+75

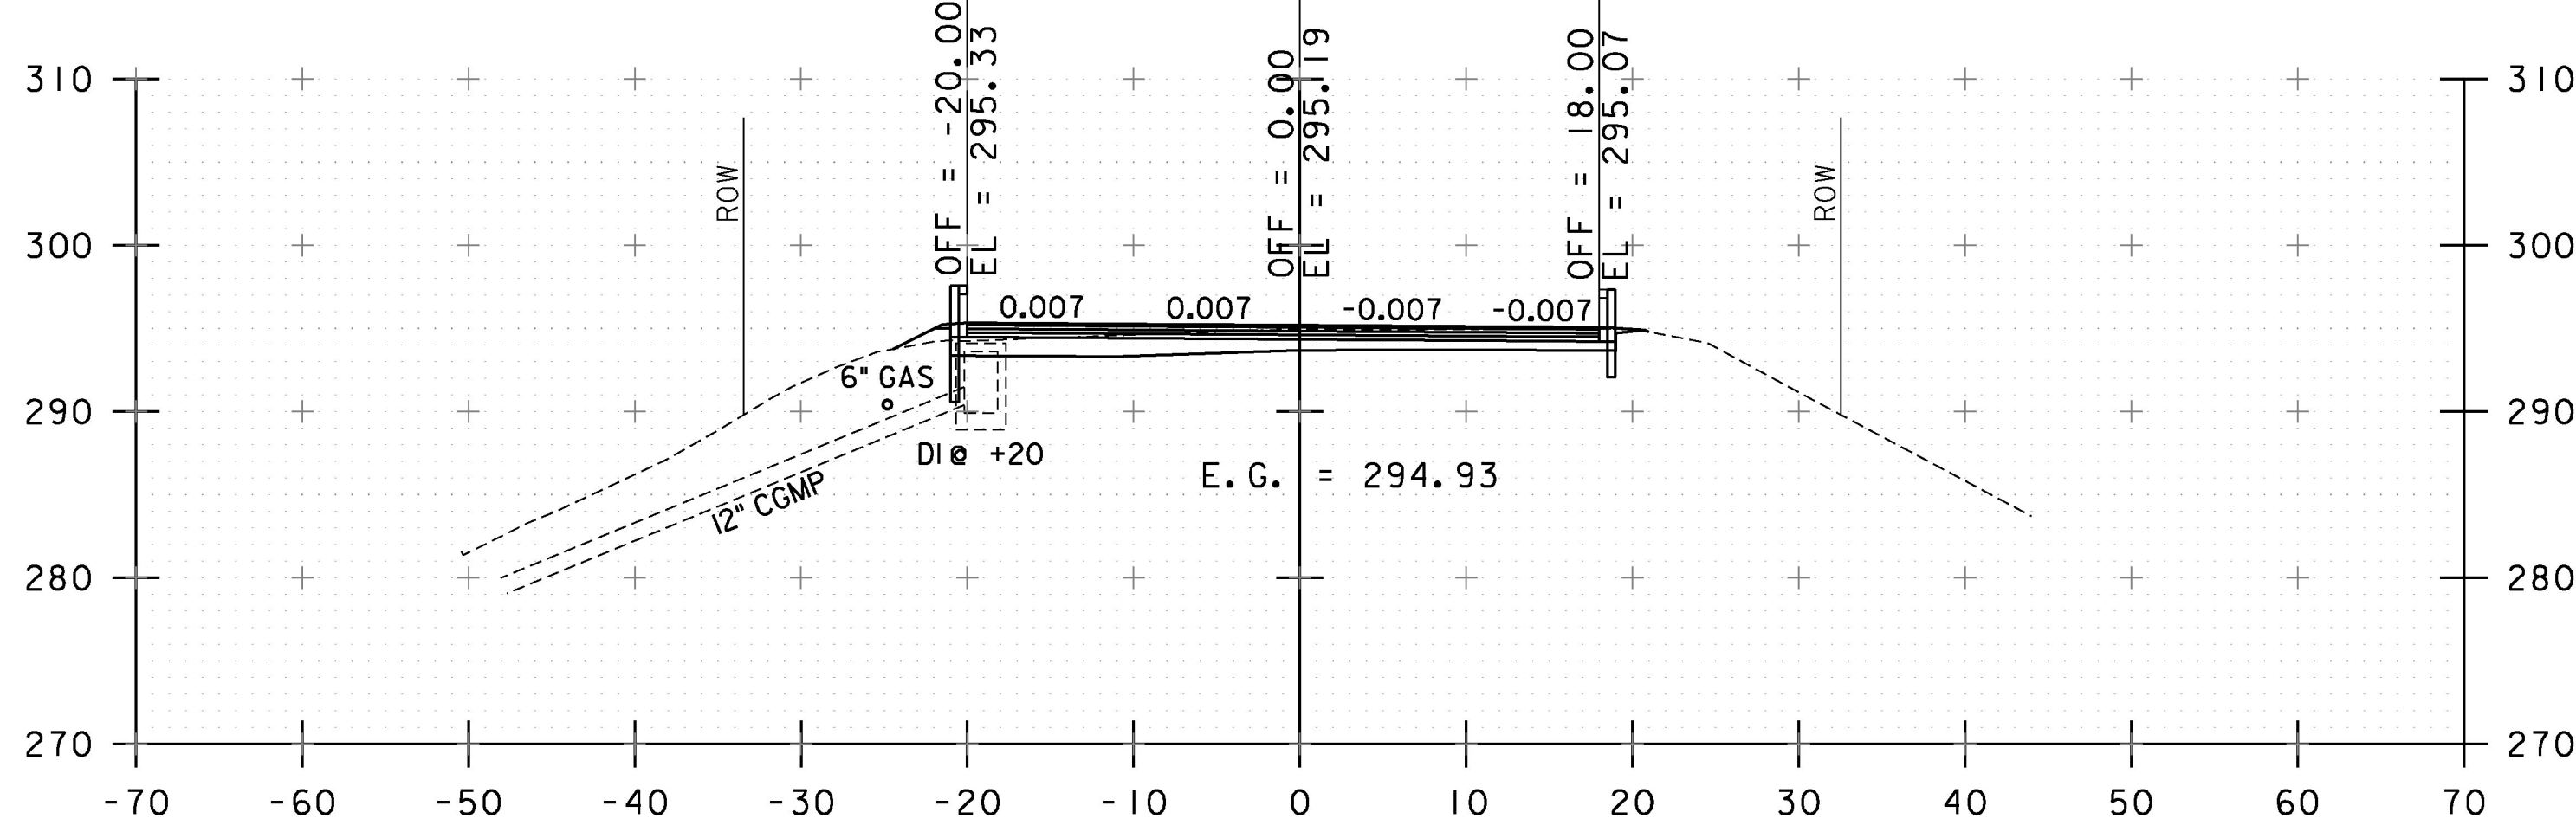


153+25

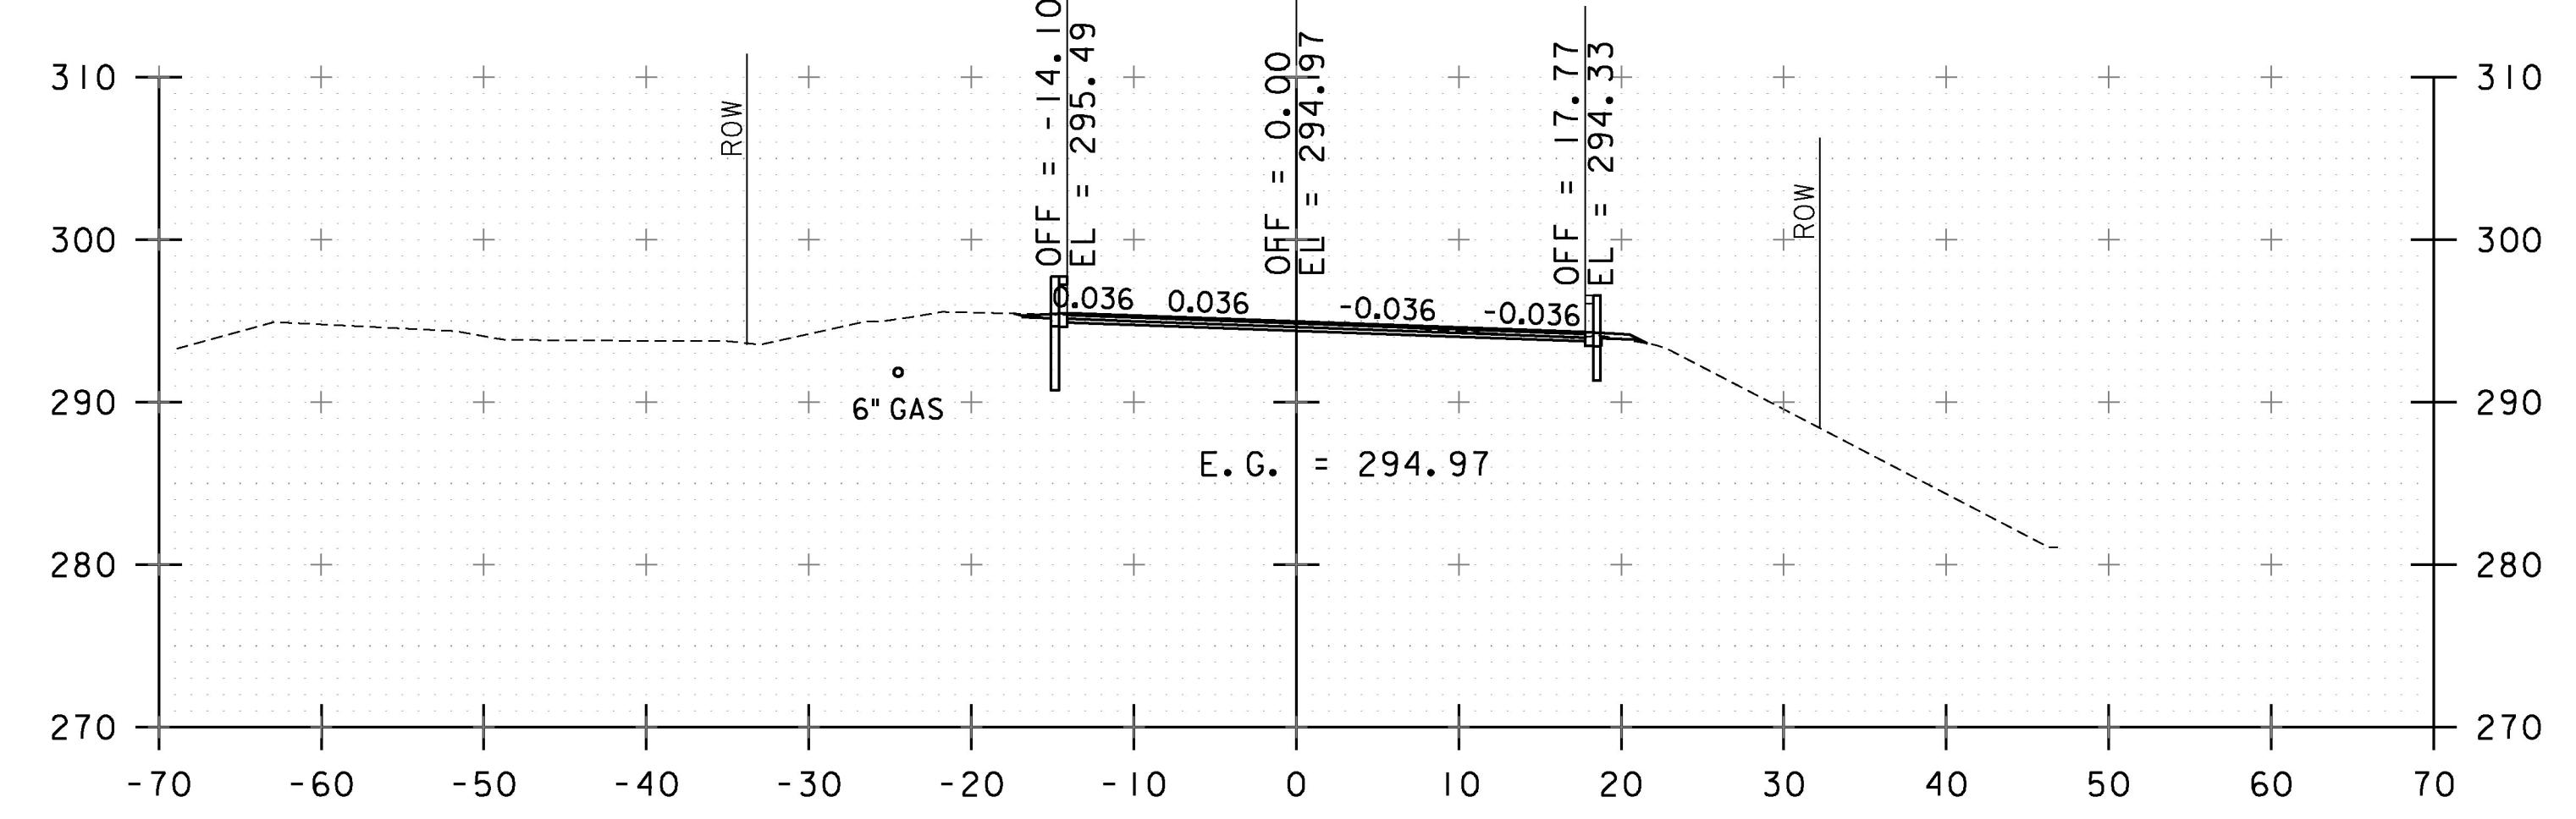

0+50

0+26.72
 STOP CONCRETE REMOVAL
 BEGIN TRANSITION

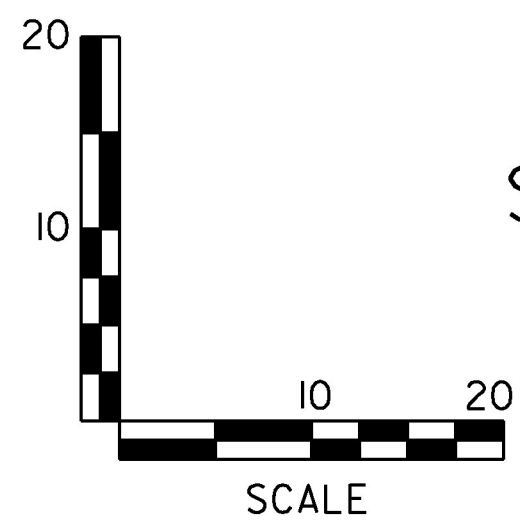

STA. 153+25 TO STA. W 1+00

PROJECT NAME: SOUTH BURLINGTON-WILLISTON	PLOT DATE: 2/15/2017
PROJECT NUMBER: NH 2944(I)	DRAWN BY: I. MAYNARD
FILE NAME: zild340xsl.dgn	CHECKED BY: J. LITTLE
PROJECT LEADER: G. EDWARDS	SHEET 143 OF 249
DESIGNED BY: I. MAYNARD	
CROSS SECTION SHEET 23	