




1+26.72 END TRANSITION
BEGIN COLD PLANE, LEVEL & OVERLAY

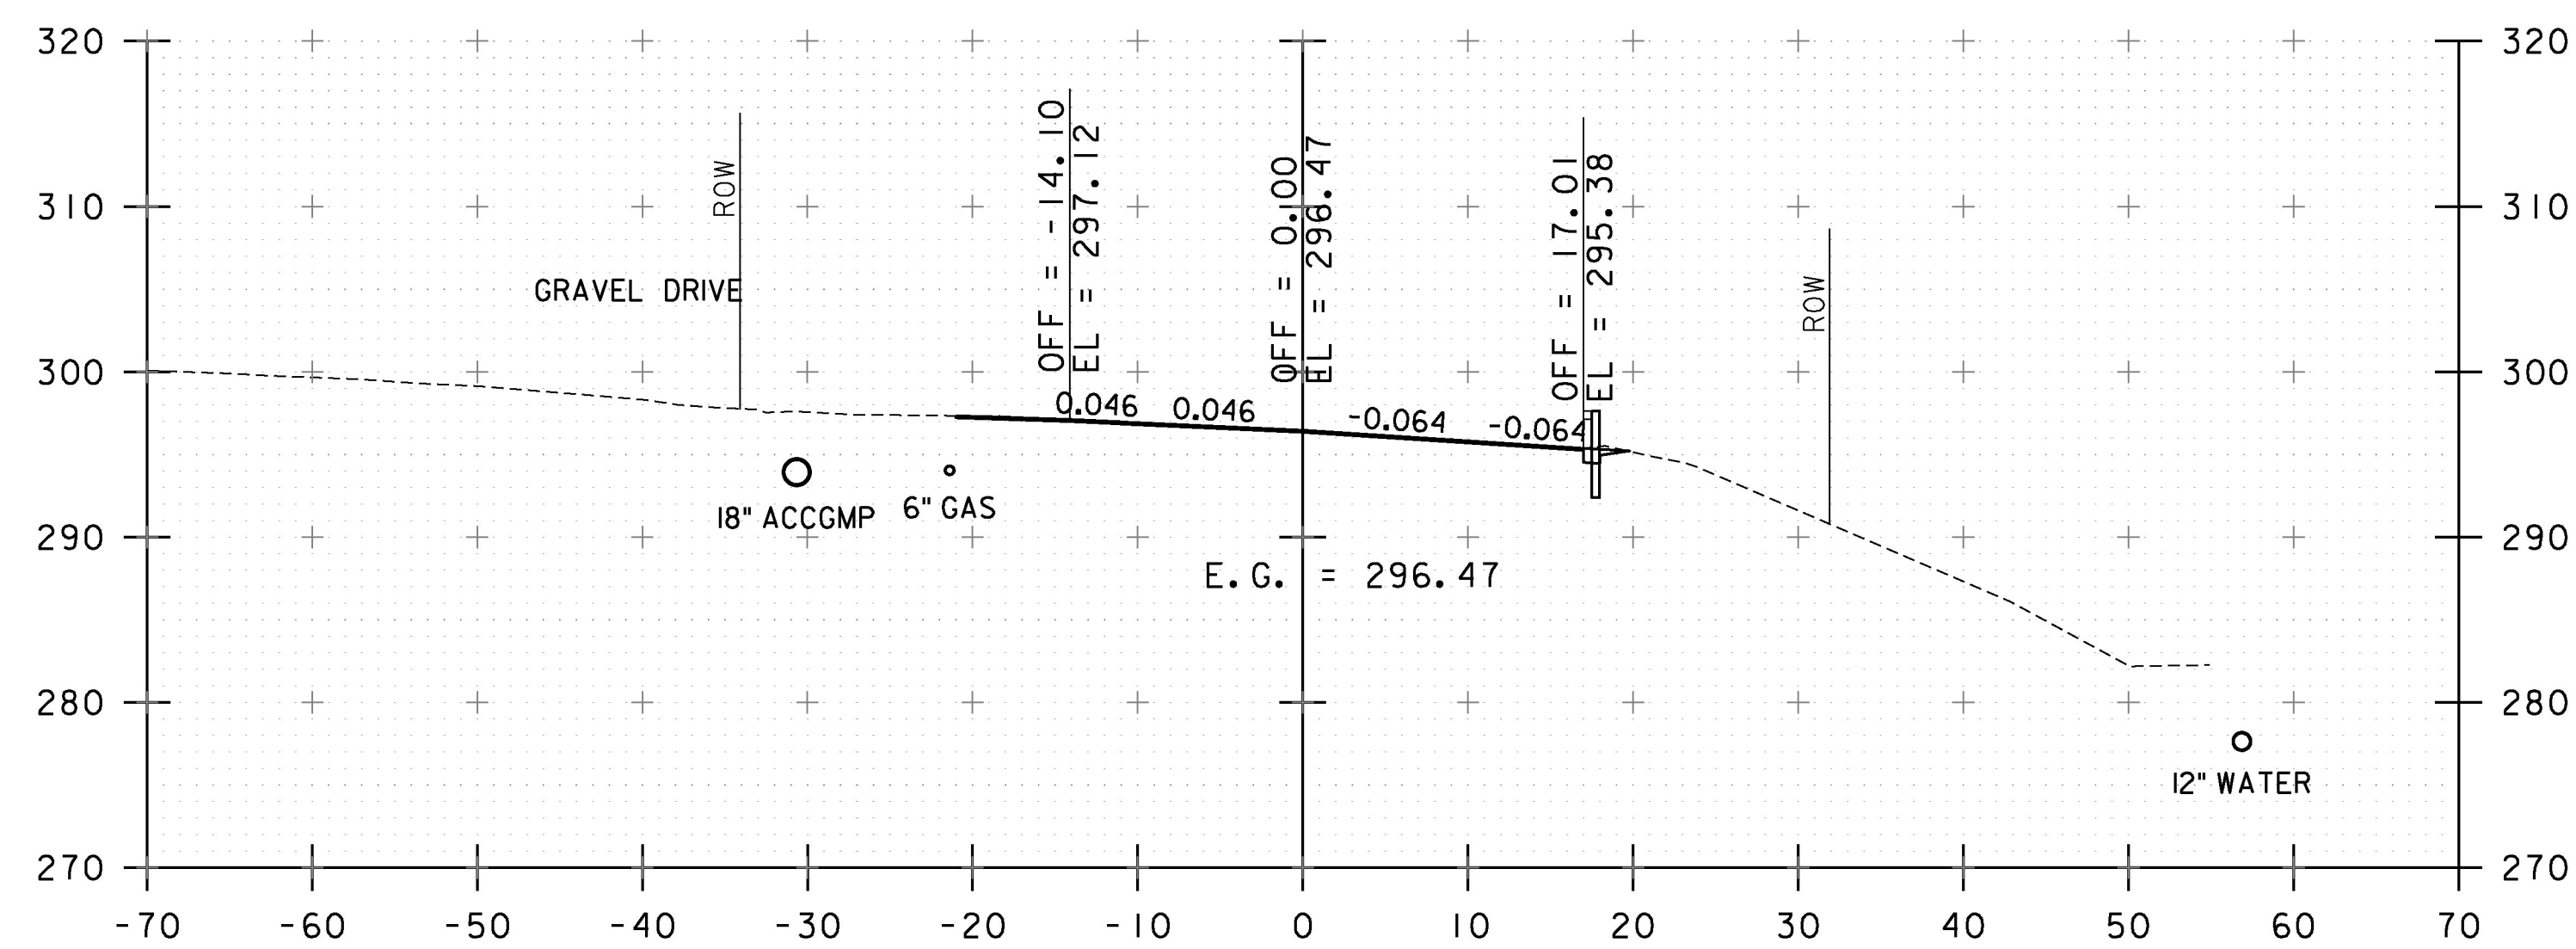


1+25

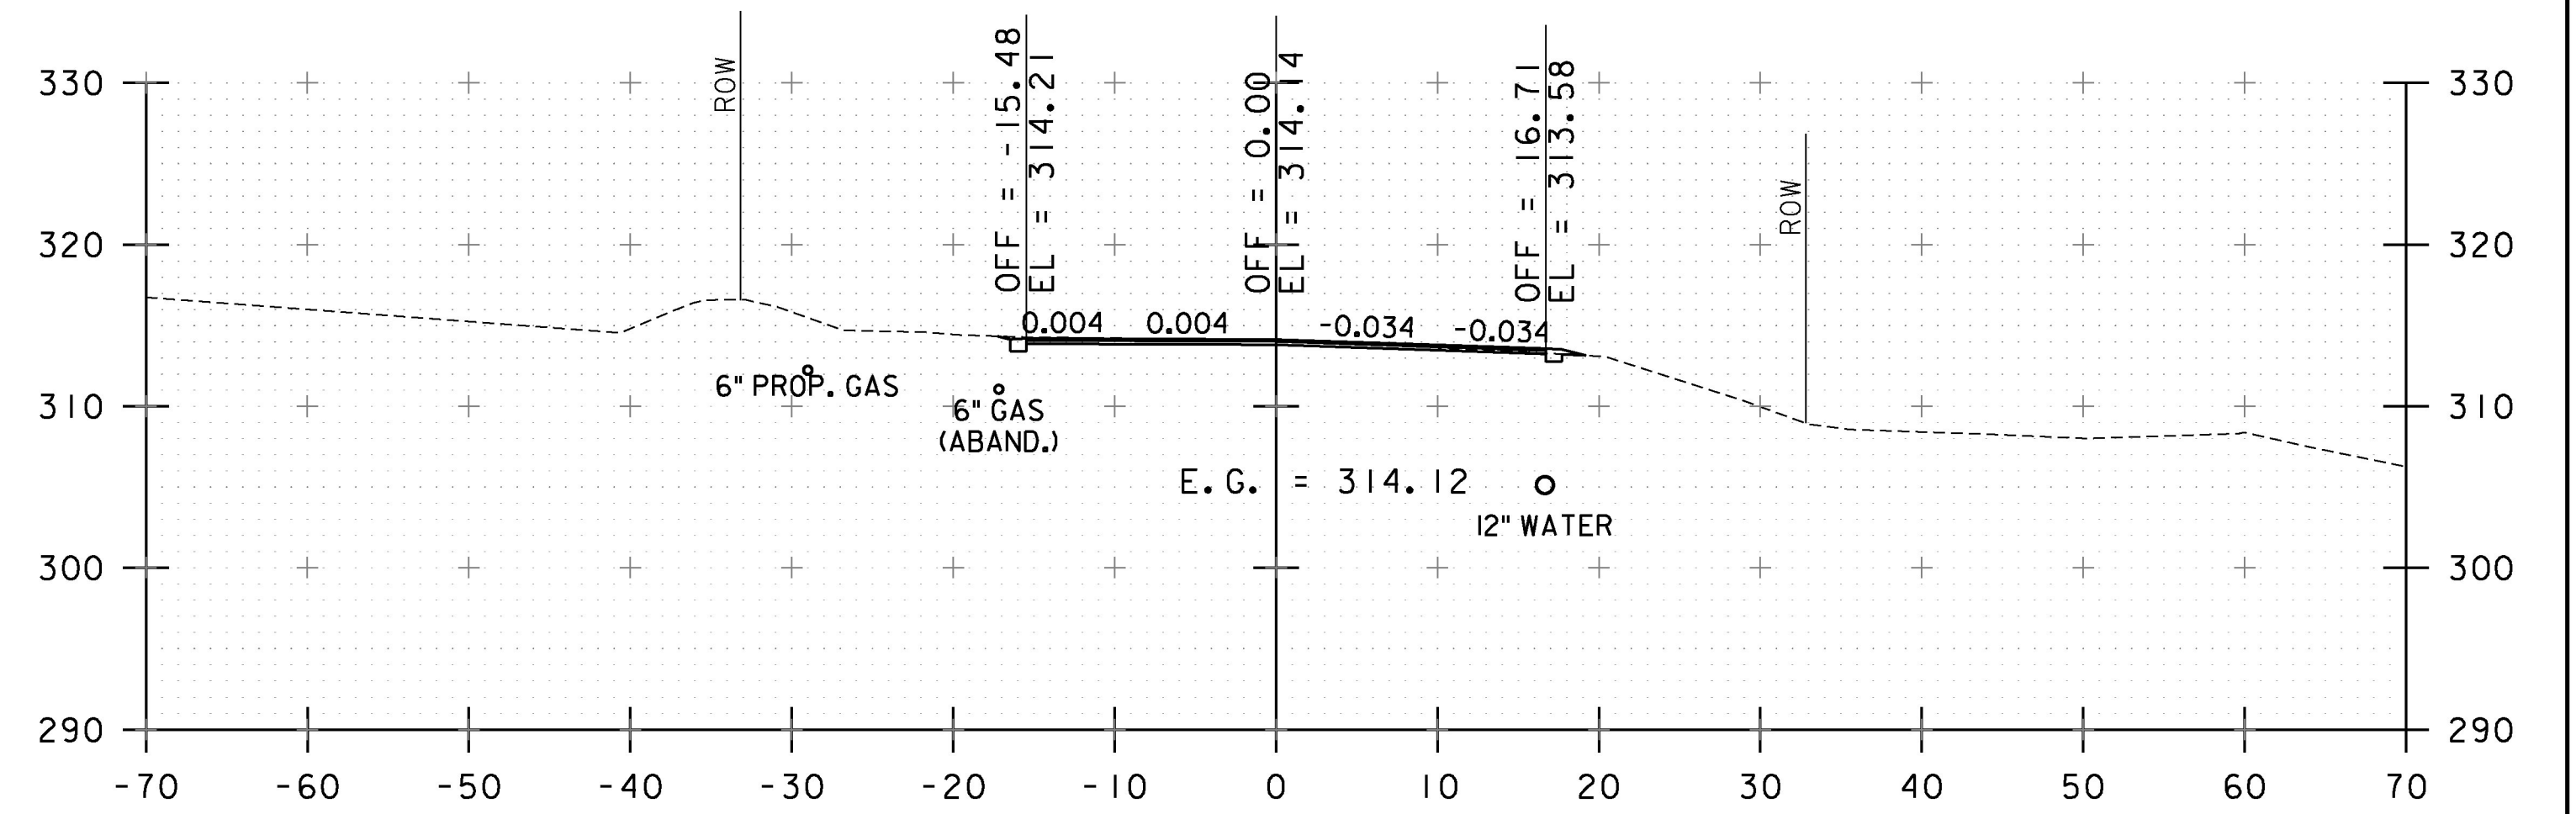


16+50

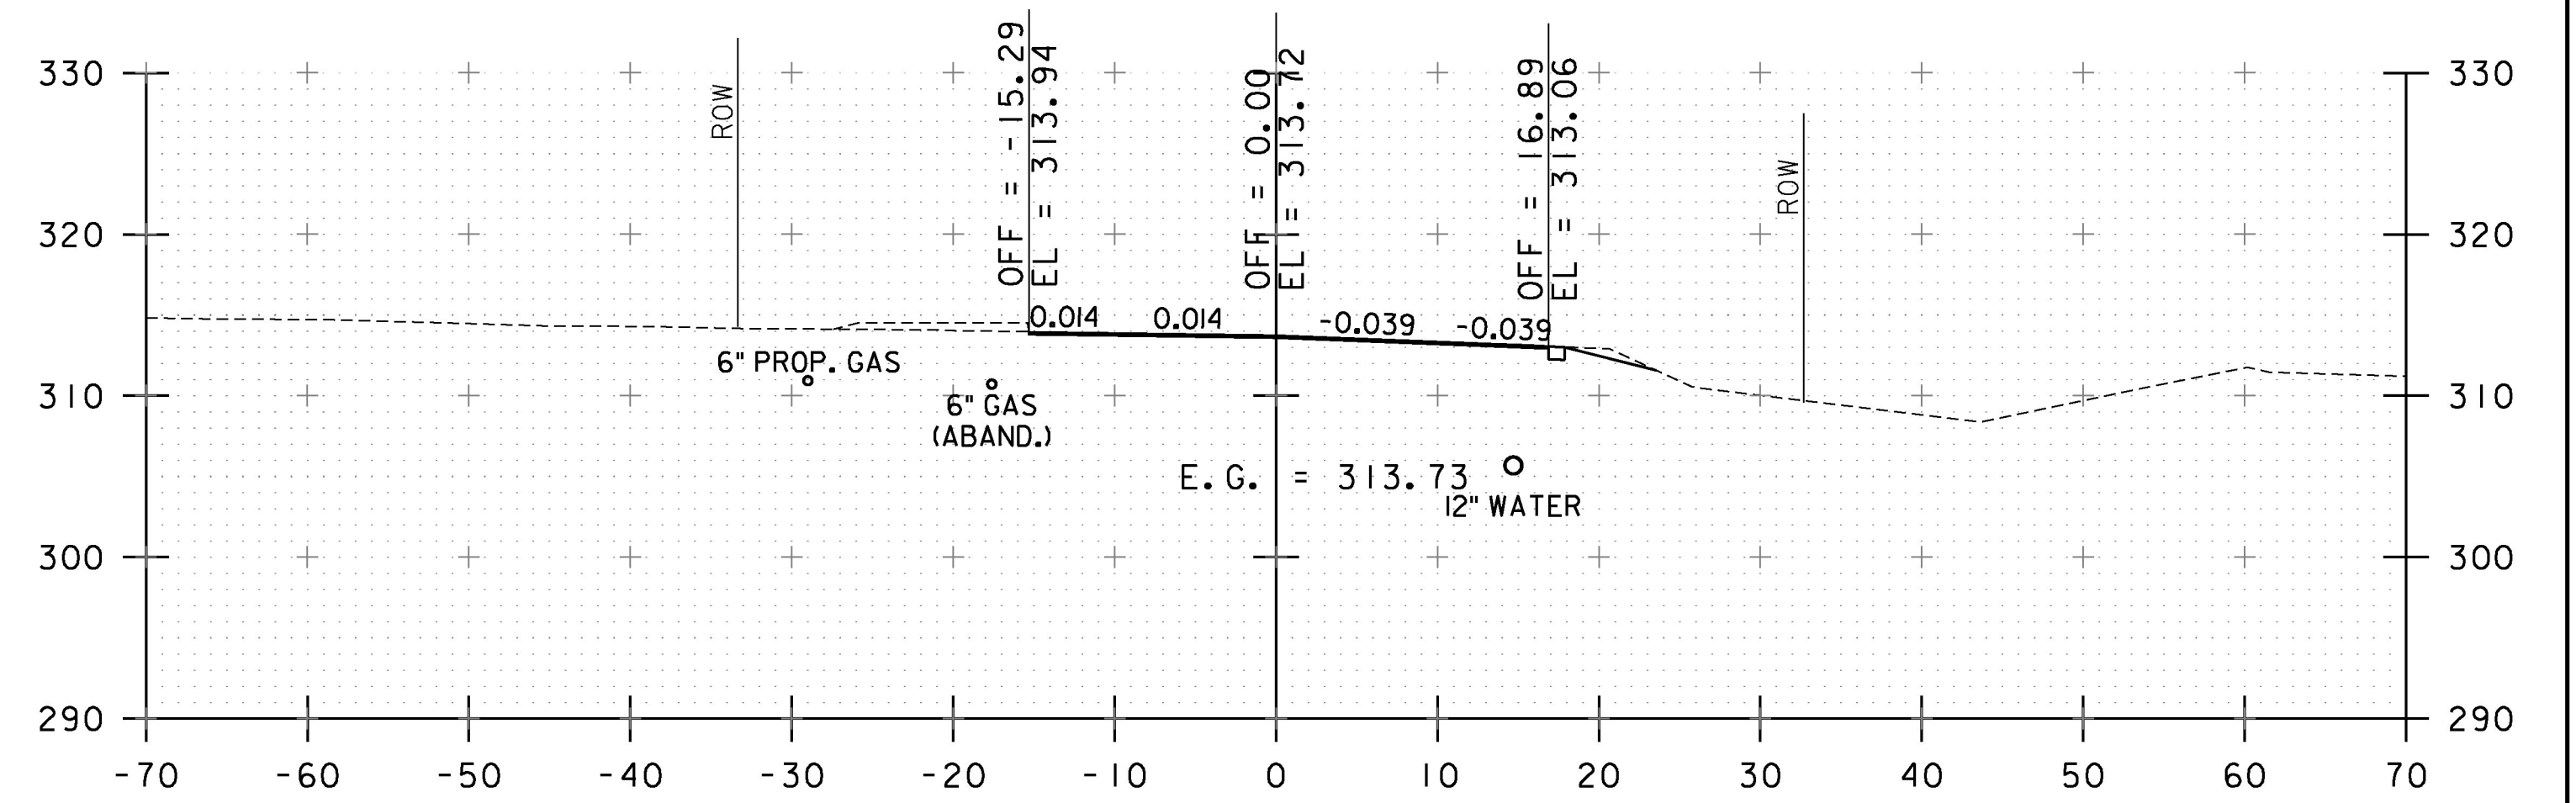

16+25

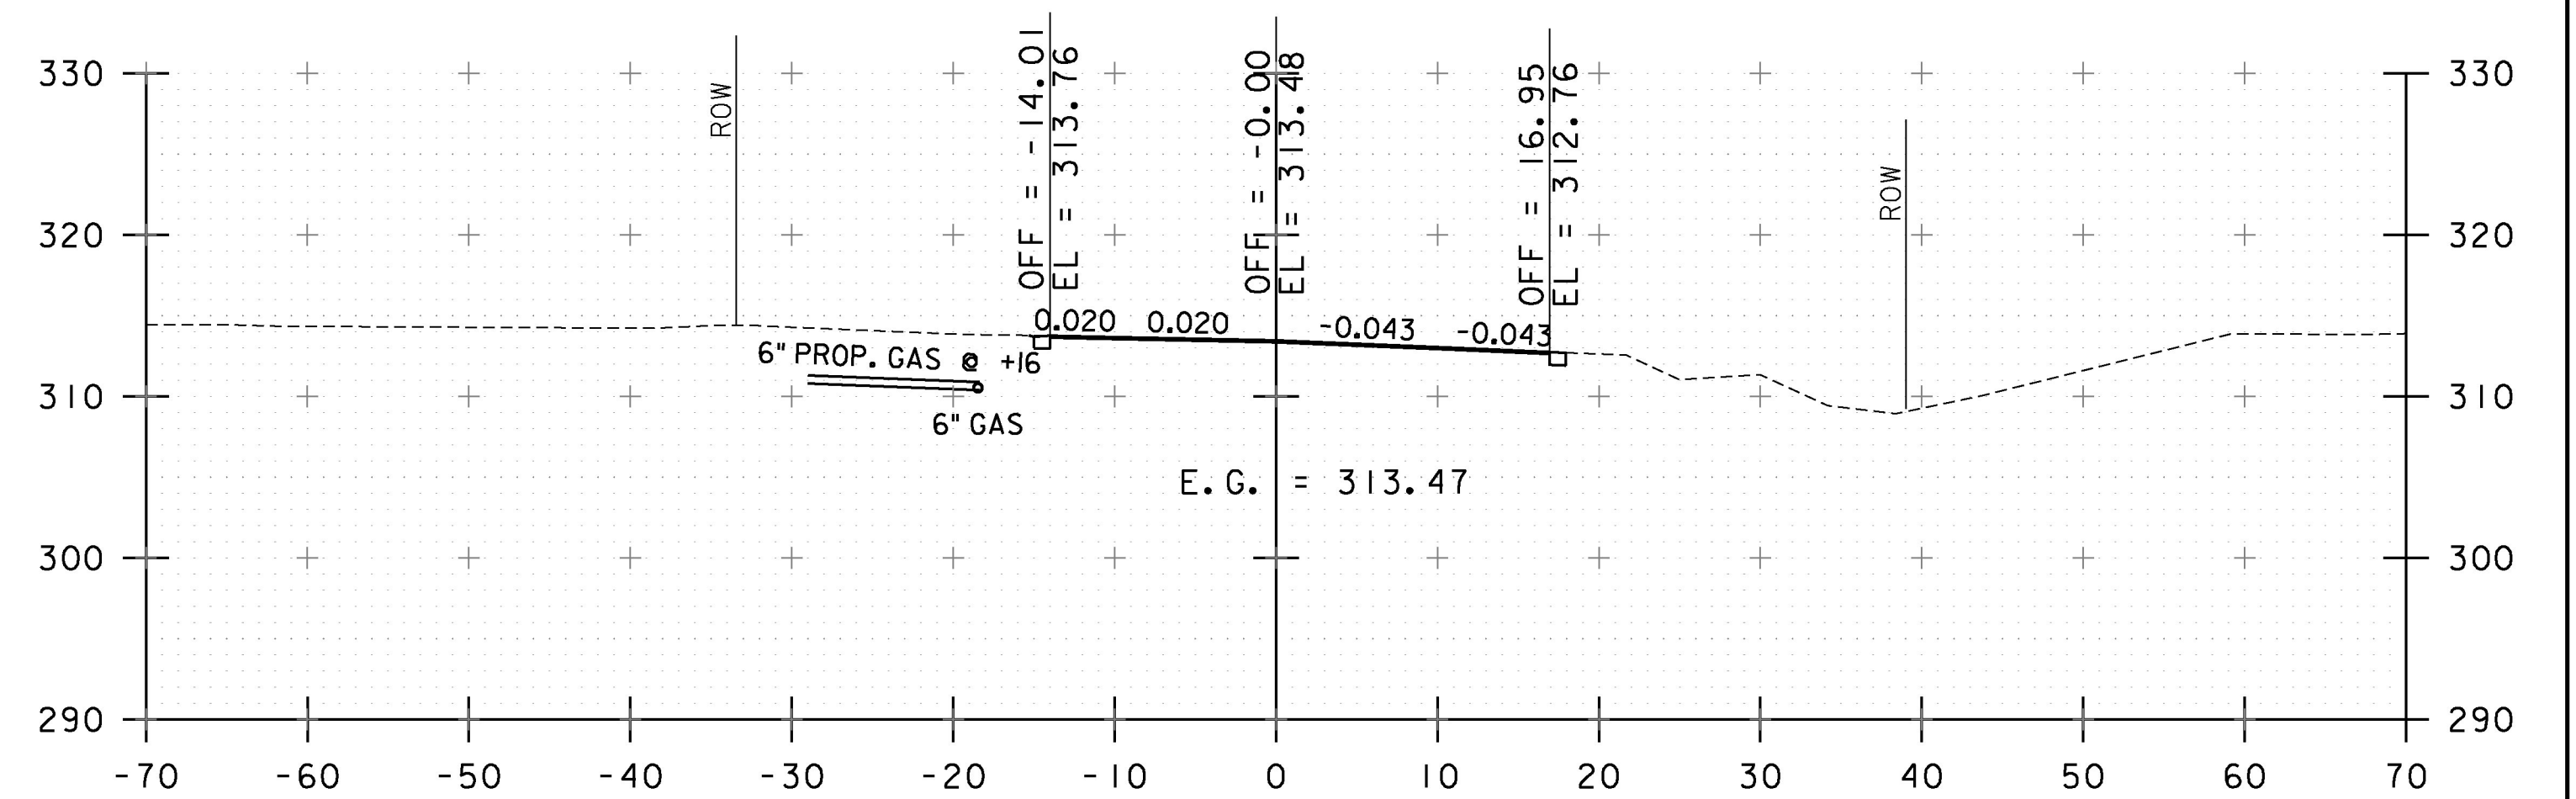

16+10.40
END COLD PLANE TYPICAL
BEGIN TRANSITION

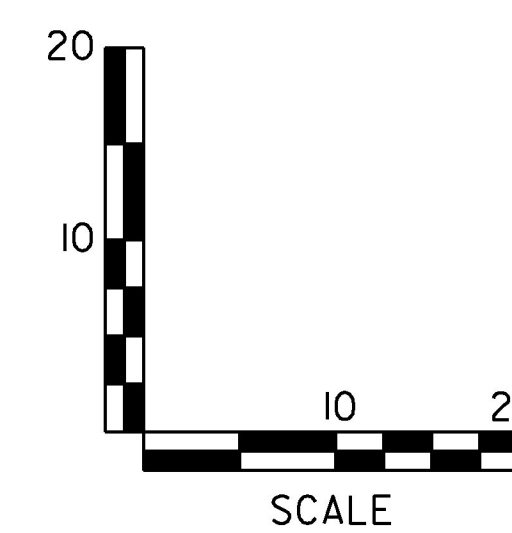

STA. W 1+25 TO STA. W 16+50

PROJECT NAME:	SOUTH BURLINGTON-WILLISTON
PROJECT NUMBER:	NH 2944(1)
FILE NAME:	zild340xsl.dgn
PROJECT LEADER:	G. EDWARDS
DESIGNED BY:	I. MAYNARD
CROSS SECTION SHEET 24	
PLOT DATE:	2/15/2017
DRAWN BY:	I. MAYNARD
CHECKED BY:	J. LITTLE
SHEET	144 OF 249