




20+75

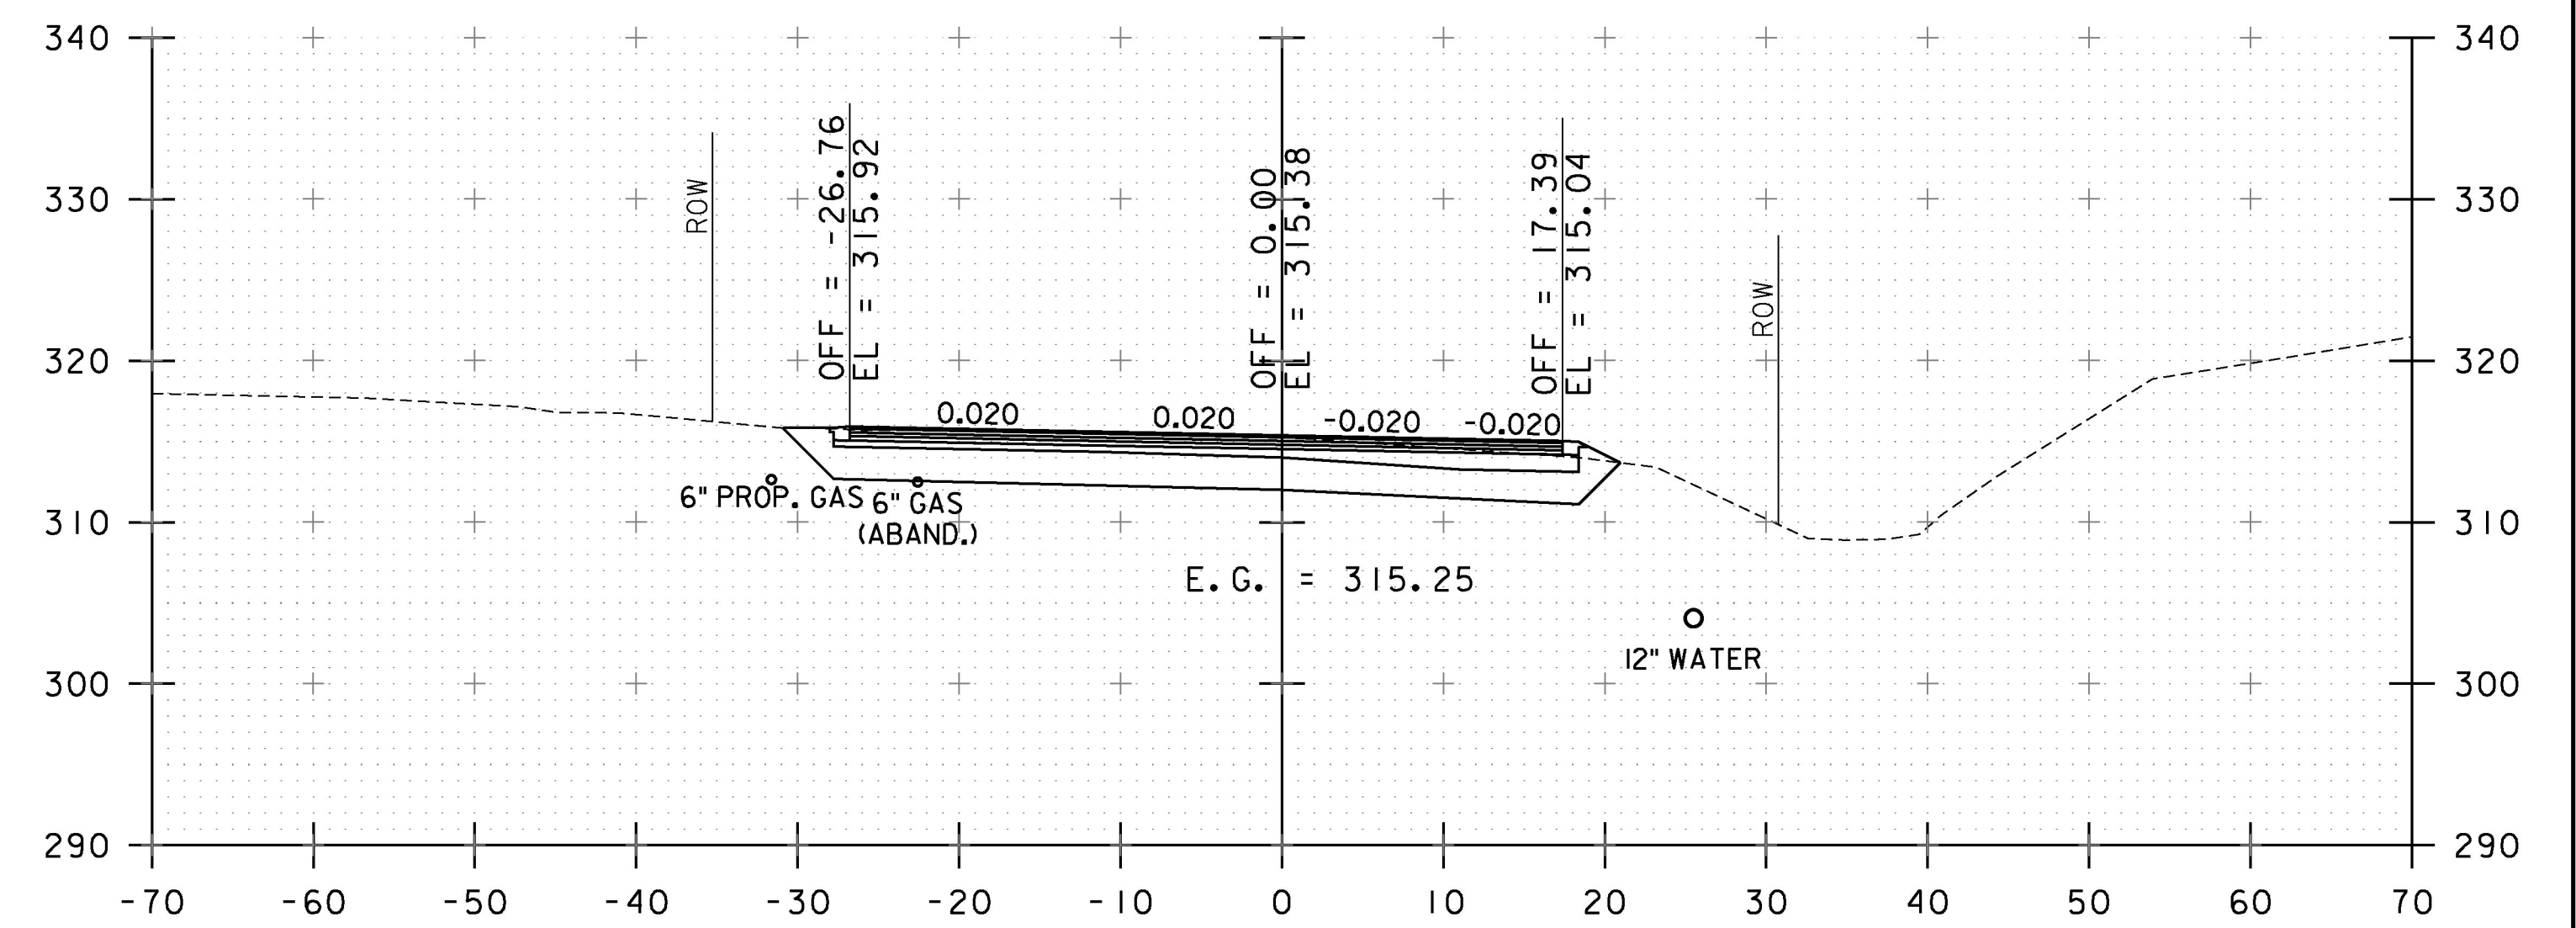


21+25

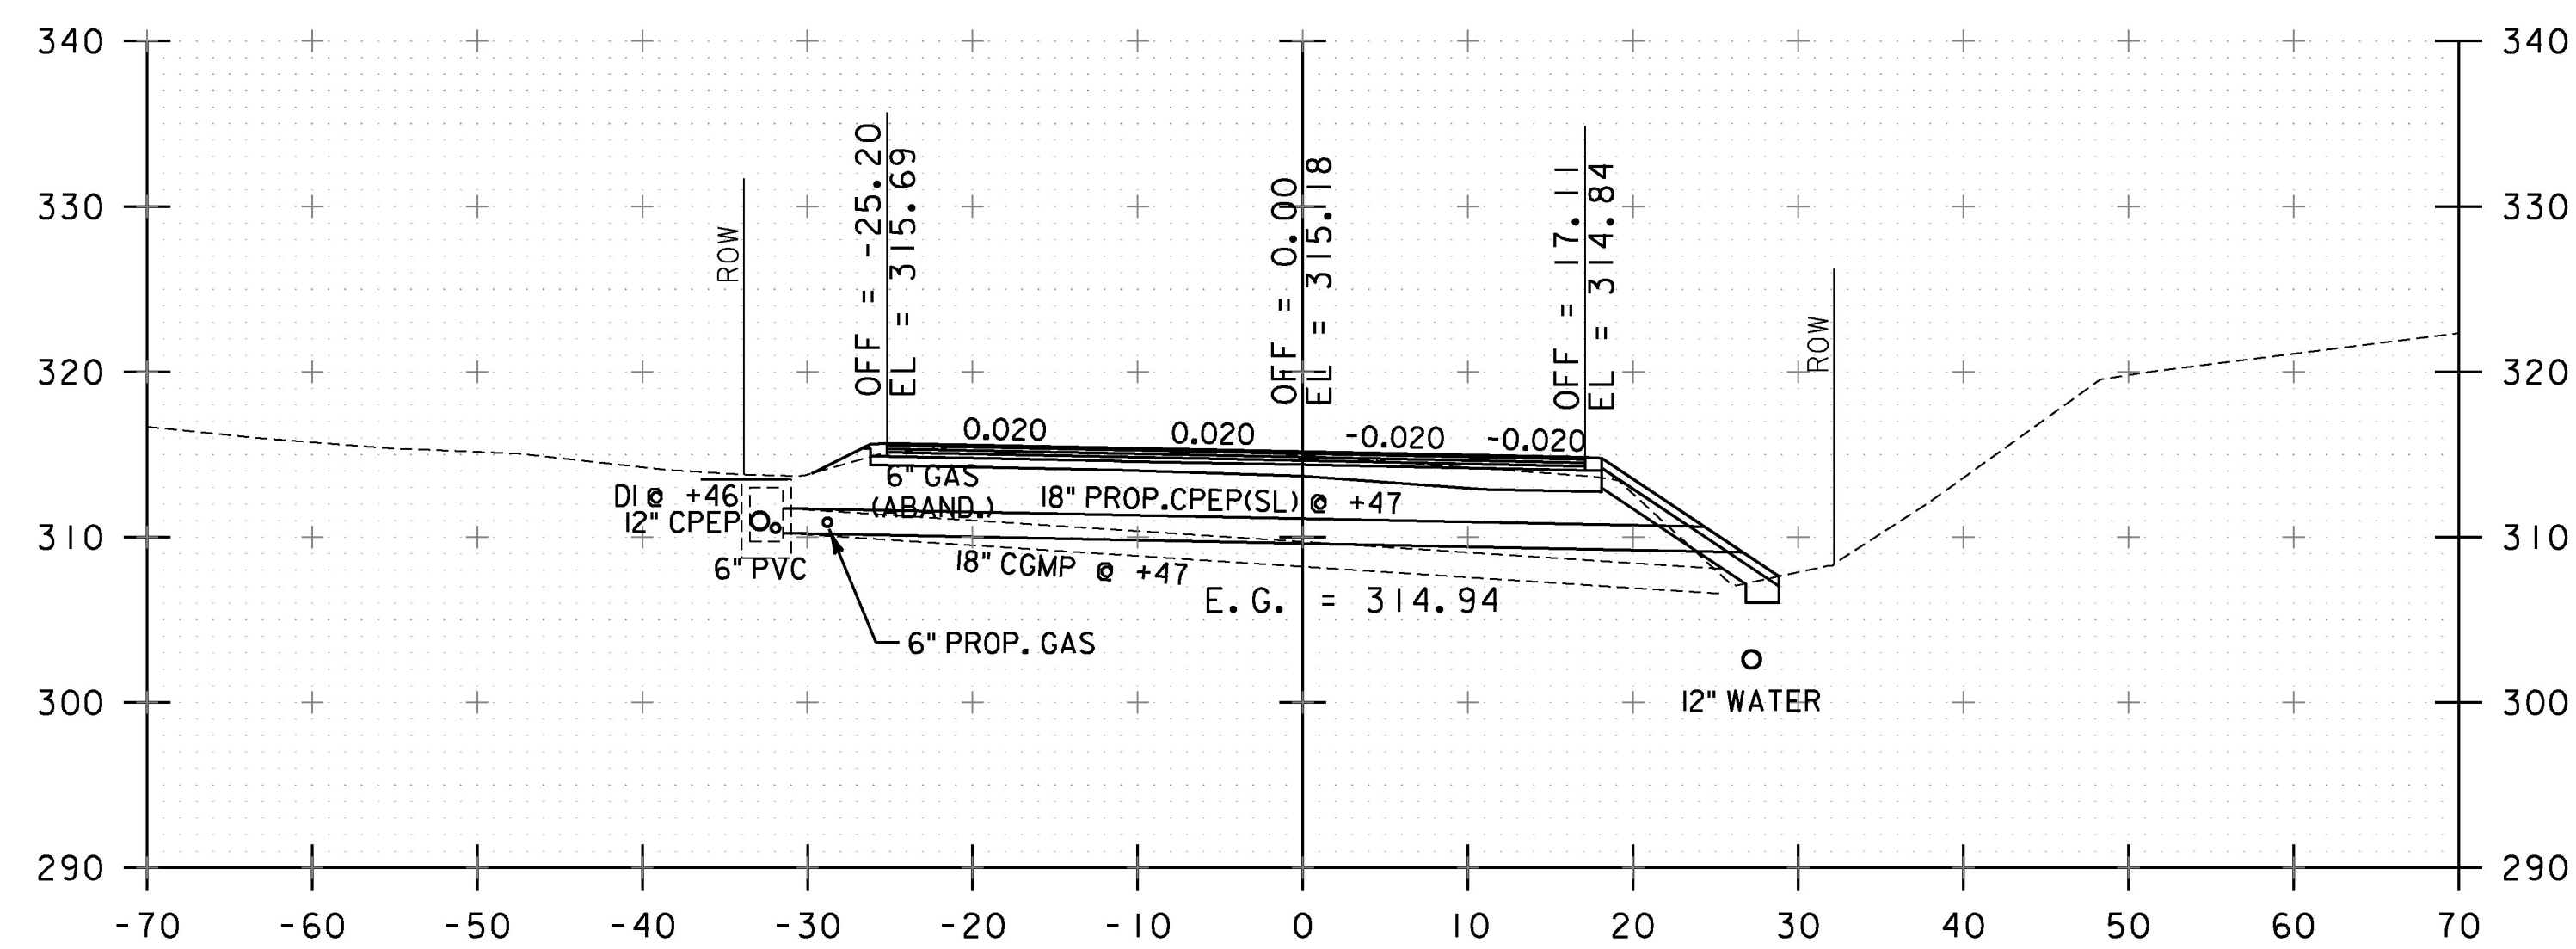

20+50
BEGIN UNDERCUT TRANSITION

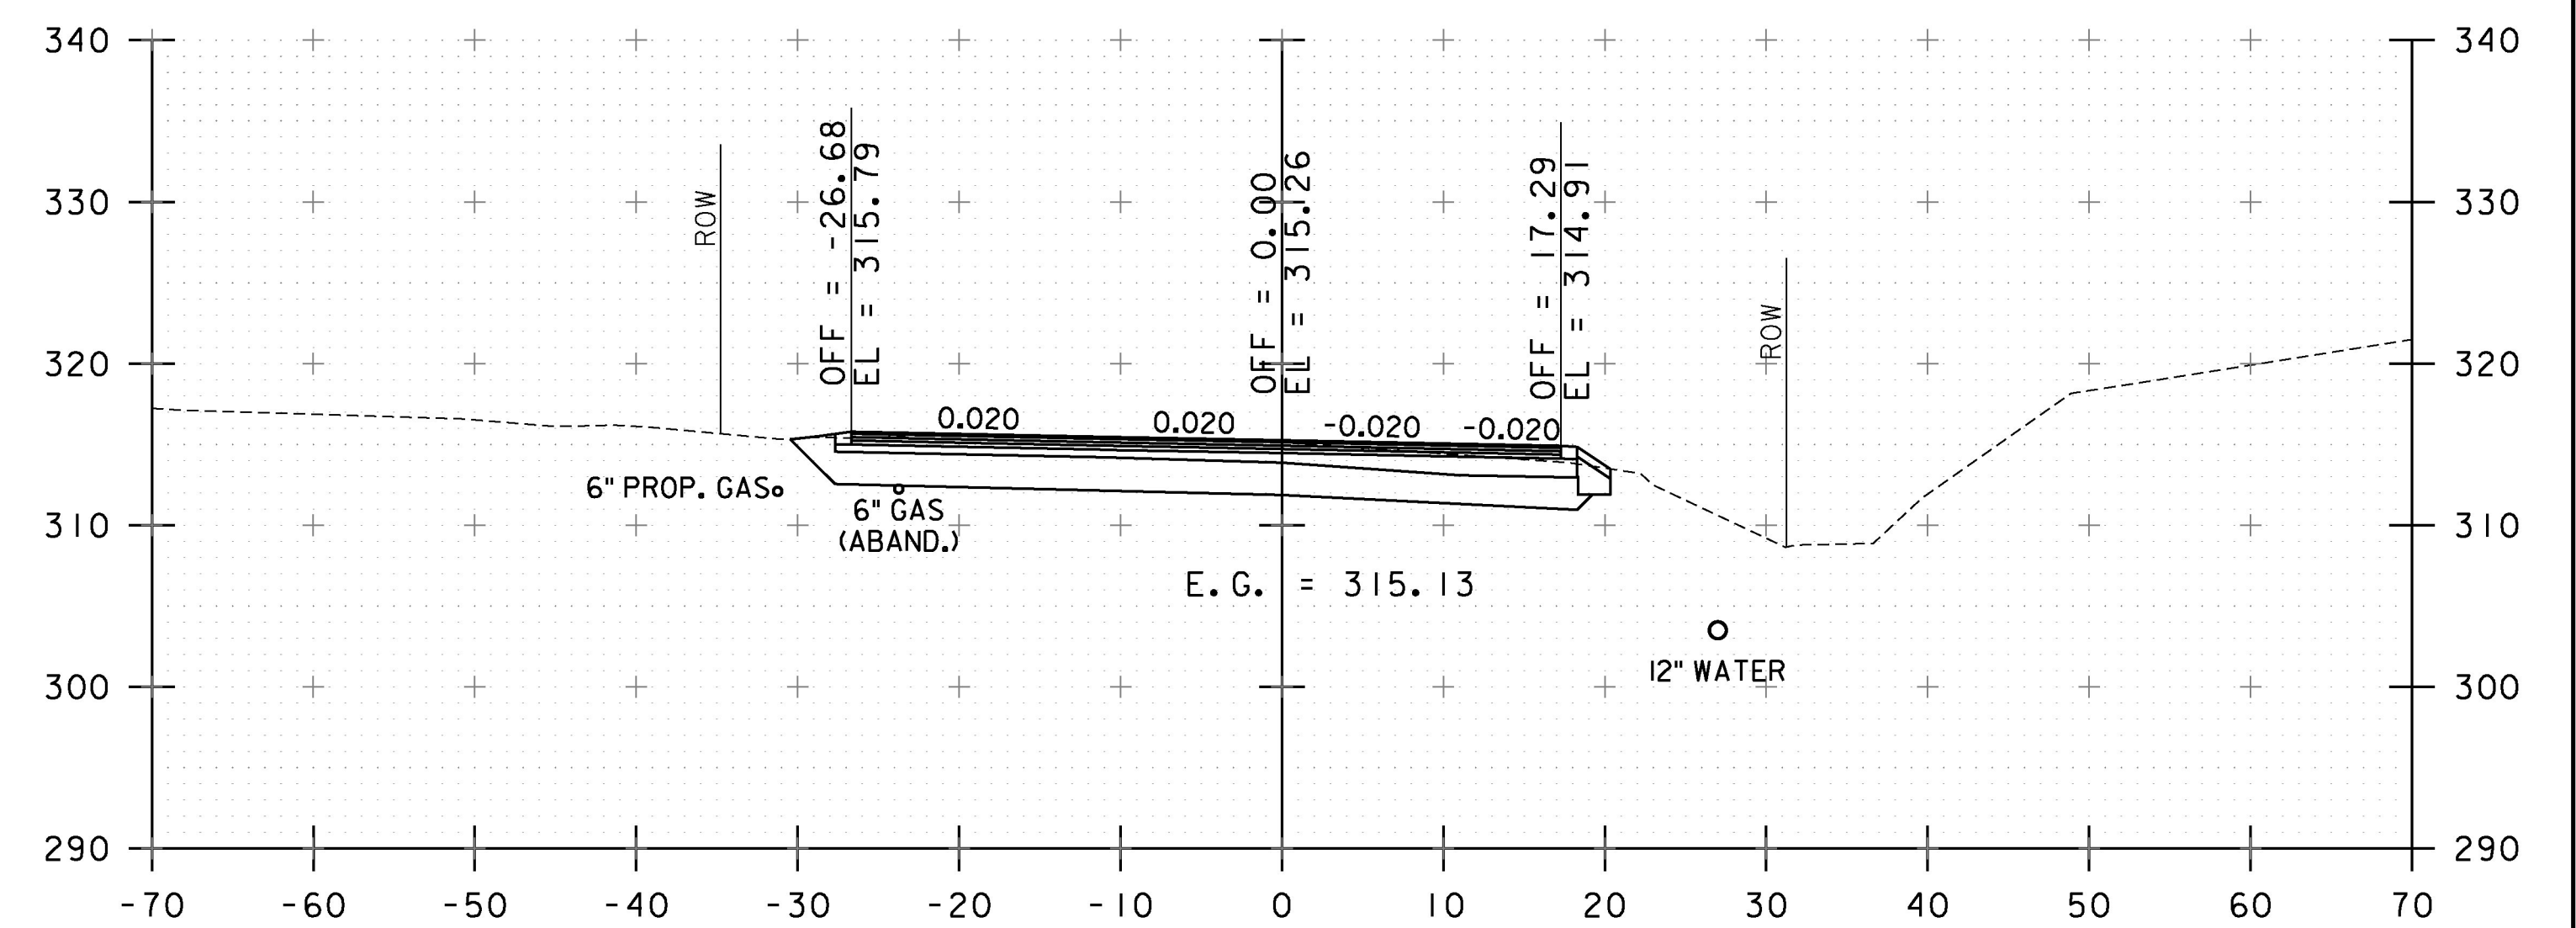

21+00 END TRANSITION
BEGIN FULL DEPTH UNDERCUT

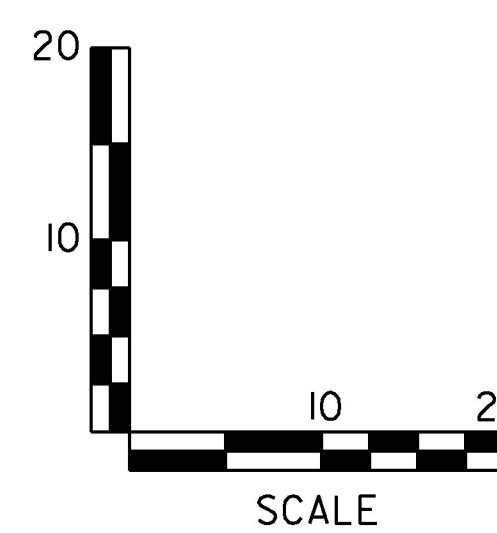

STA. W 20+50 TO STA. W 21+25

PROJECT NAME:	SOUTH BURLINGTON-WILLISTON
PROJECT NUMBER:	NH 2944(I)
FILE NAME:	zild340xsl.dgn
PROJECT LEADER:	G. EDWARDS
DESIGNED BY:	I. MAYNARD
CROSS SECTION SHEET 28	
PLOT DATE:	2/15/2017
DRAWN BY:	I. MAYNARD
CHECKED BY:	J. LITTLE
SHEET	148 OF 249