




21+75

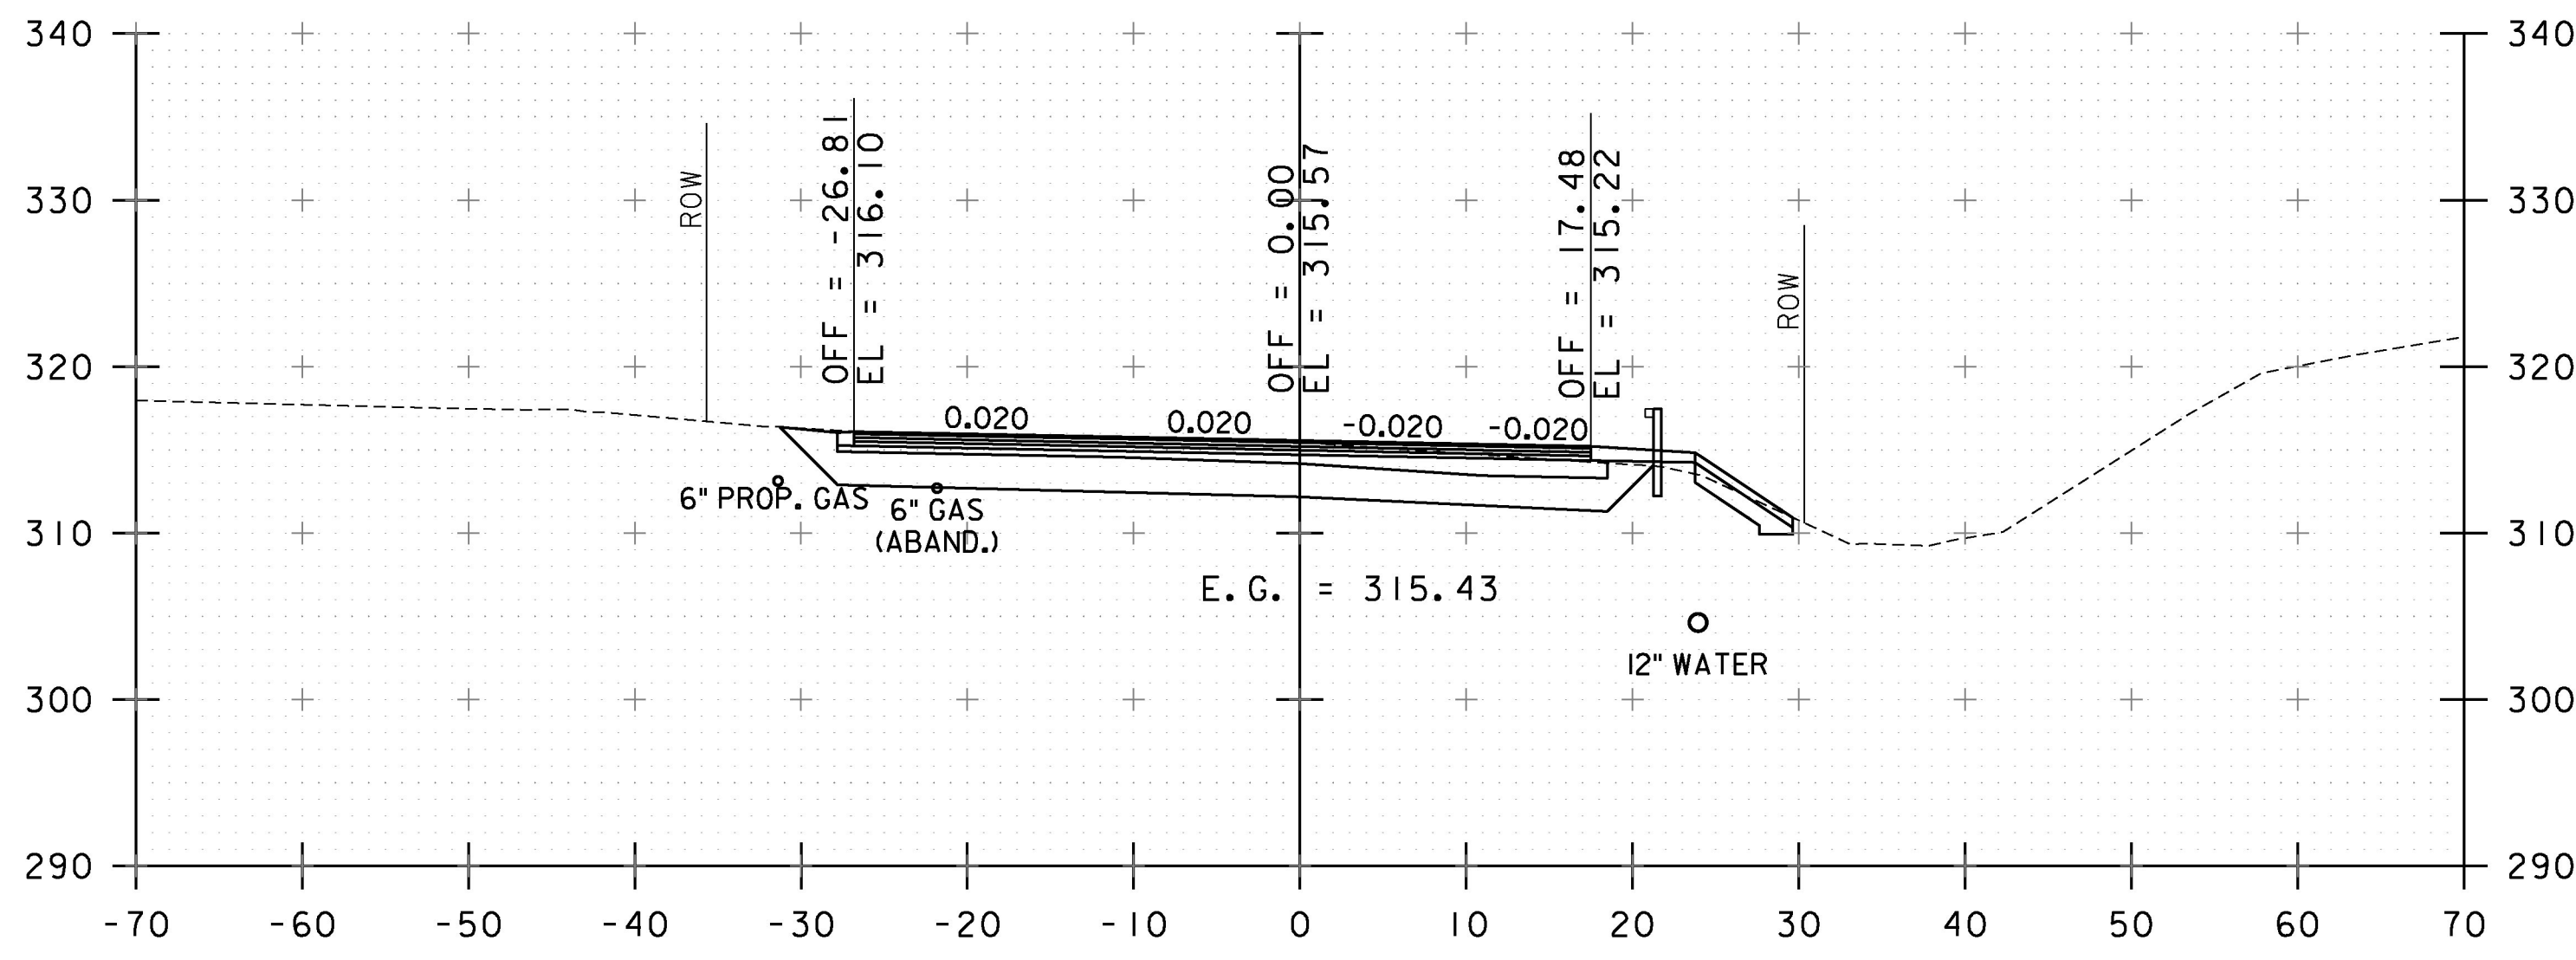


21+50

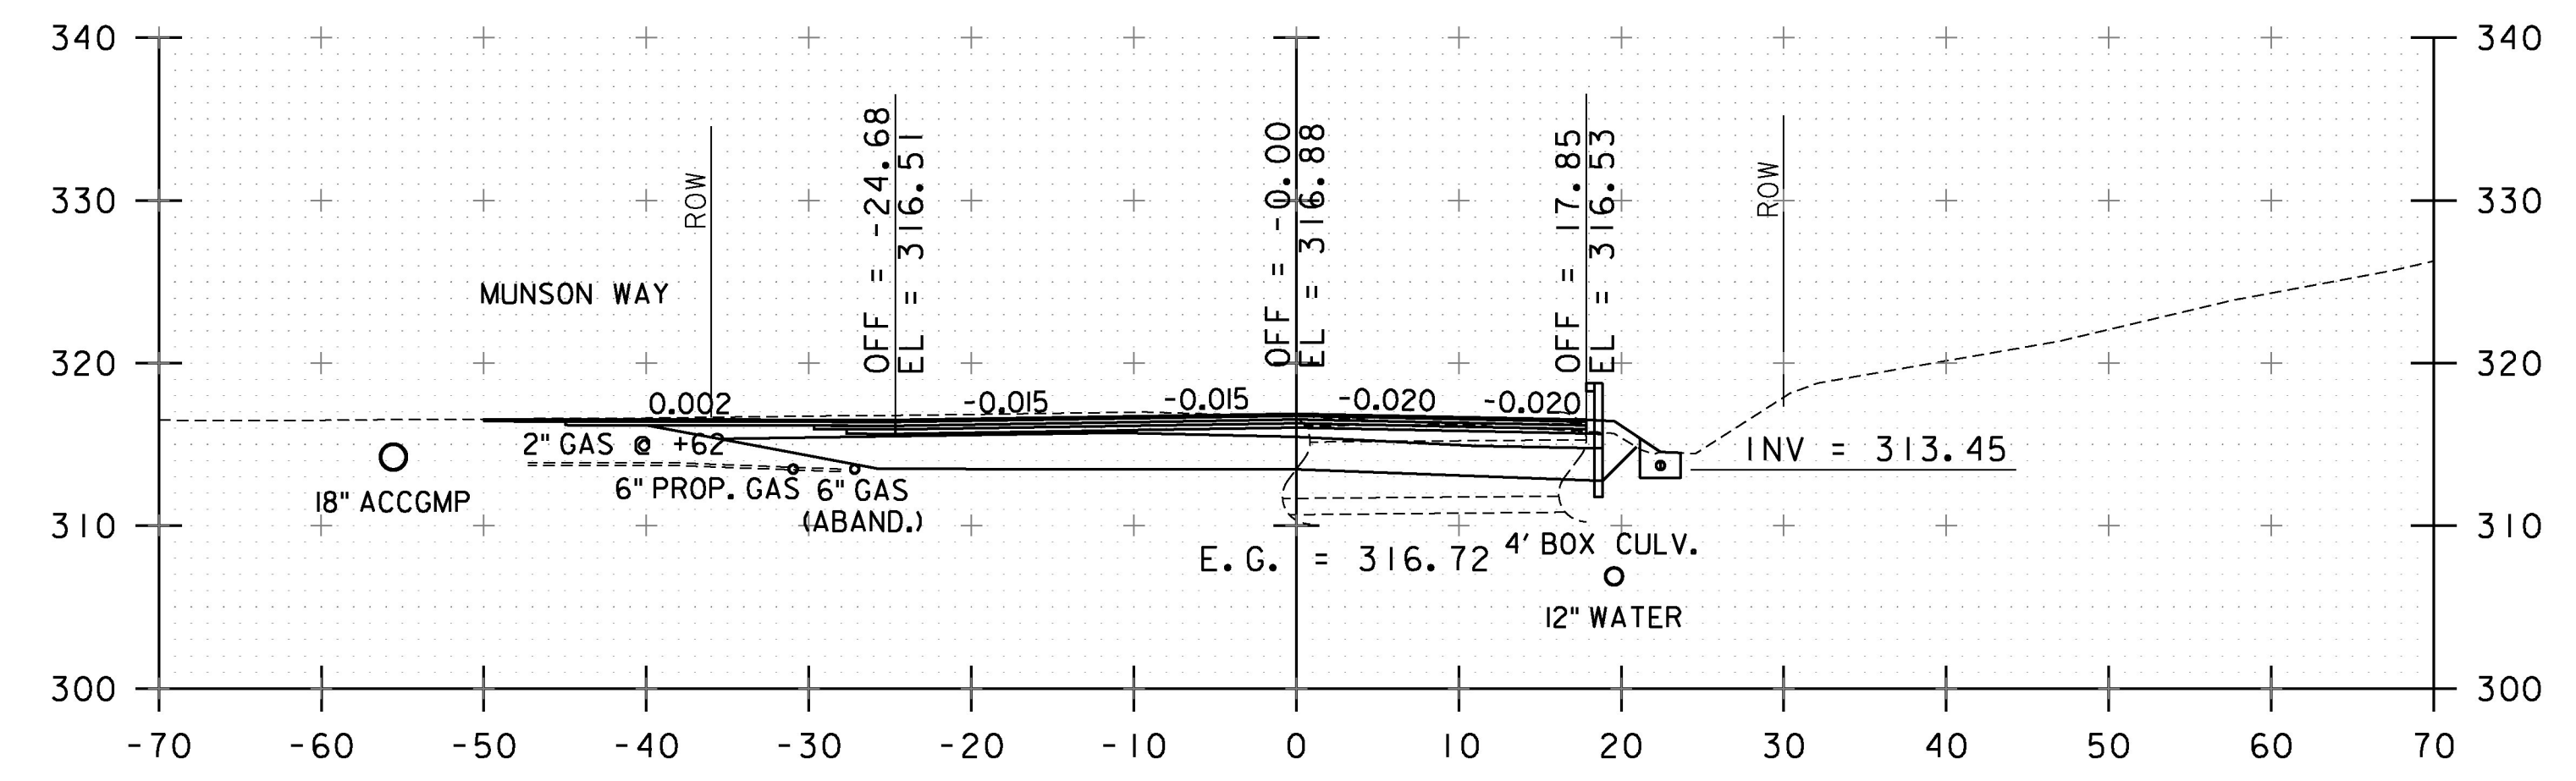


22+50

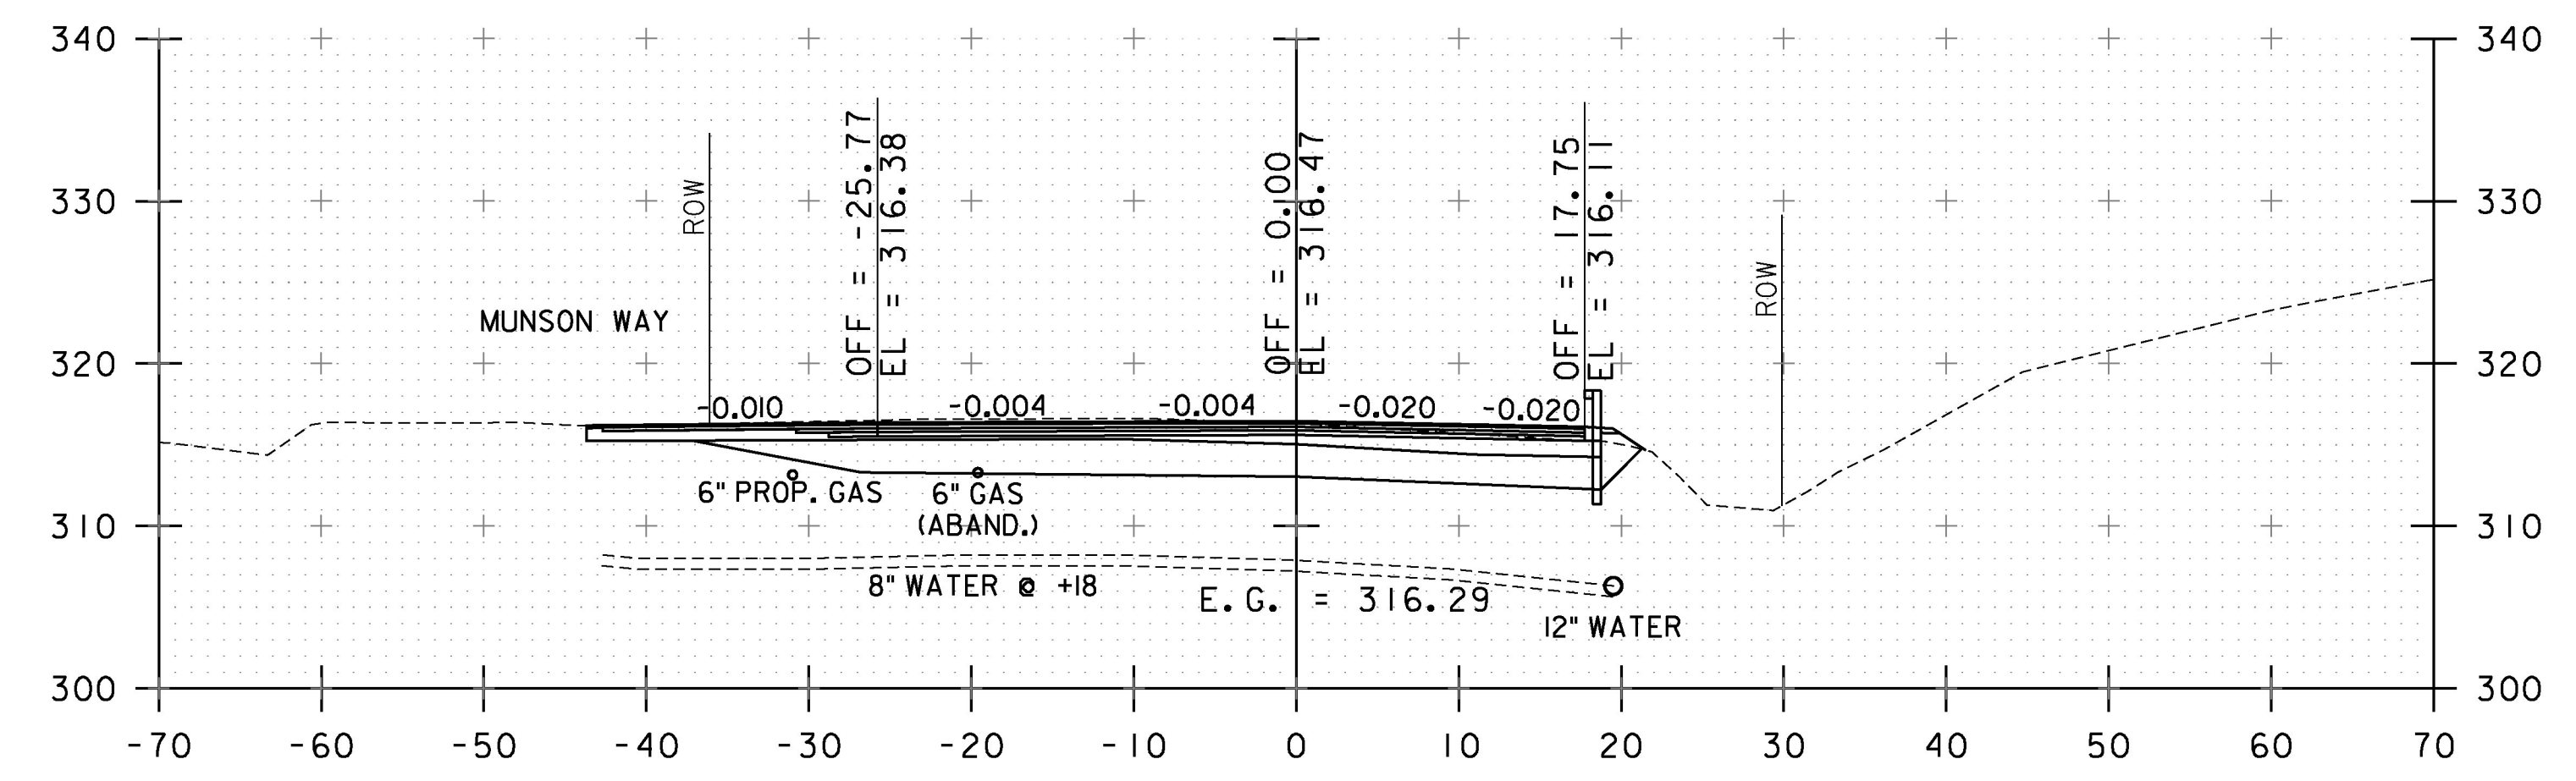

22+25

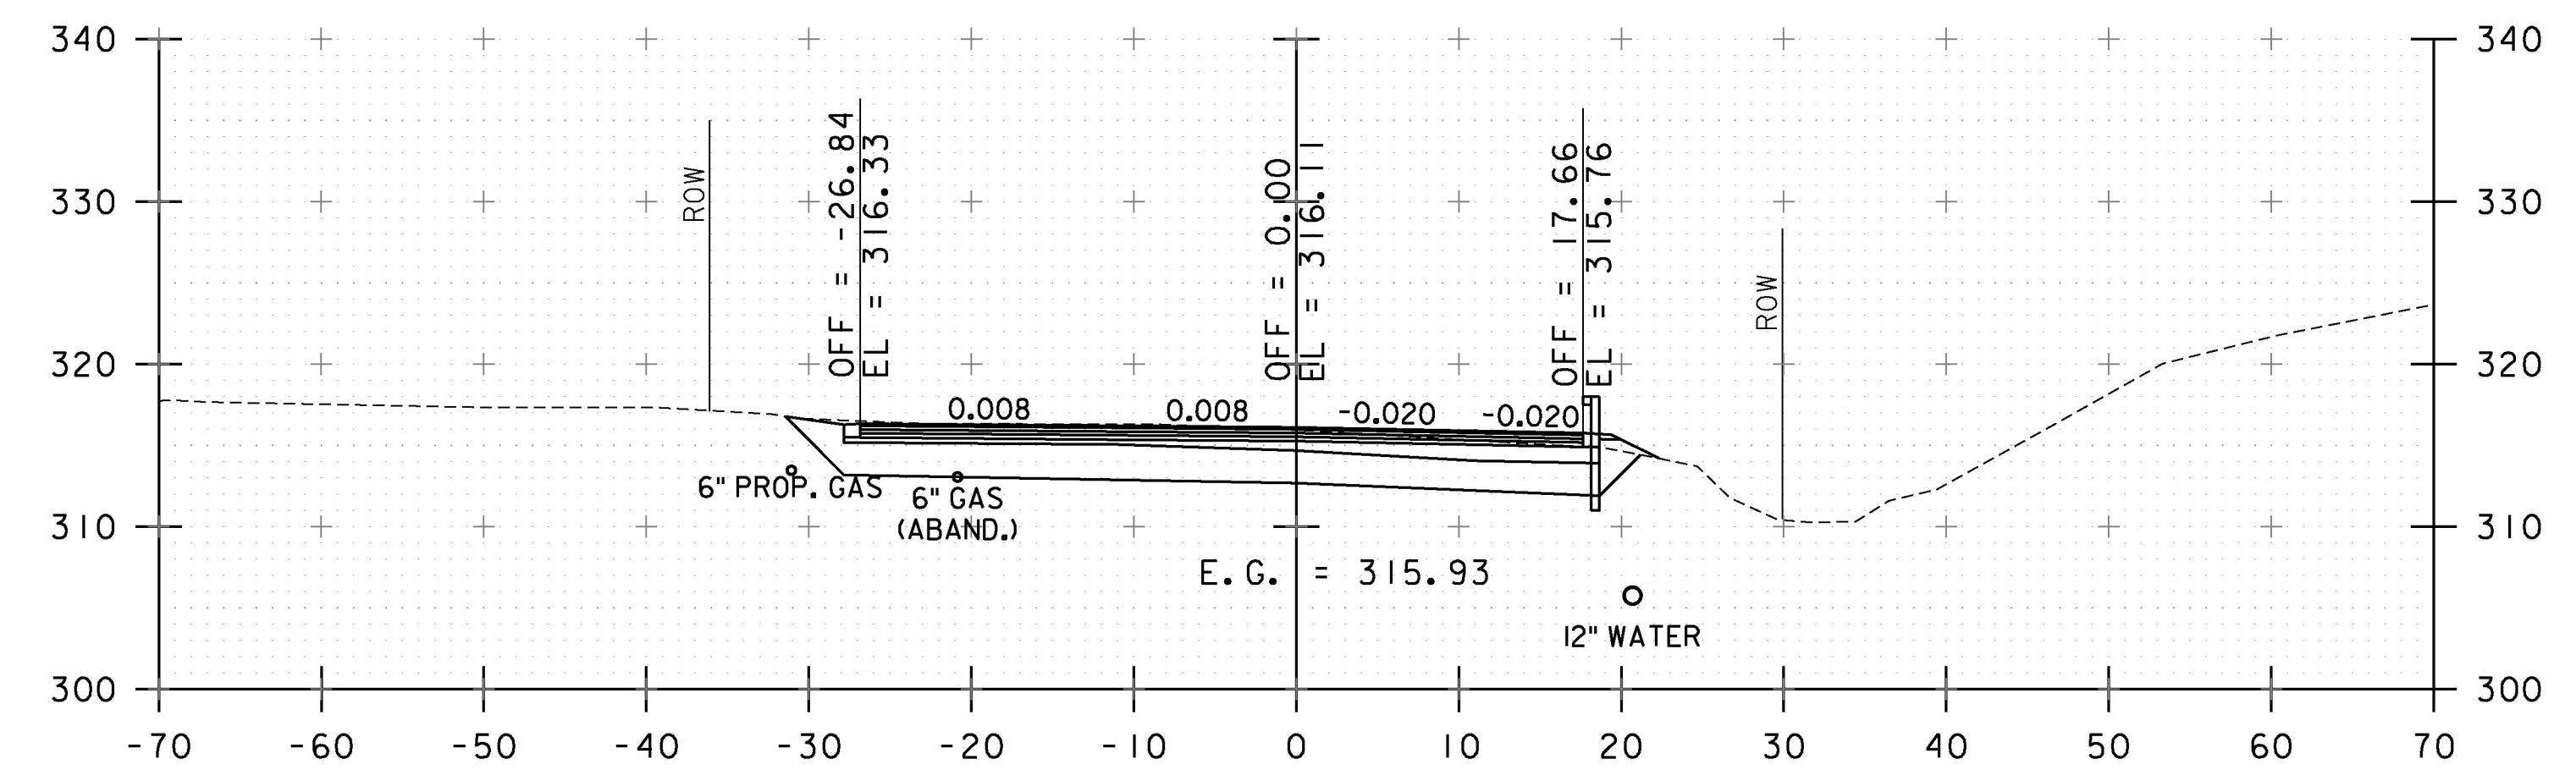

22+00

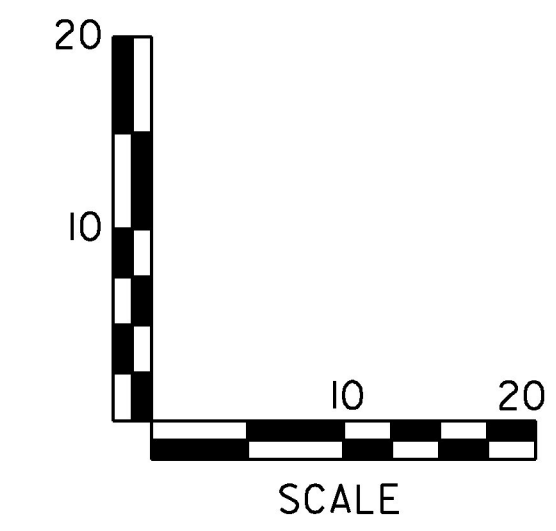

STA. W 21+50 TO STA. W 22+50

|                        |                            |
|------------------------|----------------------------|
| PROJECT NAME:          | SOUTH BURLINGTON-WILLISTON |
| PROJECT NUMBER:        | NH 2944(I)                 |
| FILE NAME:             | z1ld340xsl.dgn             |
| PROJECT LEADER:        | G. EDWARDS                 |
| DESIGNED BY:           | I. MAYNARD                 |
| CROSS SECTION SHEET 29 |                            |
| PLOT DATE:             | 2/15/2017                  |
| DRAWN BY:              | I. MAYNARD                 |
| CHECKED BY:            | J. LITTLE                  |
| SHEET                  | 149 OF 249                 |