




27+25

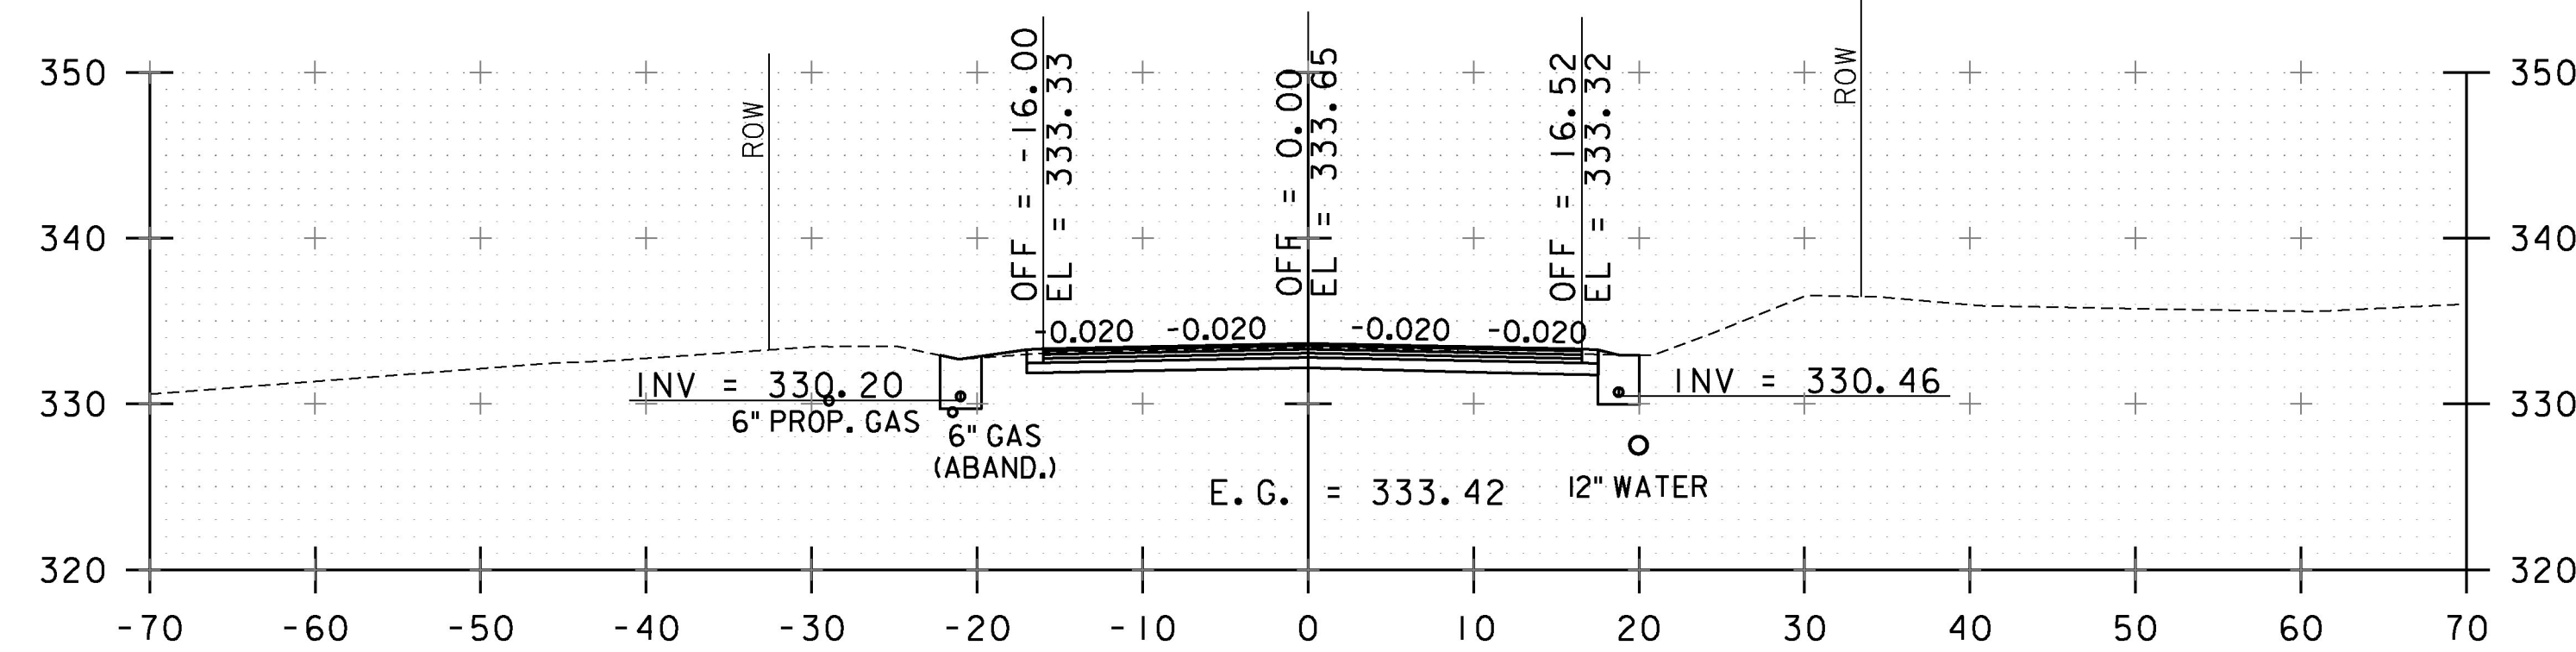


28+00

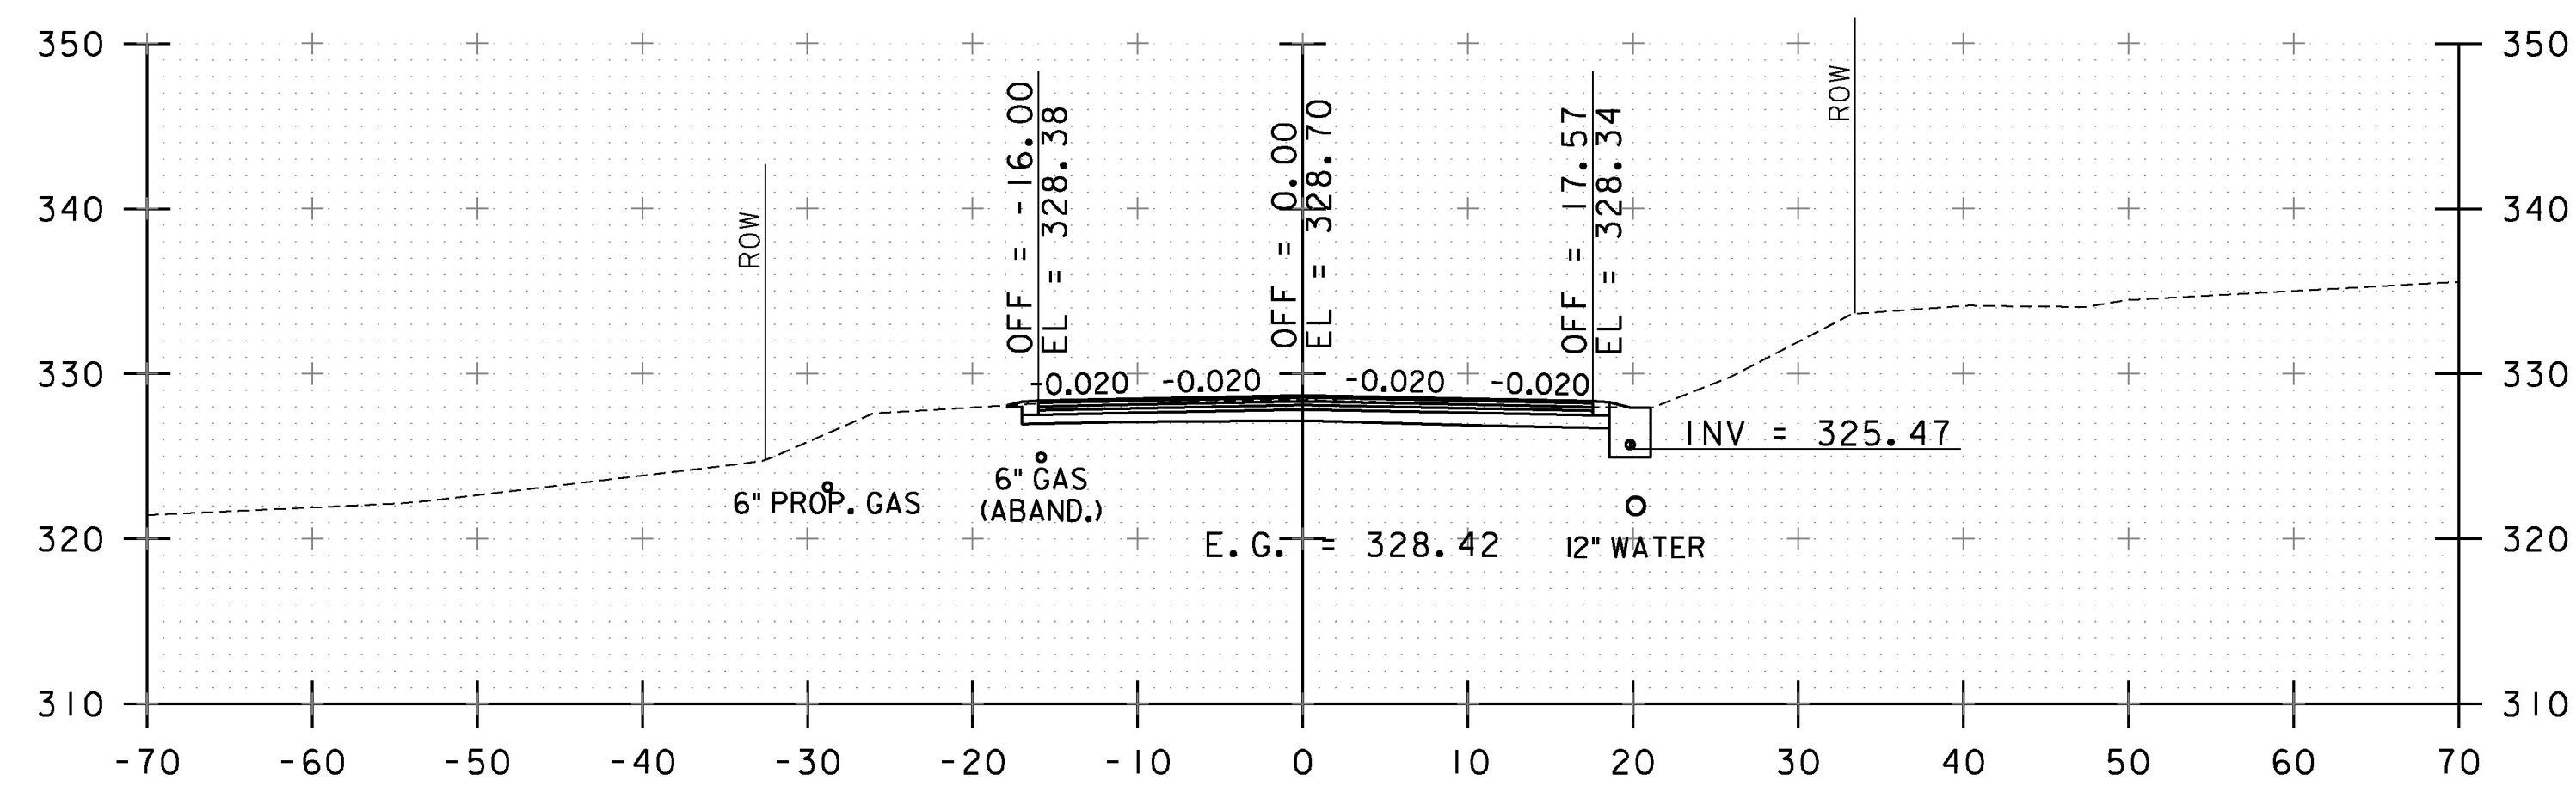


27+00

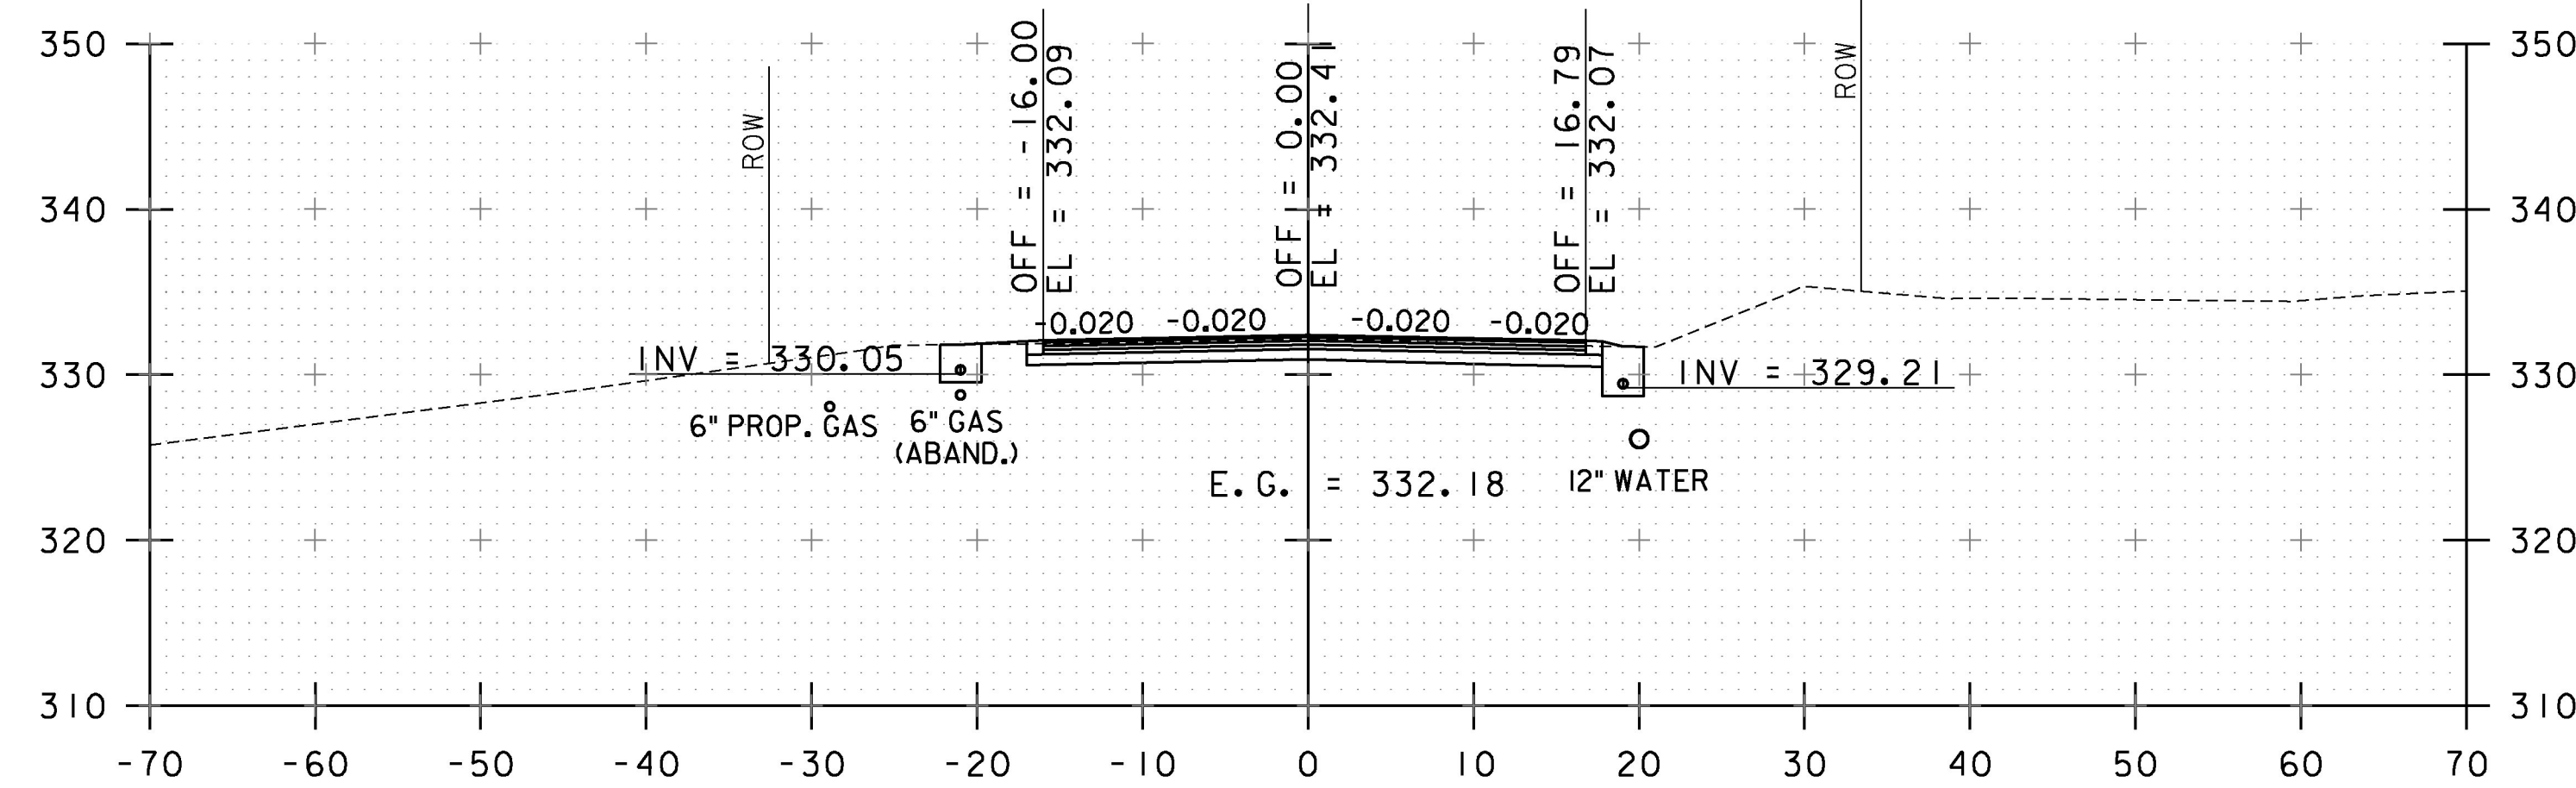


27+75

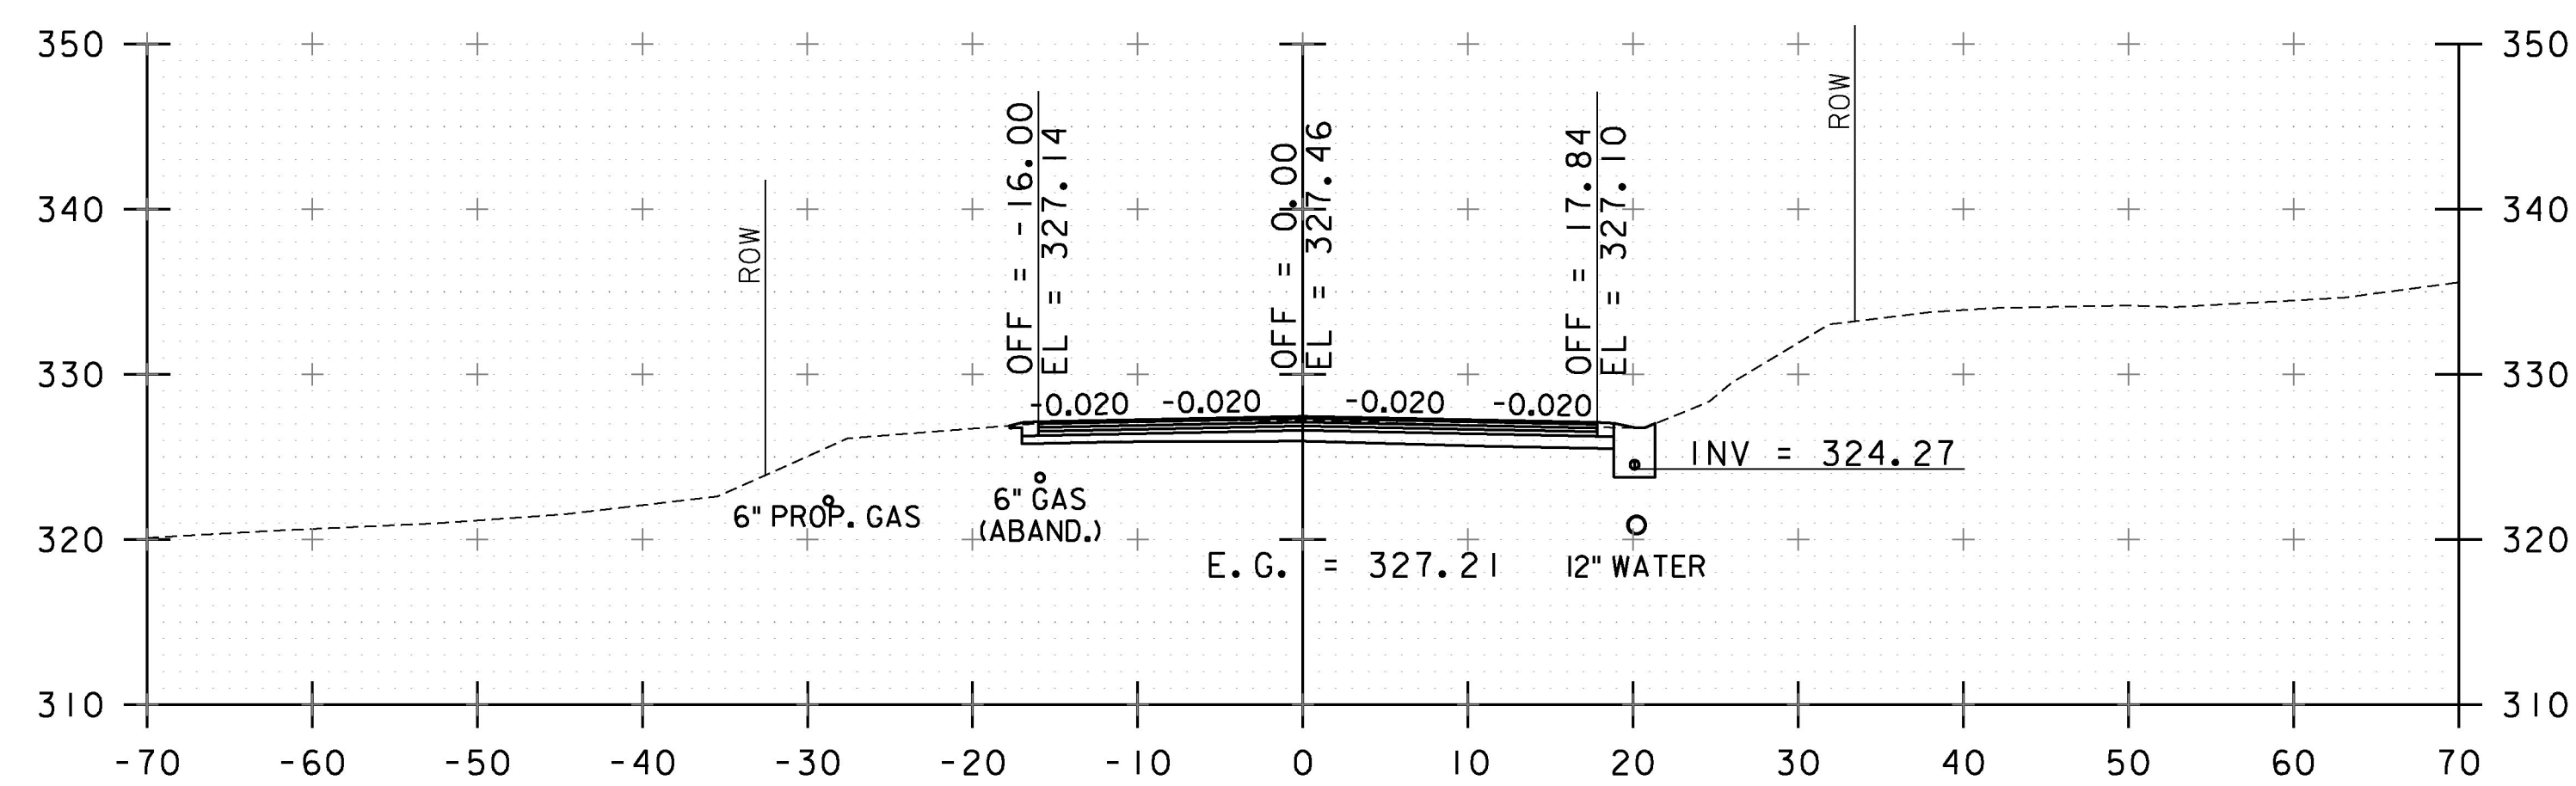

26+75

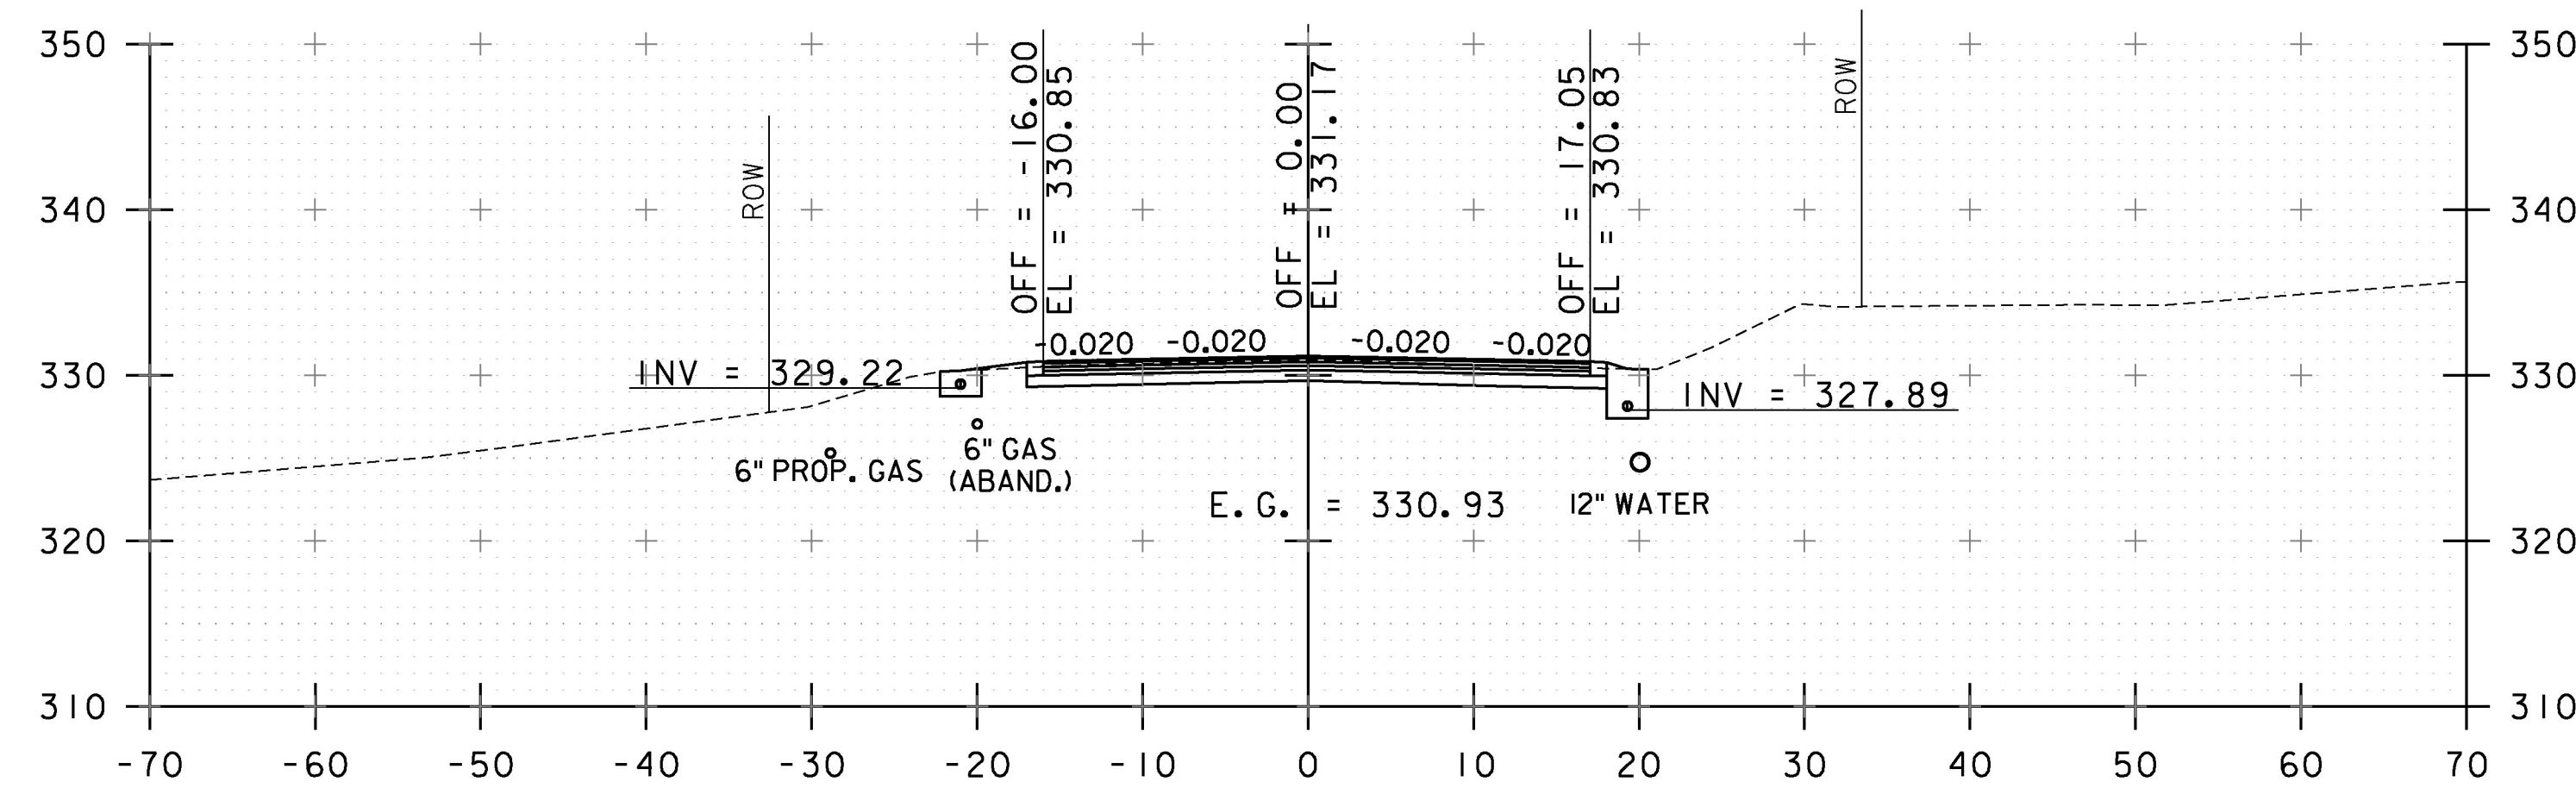

27+50

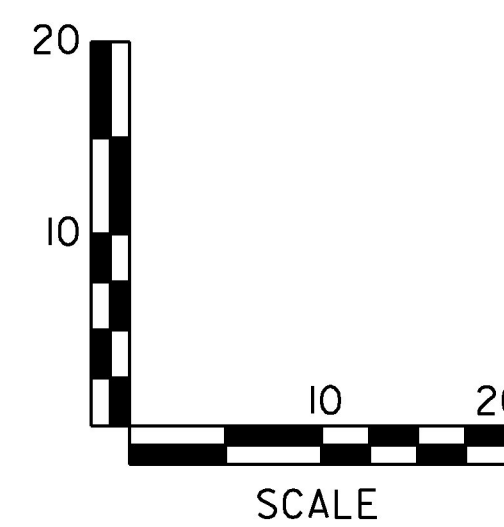

SCALE STA. W 26+75 TO STA. W 28+00

PROJECT NAME: SOUTH BURLINGTON-WILLISTON	
PROJECT NUMBER: NH 2944(I)	
FILE NAME: zild340xst.dgn	PLOT DATE: 2/15/2017
PROJECT LEADER: G. EDWARDS	DRAWN BY: I. MAYNARD
DESIGNED BY: I. MAYNARD	CHECKED BY: J. LITTLE
CROSS SECTION SHEET 34	SHEET 154 OF 249