




46+75

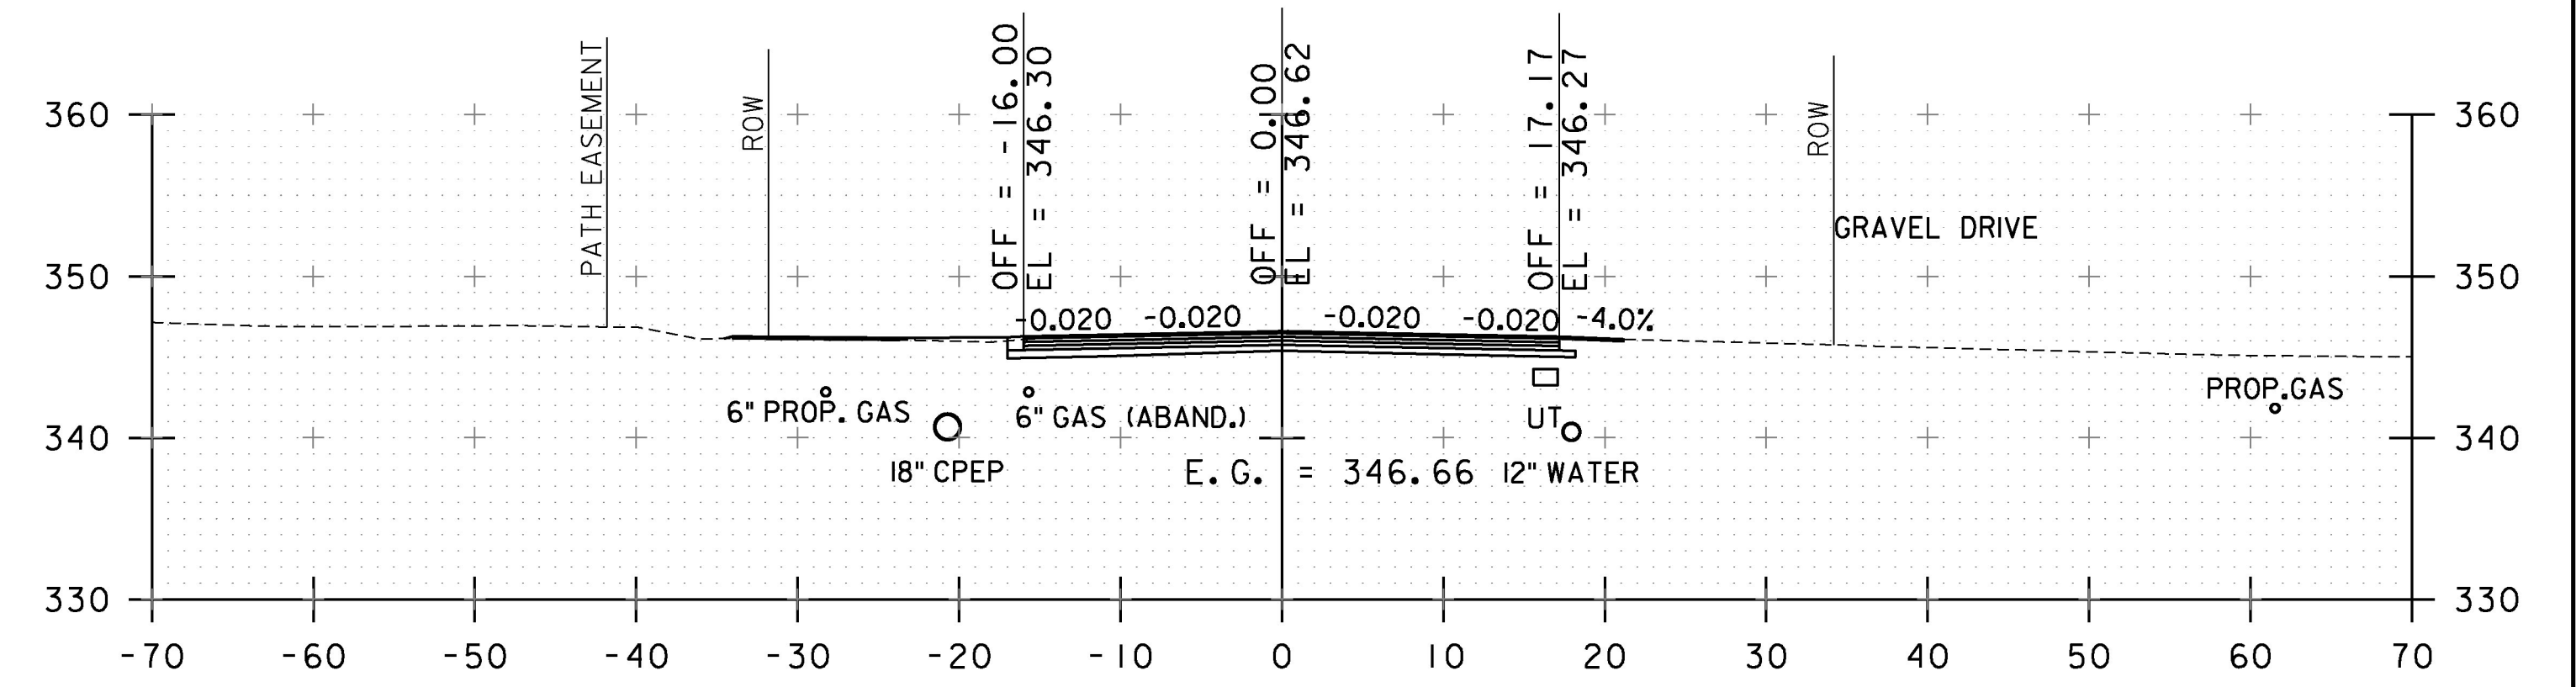


47+50

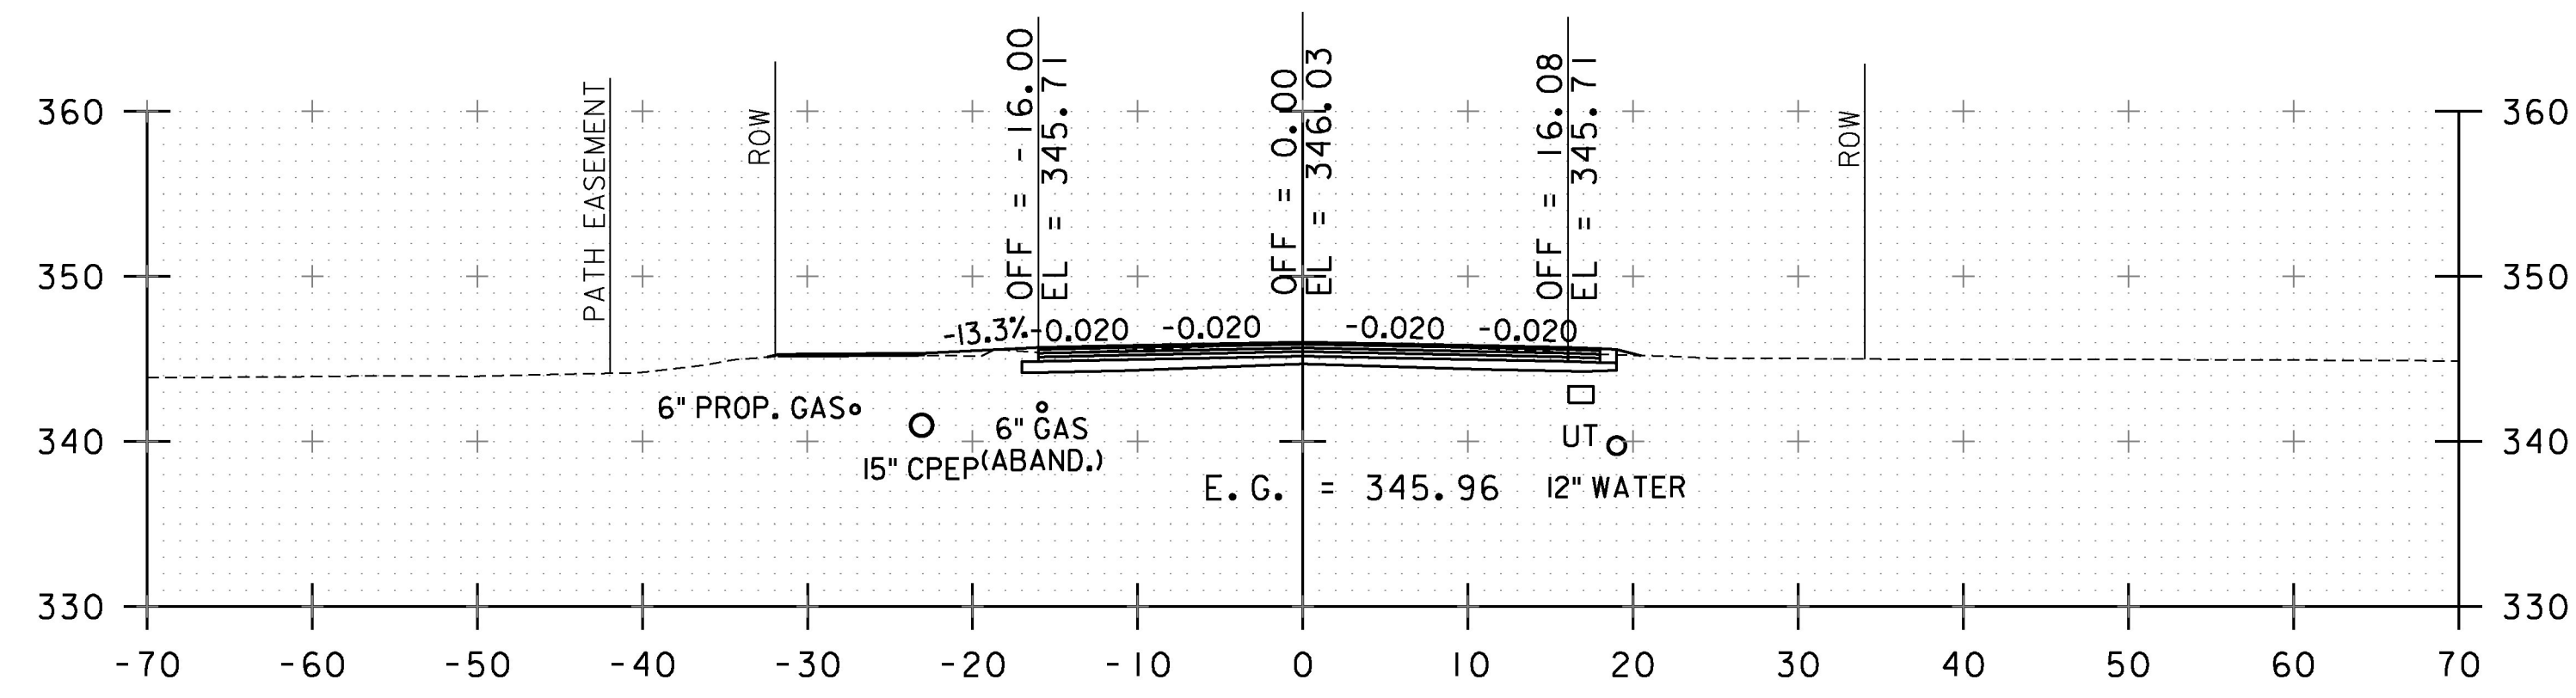


46+50

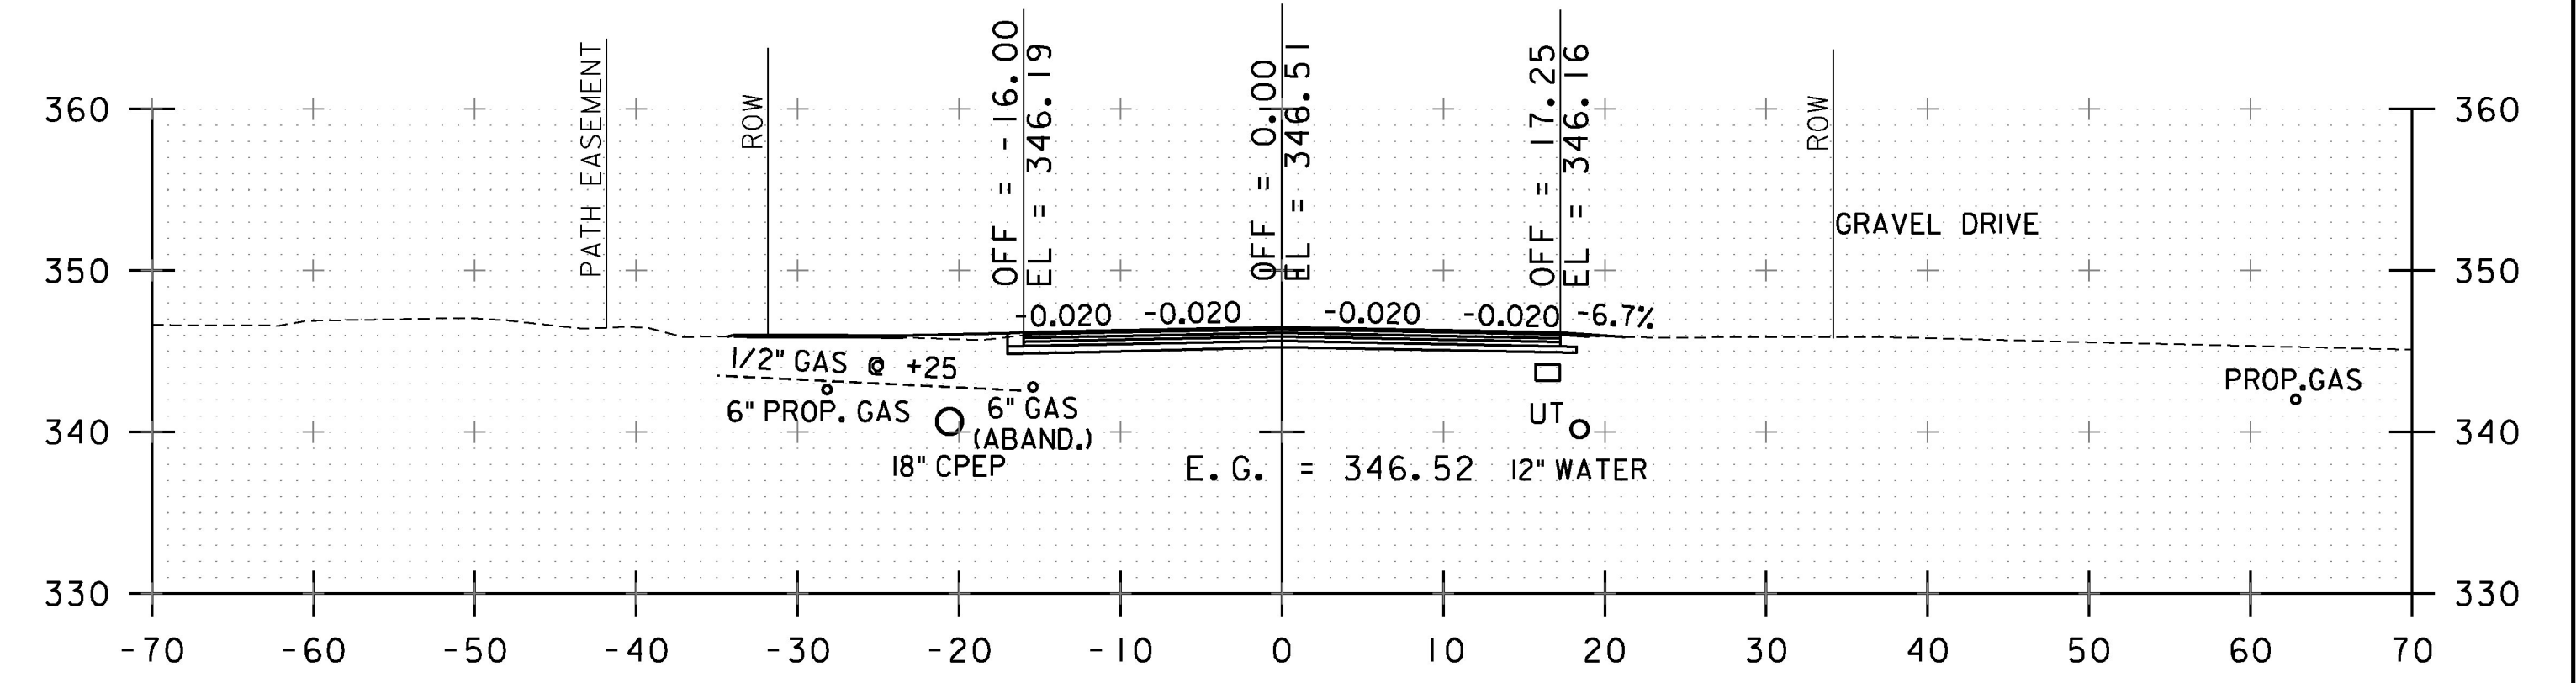


47+25

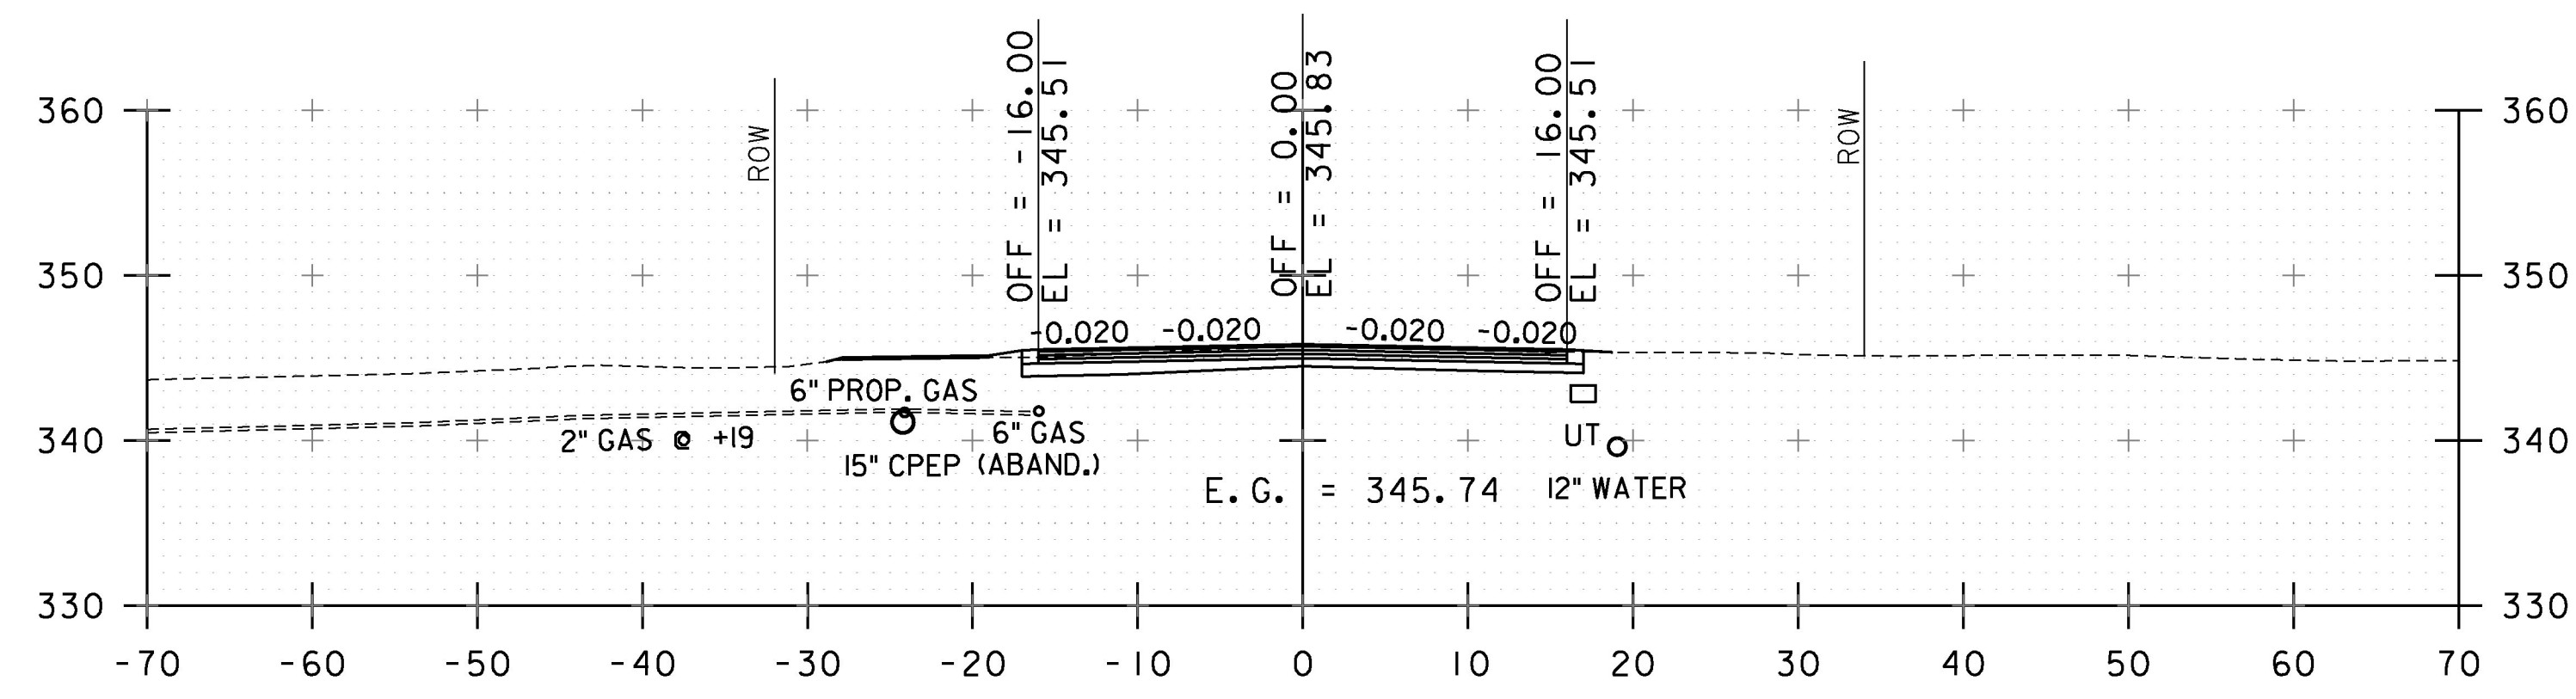

46+25

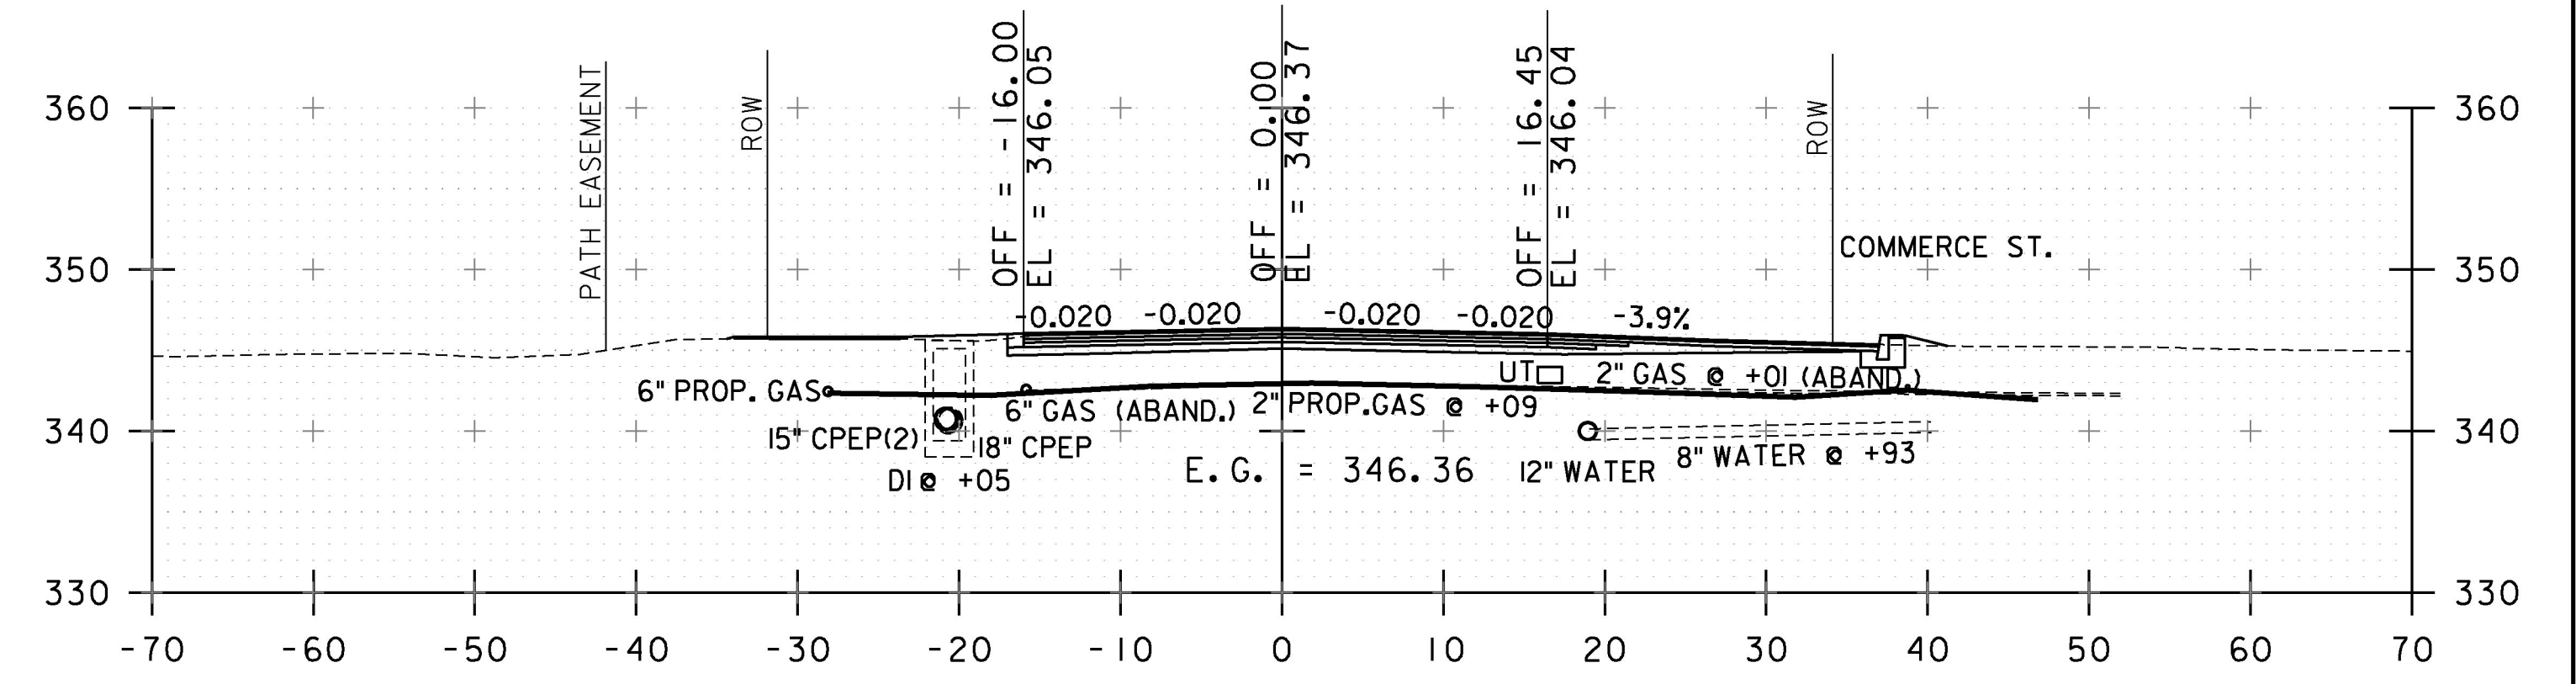

47+00

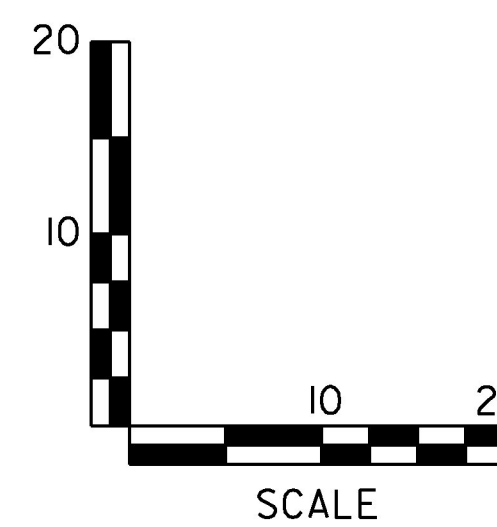

SCALE

STA. W 46+25 TO STA. W 47+50

PROJECT NAME: SOUTH BURLINGTON-WILLISTON	
PROJECT NUMBER: NH 2944(I)	
FILE NAME: z1ld340xsl.dgn	PLOT DATE: 2/15/2017
PROJECT LEADER: G. EDWARDS	DRAWN BY: I. MAYNARD
DESIGNED BY: I. MAYNARD	CHECKED BY: J. LITTLE
CROSS SECTION SHEET 47	SHEET 167 OF 249