




54+25 END TRANSITION  
BEGIN FULL DEPTH UNDERCUT

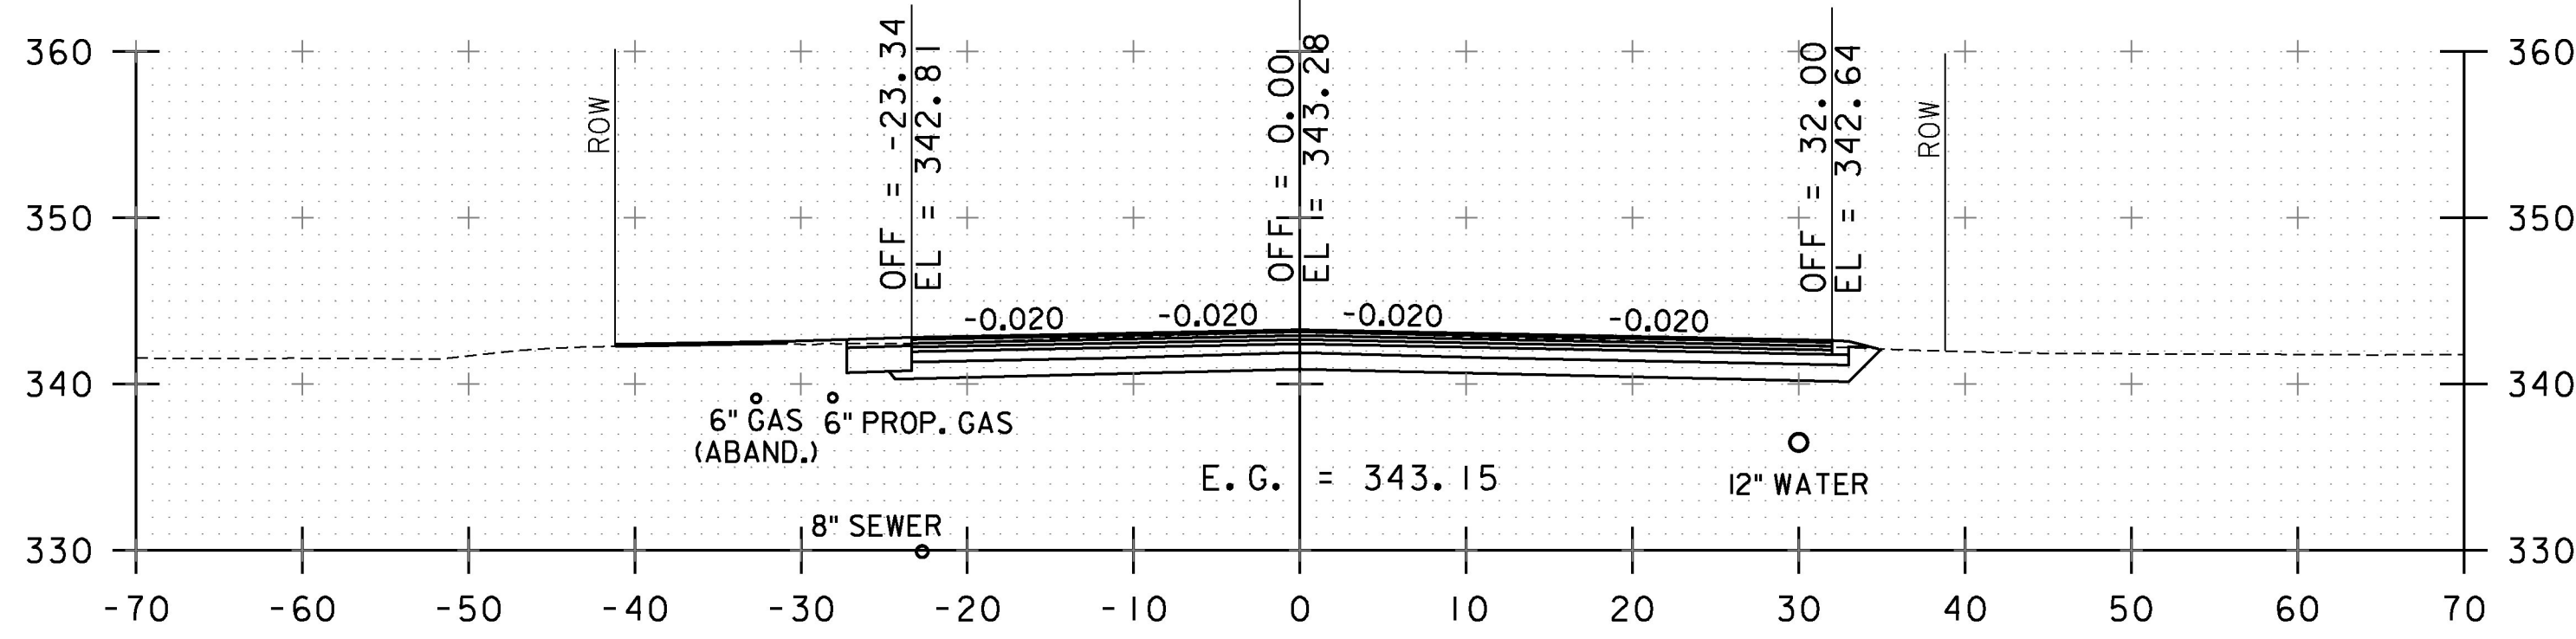


54+00

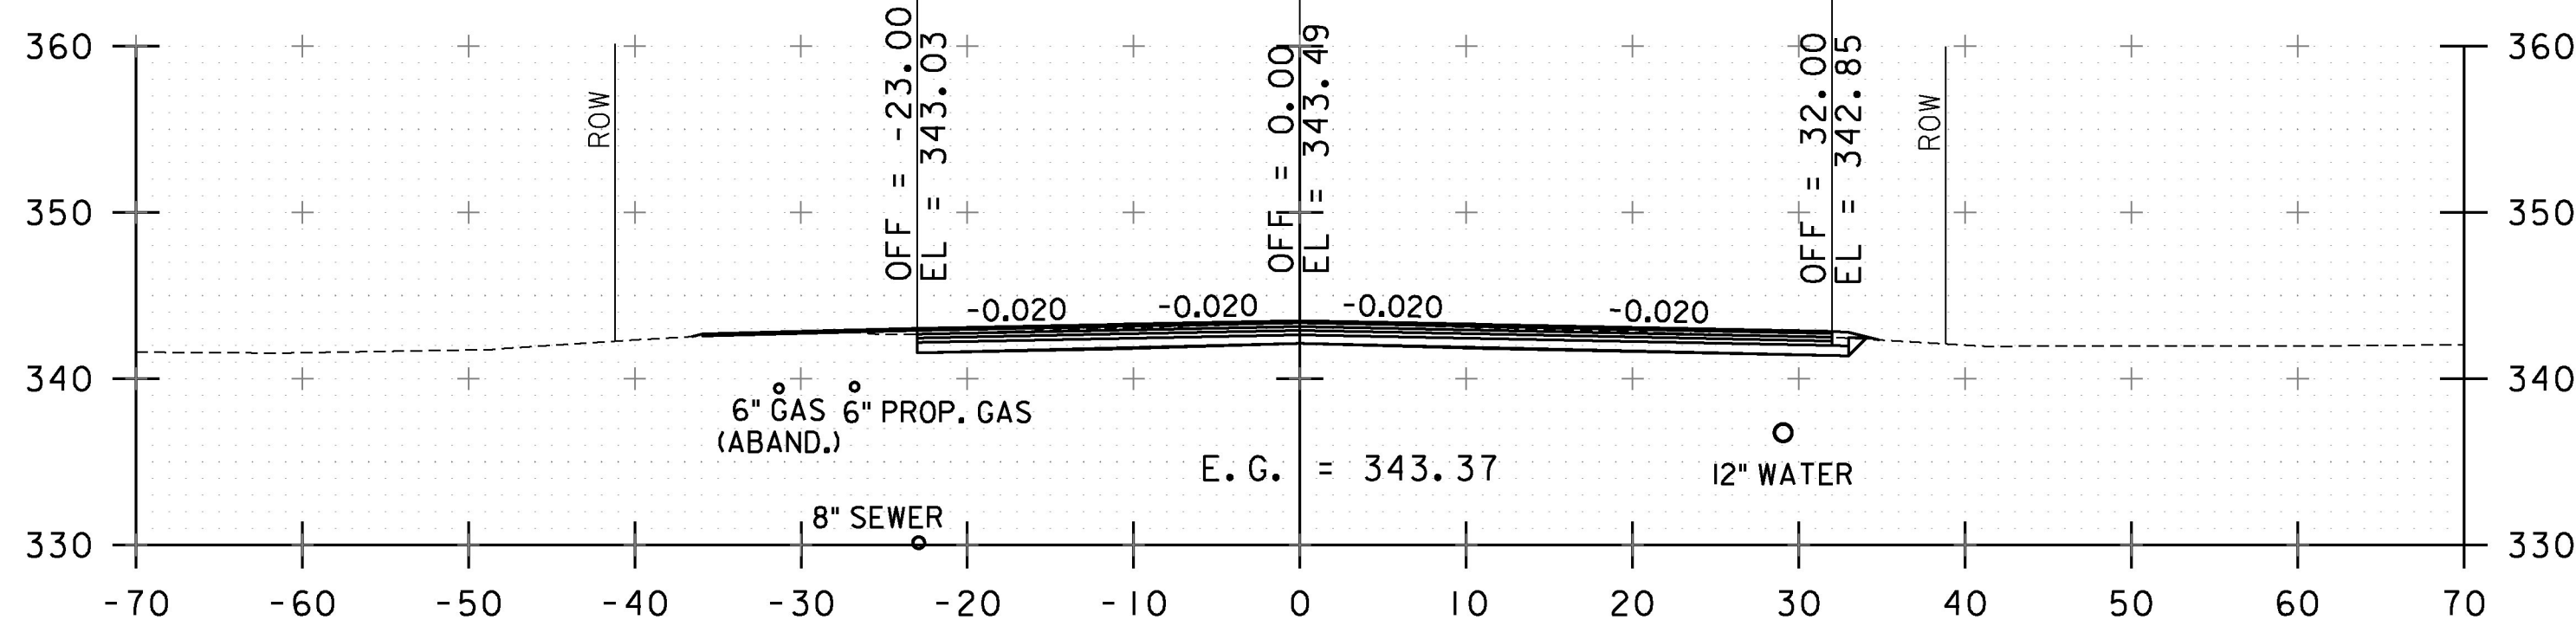


53+75  
BEGIN UNDERCUT TRANSITION

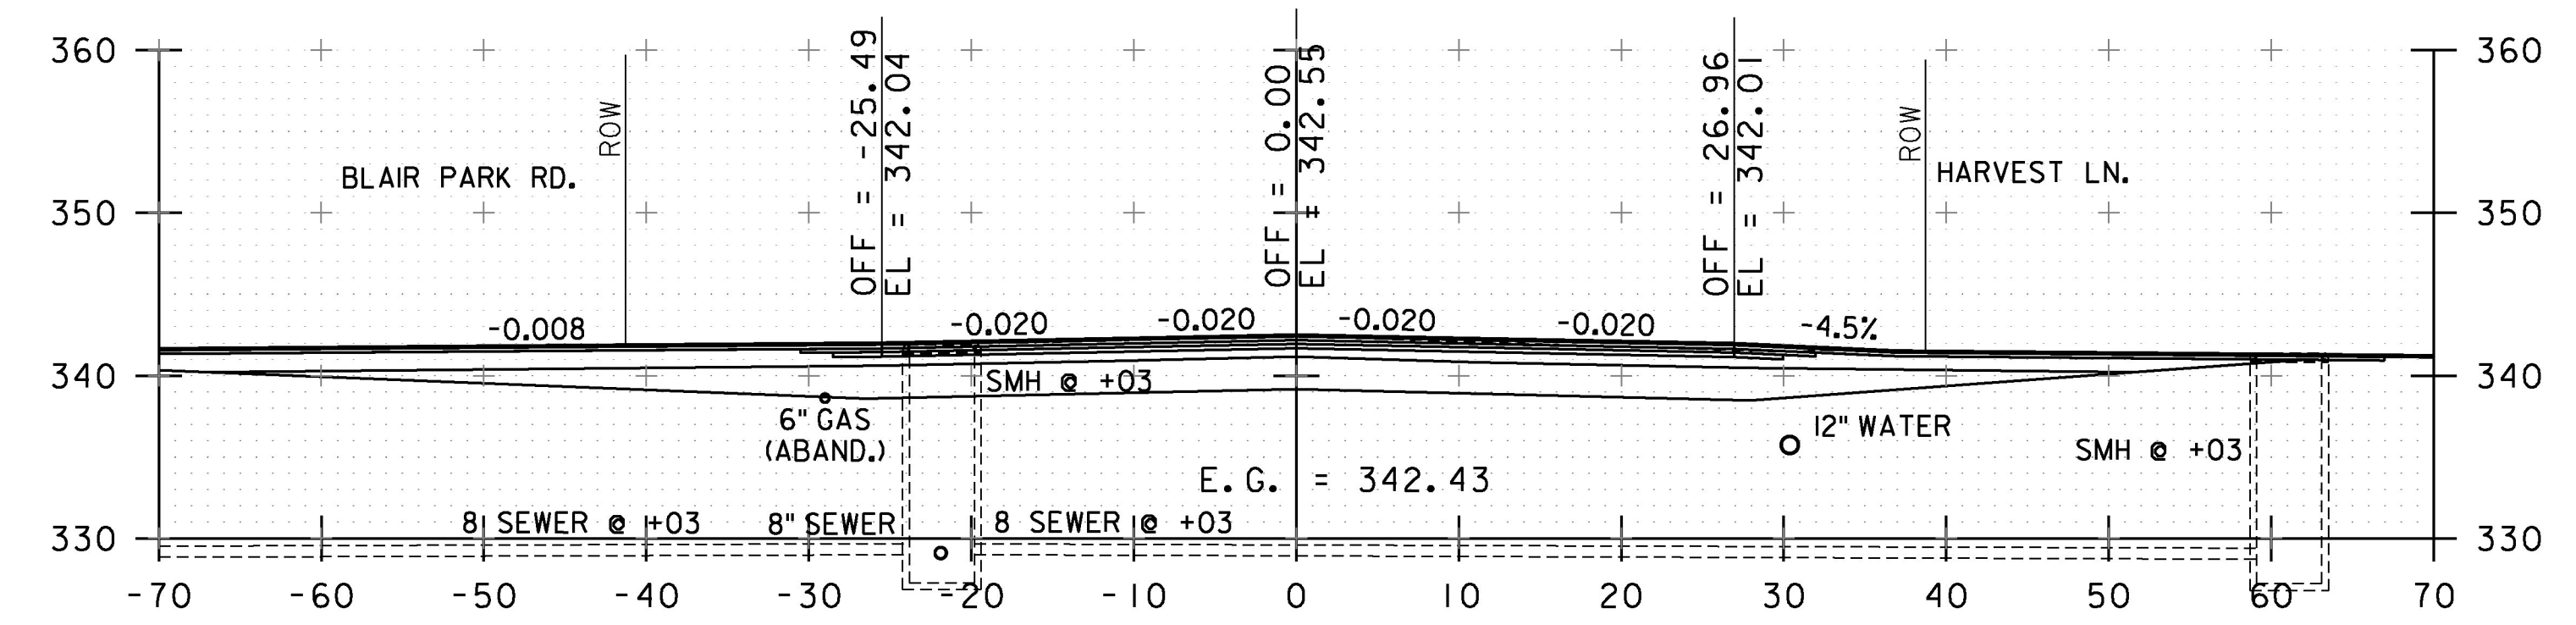


55+00

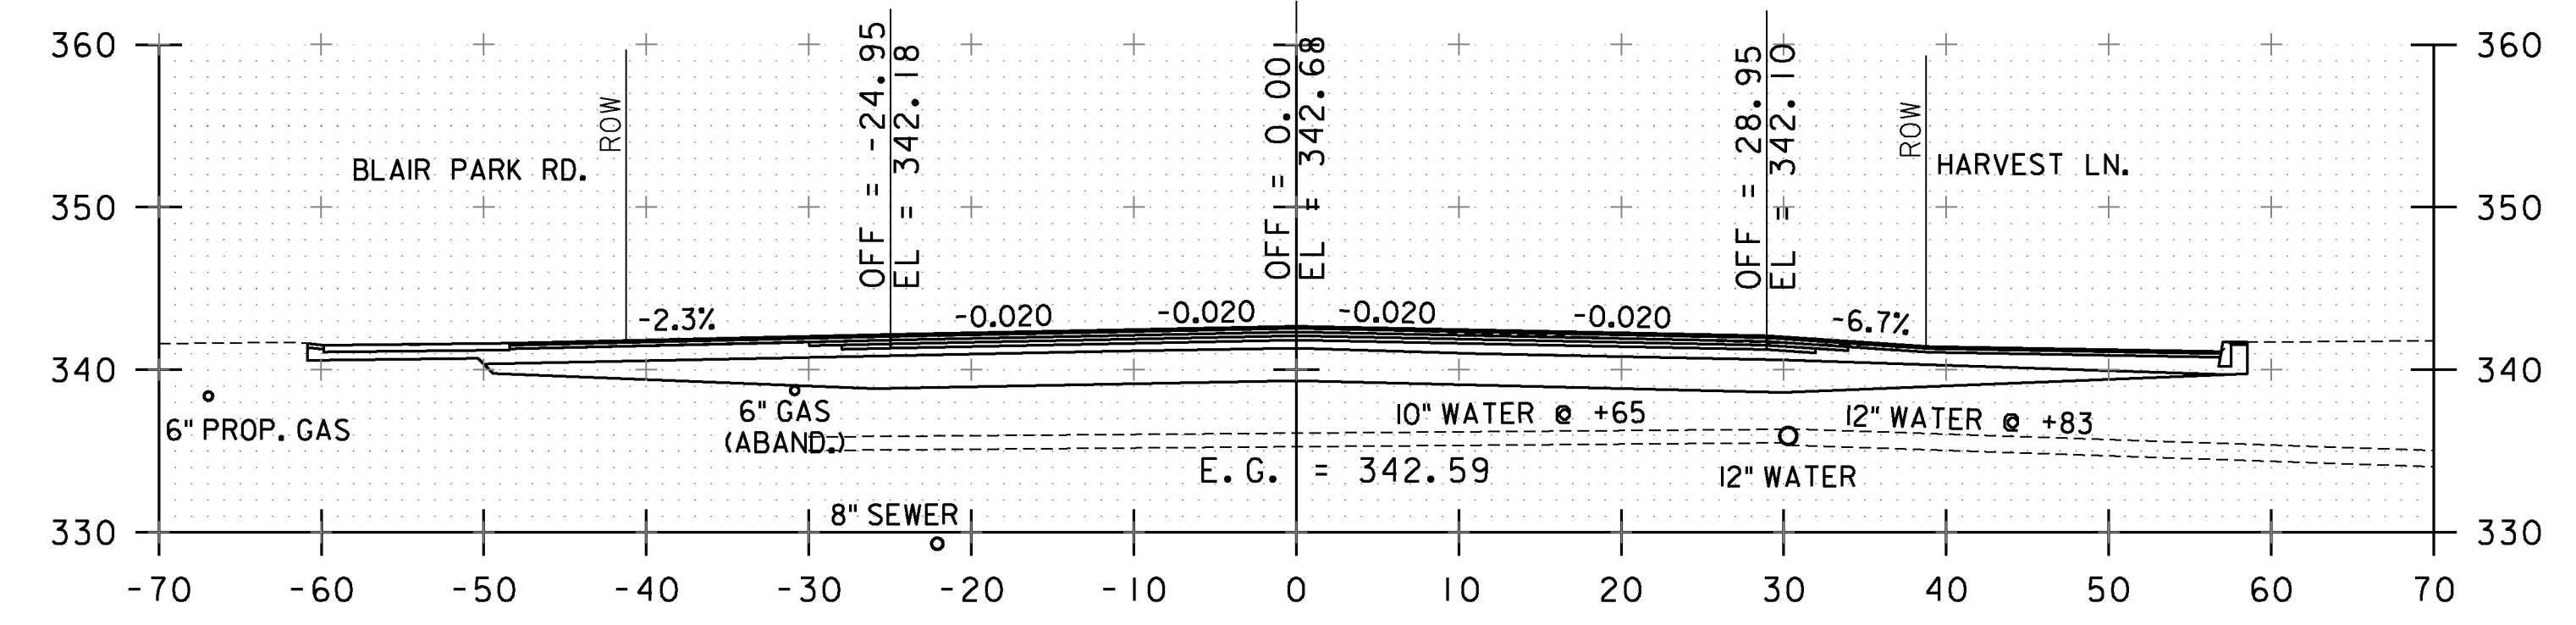

54+75

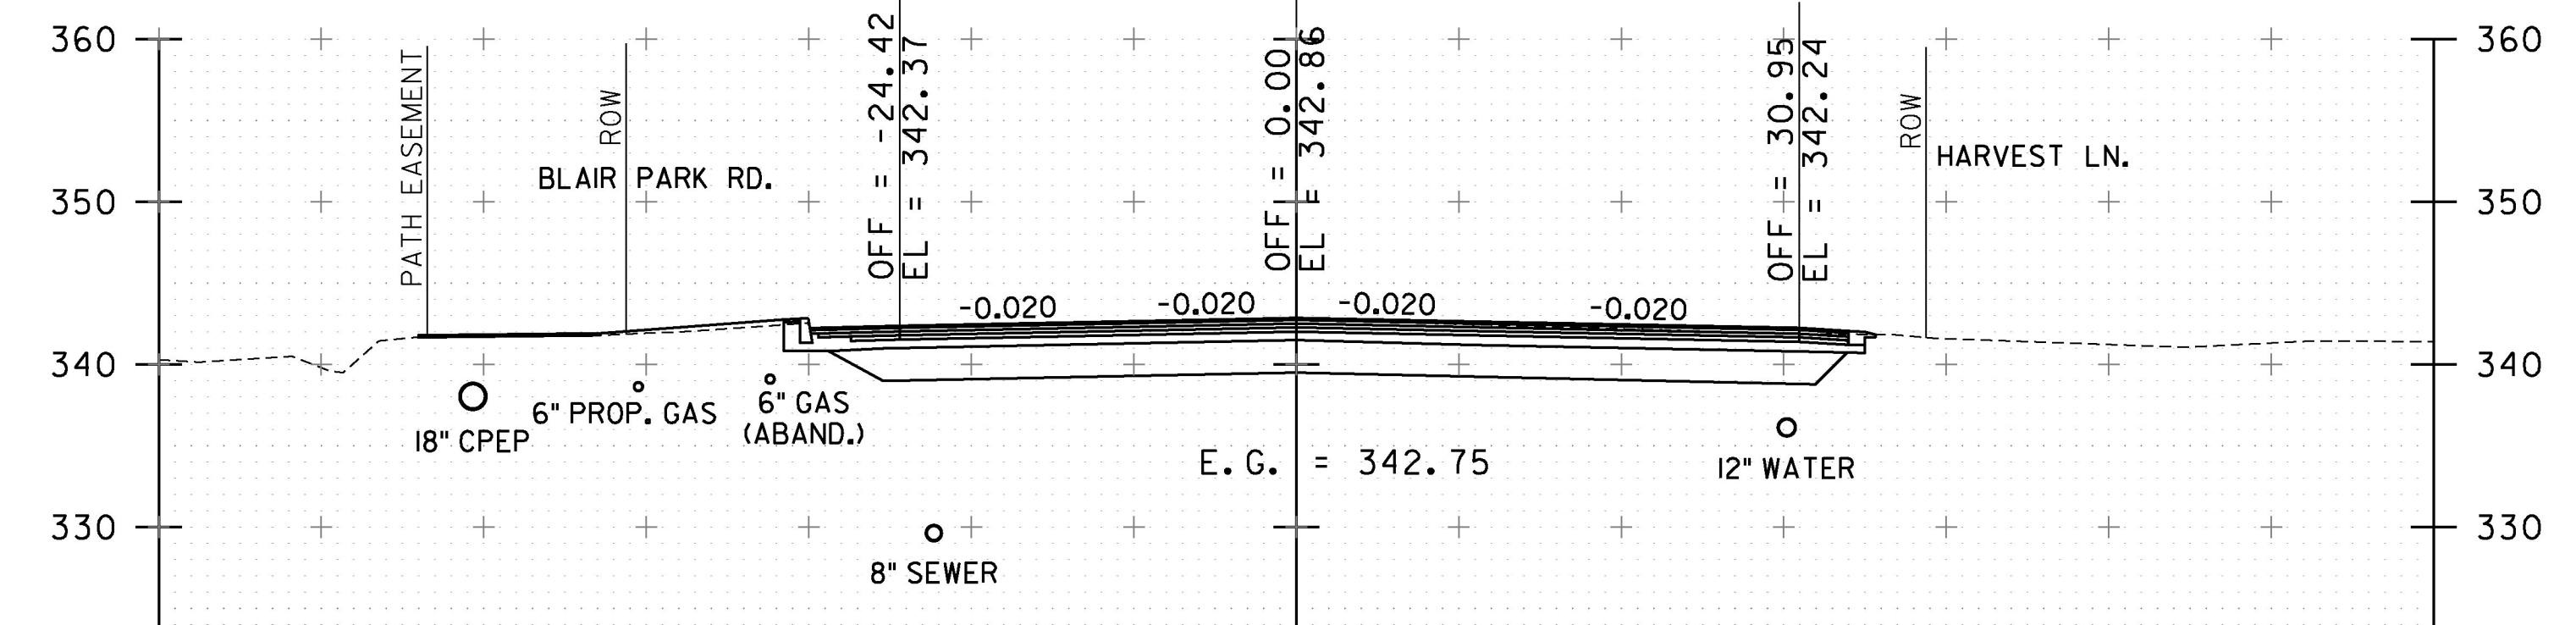

54+50

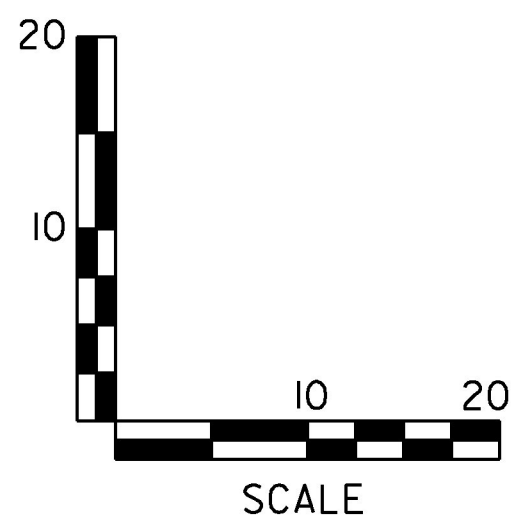

STA. W 53+75 TO STA. W 55+00

PROJECT NAME:	SOUTH BURLINGTON-WILLISTON
PROJECT NUMBER:	NH 2944(I)
FILE NAME:	zild340xsl.dgn
PROJECT LEADER:	G. EDWARDS
DESIGNED BY:	I. MAYNARD
CROSS SECTION SHEET 52	
PLOT DATE:	2/15/2017
DRAWN BY:	I. MAYNARD
CHECKED BY:	J. LITTLE
SHEET	172 OF 249