




69+25

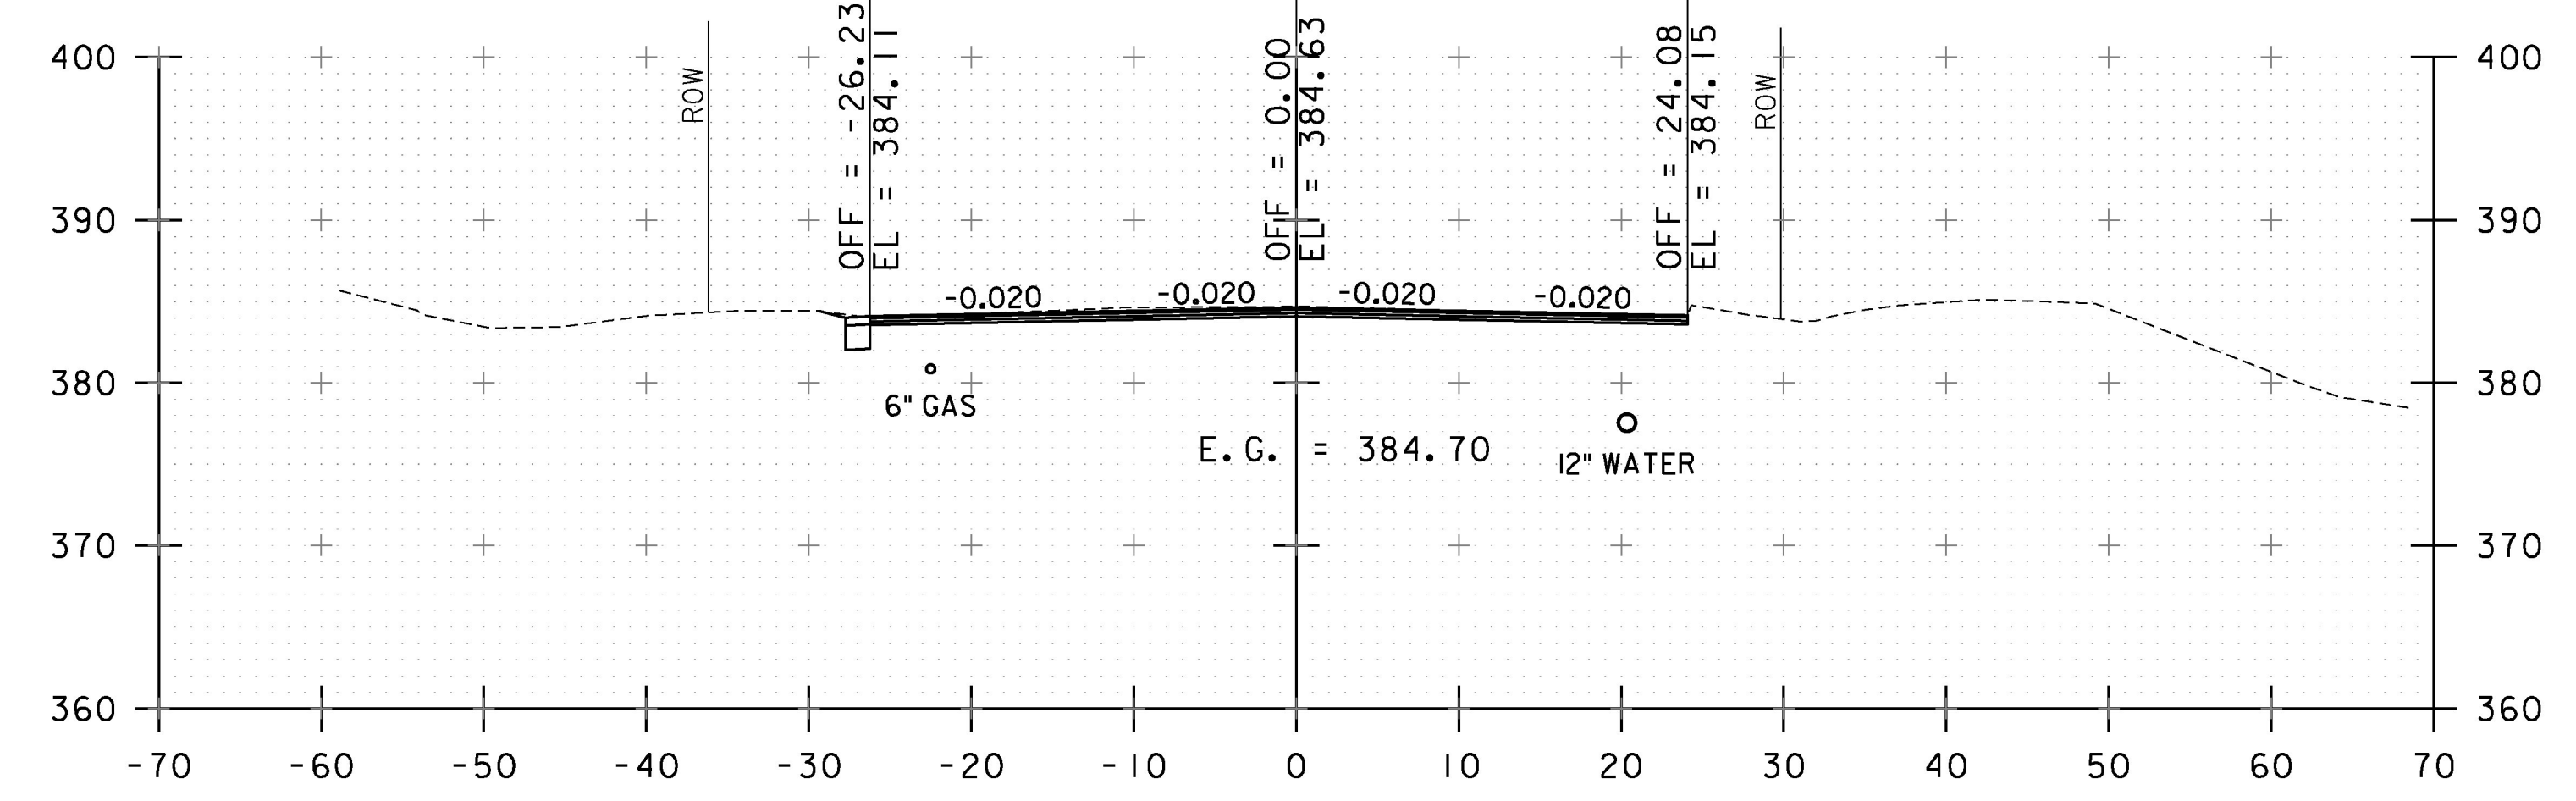

70+00

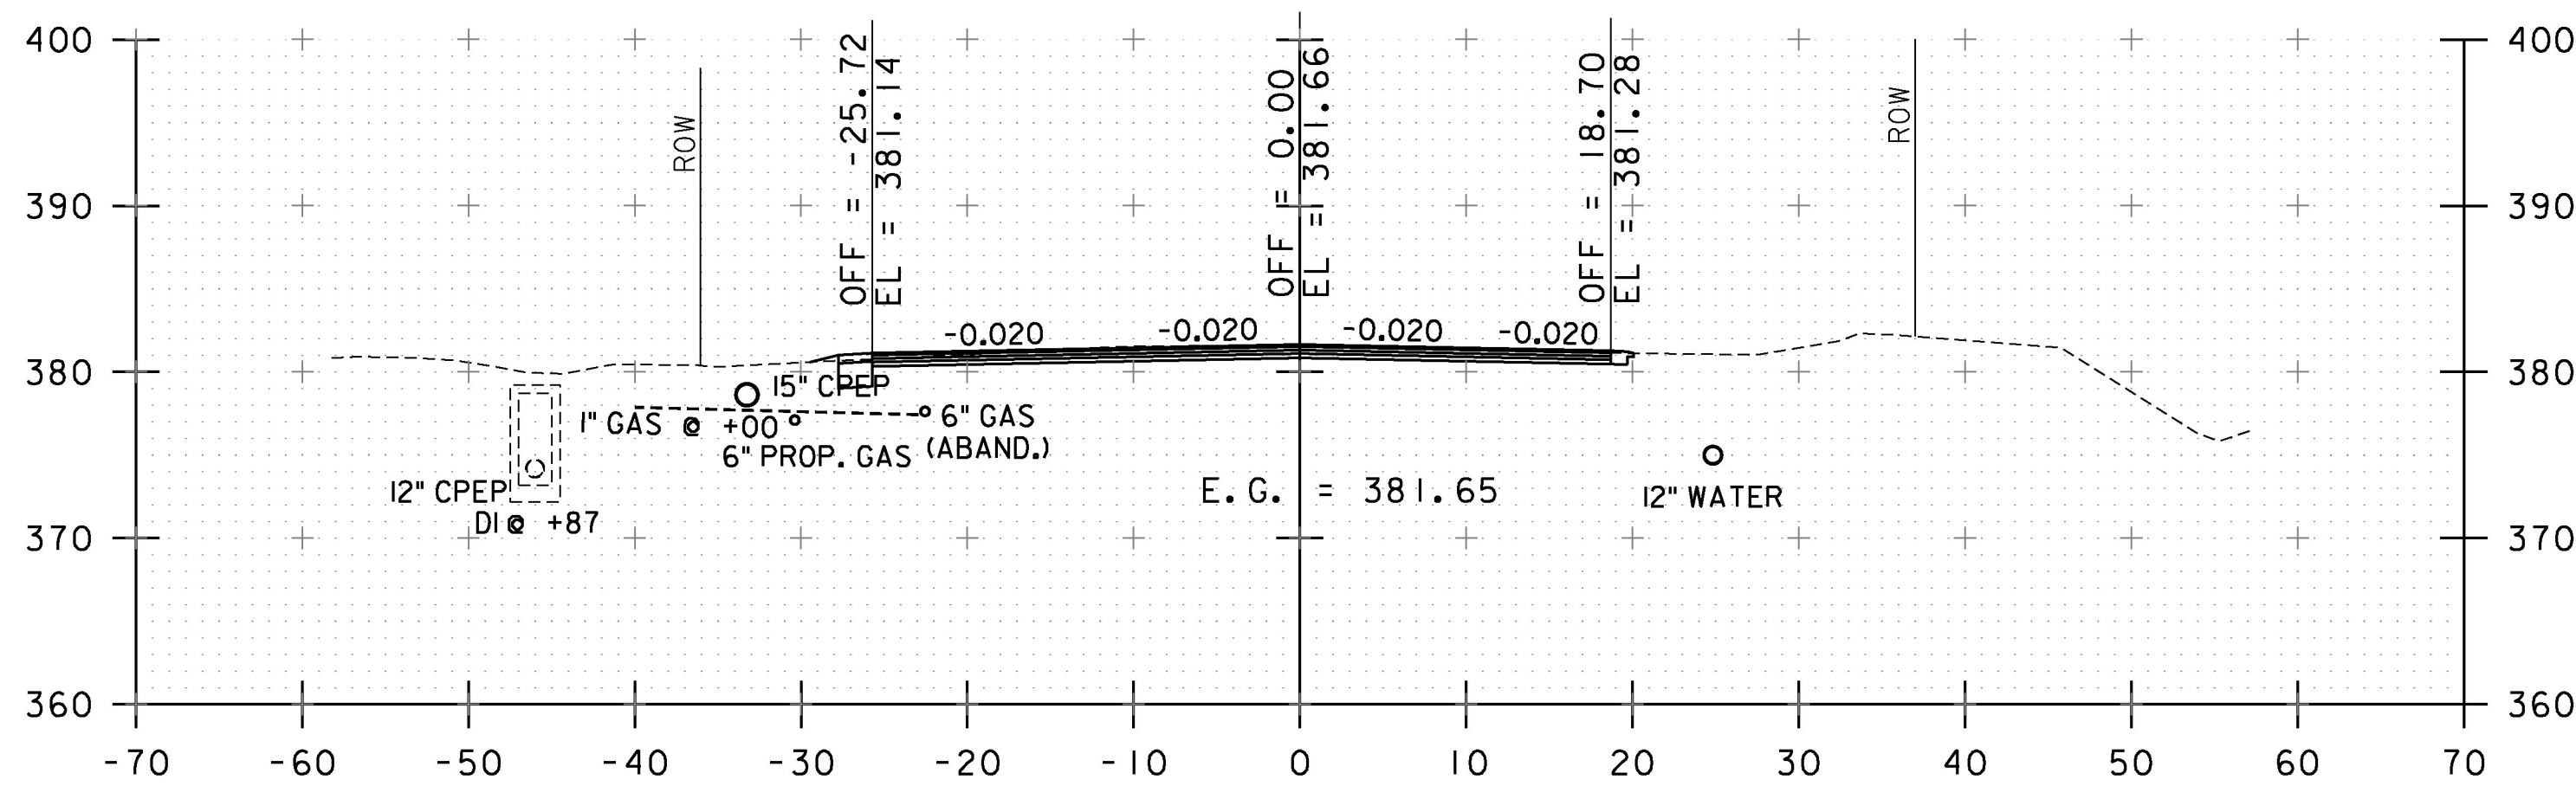


69+00

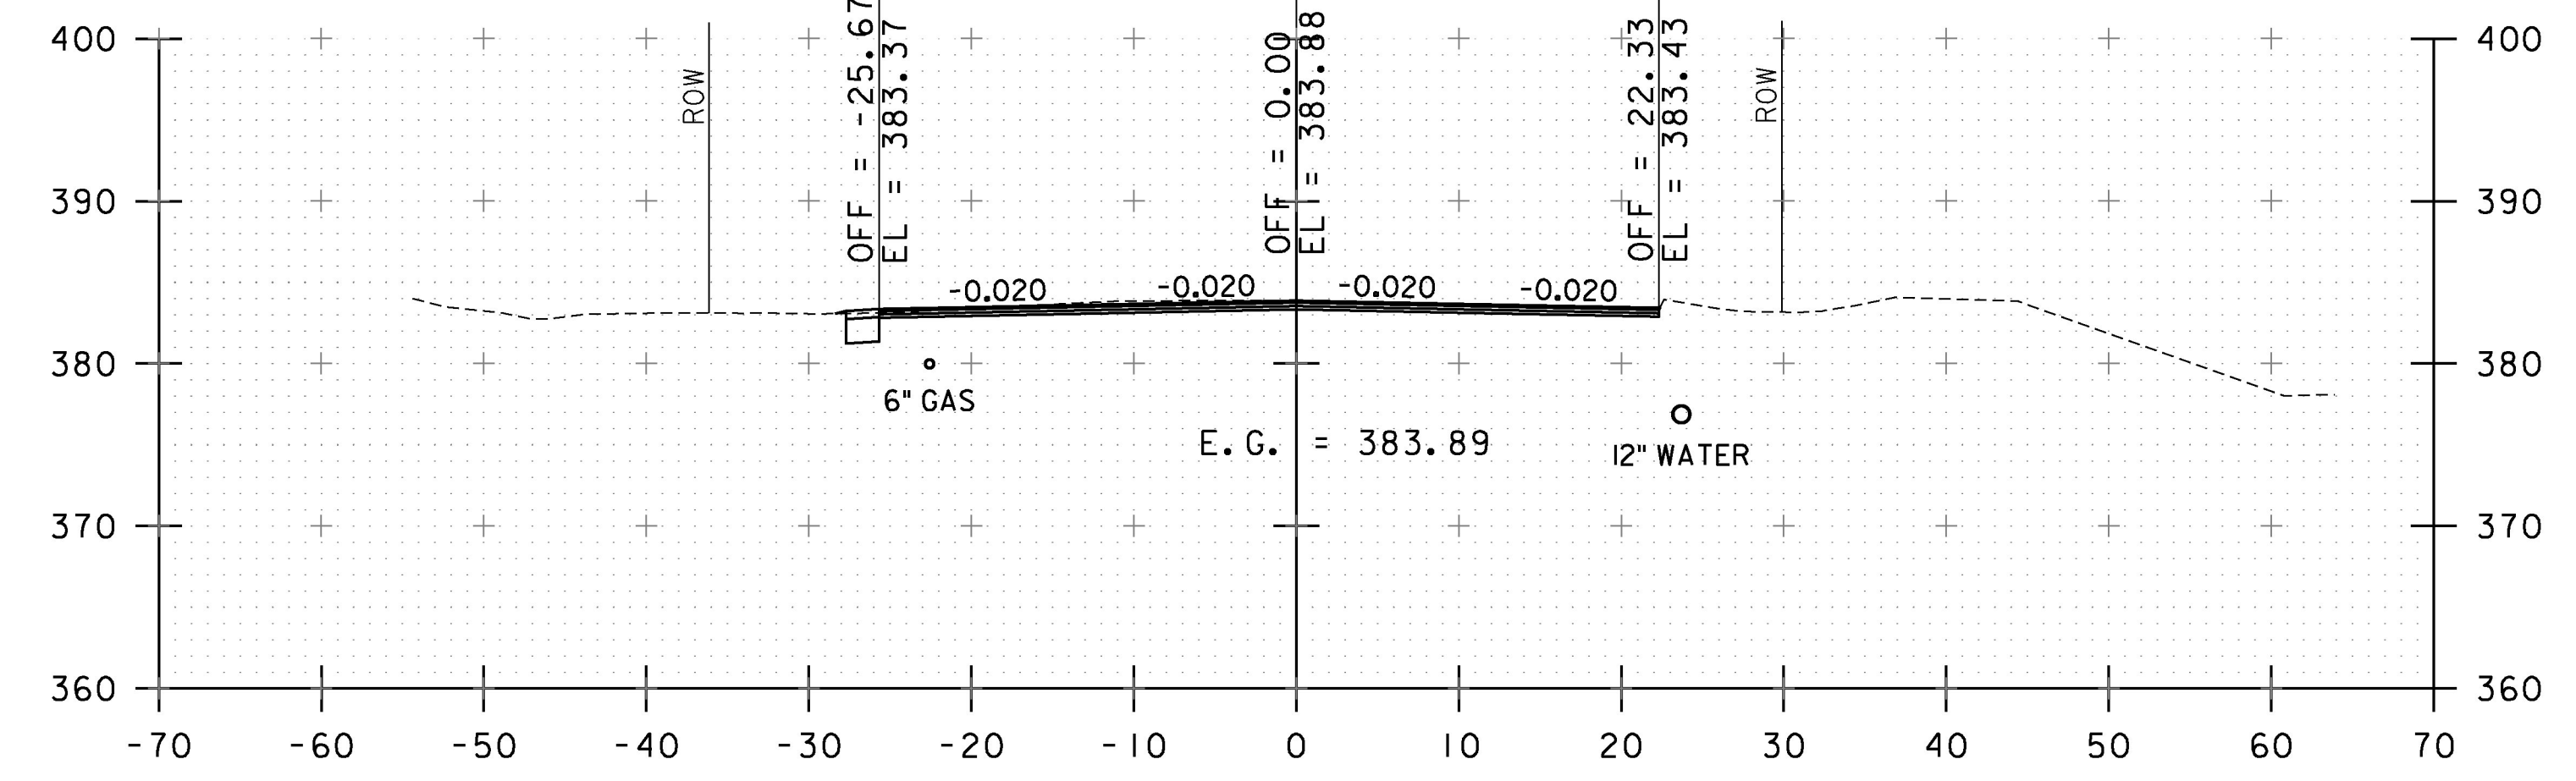


69+75


68+95.00 STOP CONCRETE REMOVAL
BEGIN COLD PLANE TRANSITION

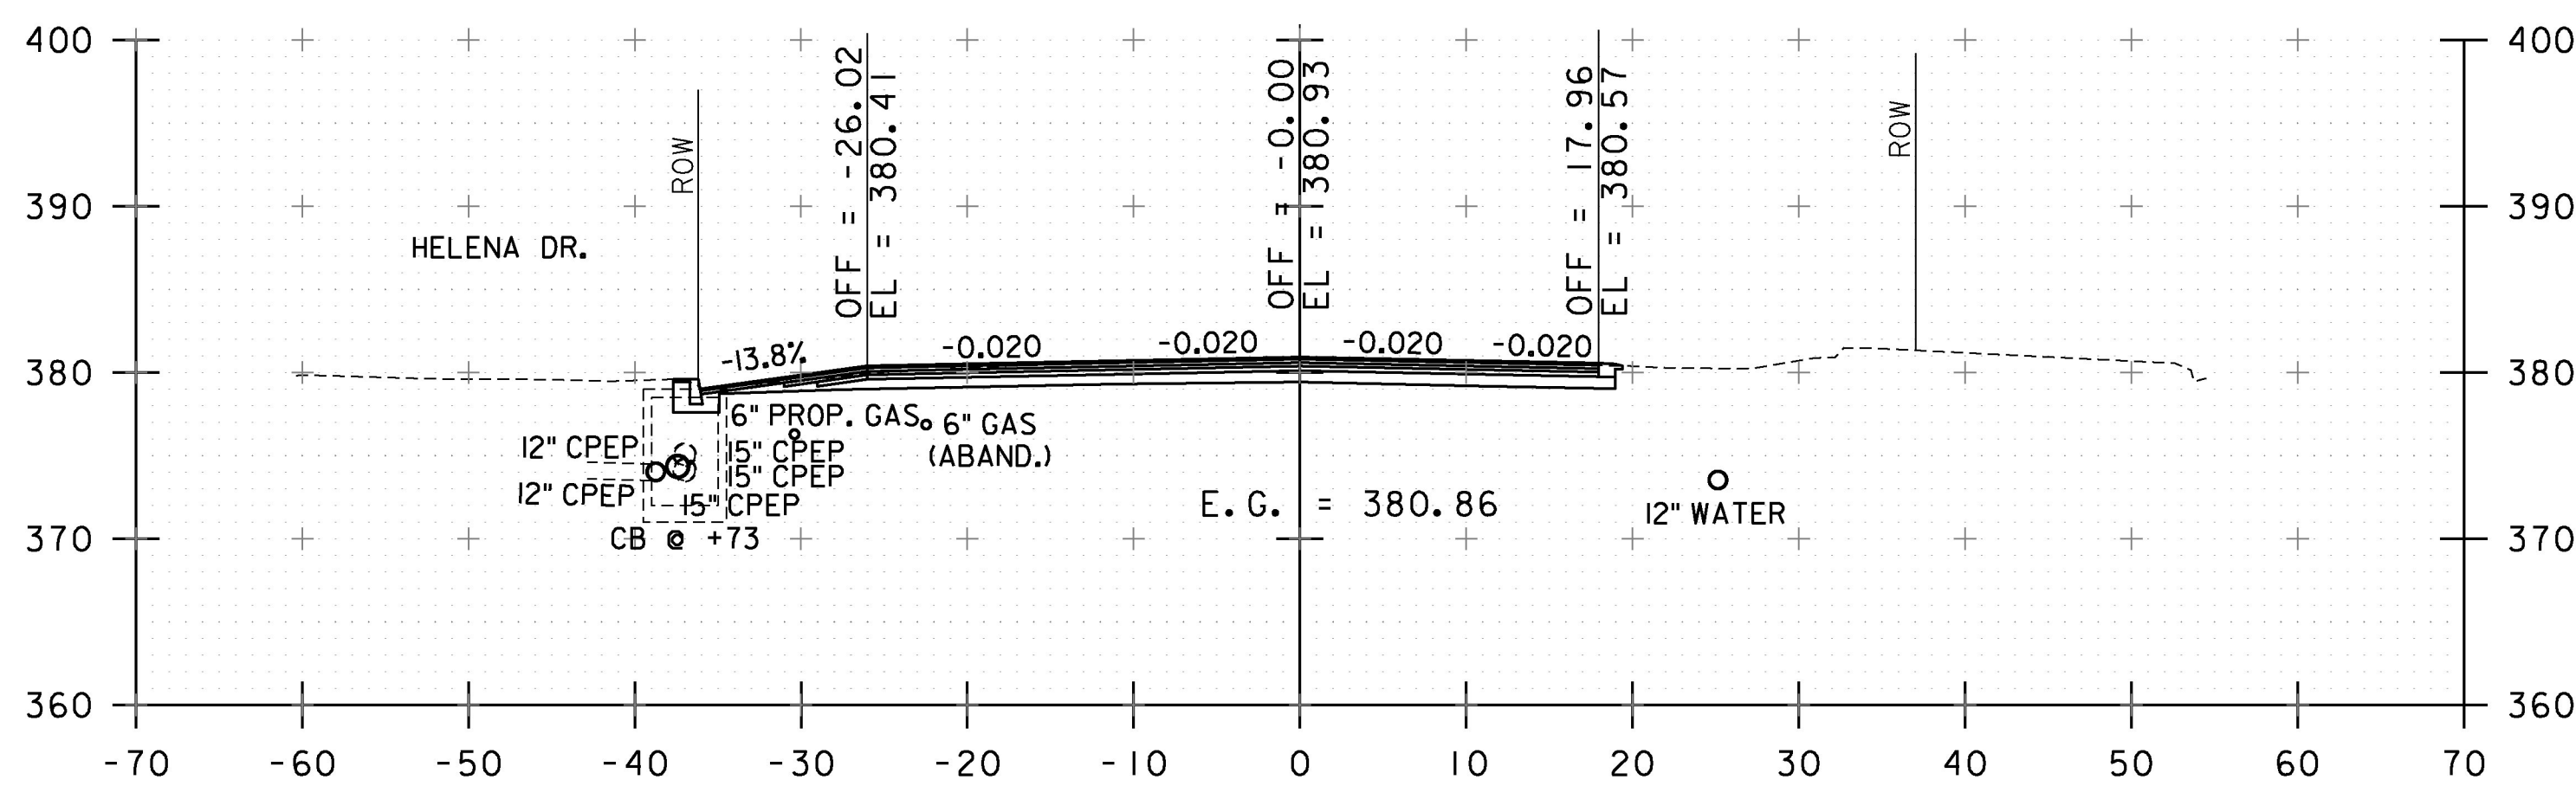

68+75

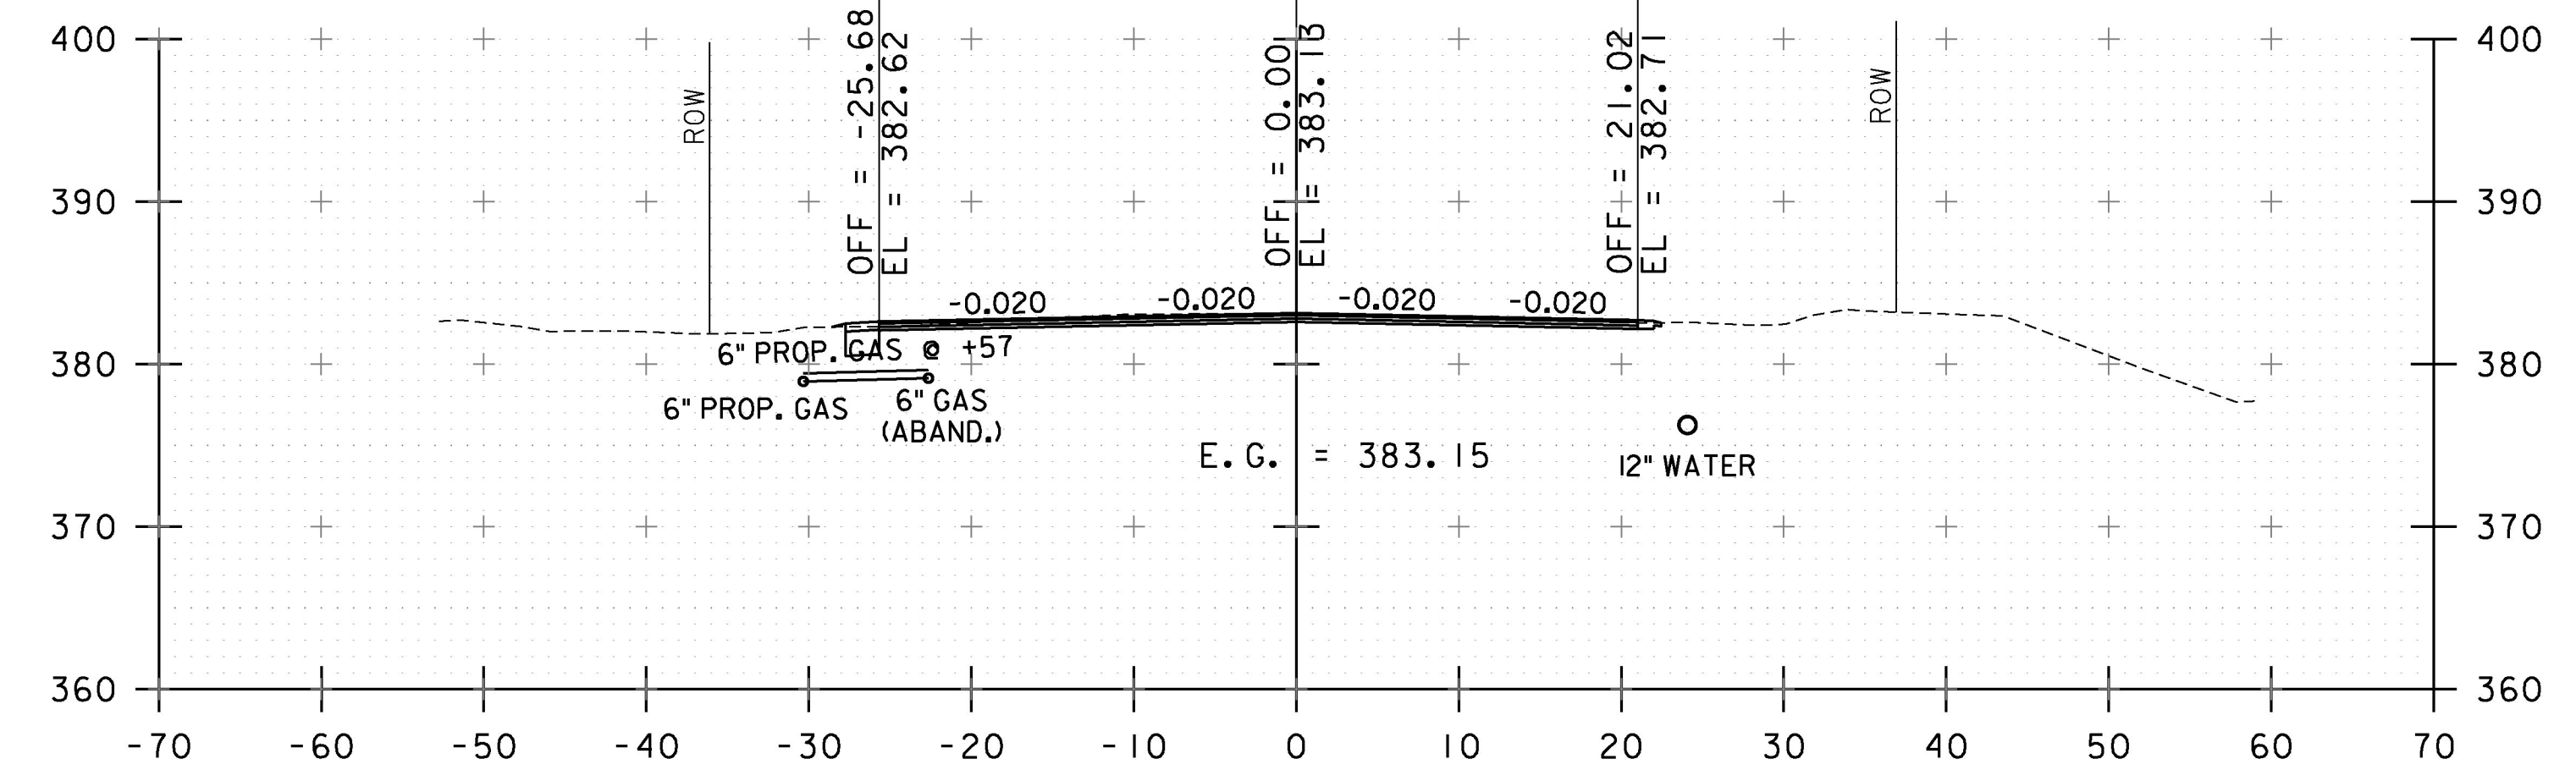

69+50

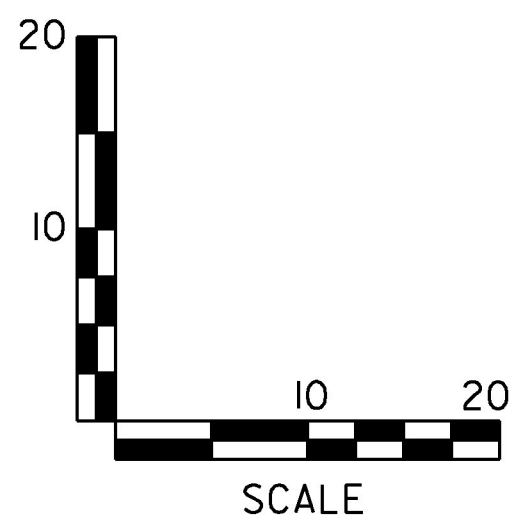

SCALE
STA. W 68+75 TO STA. W 70+00

PROJECT NAME: SOUTH BURLINGTON-WILLISTON	
PROJECT NUMBER: NH 2944(1)	
FILE NAME: zild340xsl.dgn	PLOT DATE: 2/15/2017
PROJECT LEADER: G. EDWARDS	DRAWN BY: I. MAYNARD
DESIGNED BY: I. MAYNARD	CHECKED BY: J. LITTLE
CROSS SECTION SHEET 62	SHEET 182 OF 249