




70+75

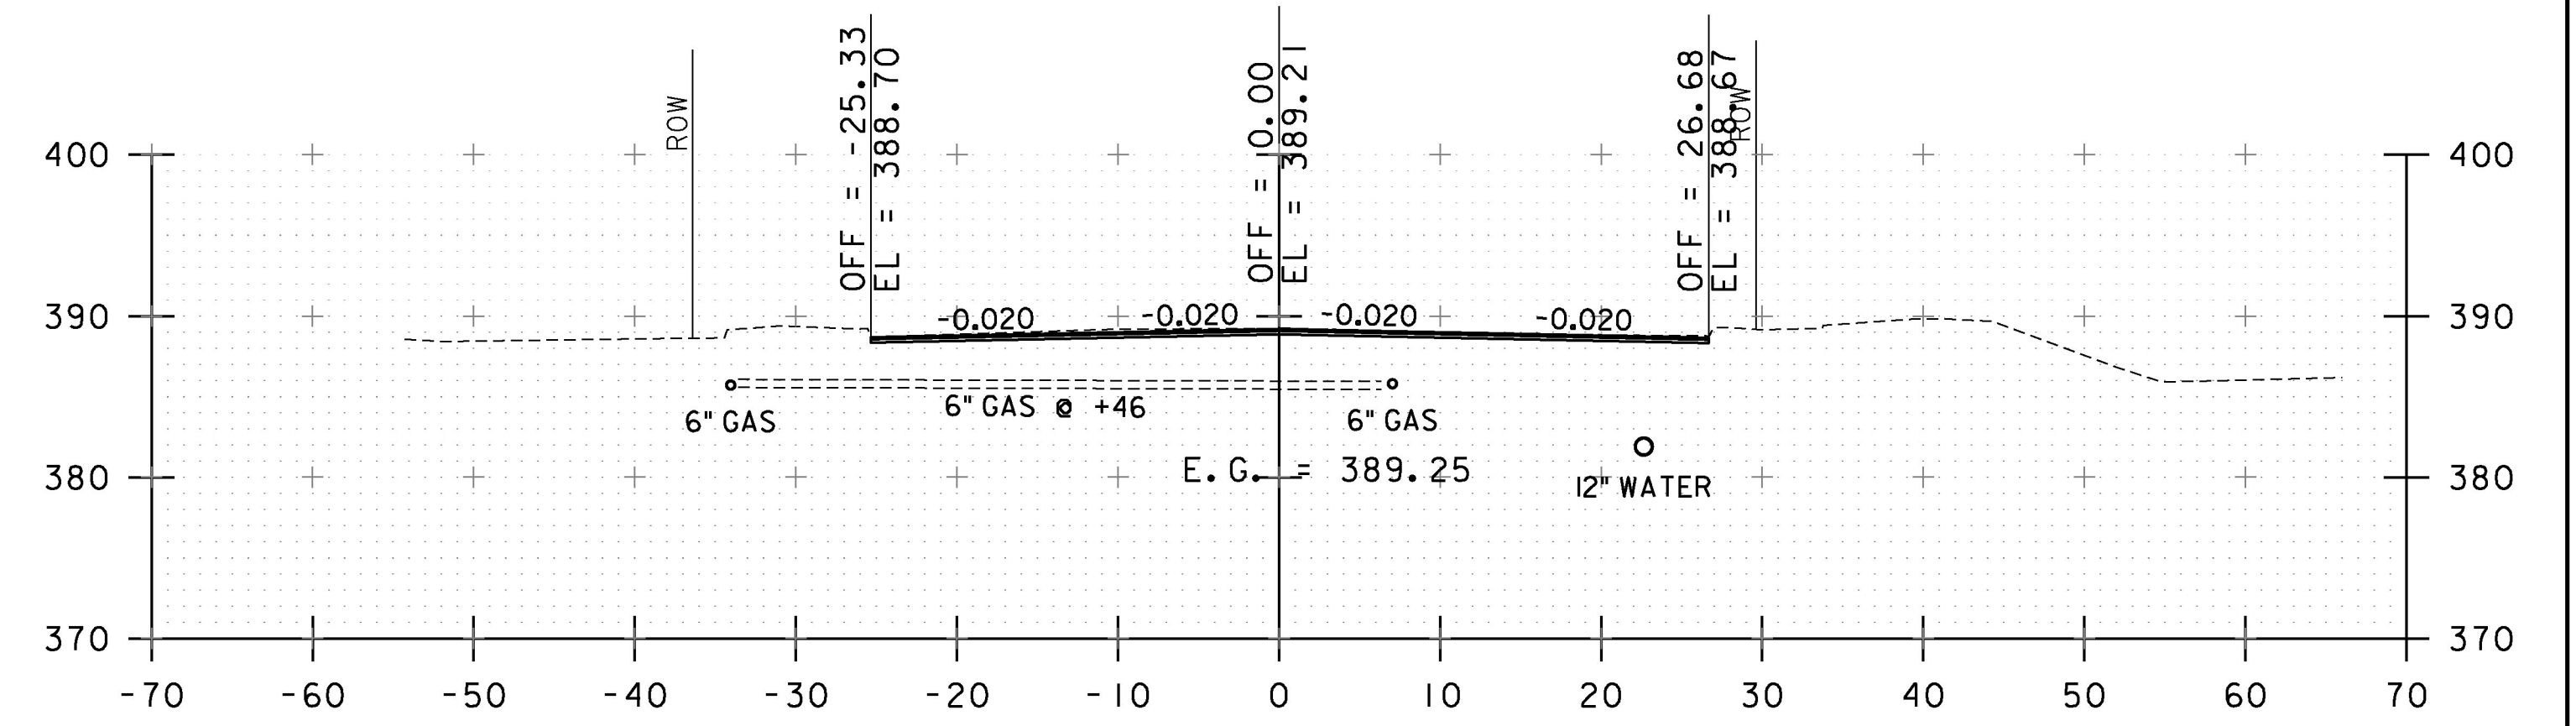


71+50

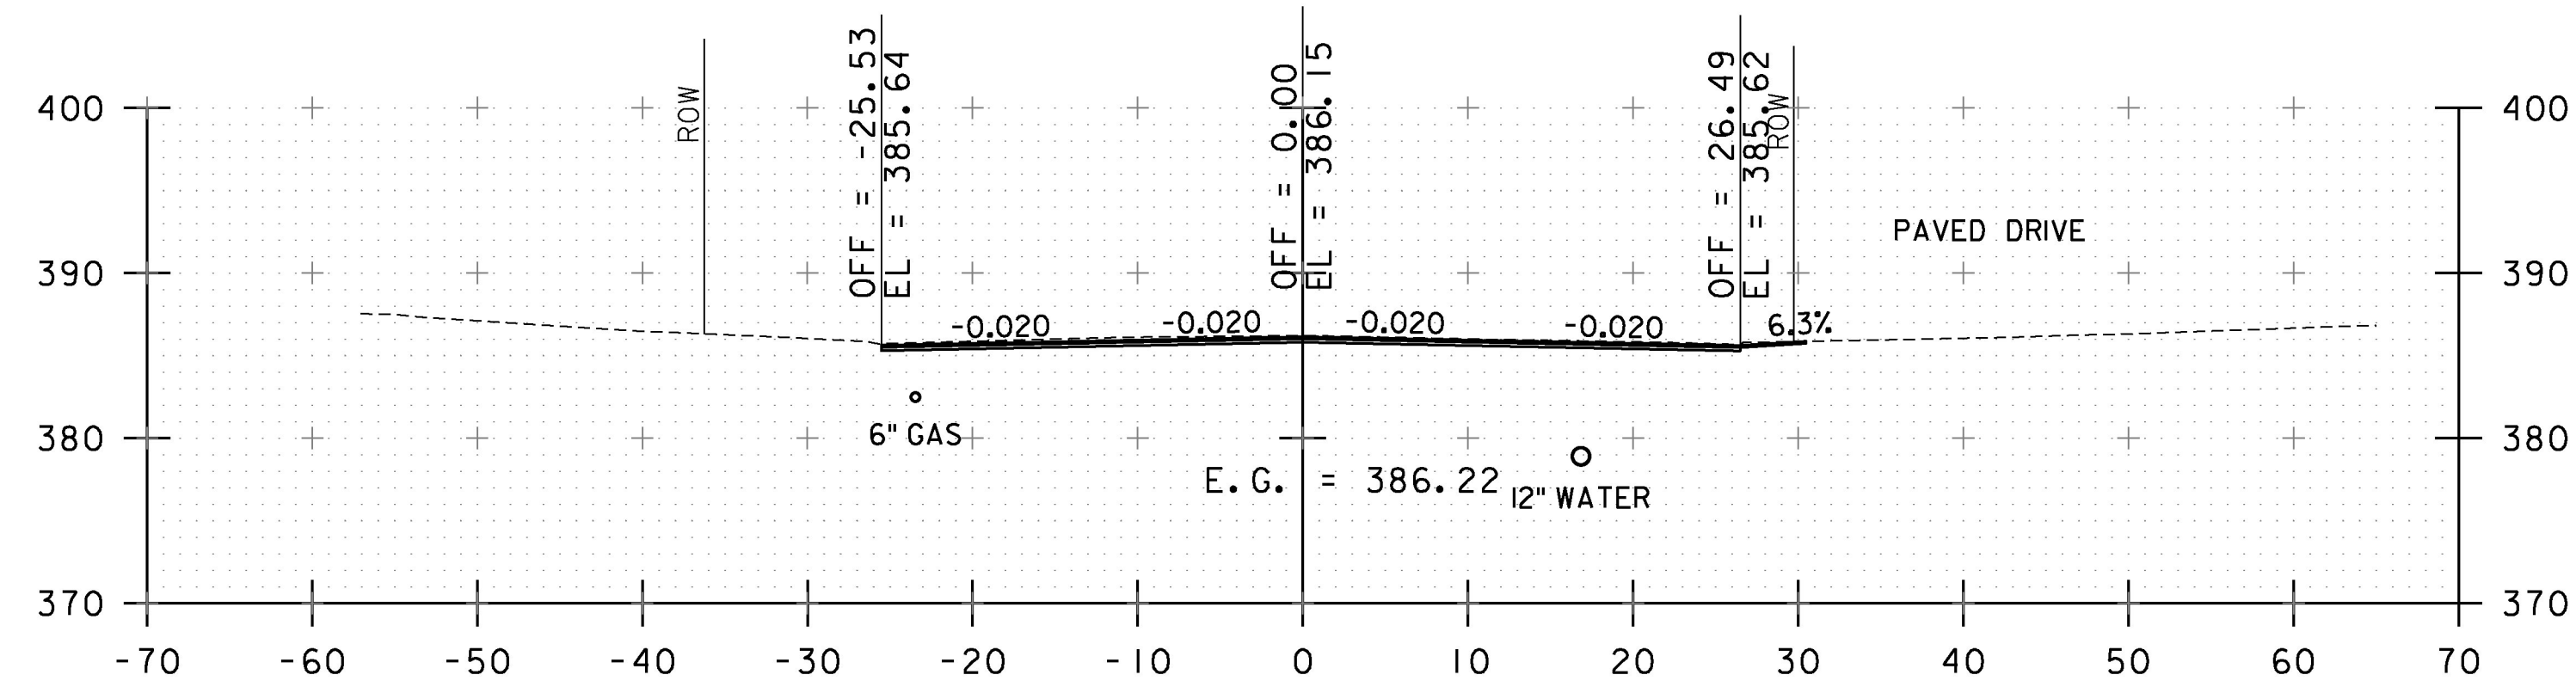


70+50

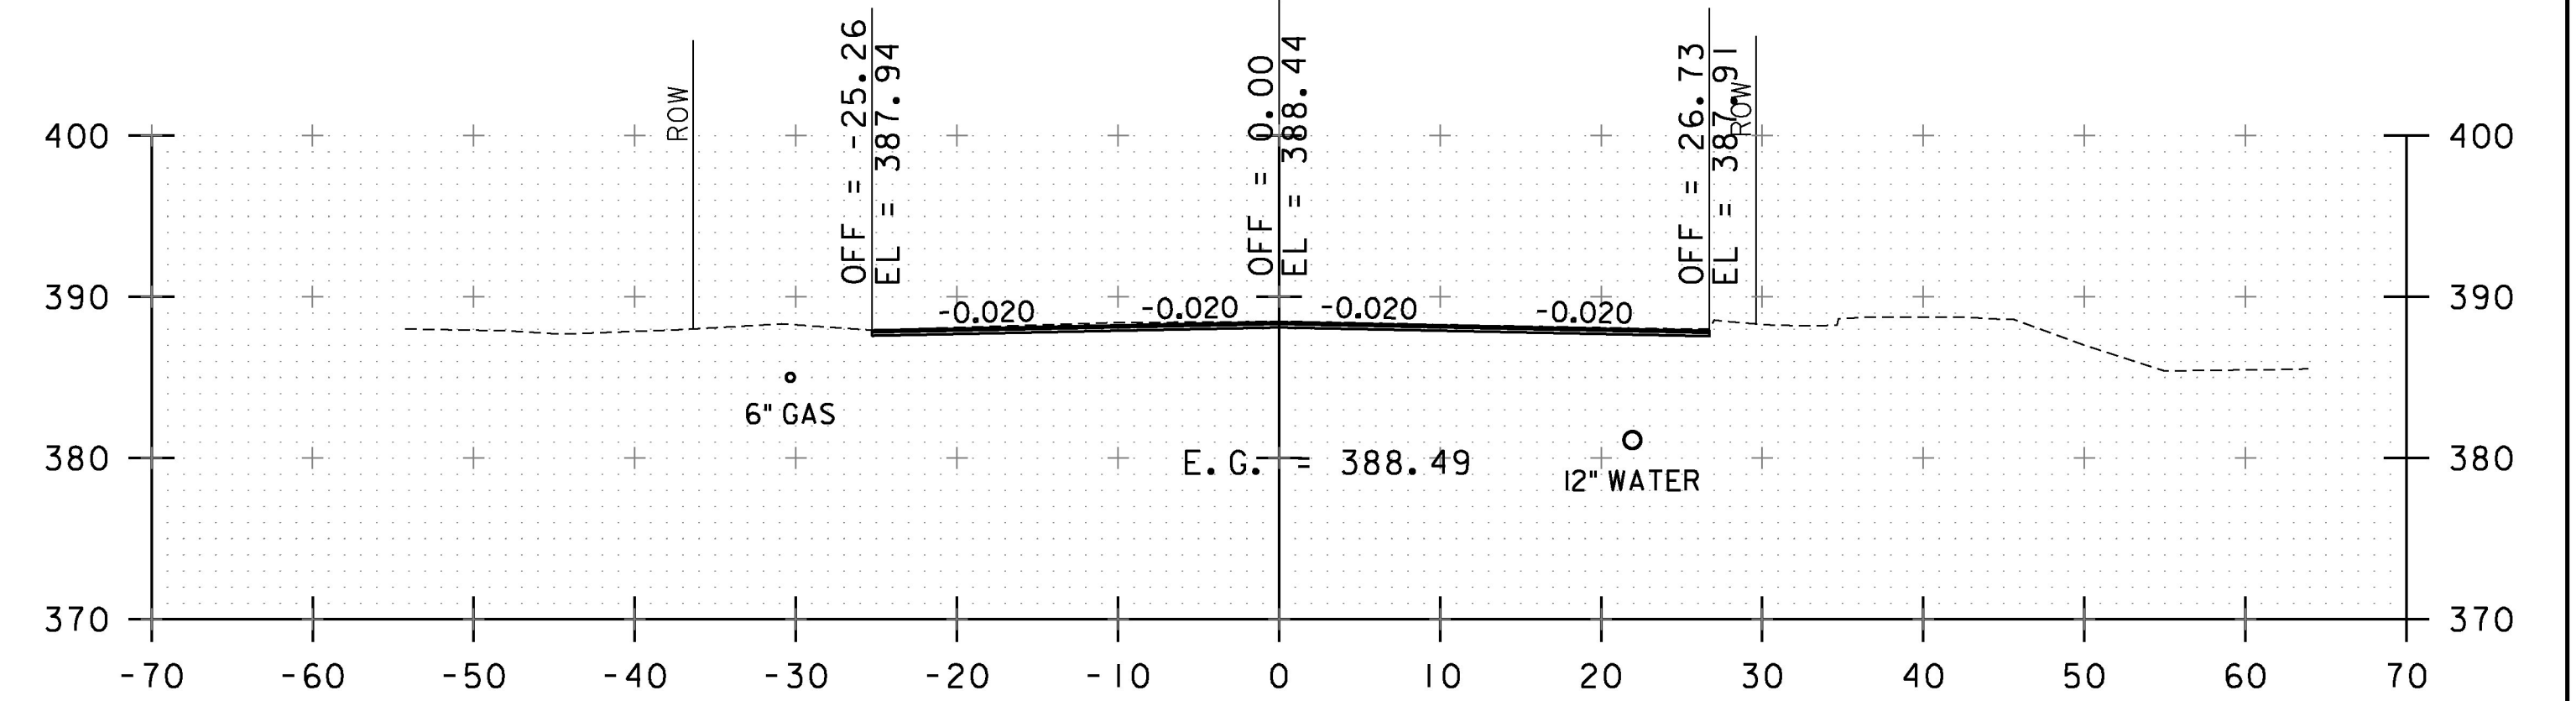

71+25

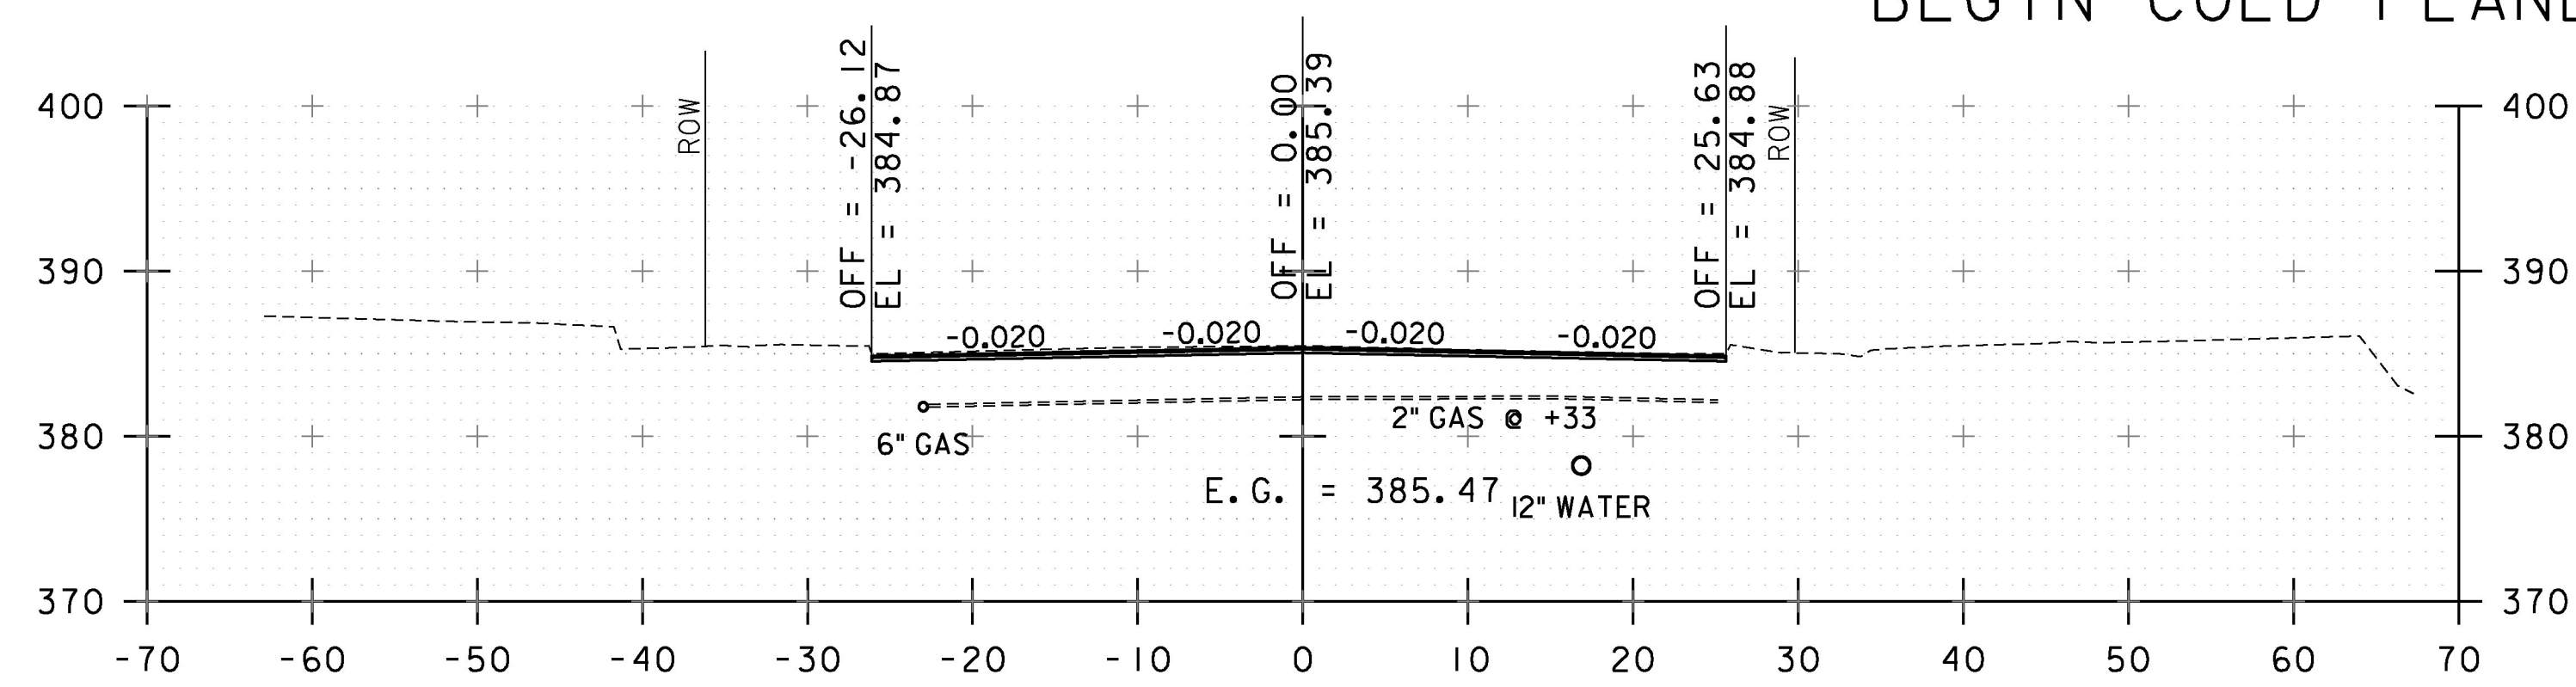


70+25

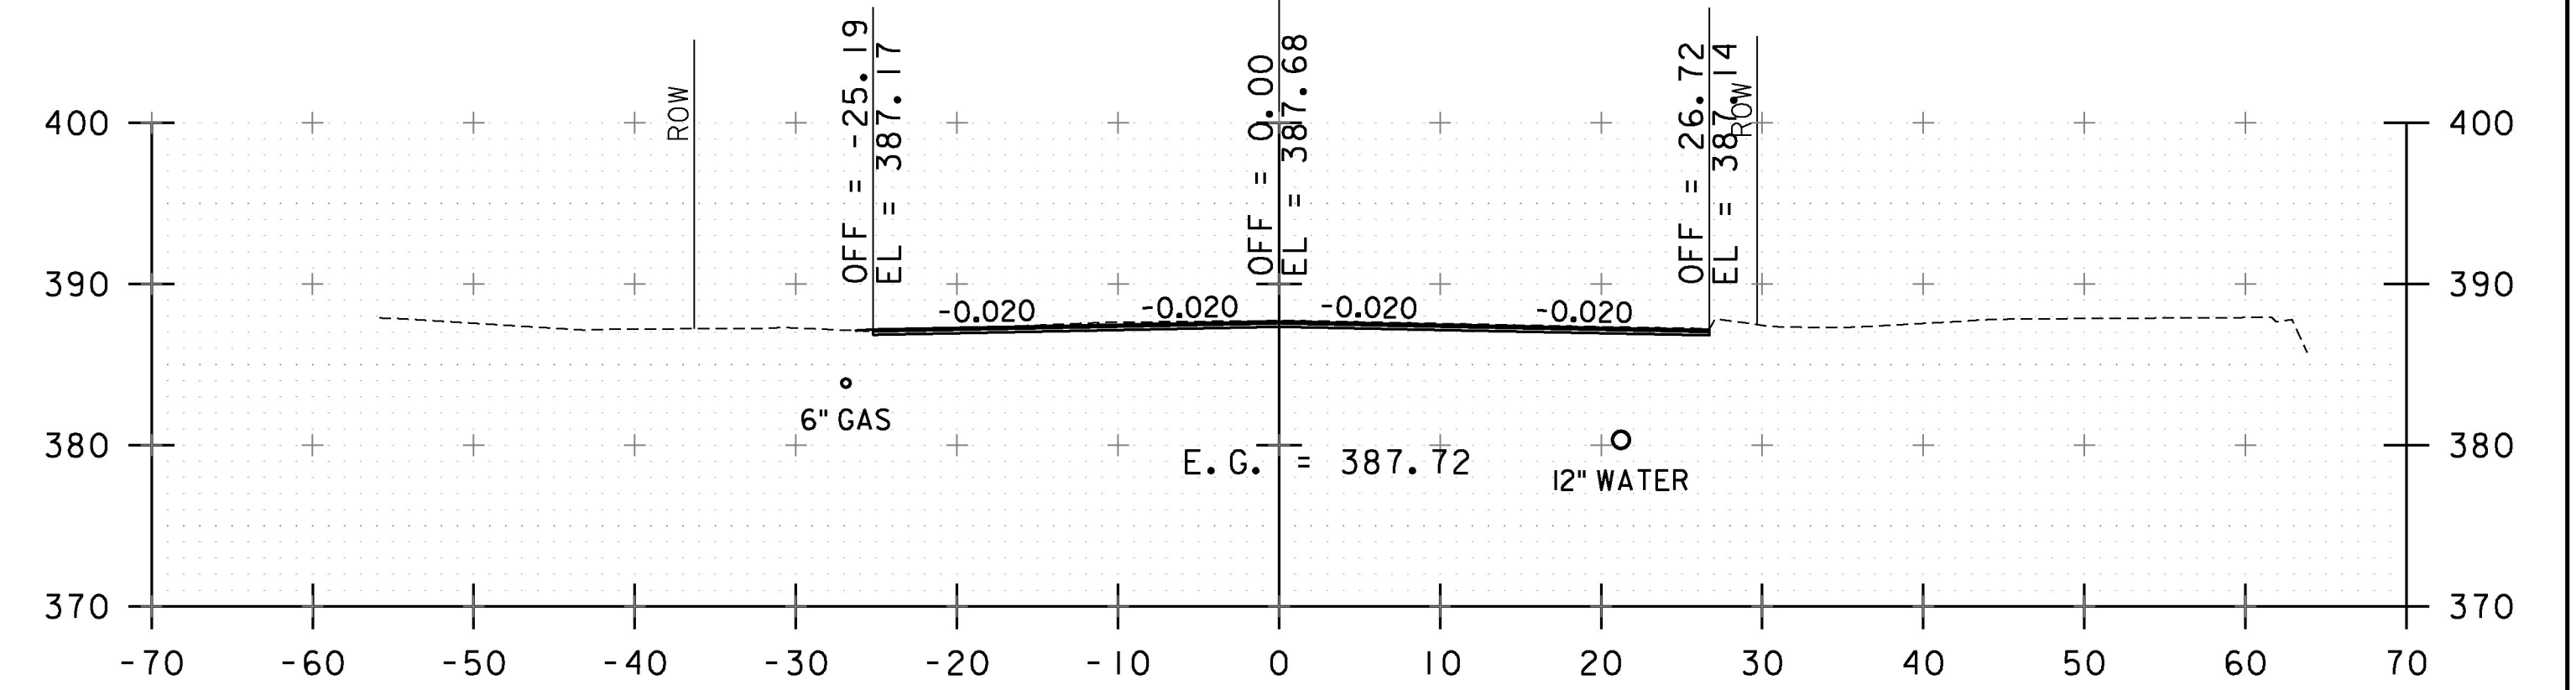

71+00

70+40.00 END TRANSITION
BEGIN COLD PLANE

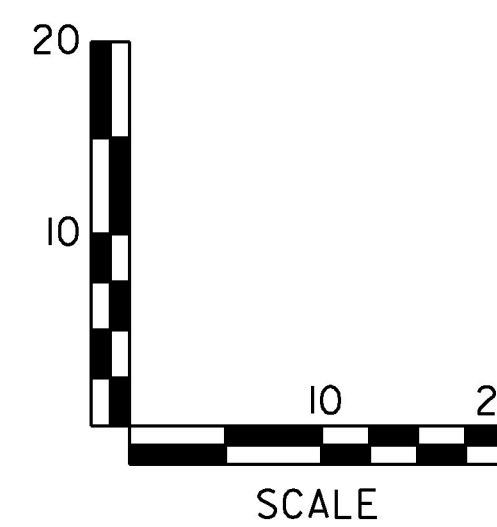

STA. W 70+25 TO STA. W 71+50

PROJECT NAME:	SOUTH BURLINGTON-WILLISTON
PROJECT NUMBER:	NH 2944(I)
FILE NAME:	zild340xsl.dgn
PROJECT LEADER:	G. EDWARDS
DESIGNED BY:	I. MAYNARD
CROSS SECTION SHEET	63
PLOT DATE:	2/15/2017
DRAWN BY:	I. MAYNARD
CHECKED BY:	J. LITTLE
SHEET	183 OF 249