

STATE OF VERMONT AGENCY OF TRANSPORTATION




PROPOSED IMPROVEMENT TOWN OF WILLISTON COUNTY OF CHITTENDEN VT ROUTE 2A (PRINCIPAL ARTERIAL)(NHS)

BEGINNING IN THE TOWN OF WILLISTON ON VT ROUTE 2A AT STA. 148+05.12 (MM 2.804) AND EXTENDING NORTHERLY ALONG VT ROUTE 2A FOR A DISTANCE OF 5,739.36 FEET (1.087 MILES) TO STA. 205+44.48 (MM 3.891).


WORK TO BE PERFORMED UNDER THIS PROJECT INCLUDES COLD PLANING AND RESURFACING OF THE EXISTING HIGHWAY WITH AN INTERMEDIATE COURSE, WEARING COURSE, NEW PAVEMENT MARKINGS, GUARDRAIL, SIGNS AND OTHER HIGHWAY RELATED ITEMS.

PROJECT DATA:	LENGTH (FEET)	LENGTH (MILES)
TOWN OF WILLISTON		
VT ROUTE 2A		
STA. 148+05.12 TO STA. 205+44.48	5,739.36	1.087
MM 2.804 TO MM 3.891		
TOTAL LENGTH OF PROJECT:	5,739.36	1.087
TOTAL LENGTH OF ROADWAY:	5,739.36	1.087

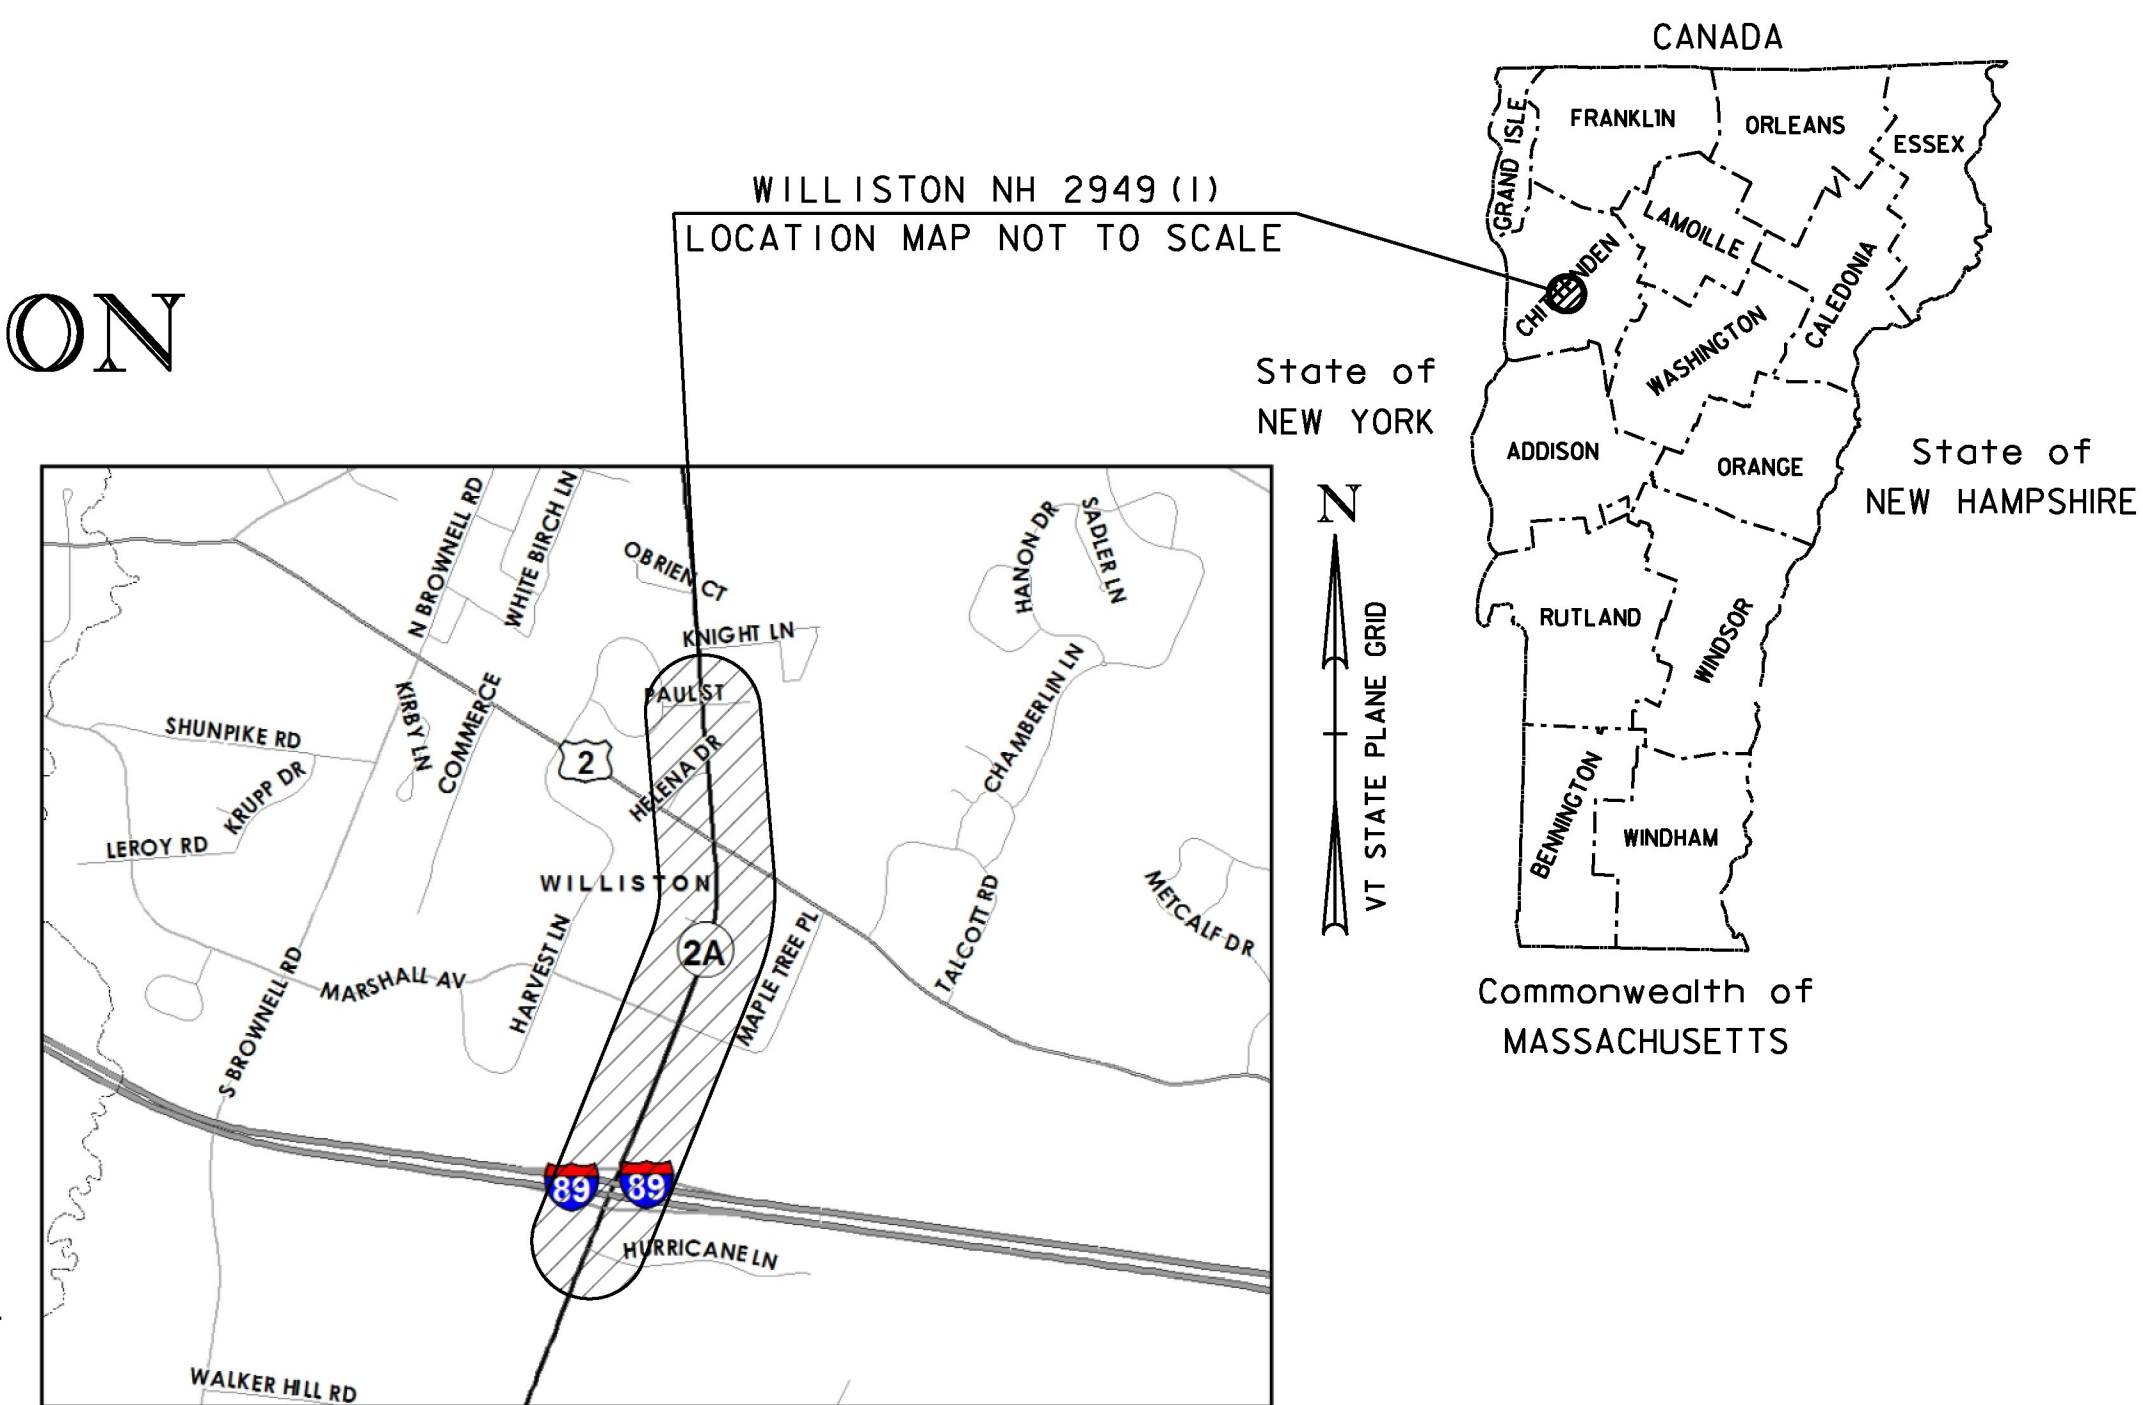

STA. 148+05.12 (MM 2.804)
BEGIN WILLISTON NH 2949 (1)

STA. 205+44.48 (MM 3.891)
END WILLISTON NH 2949 (1)

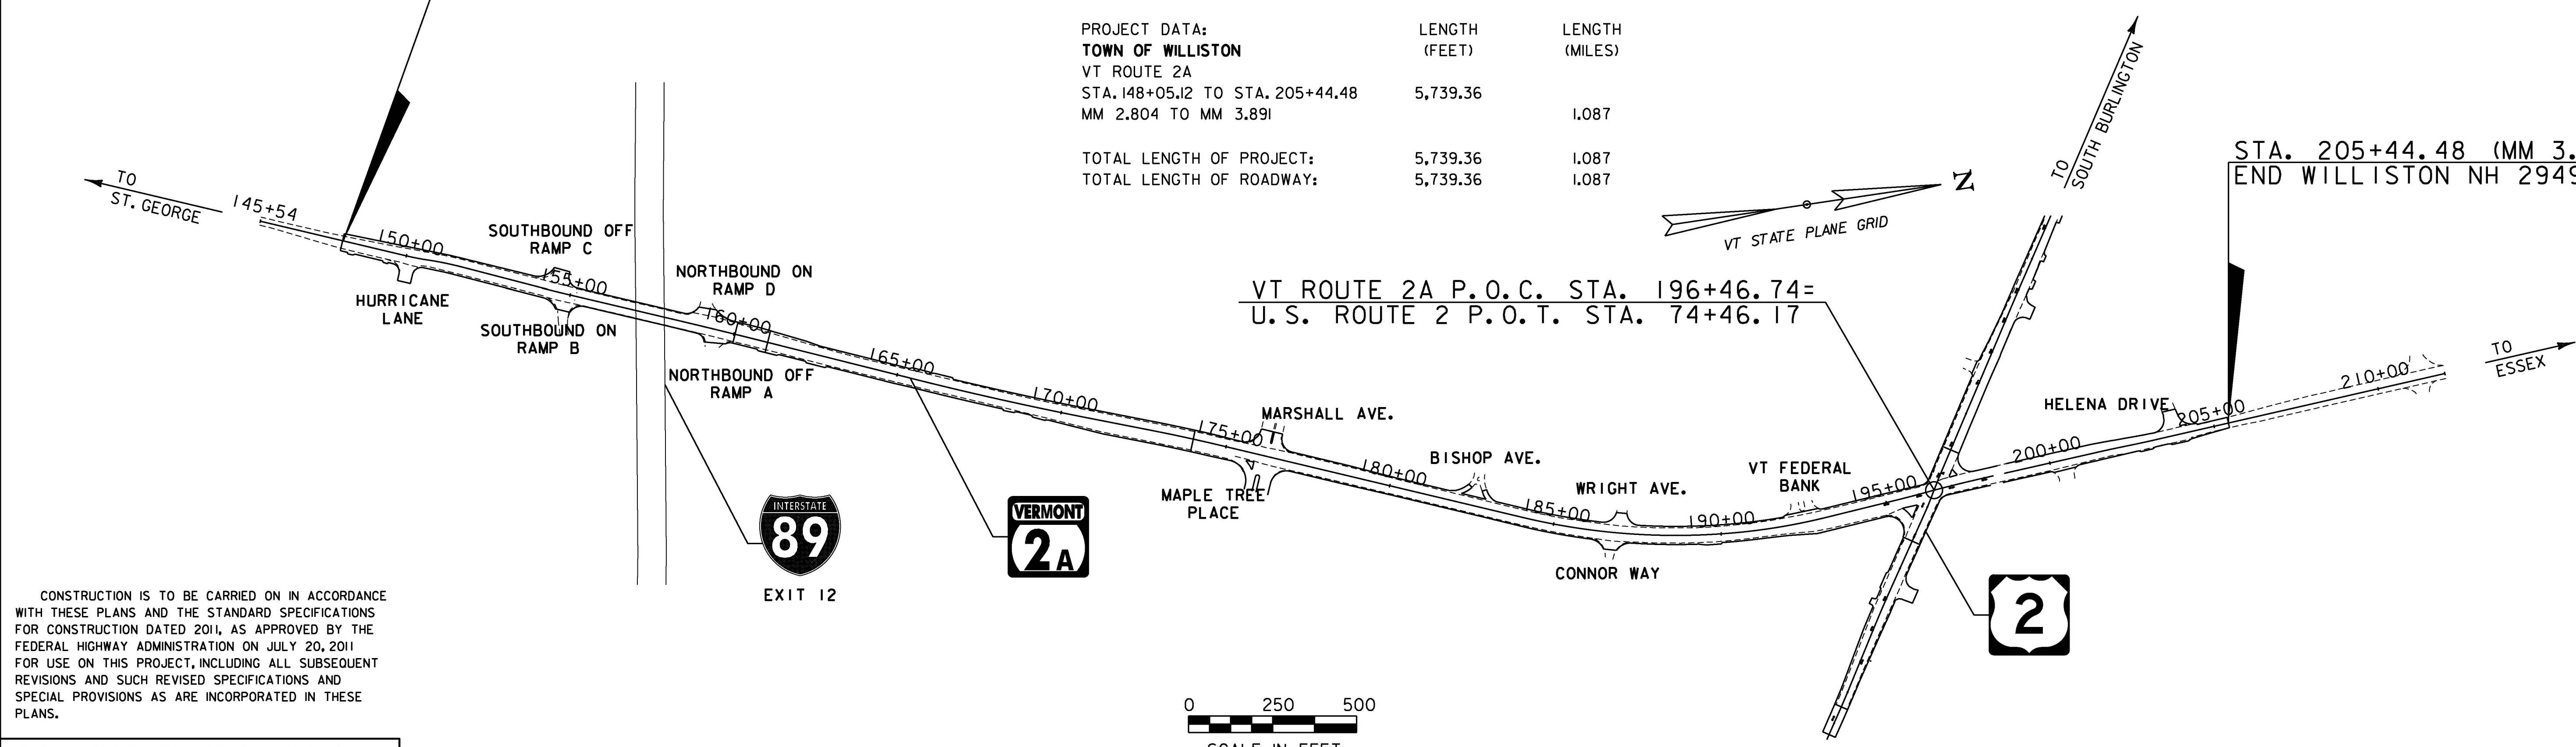

CONSTRUCTION IS TO BE CARRIED ON IN ACCORDANCE WITH THESE PLANS AND THE STANDARD SPECIFICATIONS FOR CONSTRUCTION DATED 2011 AS APPROVED BY THE FEDERAL HIGHWAY ADMINISTRATION ON JULY 20, 2011 FOR USE ON THIS PROJECT, INCLUDING ALL SUBSEQUENT REVISIONS AND SUCH REVISED SPECIFICATIONS AND SPECIAL PROVISIONS AS ARE INCORPORATED IN THESE PLANS.

QUALITY ASSURANCE PROGRAM : LEVEL I

SURVEYED BY : VAOT
SURVEYED DATE : 2013

DATUM
VERTICAL NAVD 88 FT
HORIZONTAL NAD 83(96)SFT

Stantec
Stantec Consulting Services Inc.
55 Green Mountain Drive
South Burlington VT U.S.A. 05403
Phone: (802) 864-0223
Fax: (802) 864-0165
www.stantec.com

PROJECT MANAGER : MICHAEL FOWLER, P.E.
PROJECT NAME : WILLISTON
PROJECT NUMBER : NH 2949 (1)
SHEET 199 OF 249 SHEETS