

NOTES:


1. THE CONTRACTOR SHALL REMOVE ALL WOODY STEMMED GROWTH INCLUDING BRUSH, SAPLINGS AND TREE LIMBS GROWING WITHIN OR PROJECTING INTO THE CLEARANCE AREA DOWN TO GROUND LEVEL OR AT LEAST 10 FEET BELOW THE BOTTOM OF THE SIGN, WHICHEVER IS LESS.
2. PAYMENT WILL BE FOR THINNING AND TRIMMING FOR SIGNS, ITEM 201.31 AND PAID FOR PER EACH SIGN.
3. NO CHEMICALS (POISONS OR DEFOLIANTS) WILL BE ALLOWED.

MINIMUM SIGN SIGHT DISTANCE CHART


APPROACH SPEED (mph)	SIGHT DISTANCE (feet)
30 OR LESS	300
35	350
40	400
45	450
50	500
55	550

THINNING AND TRIMMING FOR SIGNS ON CONVENTIONAL ROADS

SIGN LOCATIONS:
 VT ROUTE 2A
 STA. 162+31, LT
 STA. 200+12, LT

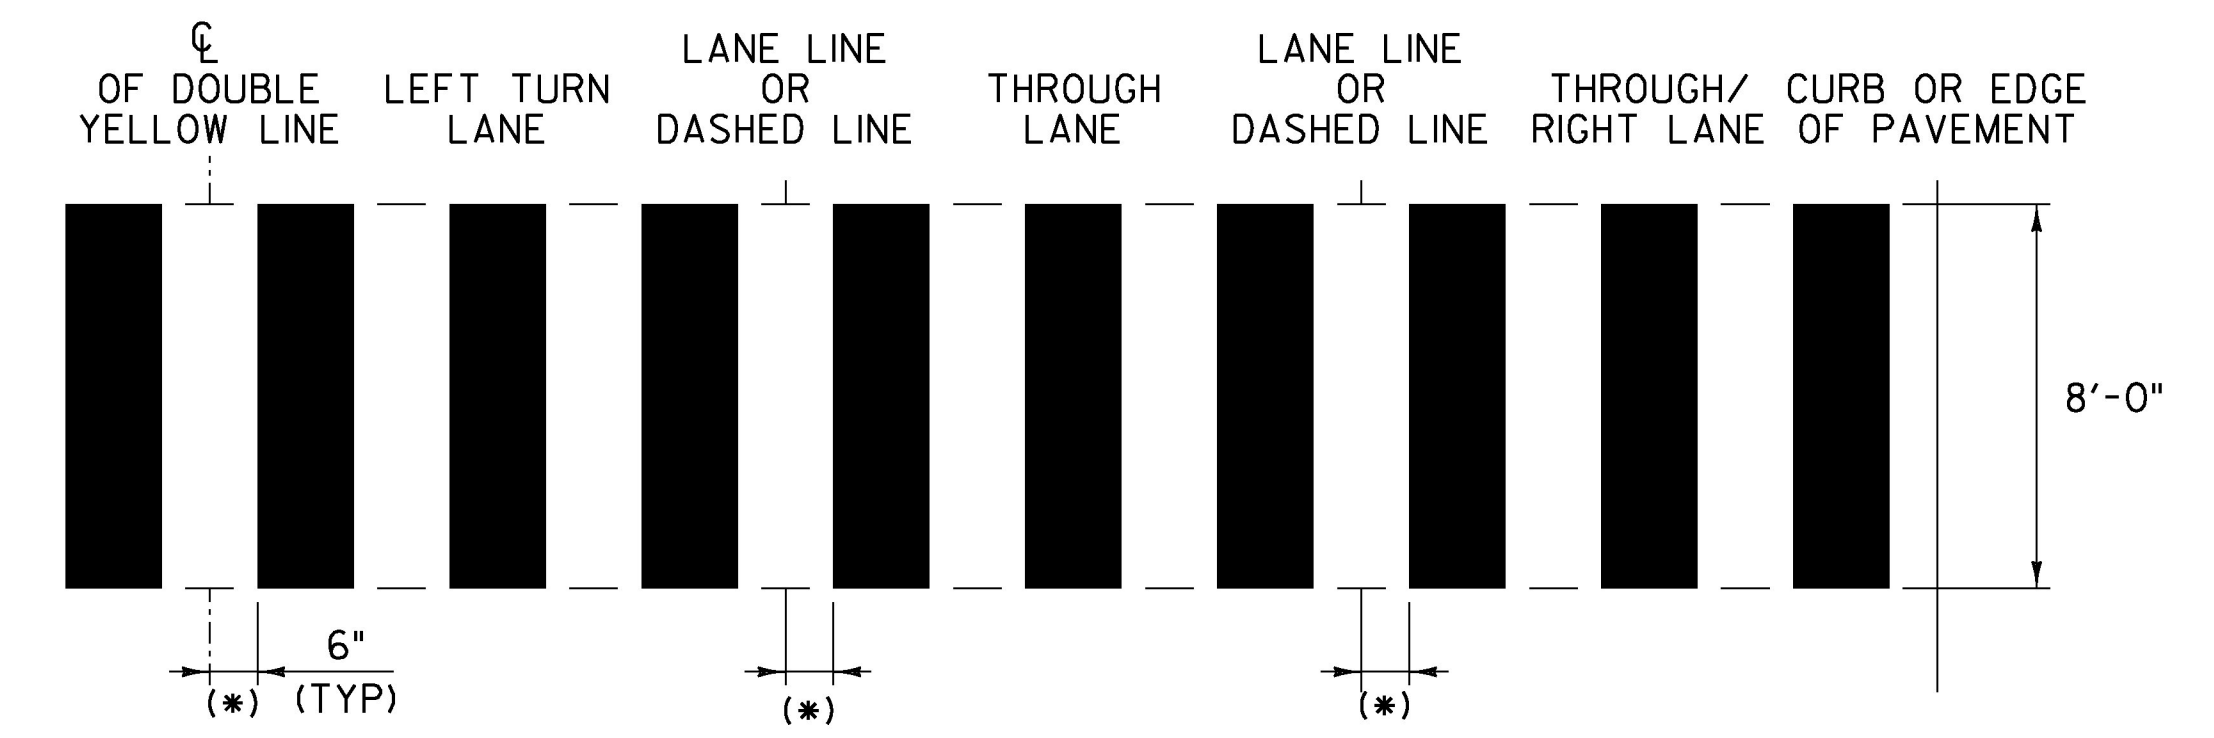


BLOCK PATTERN CROSSWALK DETAIL
 SEE LAYOUT SHEETS FOR LOCATIONS

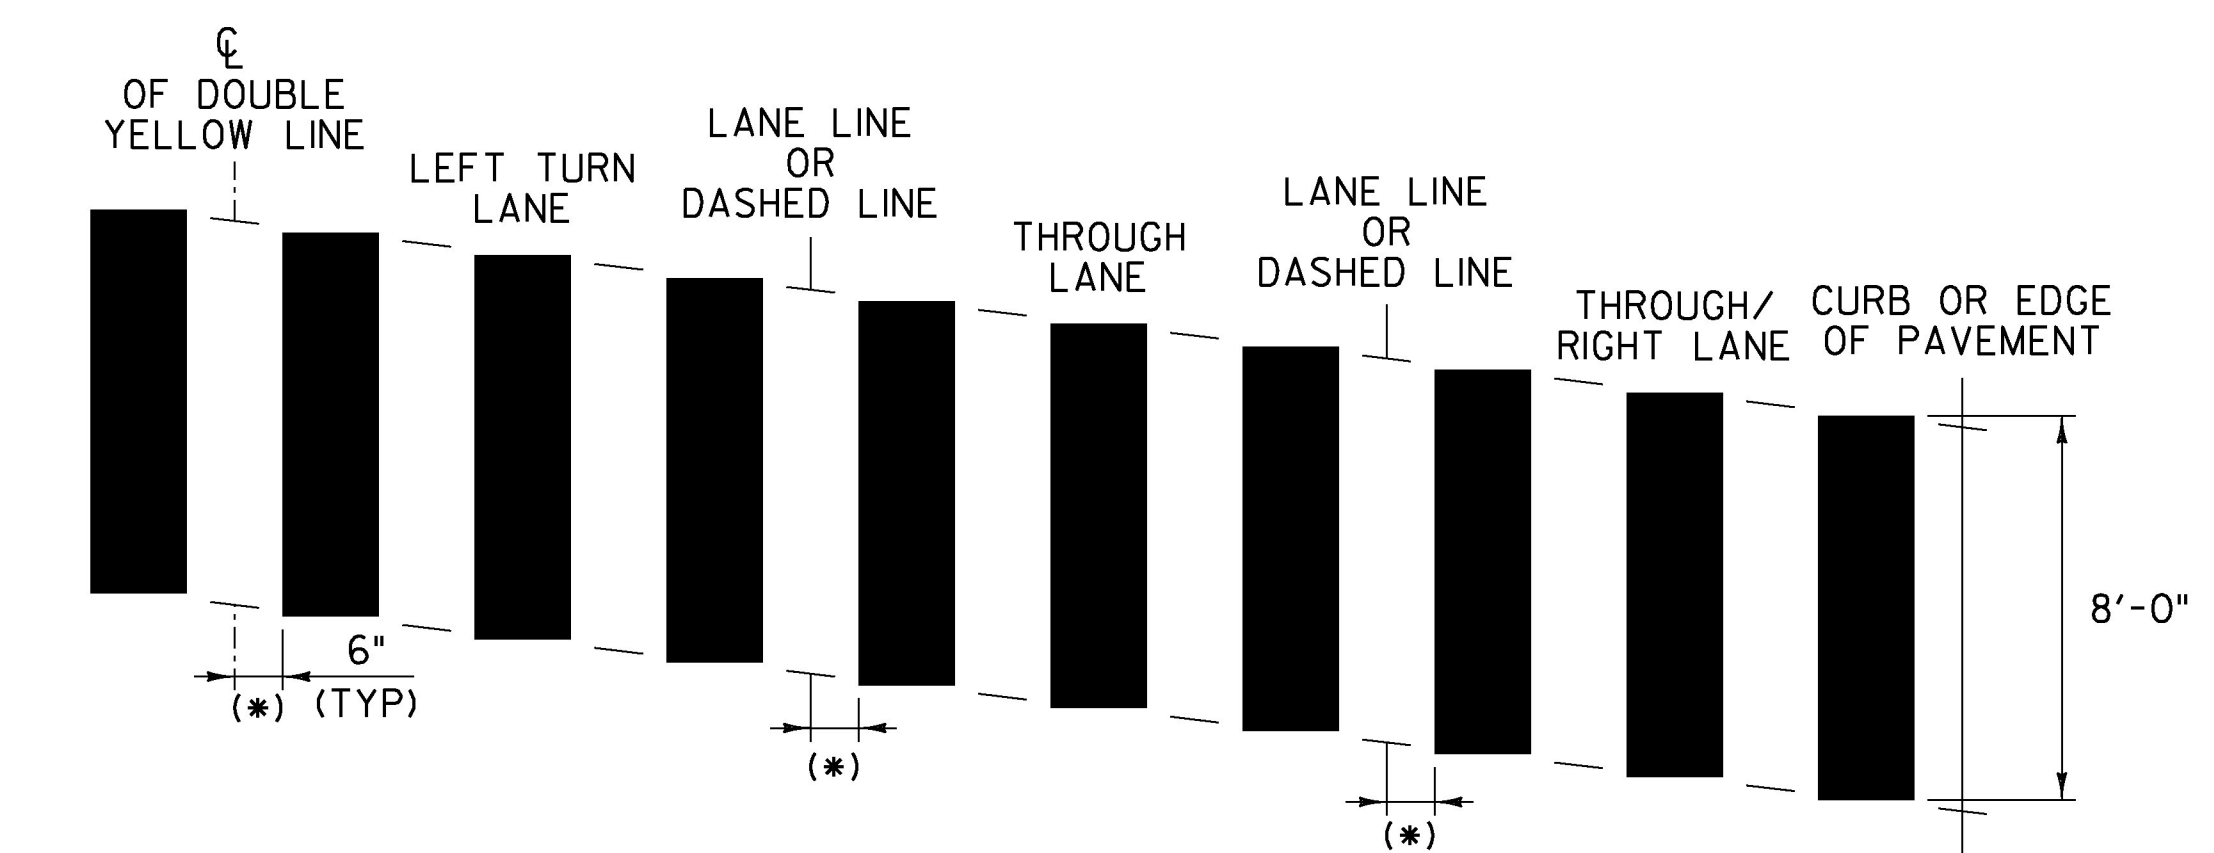

SKEWED BLOCK PATTERN CROSSWALK DETAIL
 SEE LAYOUT SHEETS FOR LOCATIONS

CROSSWALK DETAIL NOTES:

1. THIS DETAIL IS DESIGNED FOR AN 11 FOOT LANE.
2. MARK LIGHT STRING LINE ON PAVEMENT ACROSS ROADWAY (CURB TO CURB).
3. ESTABLISH THE CENTERLINE OF THE ROADWAY (DOUBLE YELLOW LINE OR LANE LINE).
4. BLOCKS ARE PARALLEL TO THE CENTERLINE (DOUBLE YELLOW LINE OR LANE LINE) (OFFSET BLOCKS VERTICALLY TO ACHIEVE REQUIRED SKEW).
5. ALWAYS START MEASURING FROM THE CENTERLINE OR LANE LINE RIGHT, WITH THE FLOW OF TRAFFIC.
6. BLOCKS ARE 24 INCHES (TYPICAL).
- (*) 7. THIS DISTANCE WILL INCREASE TO 1.0' FOR A 12 FOOT LANE.

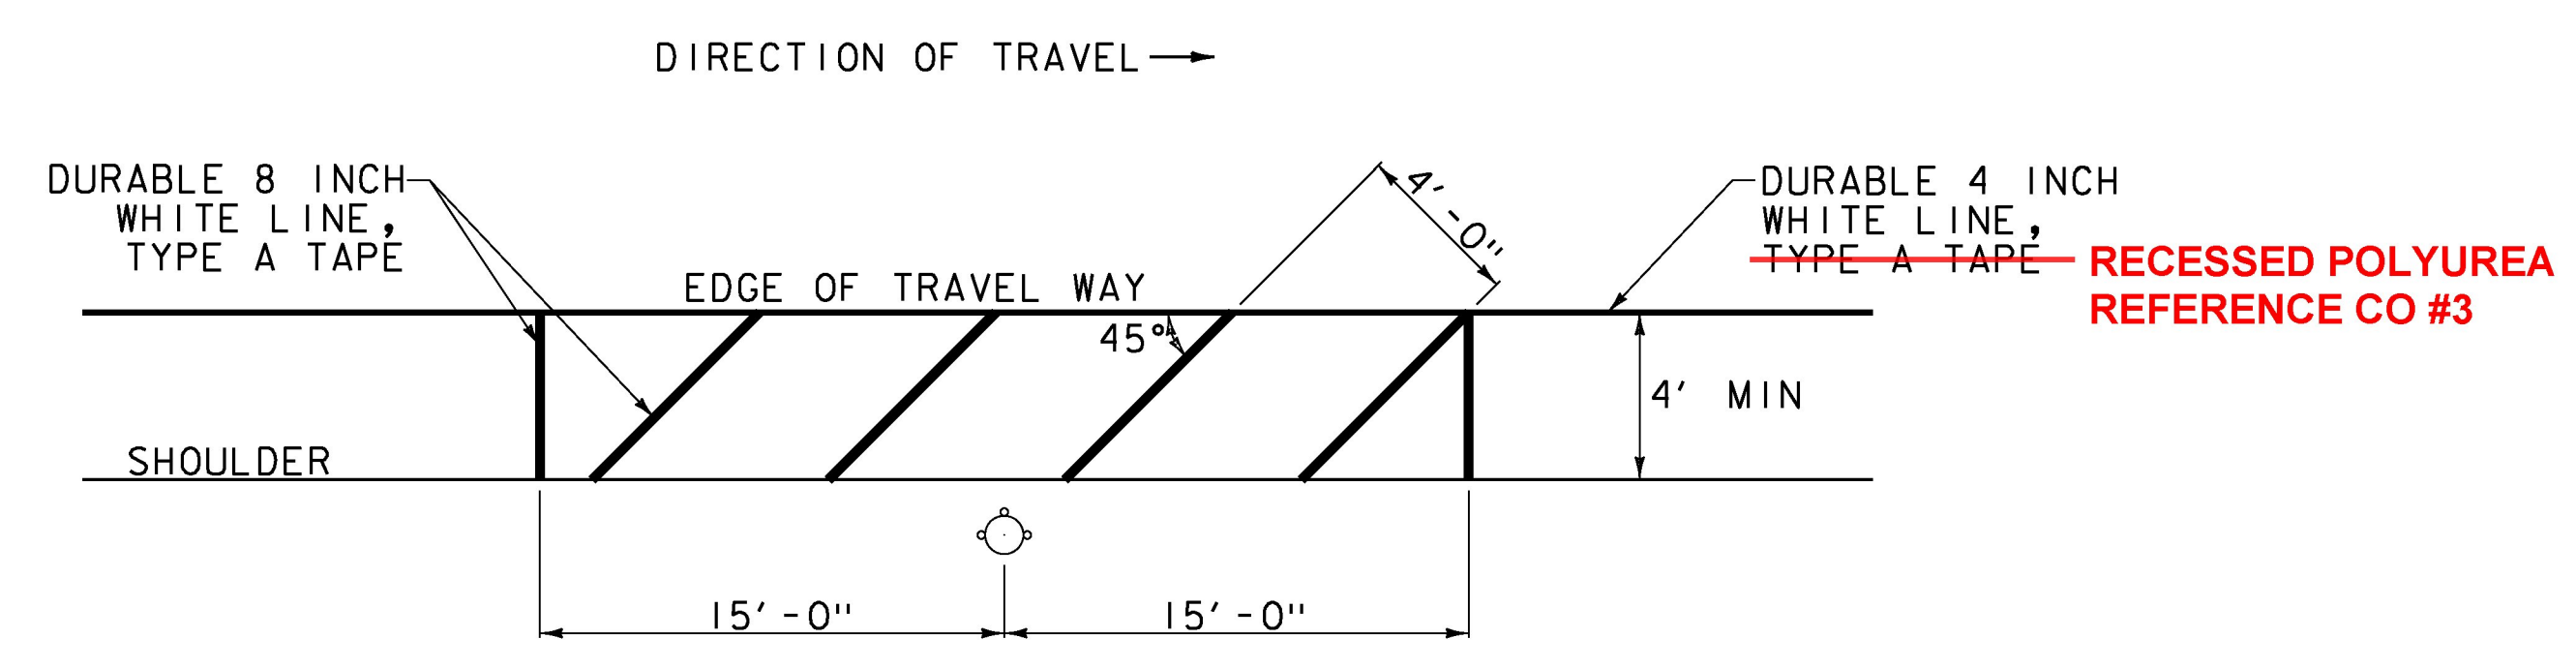


FIRE HYDRANT PAVEMENT MARKING DETAIL

VT ROUTE 2A:
 STA. 149+10, RT
 STA. 154+22, RT
 STA. 162+04, RT
 STA. 166+80, RT
 STA. 171+96, RT
 STA. 176+99, RT
 STA. 181+46, RT
 STA. 190+52, RT

NOTE:

THE CONTRACTOR SHALL ADJUST THE PLACEMENT OF THE FIRE HYDRANT PAVEMENT MARKINGS TO MEET THE EXISTING SITE CONSTRAINTS AS DIRECTED BY THE ENGINEER.

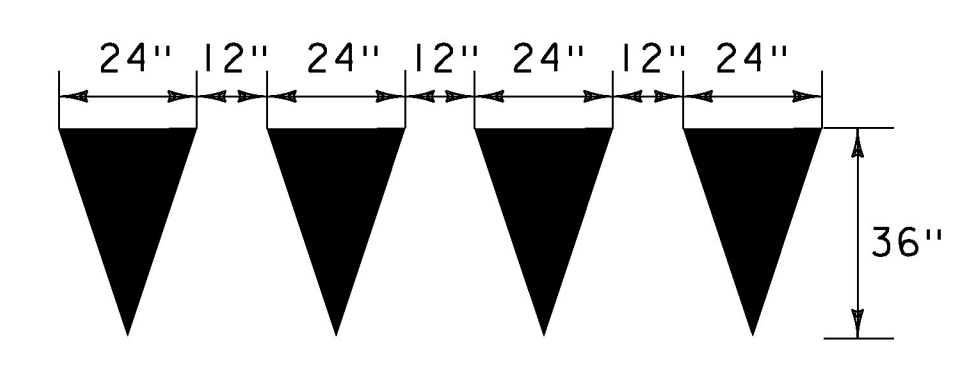

YIELD LINE DETAILS

TO BE INSTALLED ONLY AT THE DIRECTION OF THE ENGINEER TO BE PAID AS ONE DURABLE LETTER OR SYMBOL, TYPE D TAPE PER TRIANGLE

VT ROUTE 2A STA. 182+10, LT (BISHOP AVE.)



NOT TO SCALE

PROJECT NAME: WILLISTON	PLOT DATE: 2/15/2017
PROJECT NUMBER: NH 2949(I)	DRAWN BY: D. BARNES
FILE NAME: z12d224de+all.dgn	CHECKED BY: J. LITTLE
PROJECT LEADER: G. EDWARDS	SHEET 206 OF 249
DESIGNED BY: D. BARNES	
MISCELLANEOUS DETAIL SHEET I	