

**STEEL BEAM GUARDRAIL, GALVANIZED**  
 STA. 155+38 TO 155+75.5, LT  
 STA. 155+42 TO 155+92, RT

**TERMINAL CONNECTOR FOR STEEL BEAM GUARDRAIL**  
 STA. 155+75.5 TO 156+00.5, LT  
 STA. 155+92 TO 156+17, RT

**ANCHOR FOR STEEL BEAM RAIL**  
 STA. 155+38, LT  
 STA. 155+42, RT

**REMOVAL AND DISPOSAL OF GUARDRAIL**  
 STA. 155+50 TO 156+00, LT  
 STA. 155+52 TO 156+16, RT

**DURABLE & TEMPORARY 4 INCH WHITE LINE**  
 (ALL LINES WILL INCLUDE EDGE LINE BREAKS AND RADII FOR SIDE ROADS)  
 STA. 152+00 TO 157+00, SOLID LT & RT  
 STA. 152+00 TO 152+97, DOTTED LT  
 STA. 154+00 TO 154+26, SOLID RT (LANE LINE)  
 STA. 155+14 TO 157+00, SOLID RT (LANE LINE)  
 STA. 155+16 TO 156+94, SOLID LT (LANE LINE)  
 STA. 156+94 TO 157+00, DOTTED LT

**DURABLE & TEMPORARY 4 INCH YELLOW LINE**  
 (ALL LINES WILL INCLUDE C BREAKS FOR SIDE ROADS)  
 STA. 152+00 TO 154+51, DOUBLE SOLID LT & RT (GORE MARKING) SEE SHEET 208  
 STA. 155+14 TO 157+00, SOLID LT & RT

**DURABLE & TEMPORARY 6 INCH WHITE LINE**  
 STA. 154+66, SOLID LT (EDGE LINE, SB OFF RAMP C)  
 STA. 154+92, SOLID RT (EDGE LINE, SB ON RAMP B)

**DURABLE & TEMPORARY 6 INCH YELLOW LINE**  
 STA. 154+66, SOLID LT (EDGE LINE, SB OFF RAMP C)  
 STA. 154+92, SOLID RT (EDGE LINE, SB ON RAMP B)



**DURABLE & TEMPORARY 8 INCH WHITE LINE**  
 STA. 154+07 TO 154+37, RT (HYDRANT) SEE SHEET 206

**DURABLE & TEMPORARY 8 INCH YELLOW LINE**  
 STA. 152+00 TO 154+40, LT (DIAGONALS) SEE SHEET 208

**DURABLE & TEMPORARY 24 INCH STOP BAR**  
 STA. 154+27, RT  
 STA. 154+66, LT (SB OFF RAMP C)  
 STA. 155+15, LT


**DURABLE LETTER OR SYMBOL, TYPE D TAPE**  
 STA. 152+81, RT ARROW  
 STA. 152+81, RT ARROW (2)  
 STA. 154+16, RT ARROW  
 STA. 154+16, RT ARROW (2)  
 STA. 154+66, LT ARROW (2) (SB OFF RAMP C)  
 STA. 155+18, RT ARROW  
 STA. 155+21, RT ARROW (2)  
 STA. 155+24, LT ARROW  
 STA. 155+25, LT ARROW  
 STA. 155+66, LT "ONLY"  
 STA. 156+07, LT ARROW  
 STA. 156+07, LT ARROW  
 STA. 156+49, LT "ONLY"  
 STA. 156+87, RT ARROW (2)  
 STA. 156+87, RT ARROW  
 STA. 156+90, LT ARROW  
 STA. 156+90, LT ARROW

**CURVE 3 DATA**  
 PC = 154+20.98  
 PT = 155+13.21  
 $\Delta = 1^\circ 17' 19.57''$  LT  
 $\Delta = 1^\circ 23' 50.85''$  RT  
 R = 4100.00'  
 T = 46.11'  
 L = 92.22'  
 E = 0.26'  
 e = NC

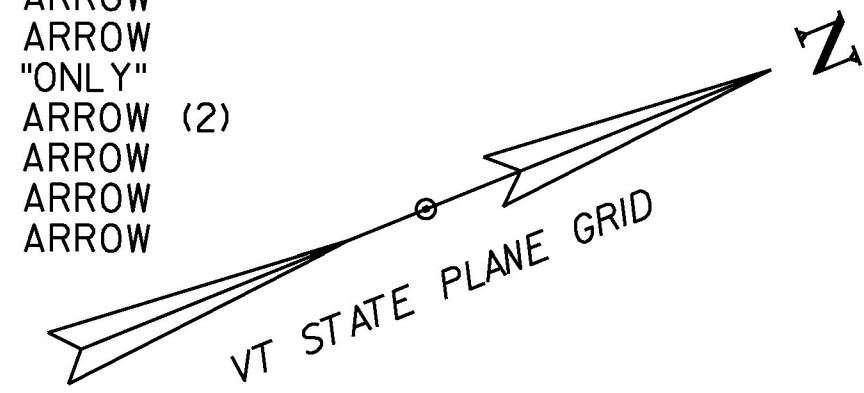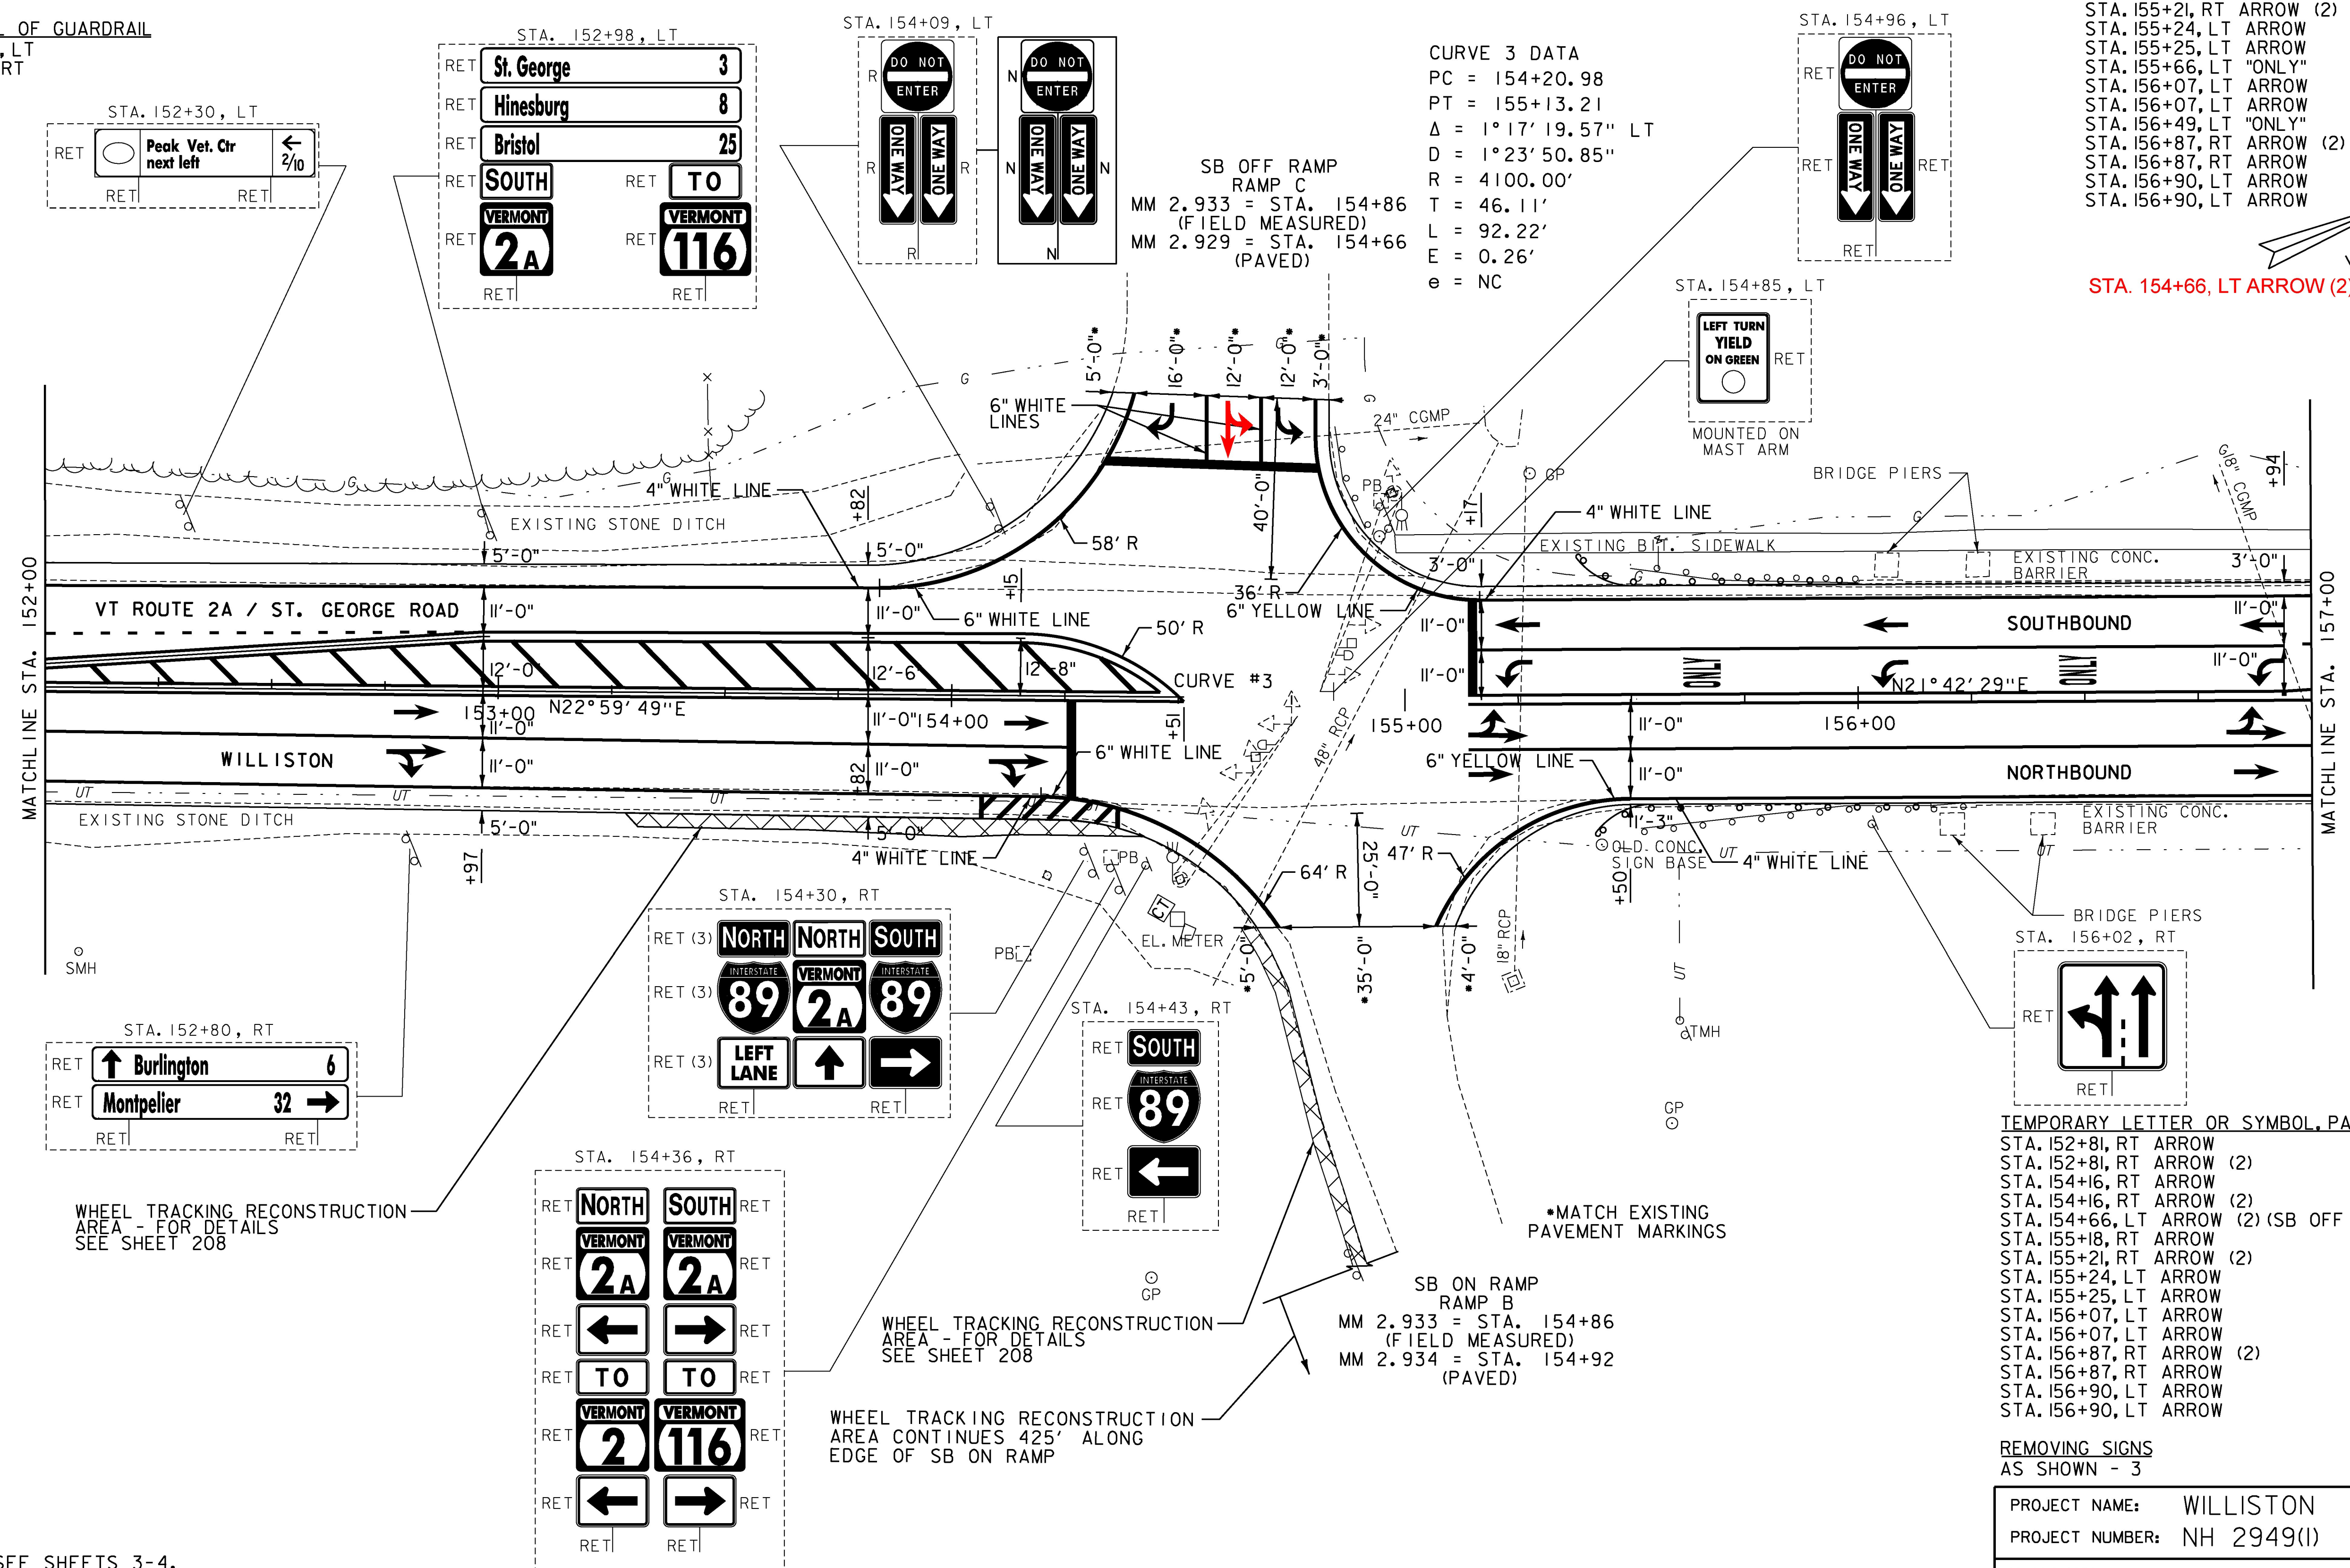

**NOTES:**

- FOR LEGENDS, SEE SHEETS 3-4.
- ALL EXISTING SIGNS NOT SHOWN ON THE PLANS SHALL BE RETAINED.

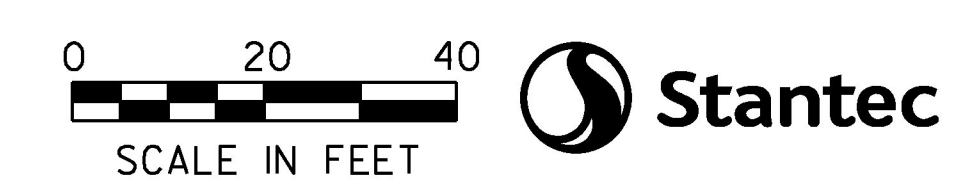

**TEMPORARY LETTER OR SYMBOL, PAINT**  
 STA. 152+81, RT ARROW  
 STA. 152+81, RT ARROW (2)  
 STA. 154+16, RT ARROW  
 STA. 154+16, RT ARROW (2)  
 STA. 154+66, LT ARROW (2) (SB OFF RAMP C)  
 STA. 155+18, RT ARROW  
 STA. 155+21, RT ARROW (2)  
 STA. 155+24, LT ARROW  
 STA. 155+25, LT ARROW  
 STA. 156+07, LT ARROW  
 STA. 156+07, LT ARROW  
 STA. 156+49, LT "ONLY"  
 STA. 156+87, RT ARROW (2)  
 STA. 156+87, RT ARROW  
 STA. 156+90, LT ARROW  
 STA. 156+90, LT ARROW

**REMOVING SIGNS**  
 AS SHOWN - 3

PROJECT NAME:	WILLISTON
PROJECT NUMBER:	NH 2949(I)
FILE NAME:	z12d224bdr.dgn
DESIGNED BY:	D. BARNES
PROJECT LEADER:	G. EDWARDS
CHECKED BY:	J. LITTLE
PLOT DATE:	2/15/2017
DRAWN BY:	D. BARNES
LAYOUT SHEET 2	SHEET 221 OF 249