

CHANGING ELEVATION OF SEWER MANHOLES
SEE SHEET 202

STEEL BEAM GUARDRAIL, GALVANIZED
STA. 158+04.5 TO 158+42, LT
STA. 158+20 TO 158+70, RT

TERMINAL CONNECTOR FOR
STEEL BEAM GUARDRAIL
STA. 157+79.5 TO 158+04.5, LT
STA. 157+95 TO 158+20, RT

ANCHOR FOR STEEL BEAM RAIL
STA. 158+42, LT
STA. 158+70, RT

REMOVAL AND DISPOSAL OF GUARDRAIL
STA. 157+80 TO 158+43, LT
STA. 157+95 TO 158+58, RT

DURABLE & TEMPORARY 4 INCH WHITE LINE
(ALL LINES WILL INCLUDE EDGE LINE BREAKS
AND RADII FOR SIDE ROADS)
STA. 157+00 TO 161+00, SOLID LT & RT
STA. 157+00 TO 158+68, SOLID RT (LANE LINE)
STA. 157+00 TO 158+74, DOTTED LT
STA. 159+56 TO 161+00, DASHED RT (LANE LINE)
STA. 159+79 TO 161+00, SOLID LT (LANE LINE)

DURABLE & TEMPORARY 4 INCH YELLOW LINE
(ALL LINES WILL INCLUDE ϕ BREAKS FOR SIDE ROADS)
STA. 157+00 TO 157+27, SOLID LT & RT
STA. 157+27 TO 159+06, DOUBLE SOLID LT & RT
(GORE MARKING) SEE SHEET 208
STA. 159+56 TO 161+00, DOUBLE SOLID LT & RT
(GORE MARKING) SEE SHEET 208

DURABLE & TEMPORARY 6 INCH WHITE LINE
STA. 159+36, SOLID LT (EDGELINE, NB ON RAMP D)
STA. 159+36, SOLID RT (EDGELINE, NB ON RAMP A)


DURABLE & TEMPORARY 6 INCH YELLOW LINE
STA. 159+36, SOLID LT (EDGELINE, NB ON RAMP D)
STA. 159+36, SOLID RT (EDGELINE, NB ON RAMP A)

DURABLE & TEMPORARY 24 INCH STOP BAR
STA. 158+69, RT
STA. 159+78 TO 159+79, LT

DURABLE & TEMPORARY 8 INCH YELLOW LINE
STA. 157+61 TO 158+90, LT (DIAGONALS) SEE SHEET 208
STA. 159+56 TO 161+00, LT (DIAGONALS) SEE SHEET 208

DURABLE LETTER OR SYMBOL, TYPE D TAPE
STA. 158+57, RT ARROW (2)
STA. 158+58, RT ARROW
STA. 159+88, LT ARROW
STA. 159+88, LT ARROW

TEMPORARY LETTER OR SYMBOL, PAINT
STA. 158+57, RT ARROW (2)
STA. 158+58, RT ARROW
STA. 159+88, LT ARROW
STA. 159+88, LT ARROW

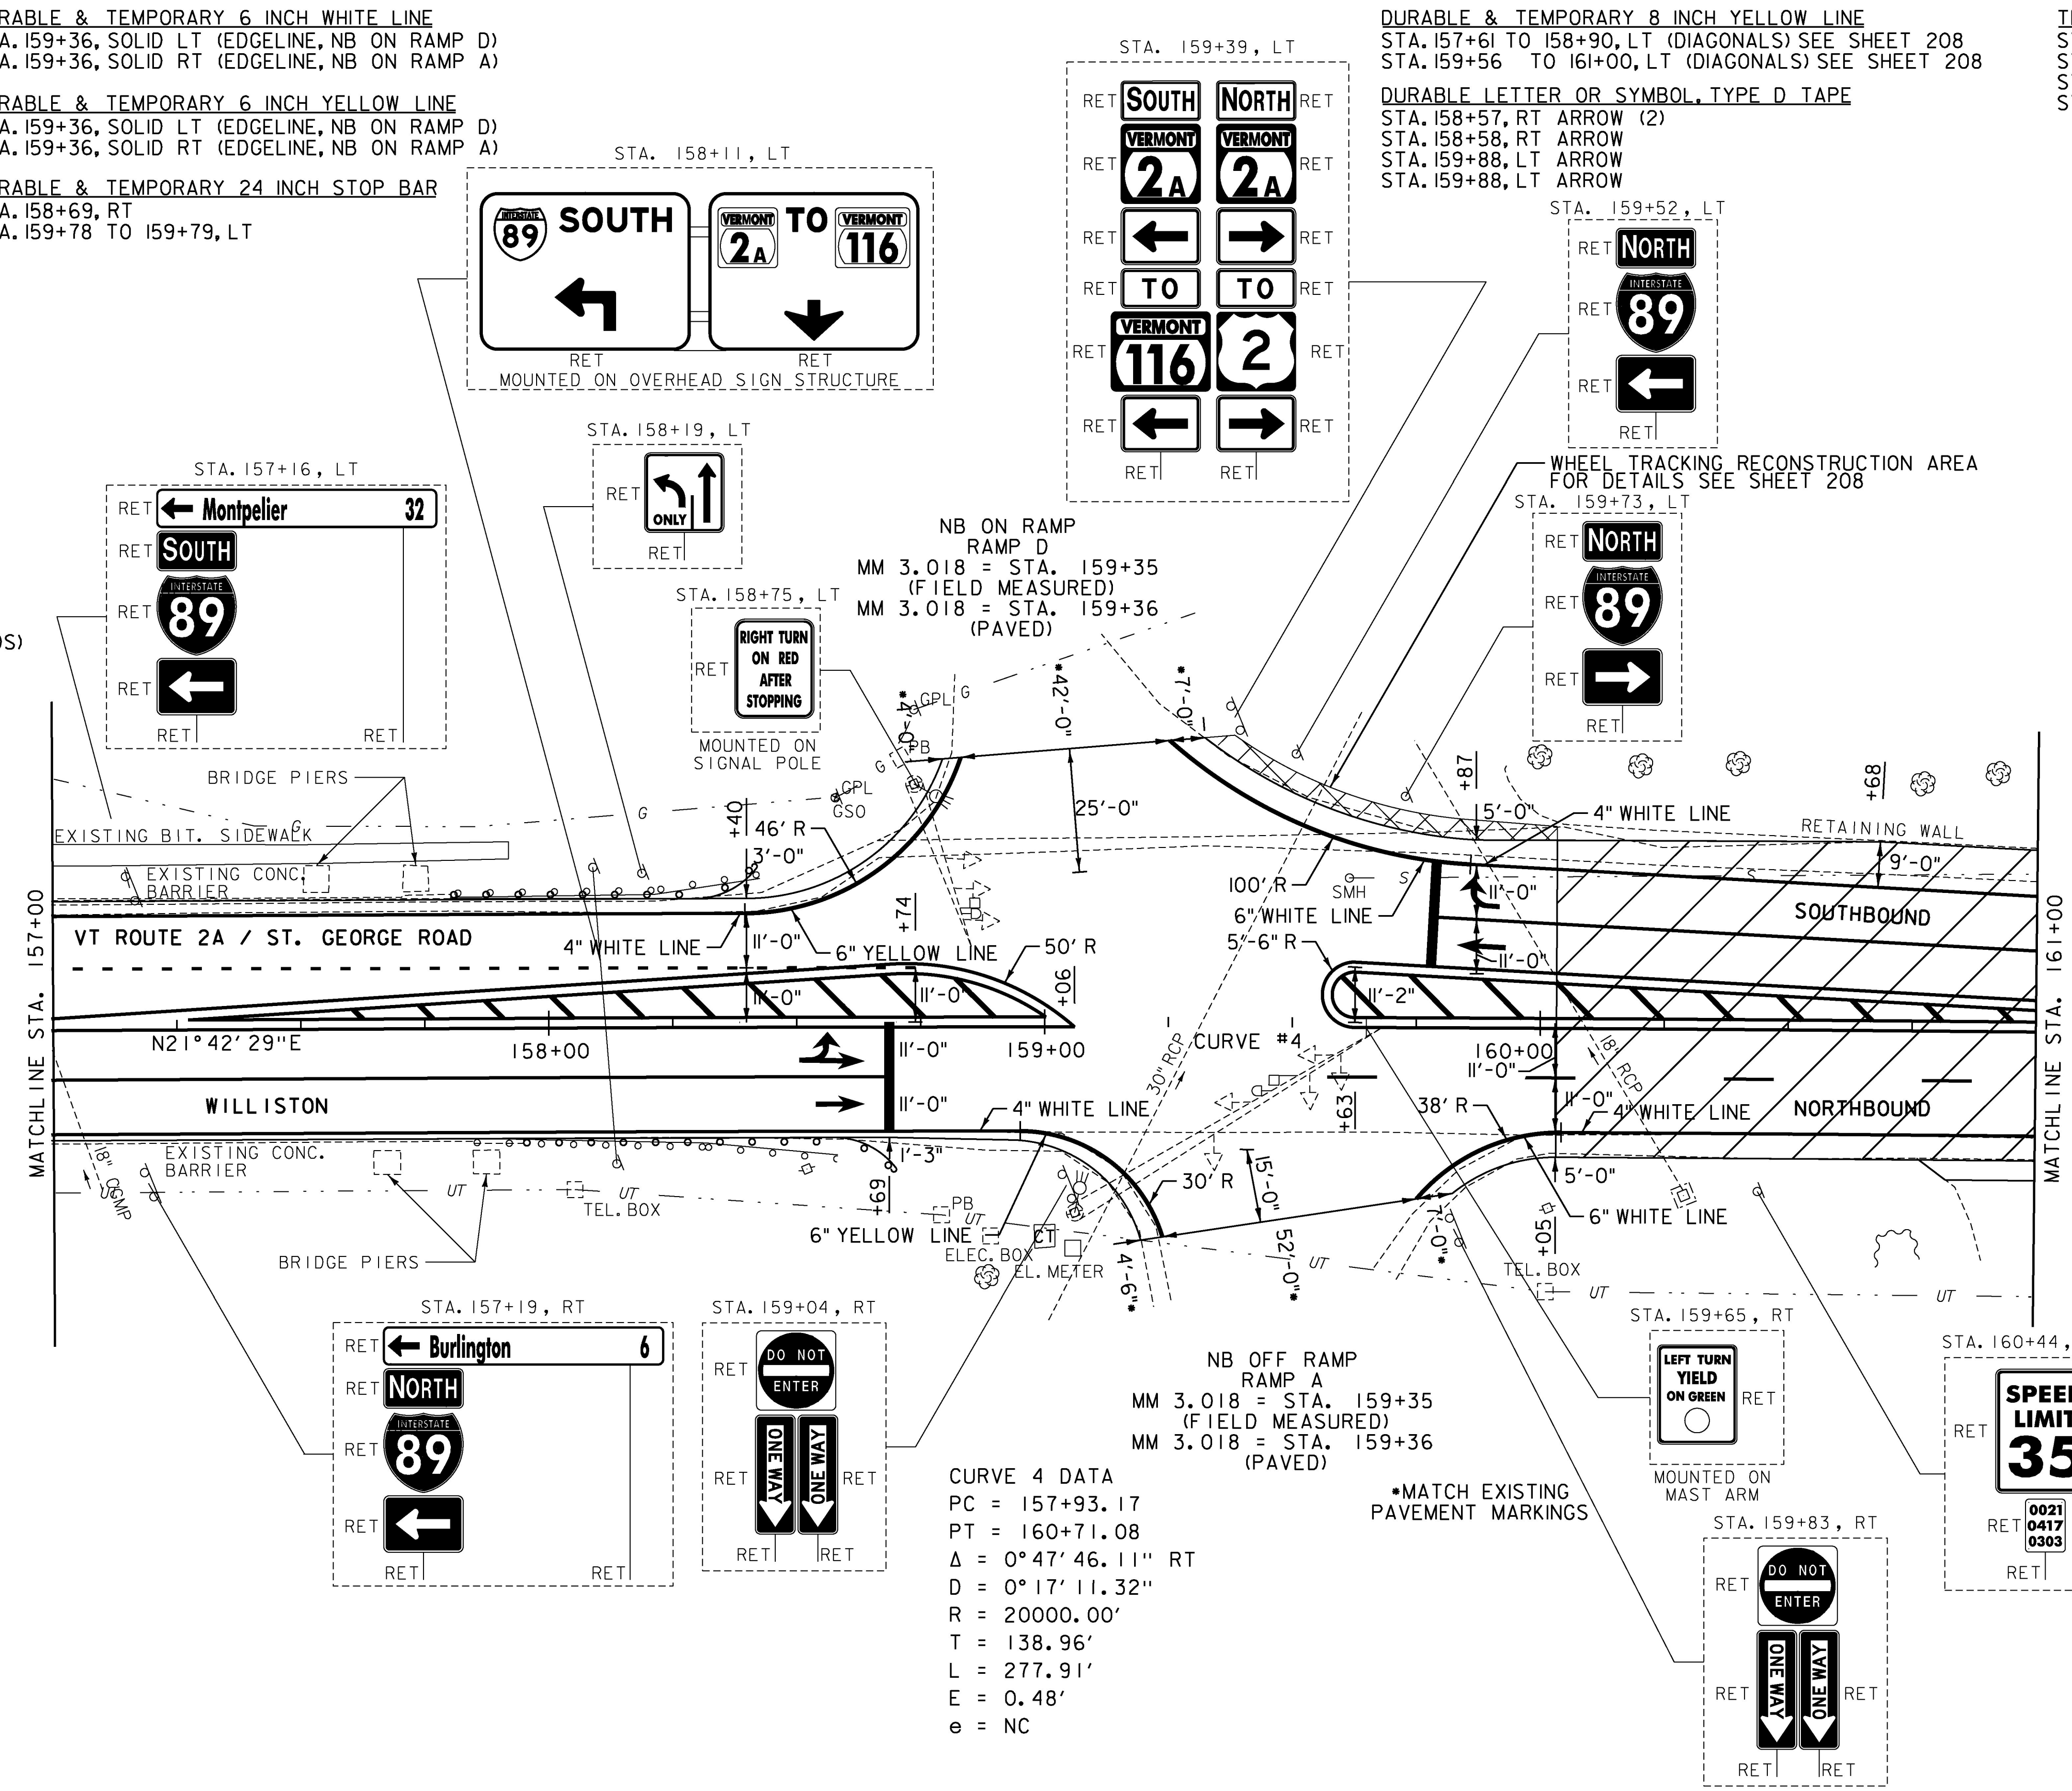

NB ON RAMP
RAMP D
MM 3.018 = STA. 159+35
(FIELD MEASURED)
MM 3.018 = STA. 159+36
(PAVED)

NB OFF RAMP
RAMP A
MM 3.018 = STA. 159+35
(FIELD MEASURED)
MM 3.018 = STA. 159+36
(PAVED)

CURVE 4 DATA
PC = 157+93.17
PT = 160+71.08
 $\Delta = 0^\circ 47' 46.11''$ RT
D = $0^\circ 17' 11.32''$
R = 20000.00'
T = 138.96'
L = 277.91'
E = 0.48'
e = NC

*MATCH EXISTING
PAVEMENT MARKINGS

NOTES:

- FOR LEGENDS, SEE SHEETS 3-4.
- ALL EXISTING SIGNS NOT SHOWN ON THE PLANS SHALL BE RETAINED.



PROJECT NAME: WILLISTON
PROJECT NUMBER: NH 2949(I)

FILE NAME: z12d224bdr.dgn
PROJECT LEADER: G. EDWARDS
DESIGNED BY: D. BARNES
LAYOUT SHEET 3

PLOT DATE: 2/15/2017
DRAWN BY: D. BARNES
CHECKED BY: J. LITTLE
SHEET 222 OF 249